
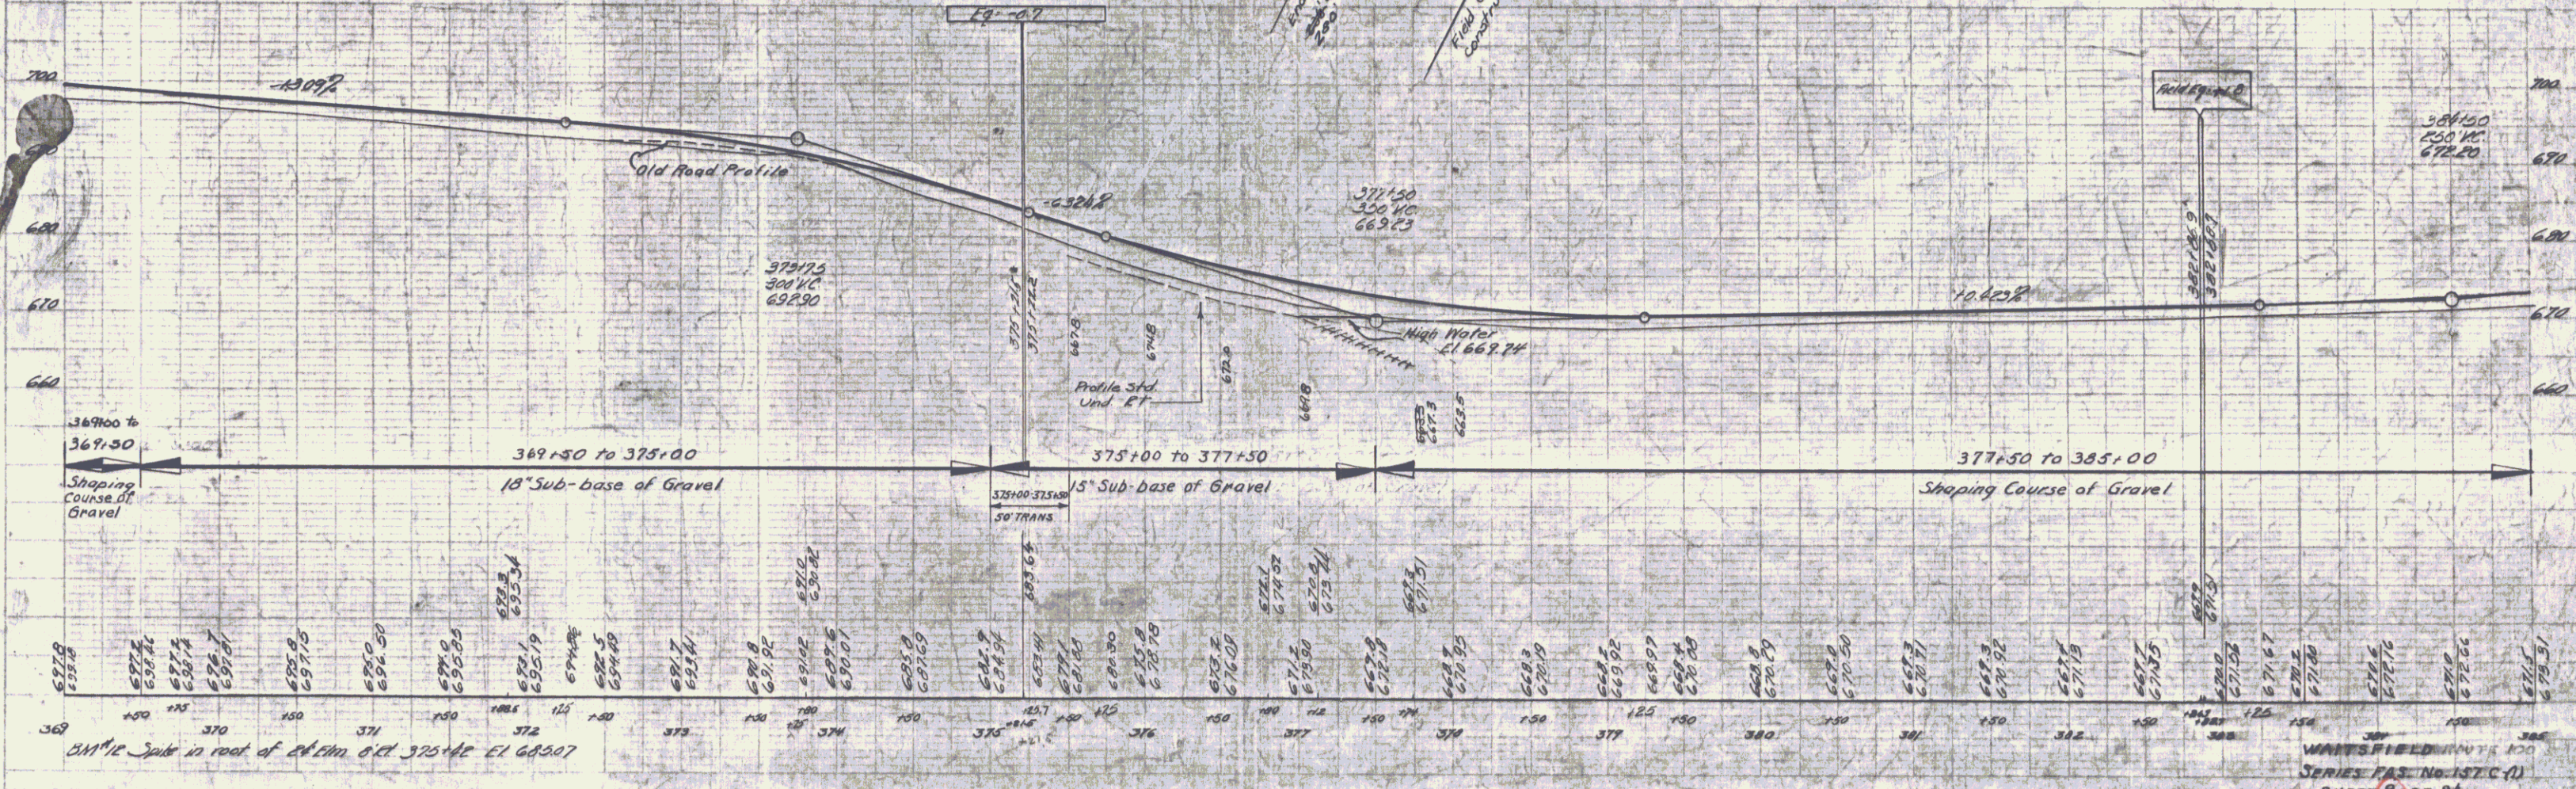


PARCEL INSTRUMENT	DATE	GRANTOR	GRANTEE	RECORDED	REMARKS
D	Q.C.D.	3-23-40	E.H. & MERTIE JONES	STAY IN	290' 138' 38' 40' 264'

F.A.S.	FISCAL YEAR	SHEET NO.	TOTAL SHEETS
WAITSFIELD	1941	9	24

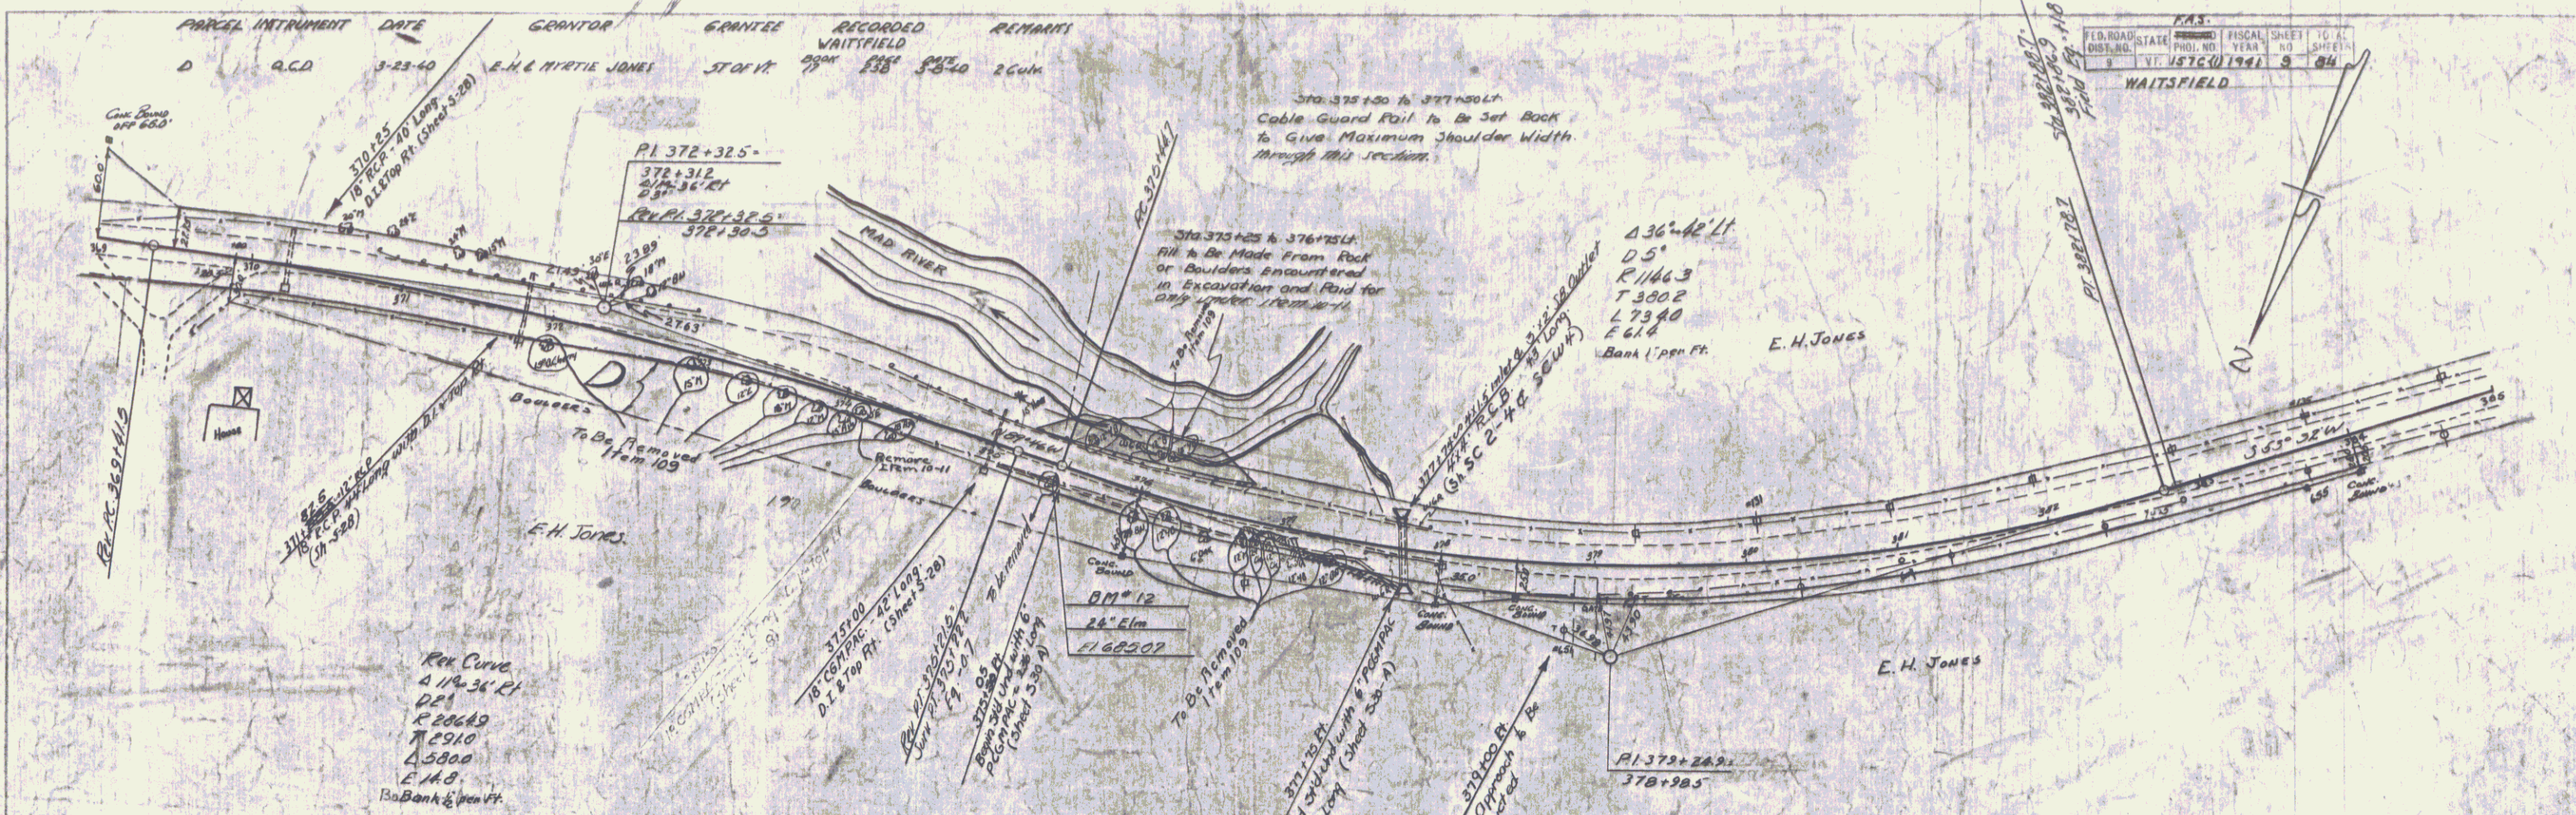

WAITSFIELD 1941
 SERIES F.A.S. No. 157.C (1)
 SHEET 9 OF 24