


PARCEL INSTRUMENT	DATE	GRANTOR	GRANTEE	RECORDED	REMARKS
E	Q.C.D.	3-23-40	E.H. & MARTIE C. JONES	ST. OF VT.	
A	W.D.O.E.	5-22-40	FLORA TUCKER	BOOK PAGE DATE	
A'	W.D.O.E.	6-4-40	FRANK EDITH HOWARD	57 OF 17 17 288.9 7-8-40	

F.A.S.			
FD. ROAD	STATE	FISCAL SHEET	TOTAL
10	VT	10	10
10	VT	10	10

Sta. 399+10 To 401+25 L<sup>r</sup>  
 Poor Foundation Material To be Removed  
 and Disposed of as Shown in Shaded  
 Area on Cross-Sections. This Work is  
 To be Paid For under the Item of  
 Common Excavation Incl. Borrow  
 (Item 10-11)

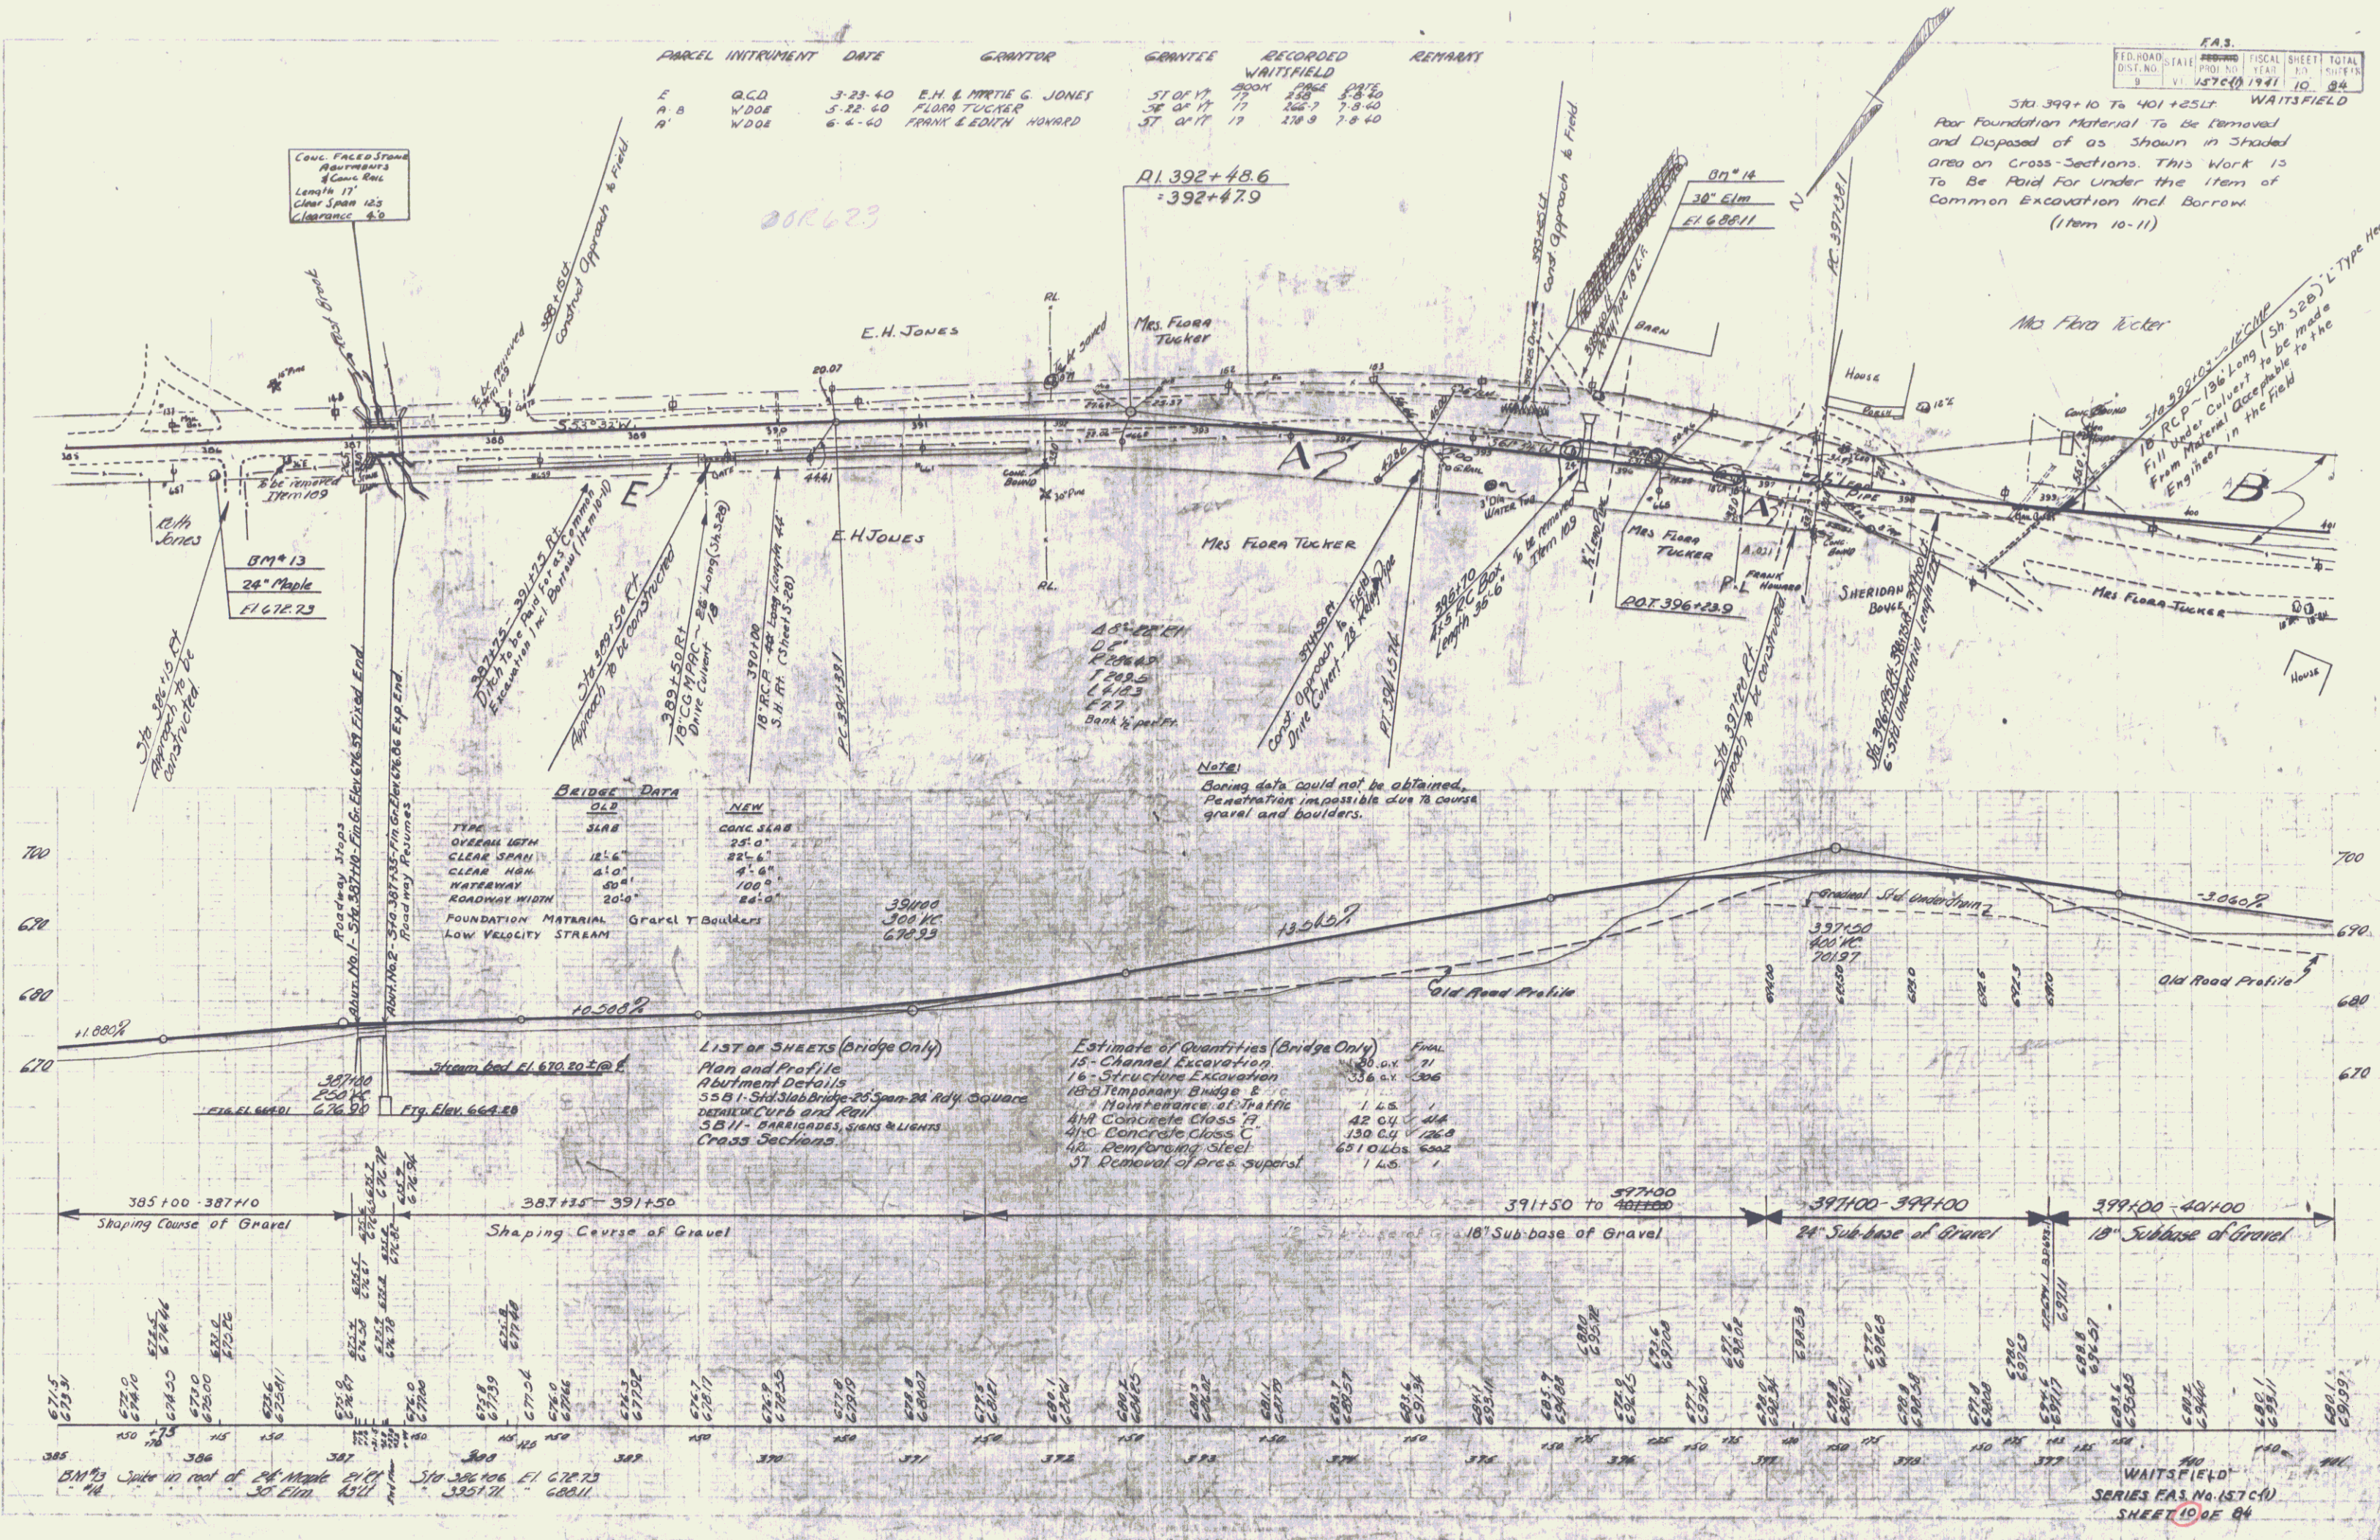

WAITSFIELD  
 SERIES F.A.S. No. (57C4)  
 SHEET 10 OF 24