

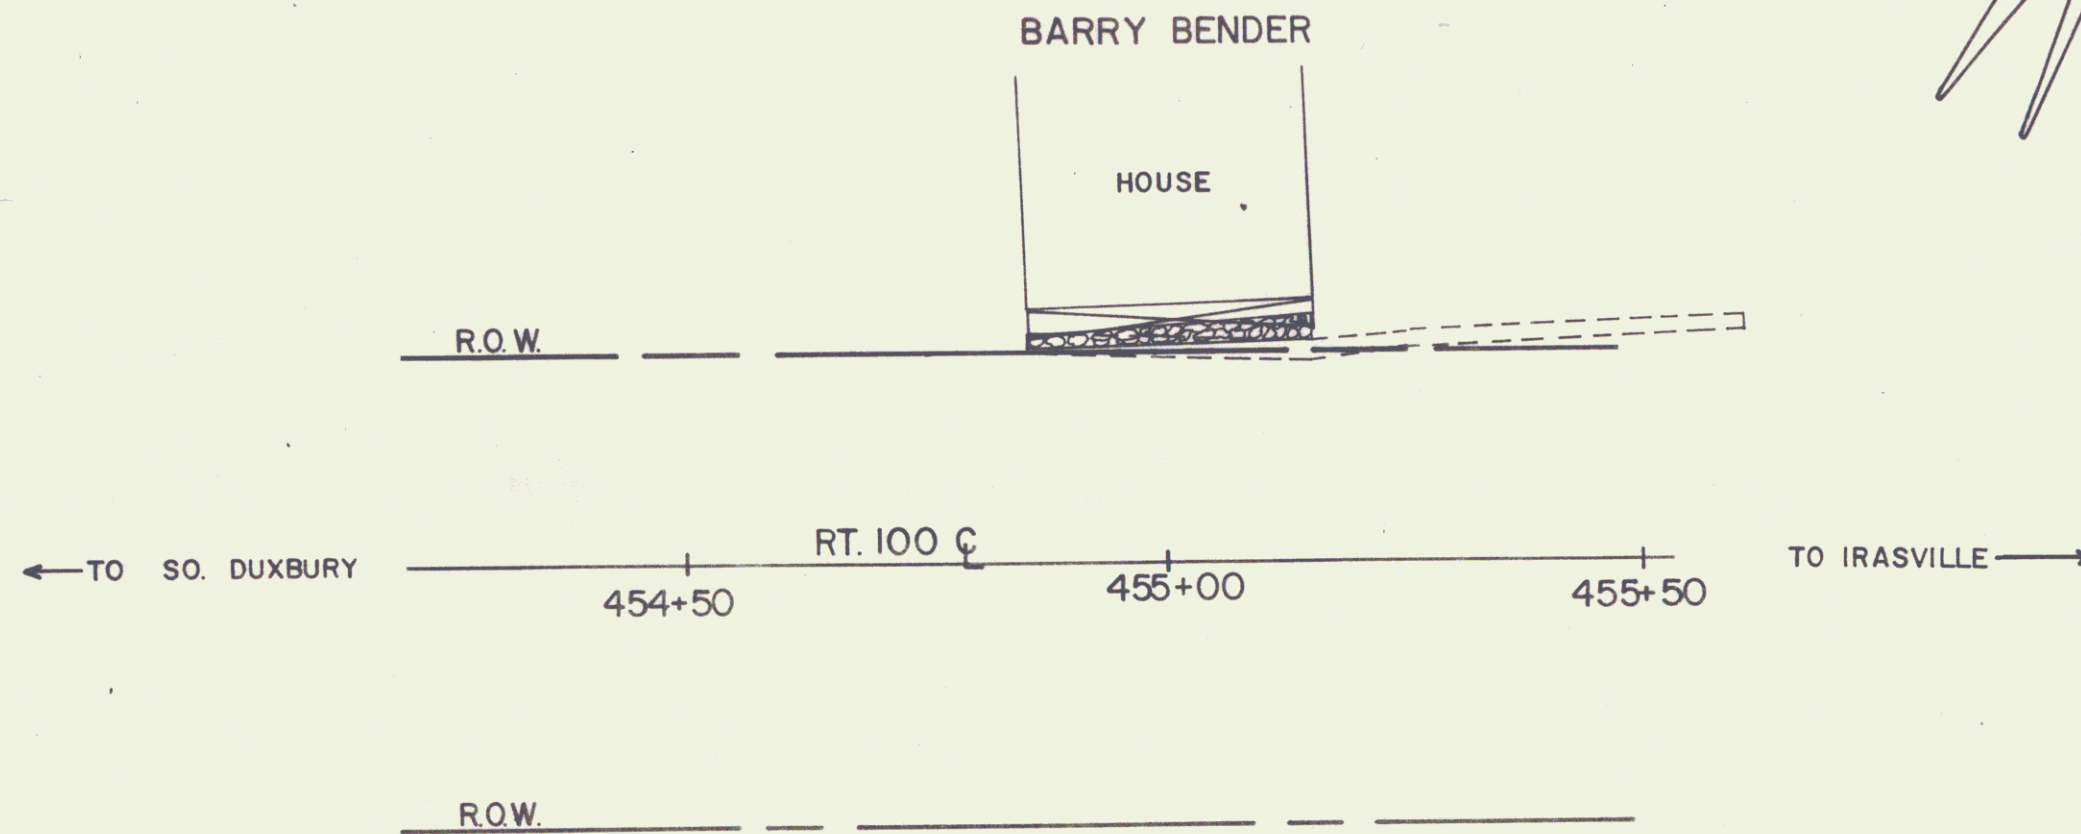


NAME	STATIONS	RIGHT	DEED	REMARKS
BENDER, BARRY	454+85LT. TO 455+15LT.	INSTALL & MAINT. (P)	W.D.O.E.	RETAINING WALL

MP 0368

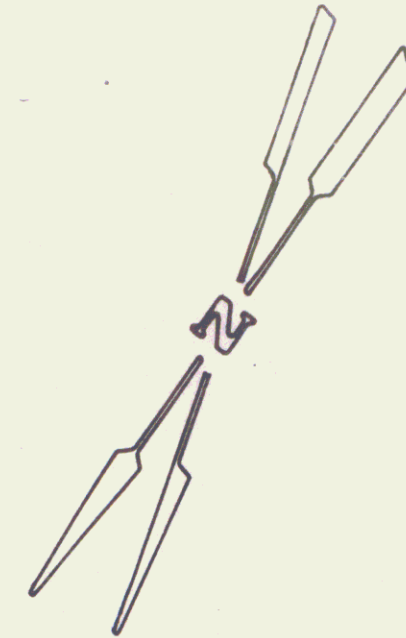

===== WALL AS ON PLANS
 [Hatched pattern] WALL AS MEASURED IN FIELD (AFFECTED)
 WALL - UNCEMENTED FIELD STONE

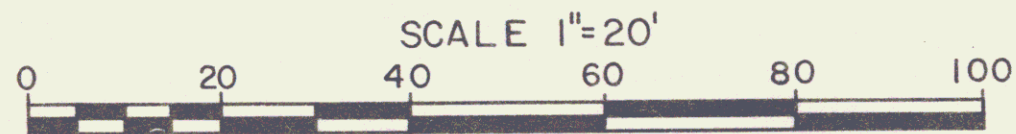

FAS 1ST c(i) VT 100
 STATE OF VERMONT
 AGENCY OF TRANSPORTATION
 SHEET 148
 TOWN OF WAITSFIELD
 DIST. #6 RETAINING WALL RT. 100 17
 APPROX SCALE 20' DATE 8-13-82 DRAWN BY FJM