
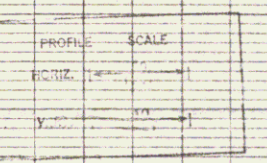
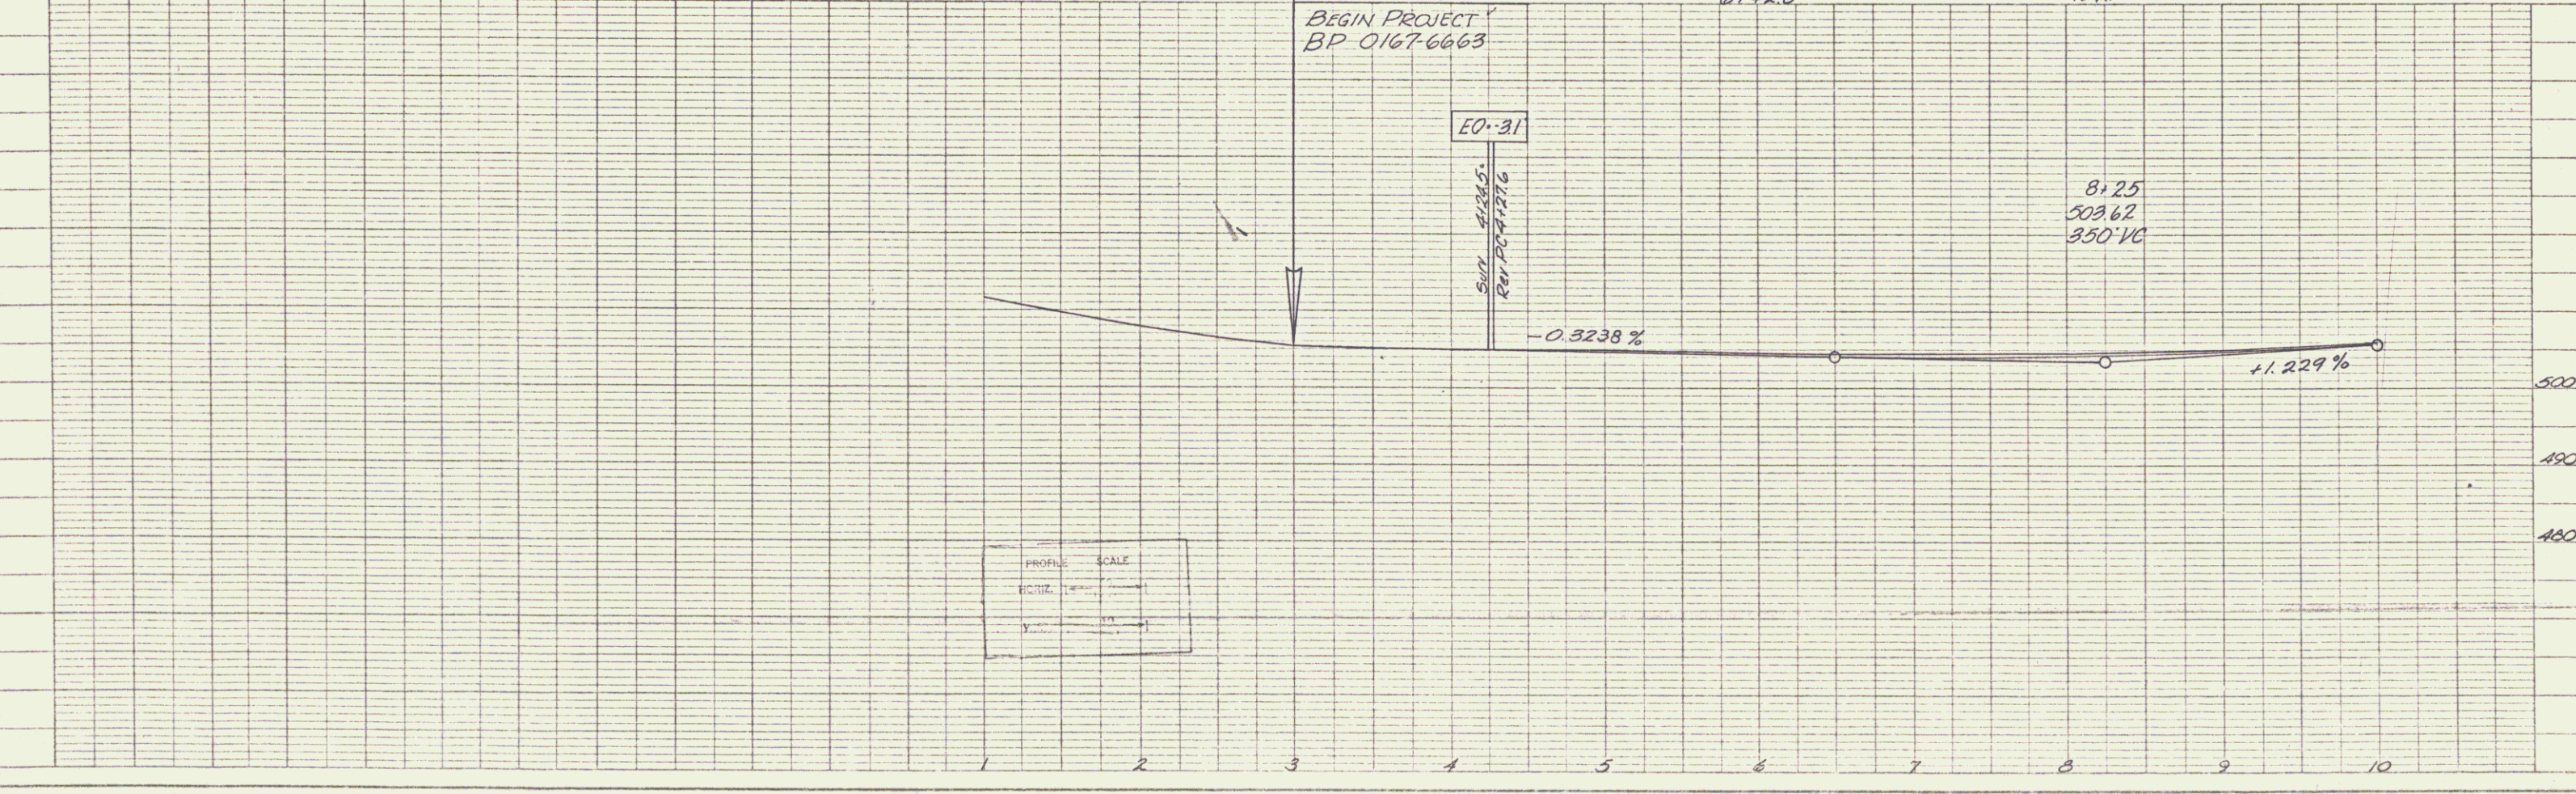
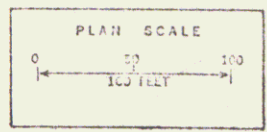


CONSTRUCT APPROACH	CONSTRUCT DRIVE	TWO CABLE GUARD RAIL
RT	LT	RT
3+60-6+25	3+00-25	3+50-6+00
7+00-9+50	4+80-4+50	4+50-8+46
	6+80-7+	7+00-10+00
	7+30-4+	

CONSTRUCT 8' SHOULDER
9+50 RT

PLAN
DATE: 10/15/10
DRAWN BY: J. J. [unclear]
CHECKED BY: [unclear]
NO. 100

PROFILE
DATE: 10/15/10
DRAWN BY: J. J. [unclear]
CHECKED BY: [unclear]
NO. 100

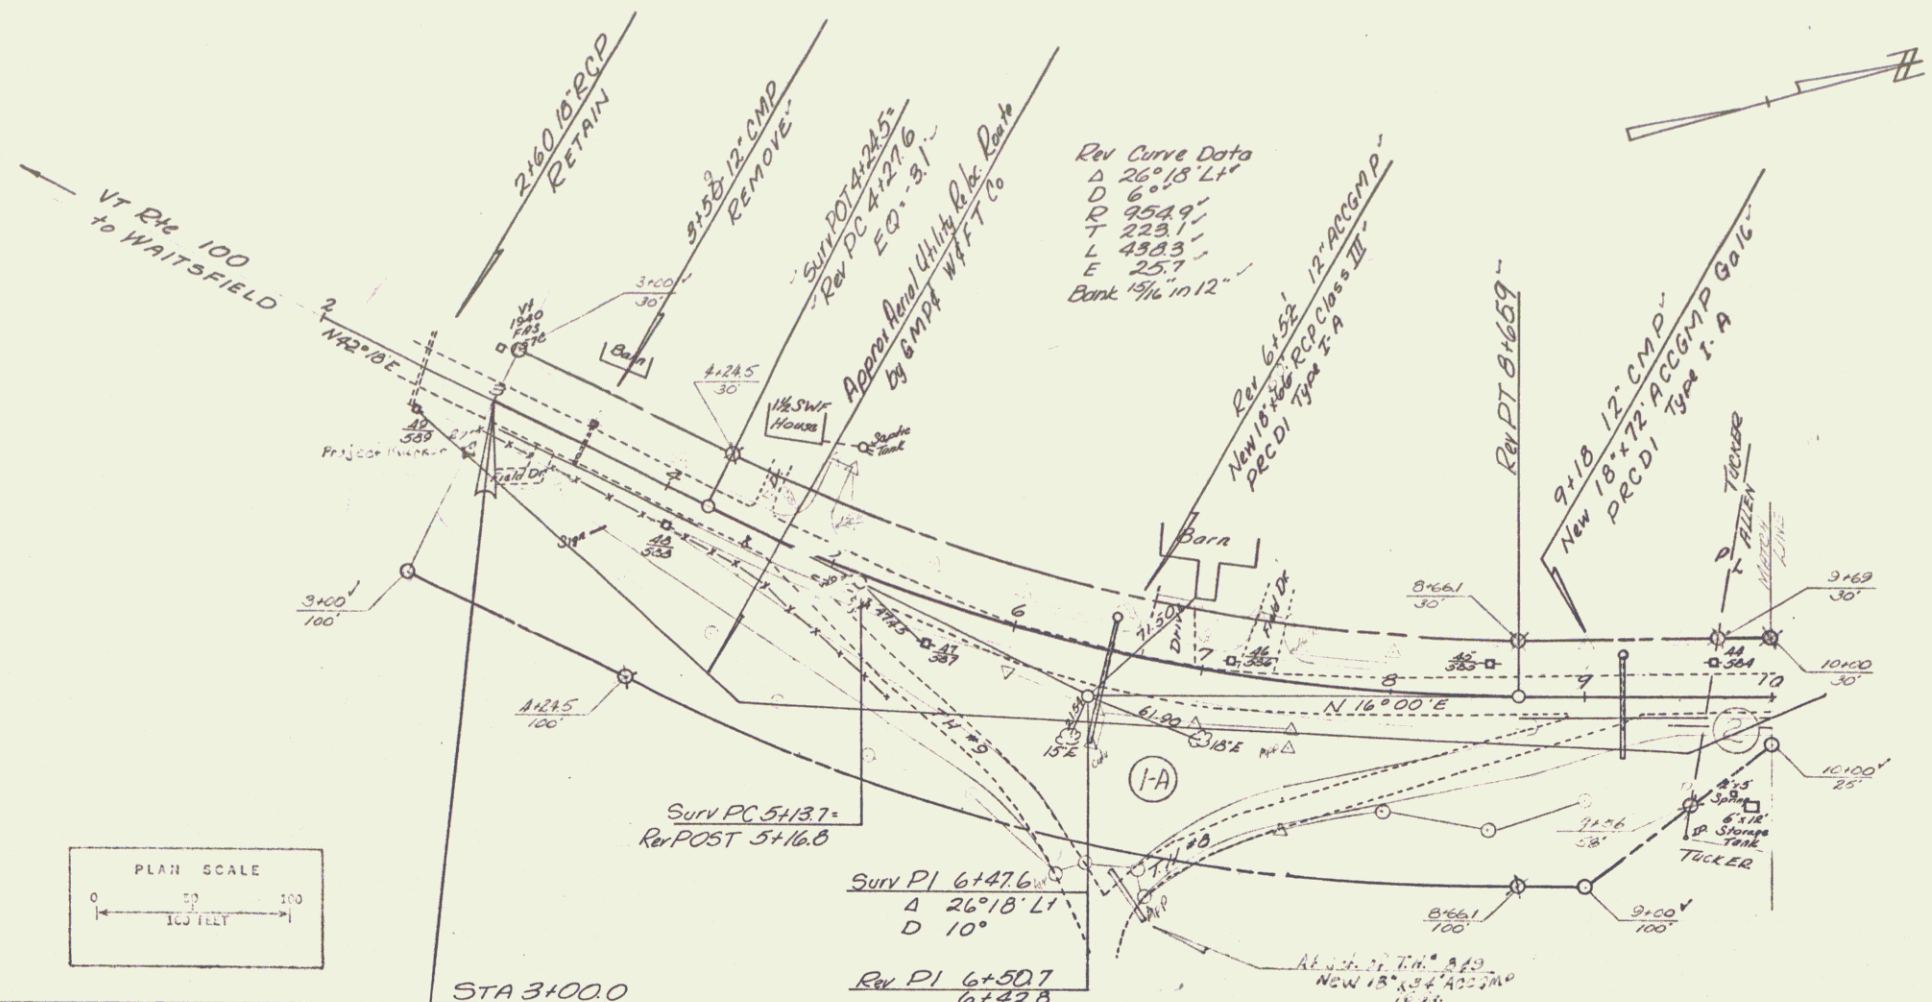

K&E PLATE 1, PLAN PROFILE
MUTUAL & BAKER CO.
48 9112 IMPERIAL™ TRADING PLATE 2001

WAITSFIELD BP 0167-6663
10/15/10