


QUIT CLAIM FROM STATE OF VERMONT
 TO QUENTIN A. PEARSON BY QCD
 ON 11/18/81 IN BK 37/43-44
 MP 0661.

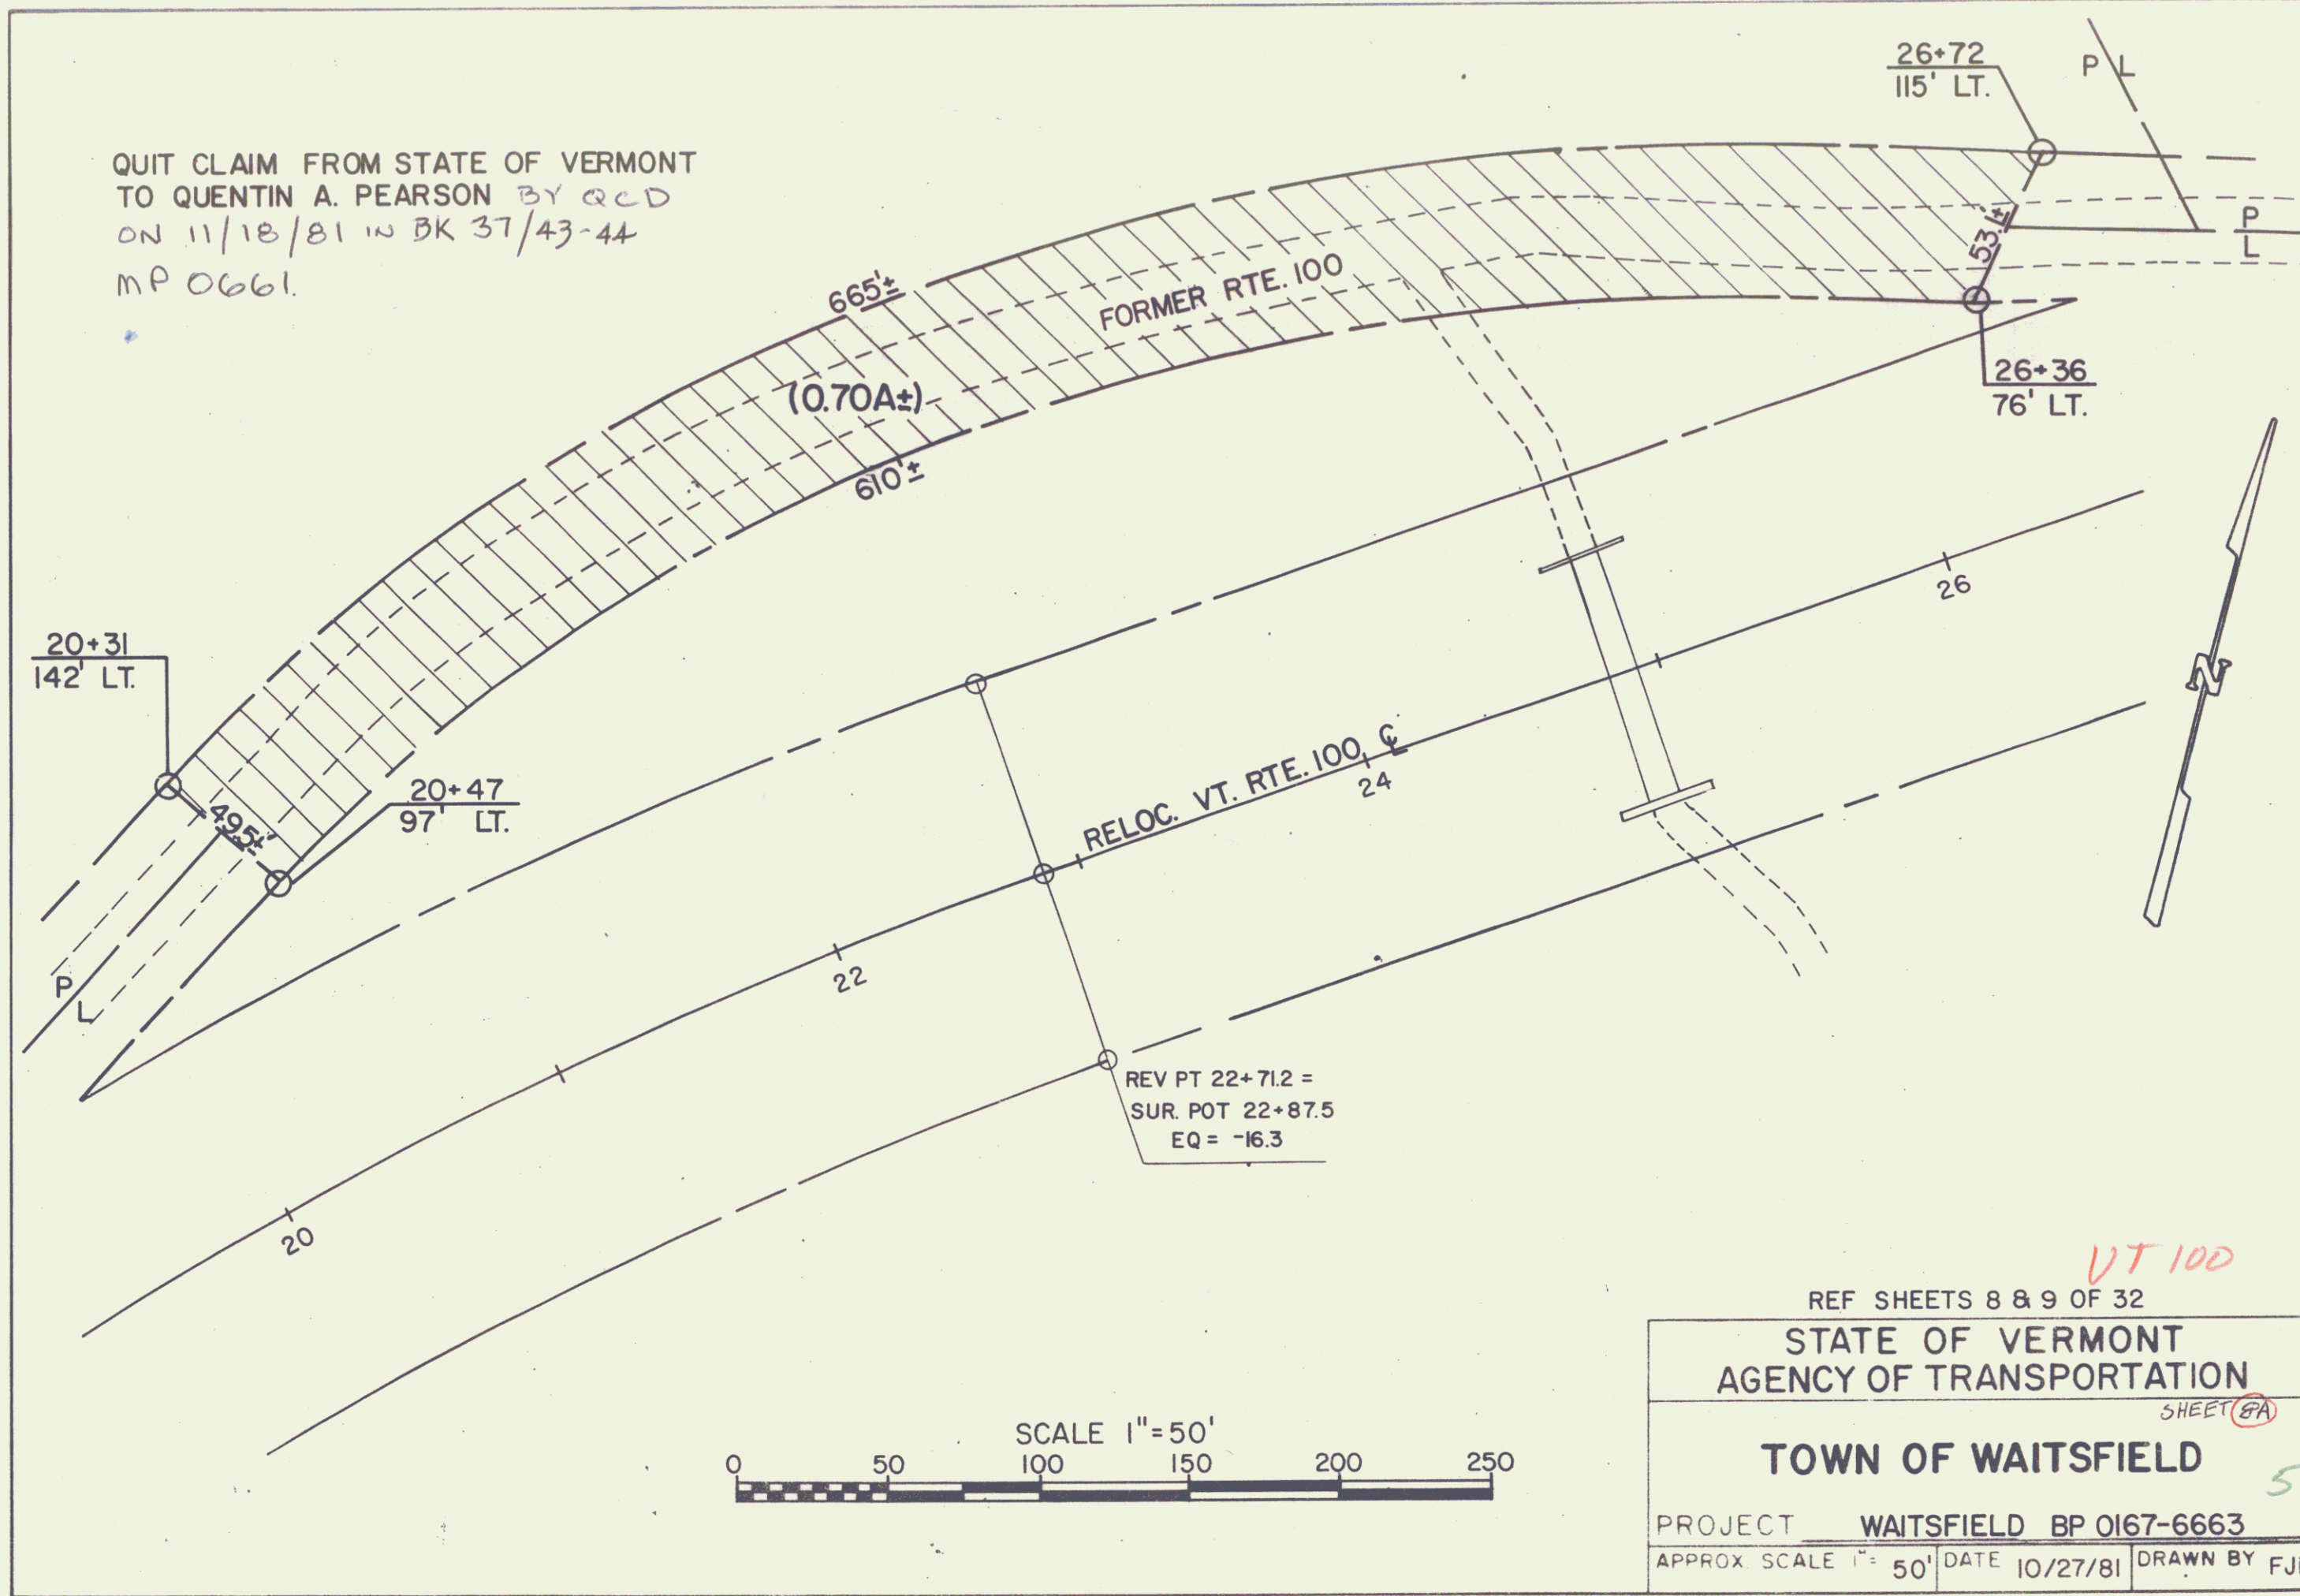

VT 100

REF SHEETS 8 & 9 OF 32

STATE OF VERMONT
AGENCY OF TRANSPORTATION

SHEET **87A**

TOWN OF WAITSFIELD

PROJECT **WAITSFIELD BP 0167-6663**

APPROX SCALE 1" = 50' DATE 10/27/81 DRAWN BY FJM