
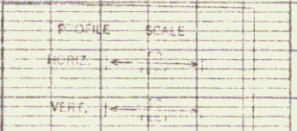
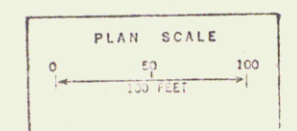


PLAN
 DRAWN BY: [Signature]
 CHECKED BY: [Signature]
 DATE: [Date]

PROFILE
 DRAWN BY: [Signature]
 CHECKED BY: [Signature]
 DATE: [Date]

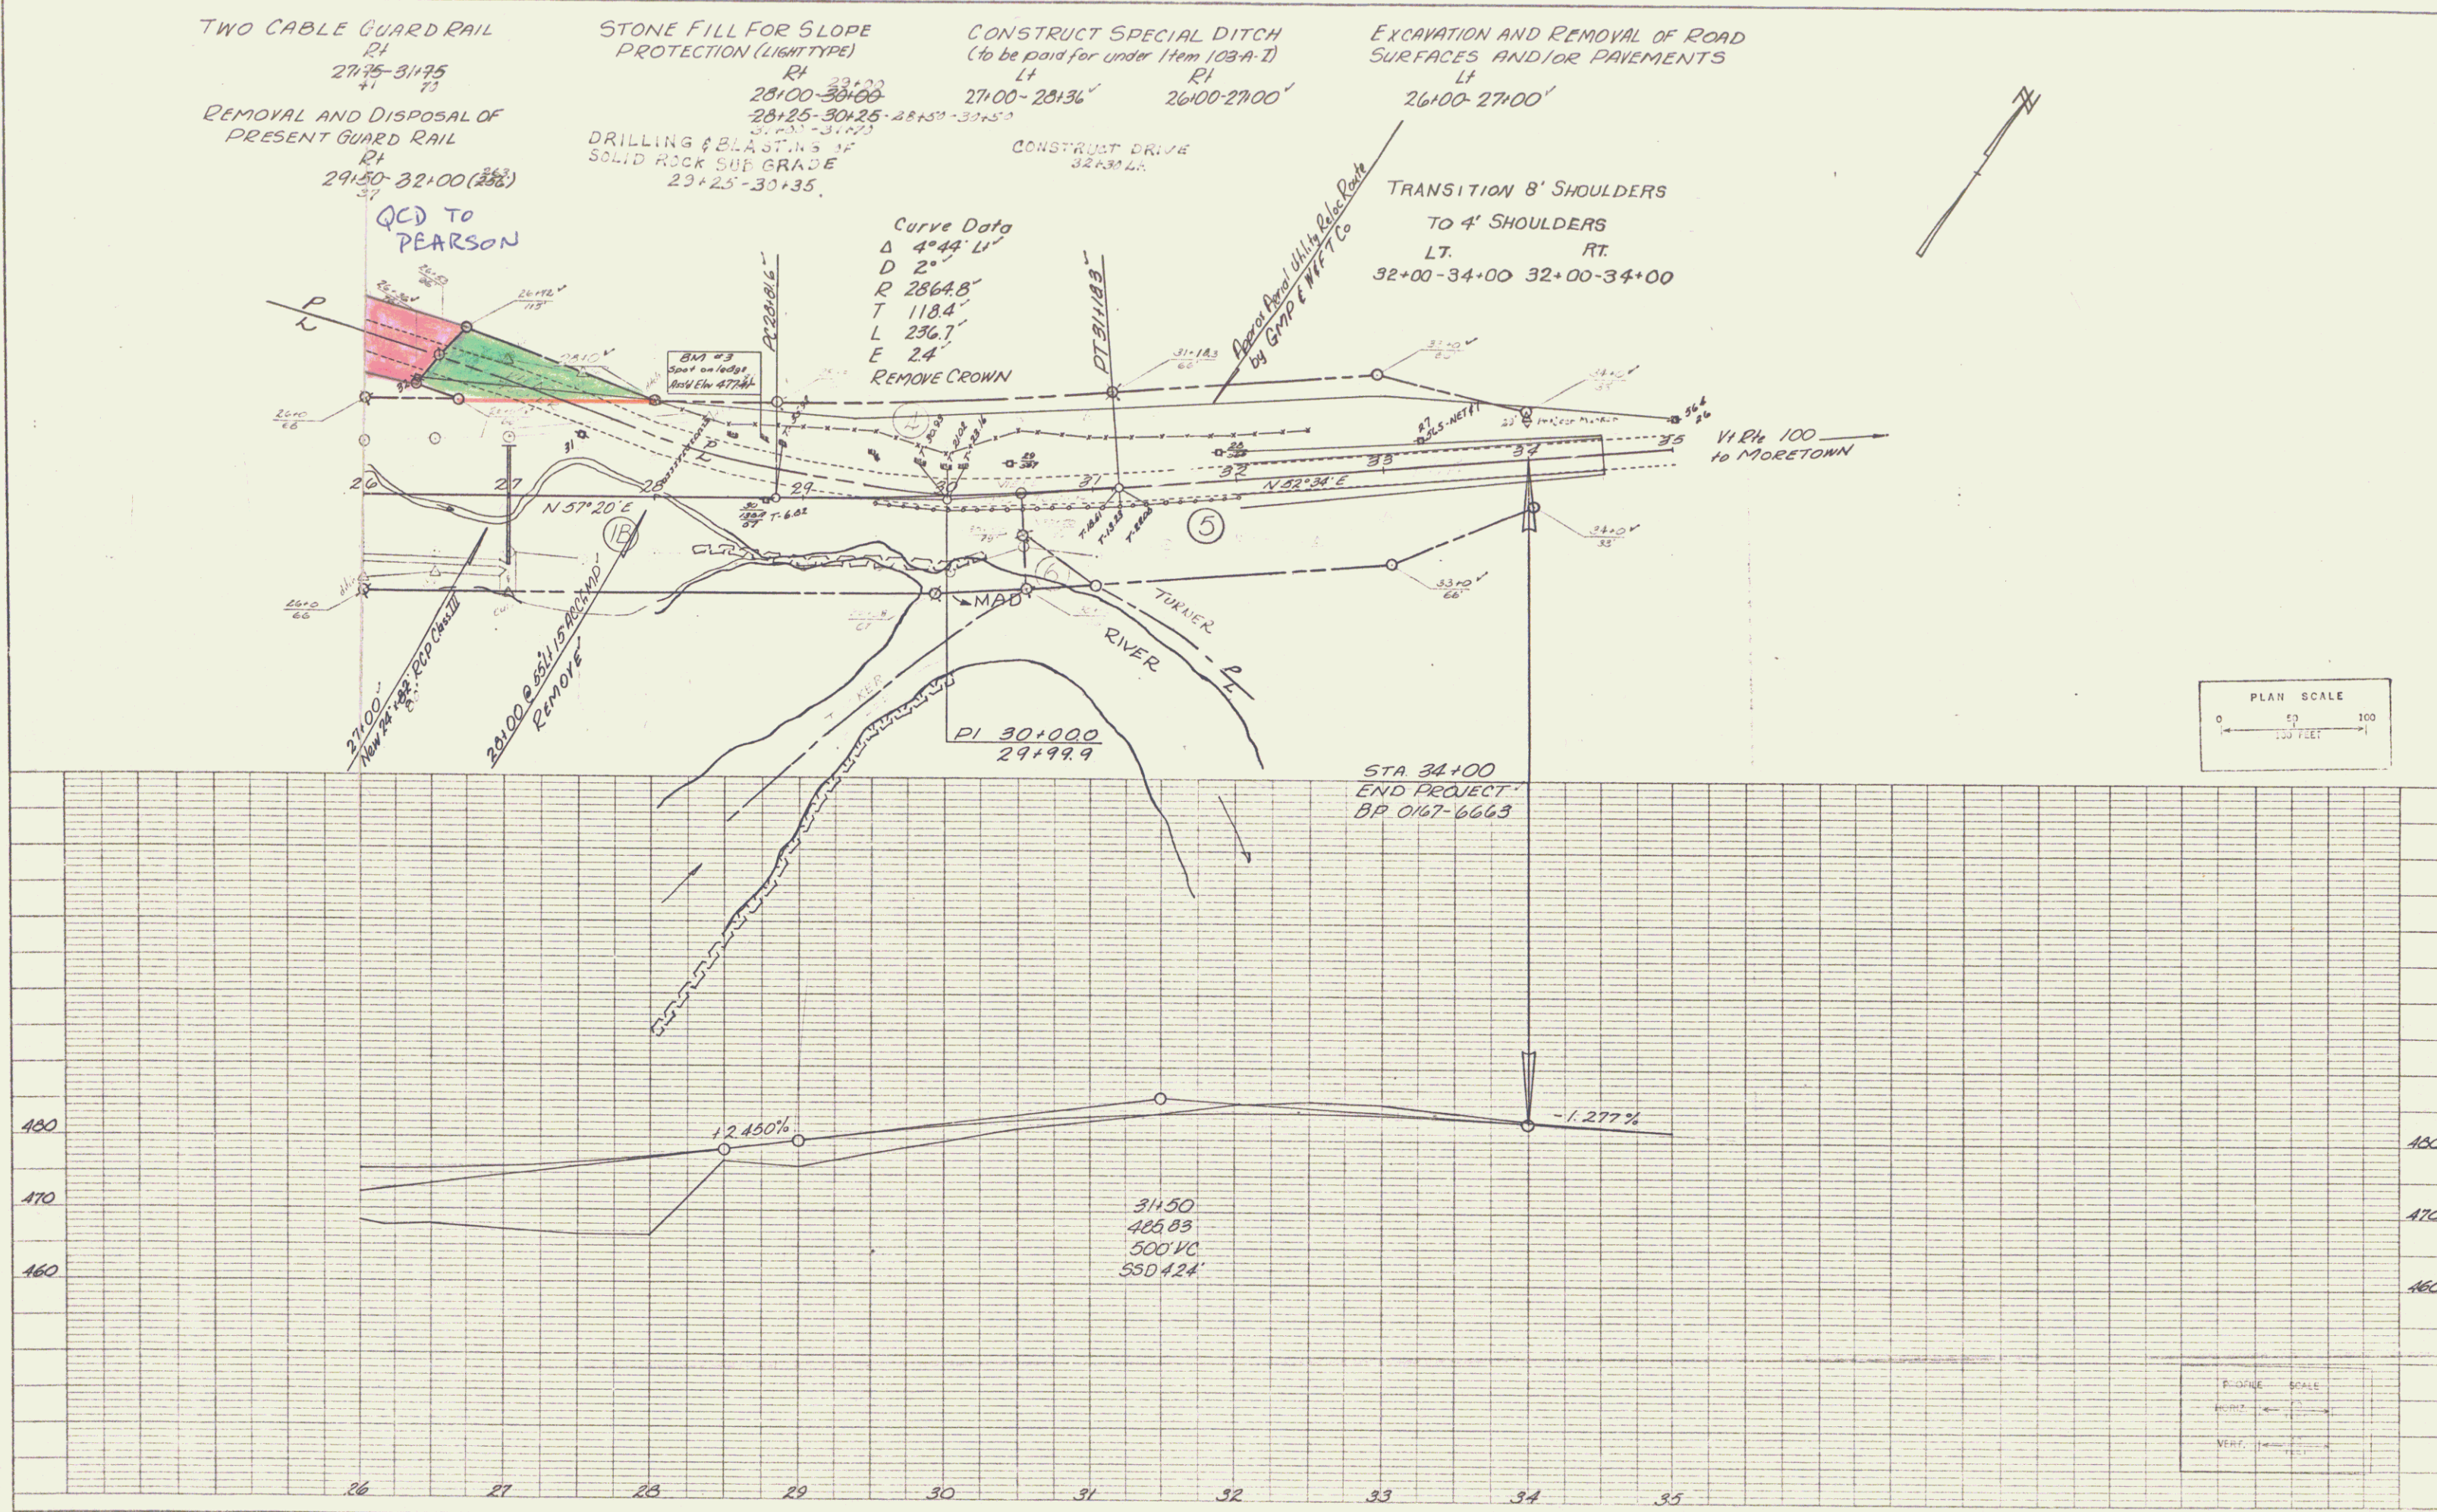

K&E PLATE 1, PLAN-PROFILE
 45 7012 IMPERIAL™