


CABLE GUED RAIL	RT.	LT.	ANCHORS
18+74 - 19+06	RT.	32'	1
18+82 - 19+14	LT.	32'	1
19+31 - 20+31	RT.	40'	1
19+37 - 20+21	LT.	26'	1
TOTALS ROWY.	72'	56'	4
TOTALS BRIDGE	83'	85'	

SKETCH SHOWING G.R.M. WALL RT. STA. 17155-17156

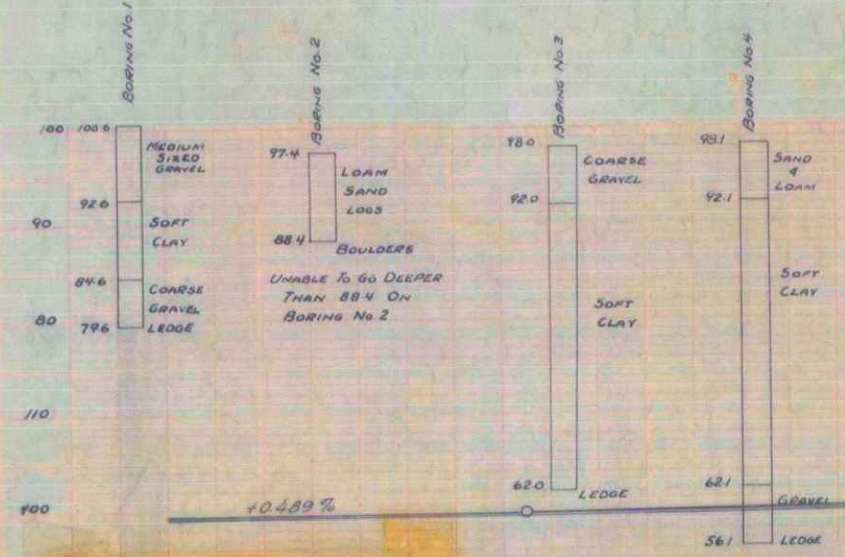


STA 17+00
BEGIN STATE PROJECT 157-N
INDEX OF SHEETS
1-2 PLAN & PROFILE SHEETS
3 ABUTMENT DETAILS
4 SUPERSTRUCTURE DETAILS
5 S.B.-SC - CURB & RAIL
6 S-30 - CABLE GUED RAIL
7 S.B-20-DETAILS C.E.L.L. & GEN. NOTES
8 S-11 - SIGNS, LIGHTS & BARRICADES
9-14 SECTIONS.

TYPE	BRIDGE DATA	
	PARENT	PROPOSED
OVERALL SPAN	45.7'	84'
ROADWAY WIDTH	15'	24'
CLEAR HEIGHT	4.8' AN	8'
WATERWAY	41.1'±	38.7'±
ABUTMENTS	DRY STONE-POOR	STUB ON PILES
FLOOR	2-LAYERS 3" PLANK	CONCRETE


Pin: 208625
Route: VT 100
Date: 01/01/1939

APPROVED: *January 1, 1938*
DISTRICT HIGHWAY ENGINEER
CORRECT: *A.D. Bishop*
BRIDGE ENGINEER
APPROVED: *May 4, 1938*
COMMISSIONER OF HIGHWAYS

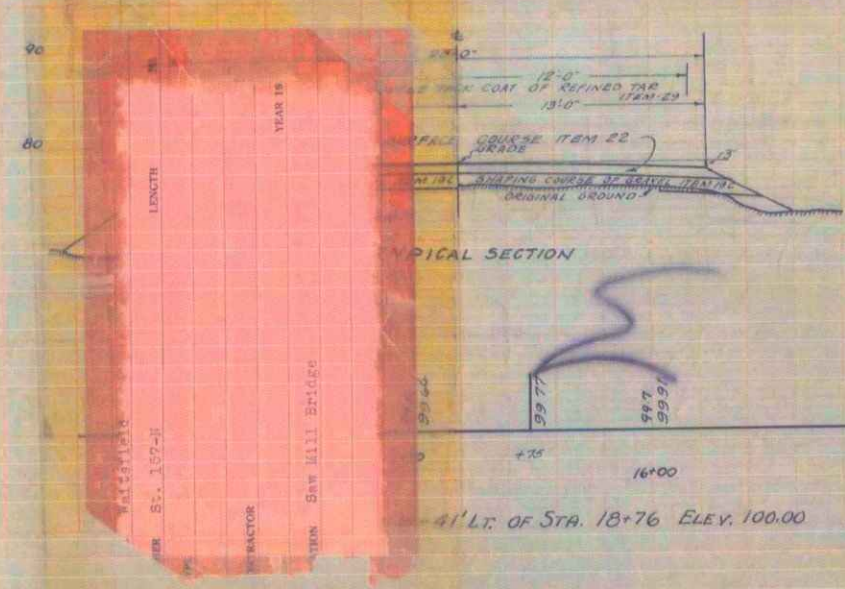

PARCEL INSTRUMENT	DATE	GRANTOR	GRANTEE	RECORDED	WAITSFIELD	BOOK	PAGE	DATE
A-B	Q.C.D.	4-12-30	CHARLES F. NEW	ST. OF VT.	17	192-3	4-15-38	

NOTE: PILES FOR ABUT. #1 ASSUMED TO BE 15' LONG AND FOR ABUT. #2 - 35' LONG FOR ESTIMATING PURPOSES ONLY. PILES TO BE DRIVEN TO A BEARING VALUE OF 20 TONS EACH.

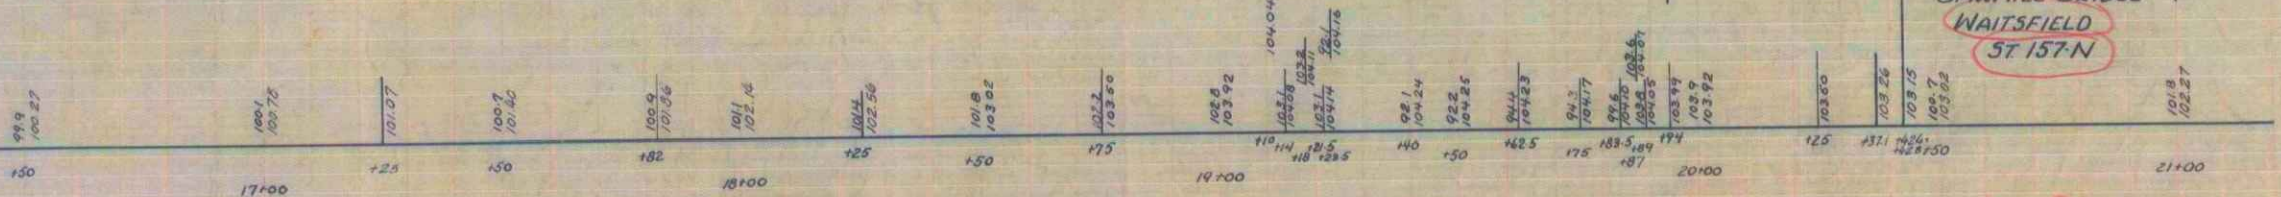

SEE SHEET No. 2 FOR ESTIMATE OF QUANTITIES

SAWMILL BRIDGE
WAITSFIELD
ST 157-N