



PLAN	
DATE	09/01/1961
BY	W.F.P.
CHECKED	
APPROVED	
PROJECT	MM 0.45-1.13
NO.	

PROFILE	
DATE	09/01/1961
BY	W.F.P.
CHECKED	
APPROVED	
PROJECT	MM 0.45-1.13
NO.	

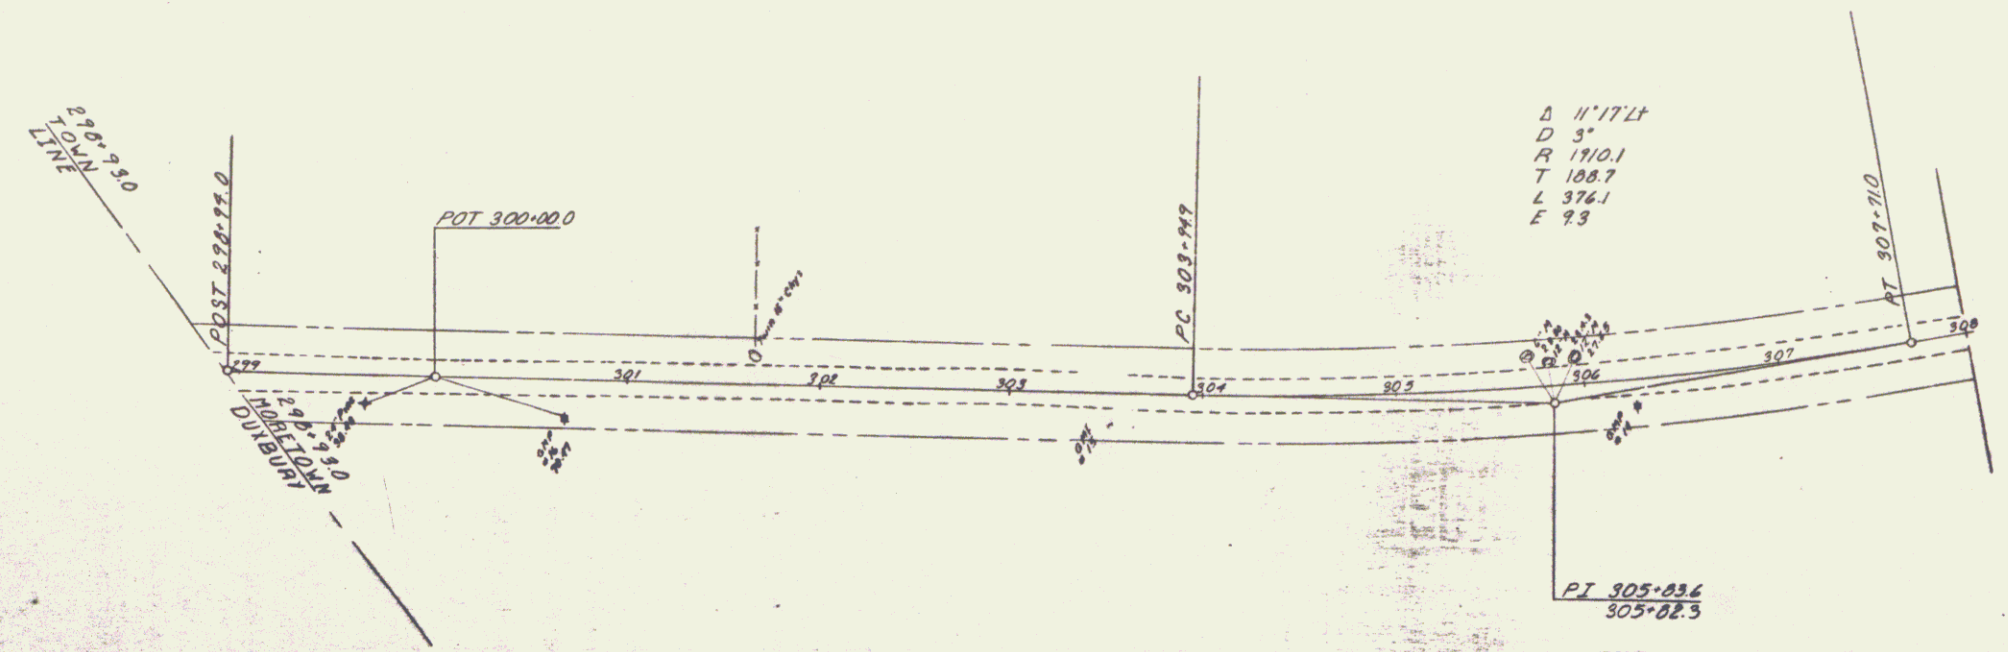

TOWN: MORETOWN
 ROUTE: VT 100
 DATE: 09/01/1961
 PROJECT: MM 0.45-1.13
 PIN: 00R627

MP 1.149-0.455

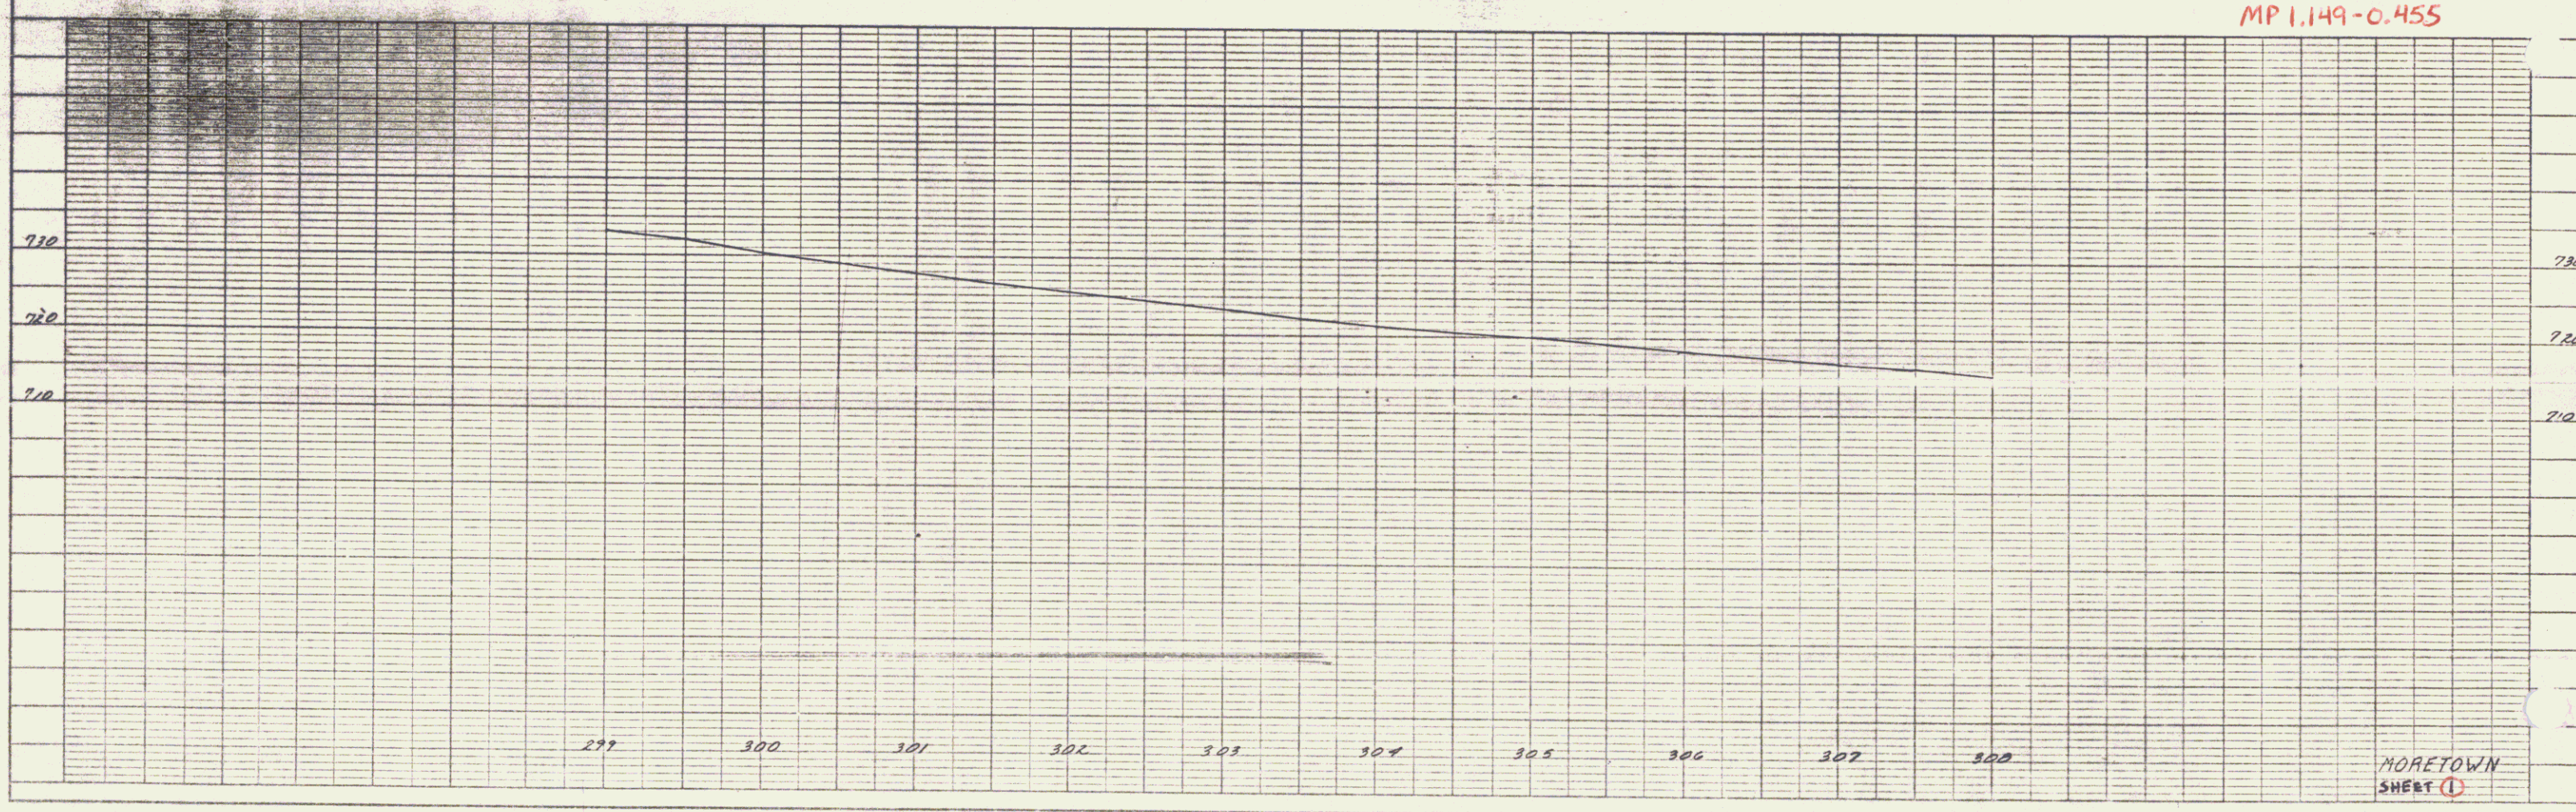

MORETOWN
 SHEET 1

PLATE 1 - PLAN - PROFILE - 0, P. R. A. E. STANDARD
 NEWELL & ESTER CO., NEW YORK
 N. Y. CO. NO. 348-100
 1961