


PLAN
 COUNTY: ...
 PROJECT: ...
 SHEET: ...
 DATE: ...

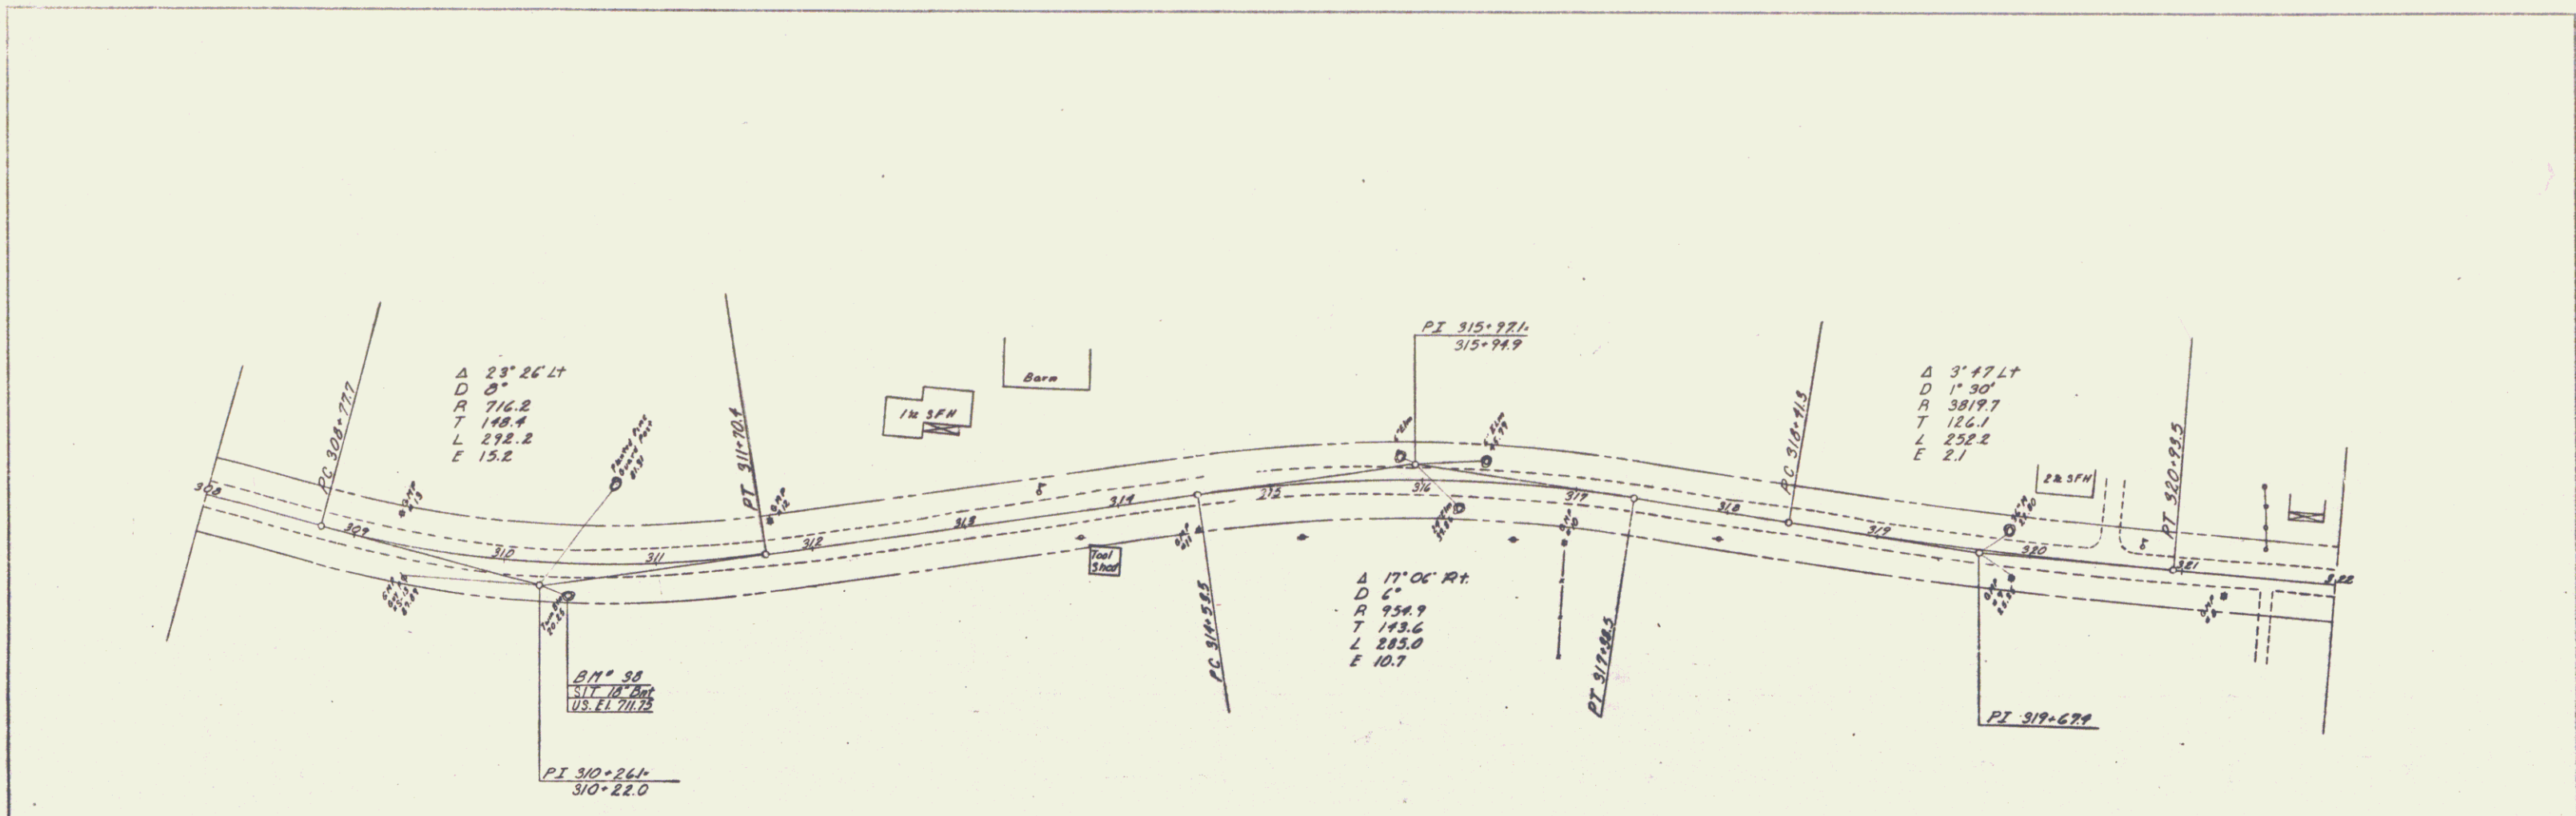

PROFILE
 COUNTY: ...
 PROJECT: ...
 SHEET: ...
 DATE: ...

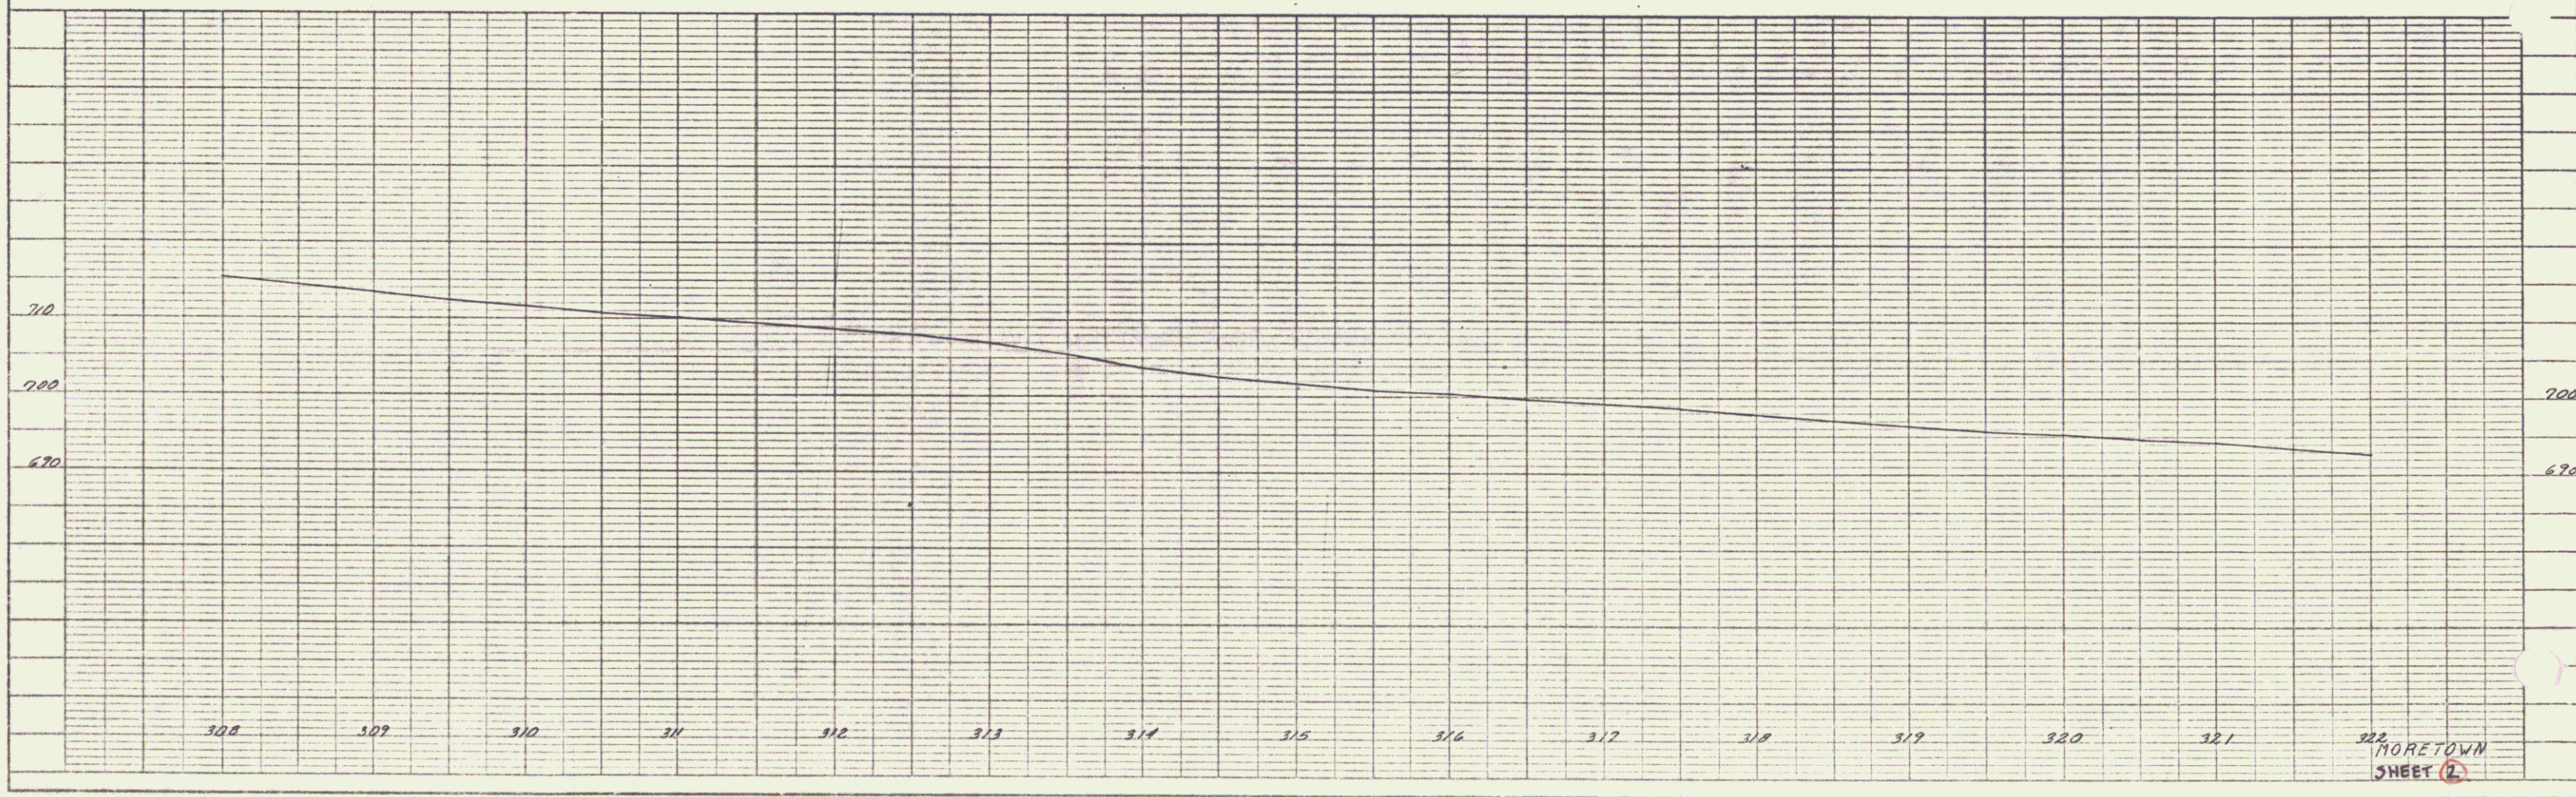


PLATE 1: PLAN PROFILE (D.P. & S.C. STANDARD)
 KLUFFEL & SUDER CO., NEW YORK
 N.Y. & C.O. No. 328-108

322
 MORETOWN
 SHEET 2