


352

RIGHT-OF-WAY DIVISION  
TOWN FILE  
PERPETUAL  
Town of VT100  
MP 045-1.13  
(To Be Returned To R.O.W. Division)

Town: MORETOWN  
Route: VT100  
DATE:

NO.	DATE	BY
1	11/11	WJH
2	11/11	WJH
3	11/11	WJH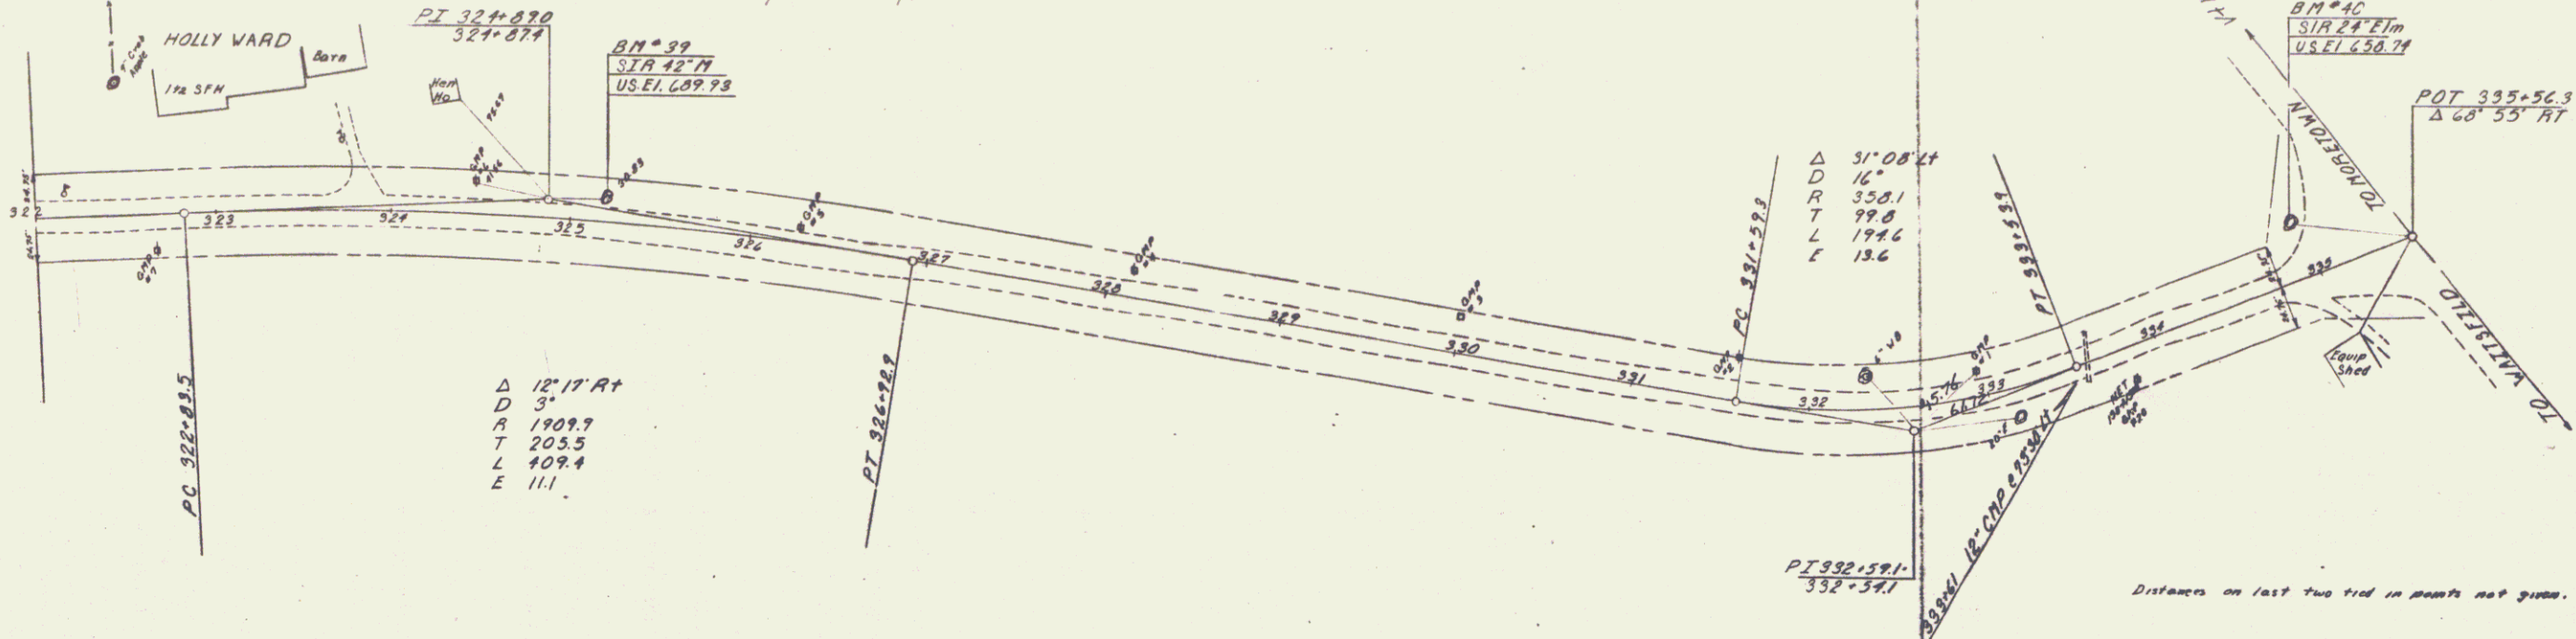
NO.	DATE	BY
1	11/11	WJH
2	11/11	WJH
3	11/11	WJH
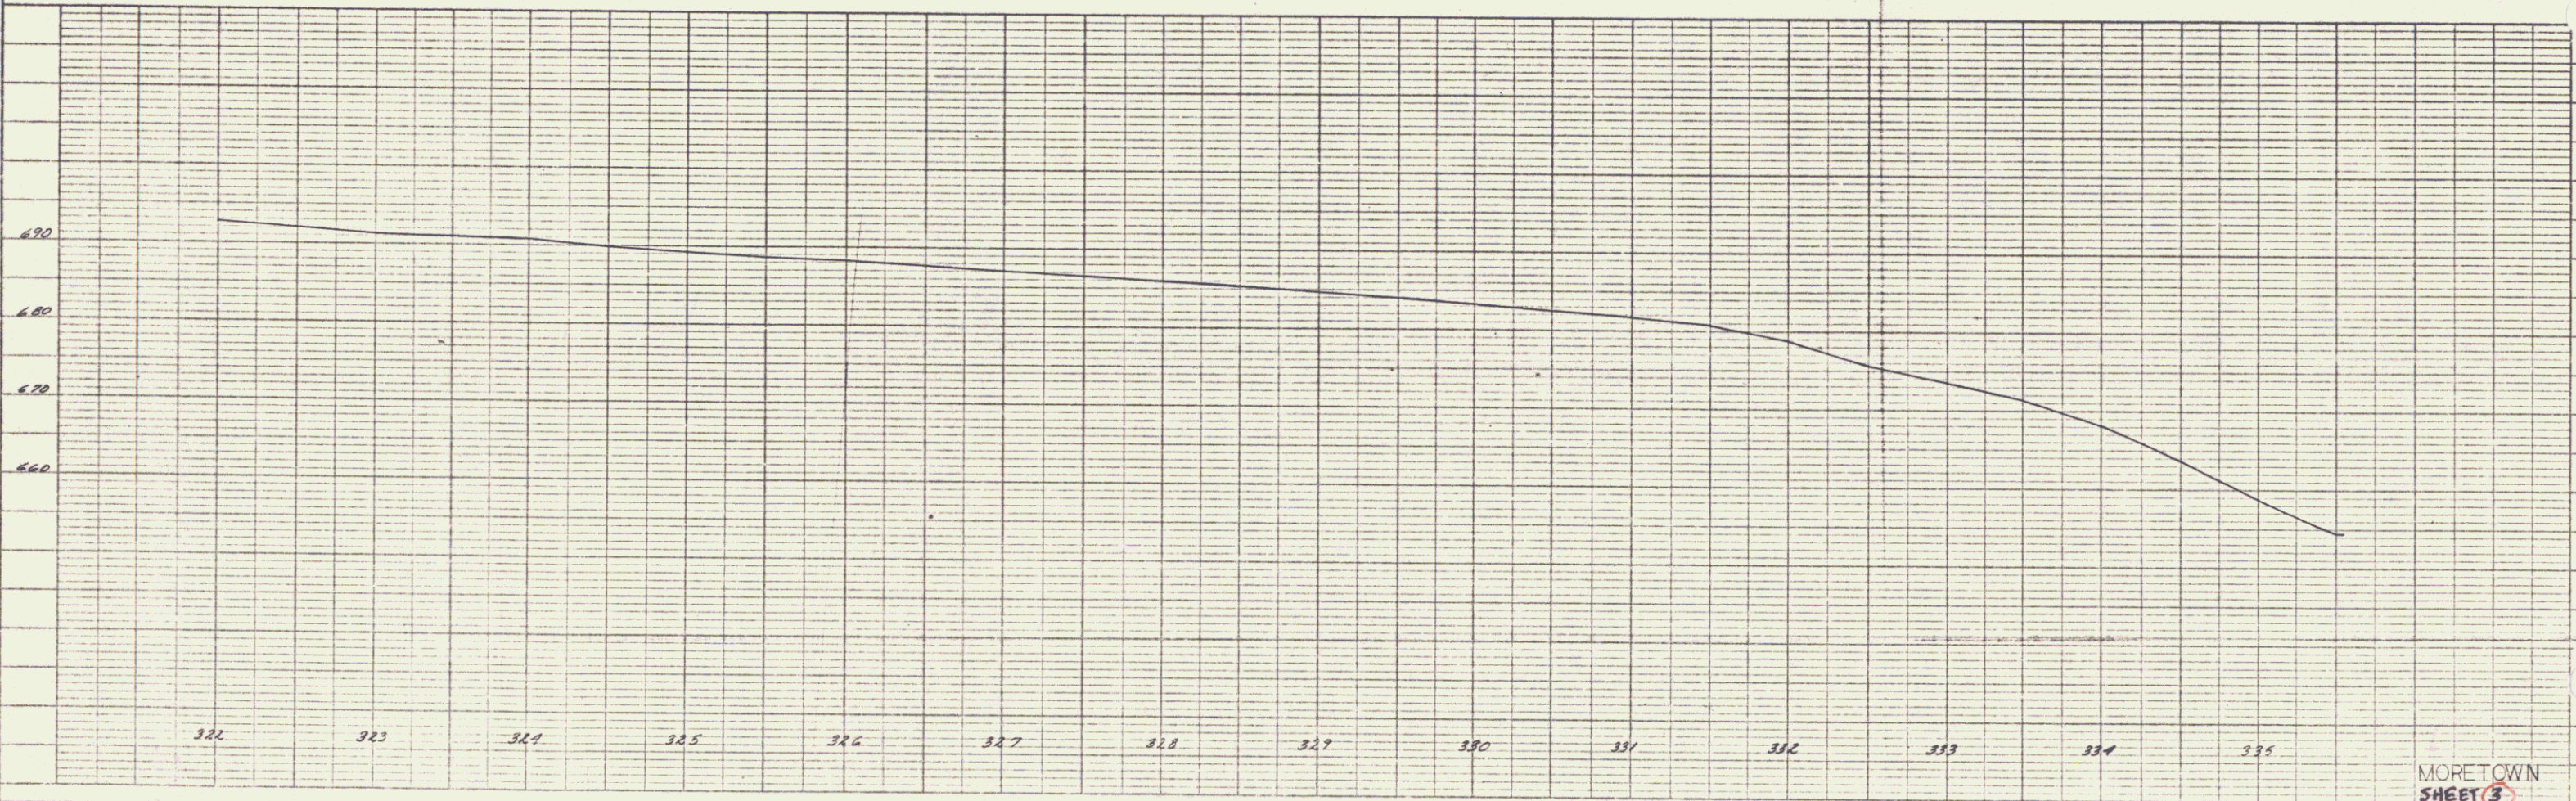


PLATE 1 - PLAN PROFILE & P.A.S.E. STANDARD  
KEMPTEL & ESSER CO., NEW YORK  
K & E CO. NO. 355-108  
NEW YORK

MORETOWN  
SHEET 3

D-350