
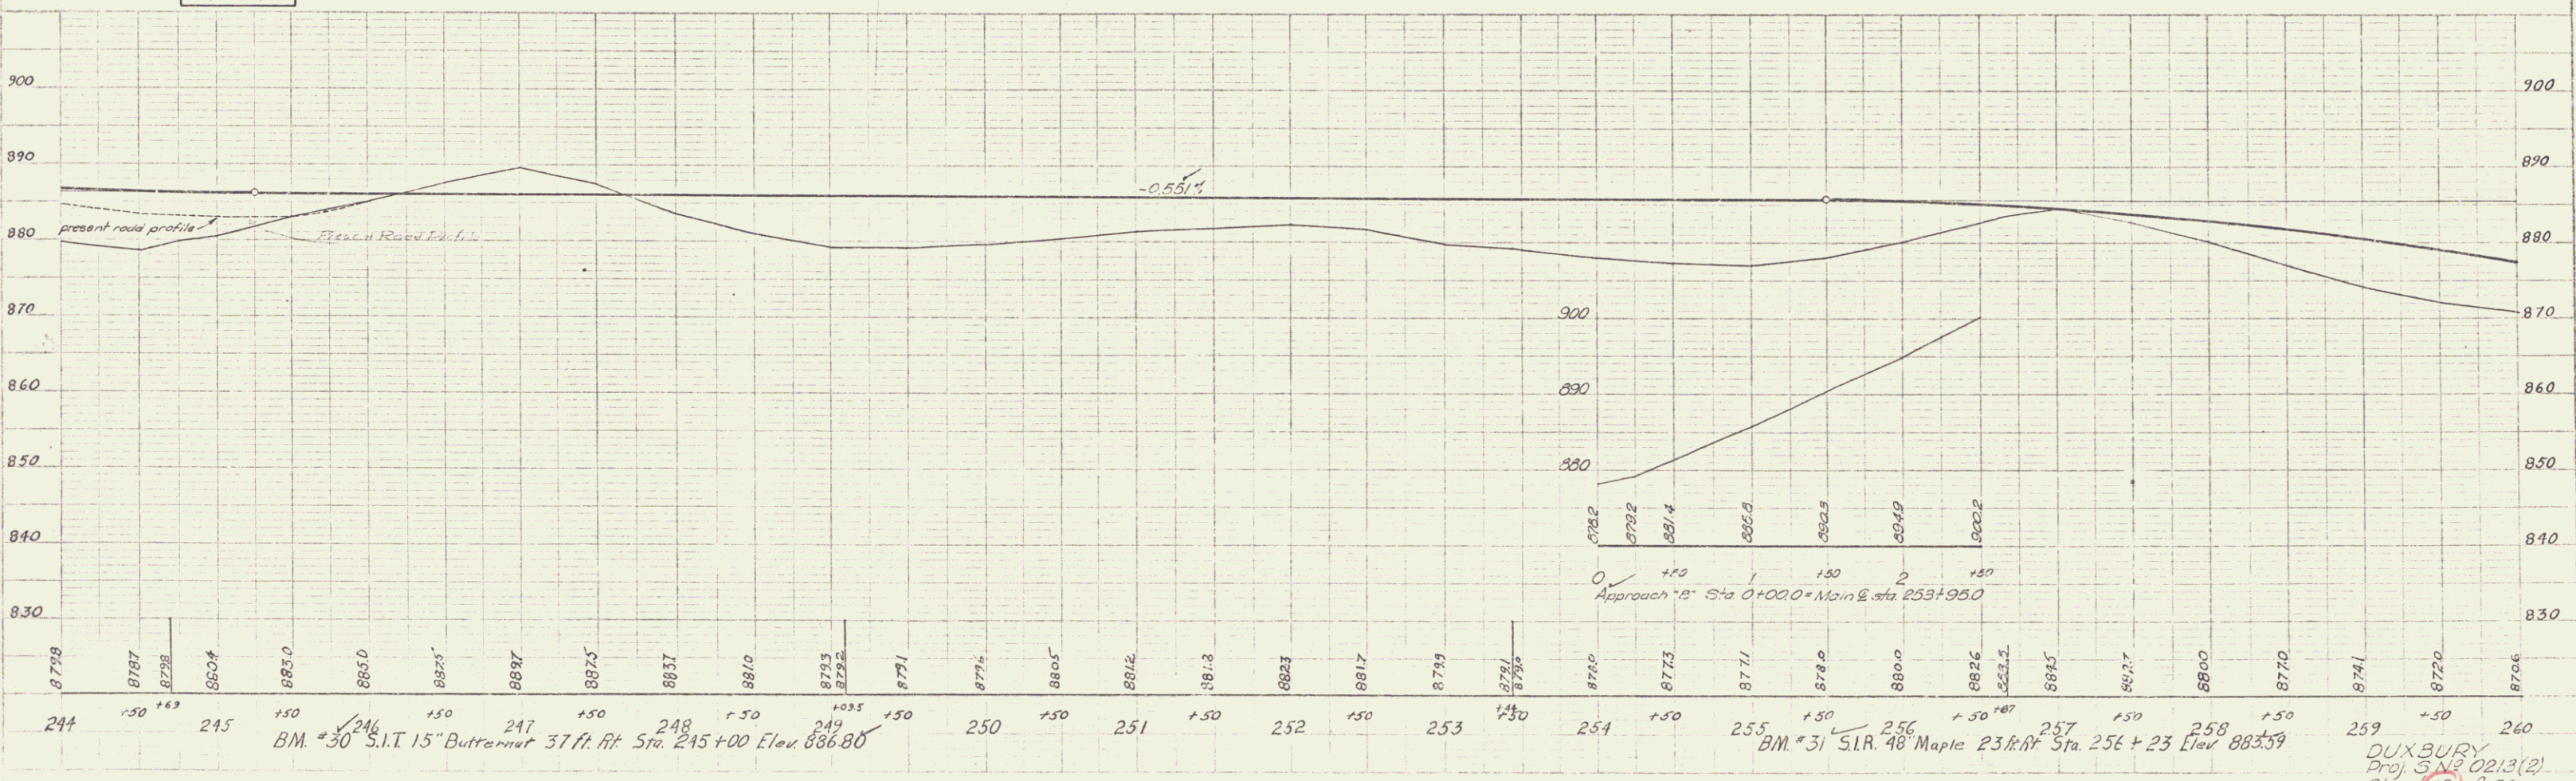


CONSTRUCT DRIVES  
 Lt Rt  
 256+15 256+07  
 251+15 251+15

CONSTRUCT APPROACH  
 Lt Rt  
 253+95 253+95

TWO CABLE GUARD RAIL  
 Lt Rt  
 247+98-252+00 247+98-251+00

WOOD GUIDE POSTS @ 10' 9"  
 Lt Rt  
 254+50-255+46 254+50-255+46

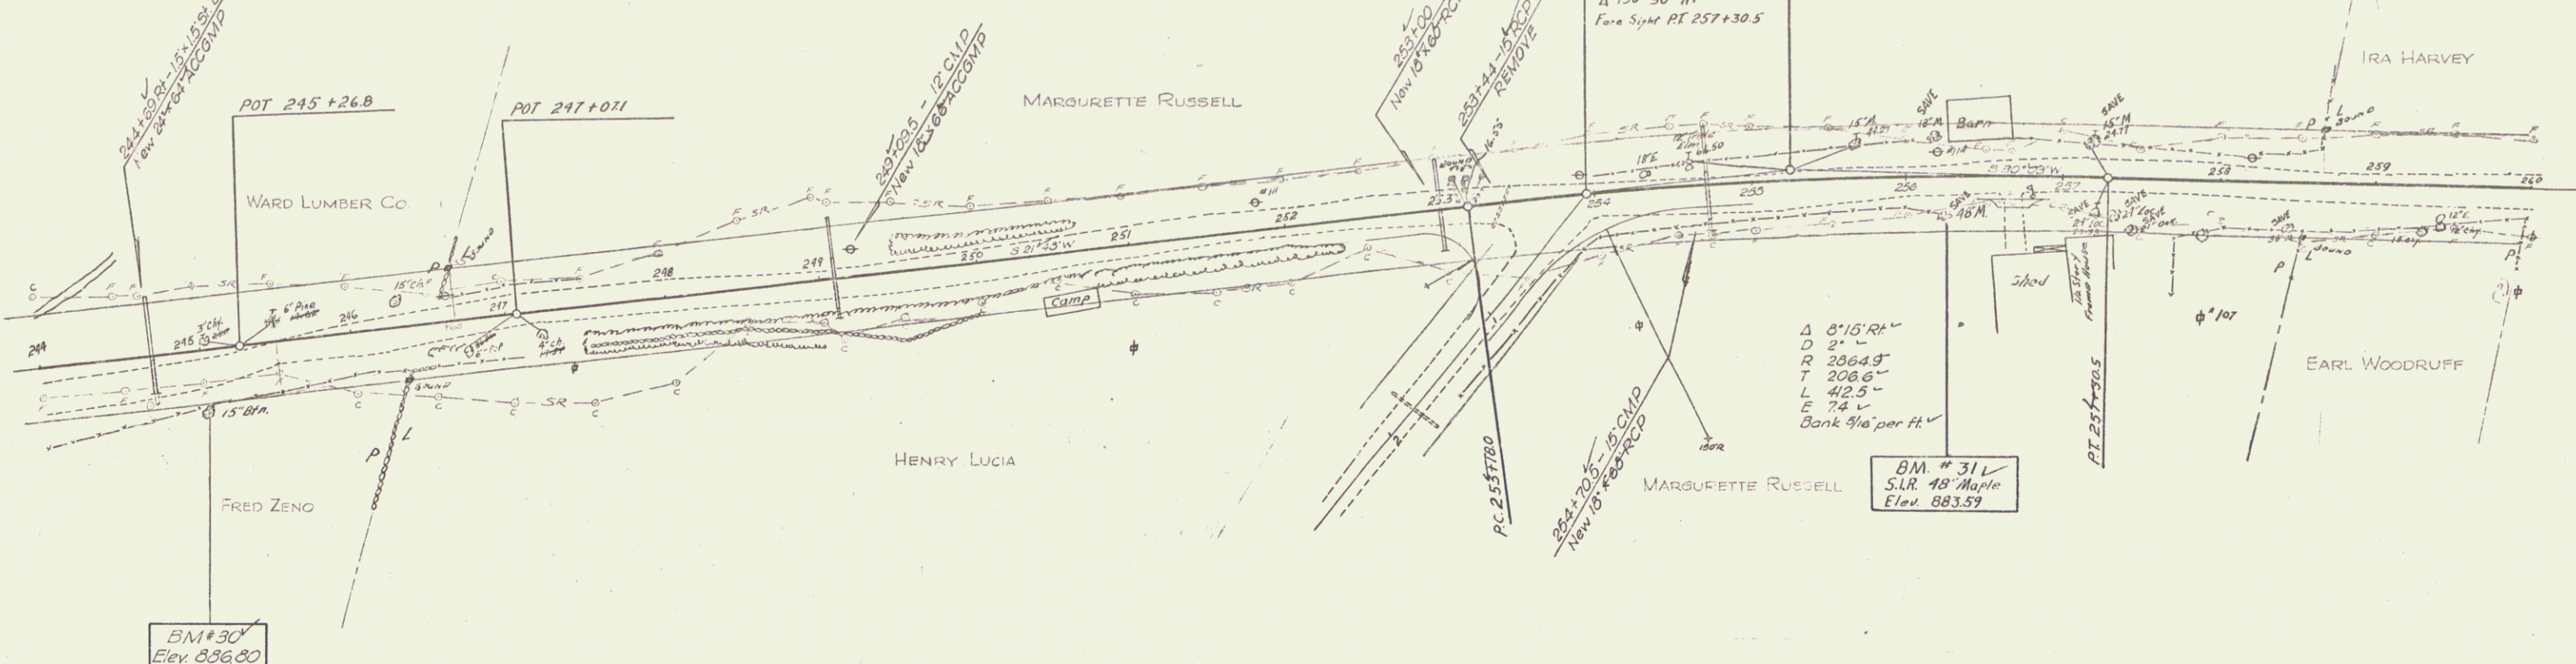

De Leo  
 A. Gagnier  
 F. Hudson

De Leo  
 F. Hudson

DUXBURY  
 Proj. 513 0213(2)  
 Sheet 10 of 56