



Delano
A. Gagnier
F. Huston

Delano
F. Huston

CONSTRUCT DRIVE
 Lt 265+00 266+50
 273+50 274+85
 277+60 278+00

CONSTRUCT TURNOUT
 Lt 274+25 275+00

Δ 26° 02' Lt
 D 51'
 R 1146.3'
 T 2650'
 L 520.7'
 E 30.2'
 Bank 3/4" in 12'

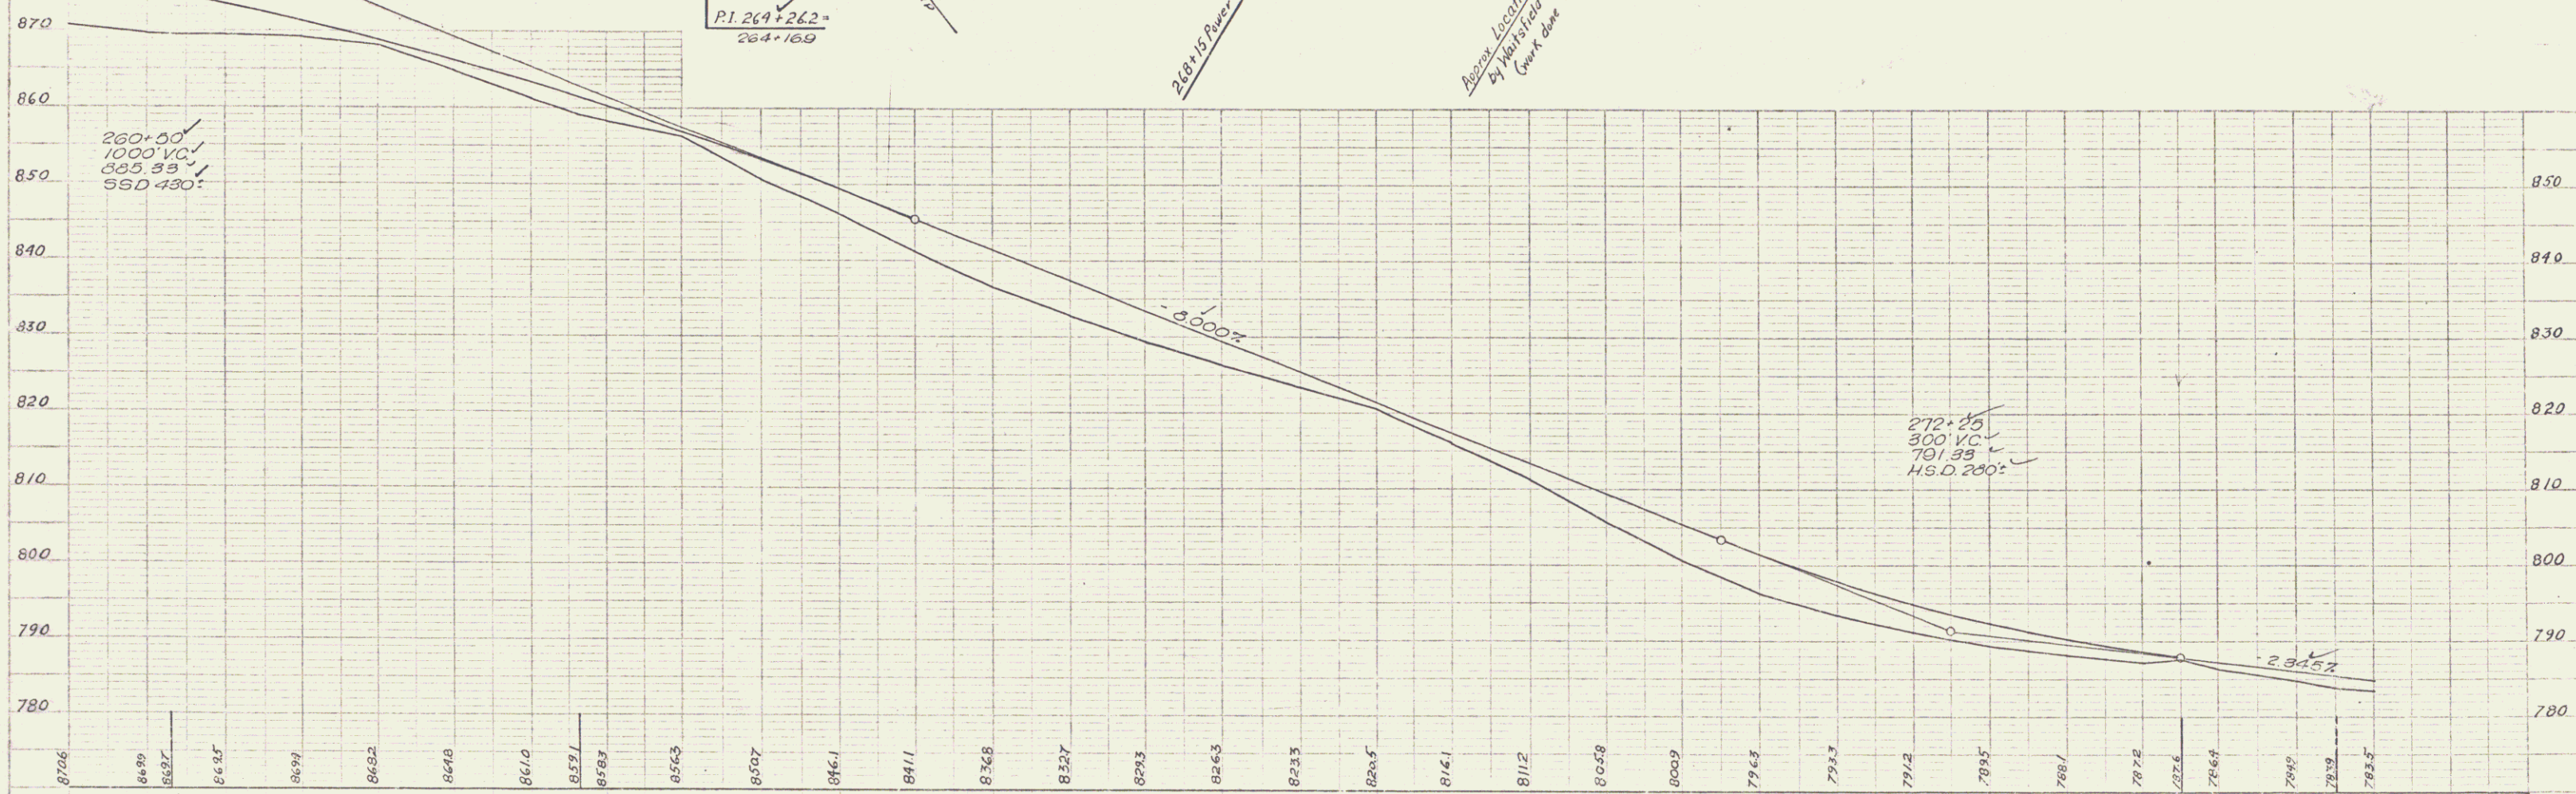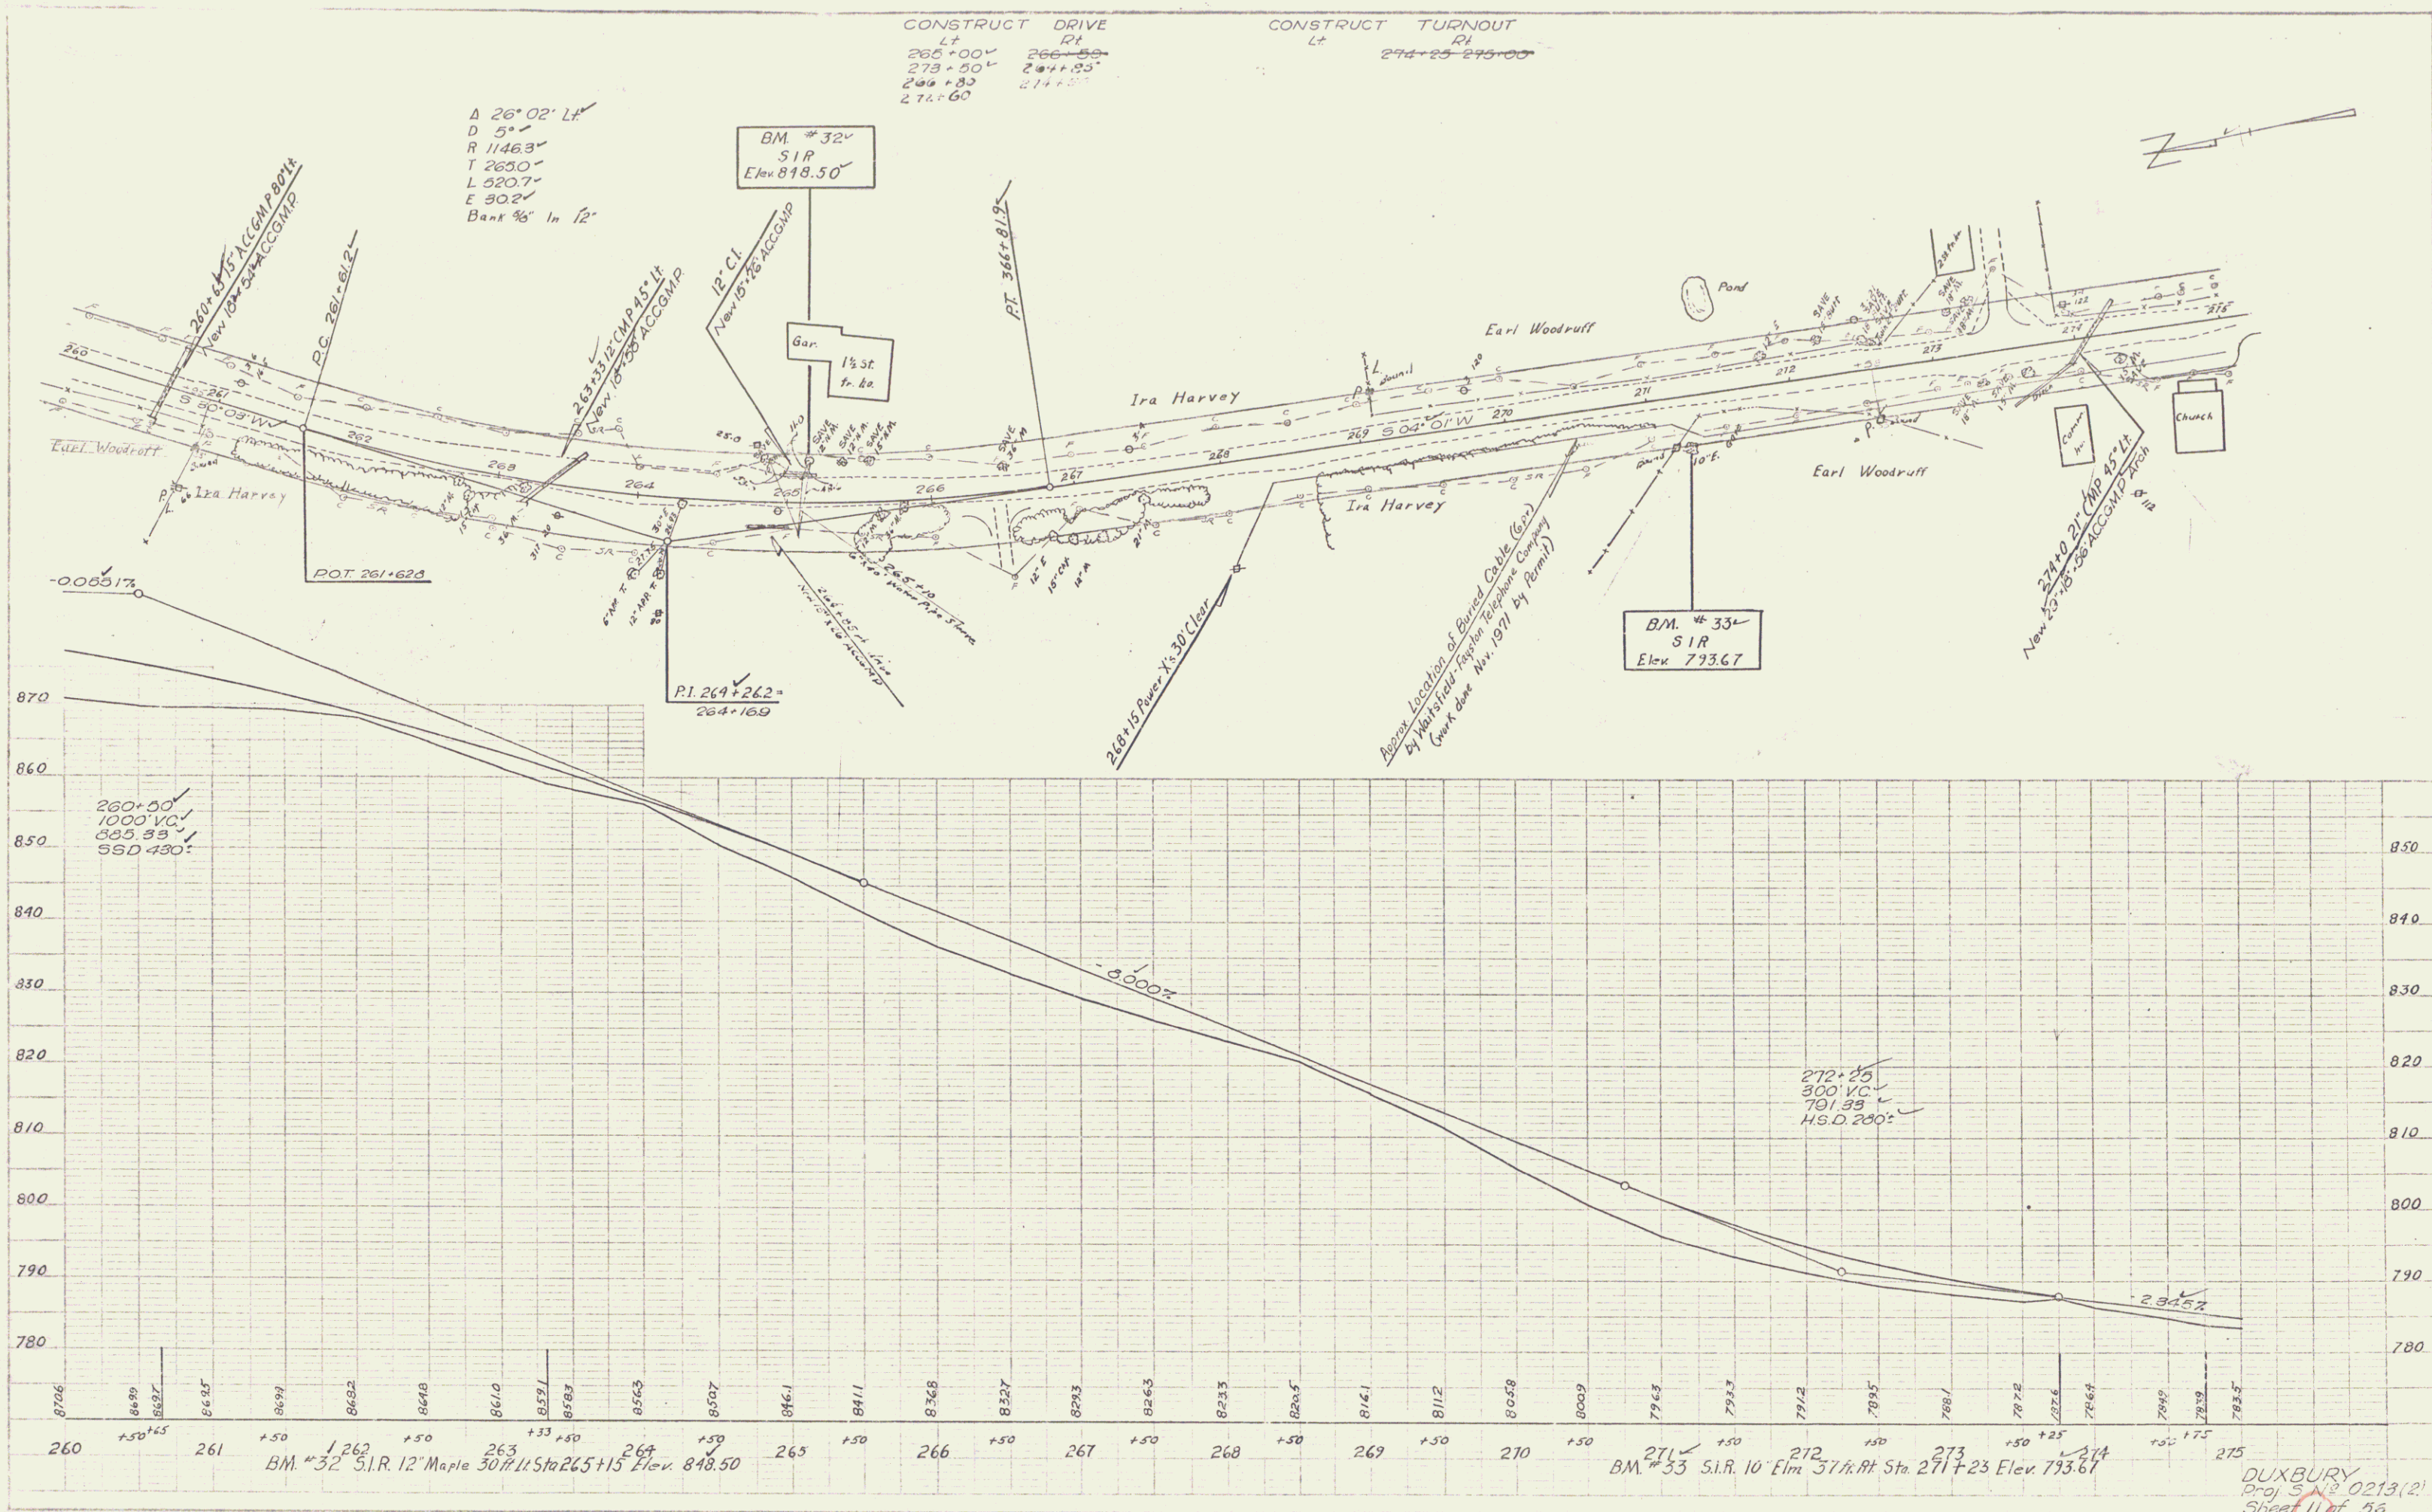

260 +50+25 261 +50 262 +50 263 +50 264 +50 265 +50 266 +50 267 +50 268 +50 269 +50 270 +50 271 +50 272 +50 273 +50 274 +50 275

B.M. #32 S.I.R. 12' Maple 30 ft. Sta 265+15 Elev. 848.50

B.M. #33 S.I.R. 10' Elm 37 ft. Sta 271+23 Elev 793.67

DUXBURY
 Proj 512 0213(2)
 Sheet 11 of 56