
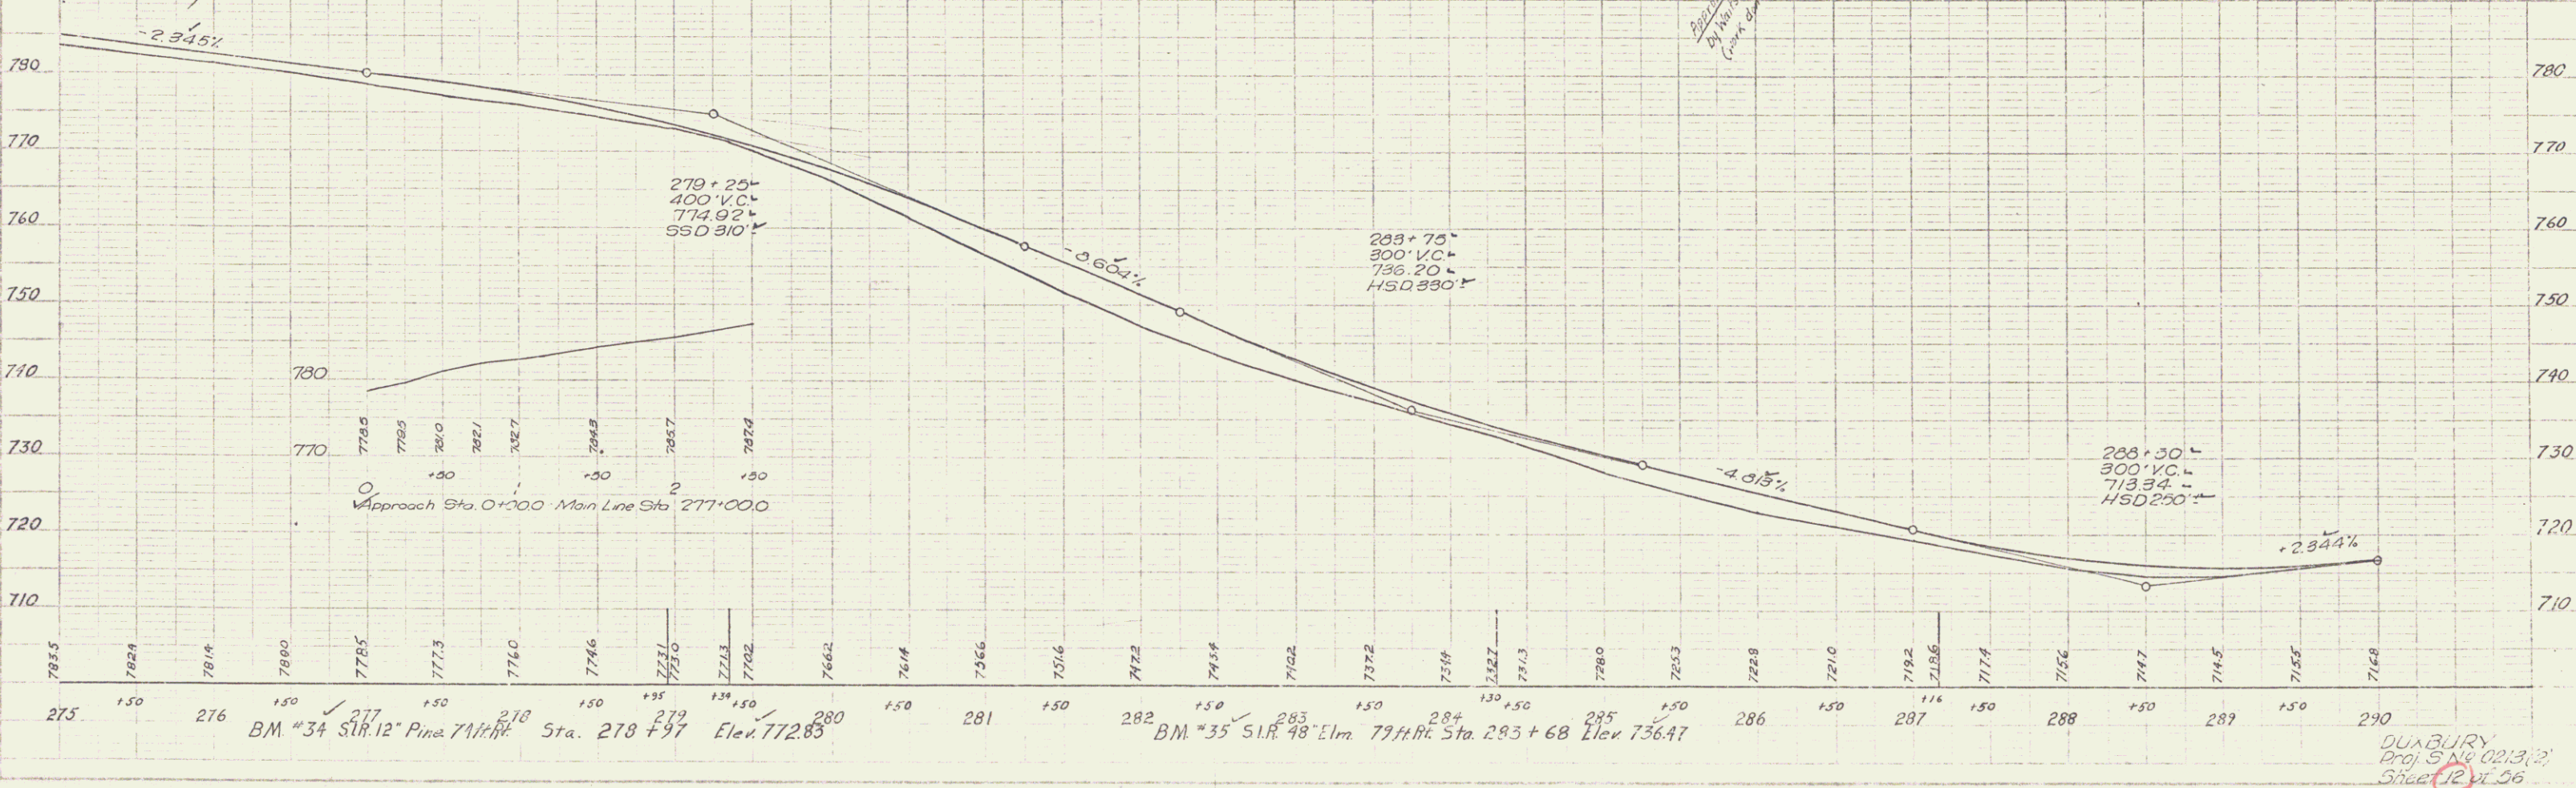


CONSTRUCT APPROACH	CONSTRUCT DRIVE	CONSTRUCT TURNOUT	TWO CABLE GUARD RAIL	REMOVAL AND DISPOSAL OF PRESENT GUARD RAIL	BITUMINOUS GROUTED STONE GUTTER
Lt Rt	Lt Rt	Lt Rt	Lt Rt	Lt Rt	Lt Rt
217+00	276+10 277+50 278+34 283+00 284+50 287+16 287+55	284+80 285+30 286+33 287+00	289+10-290+78 291+78-292+43	289+10-290+00 290+10-290+00	276+25-290+00 278+00-273+15

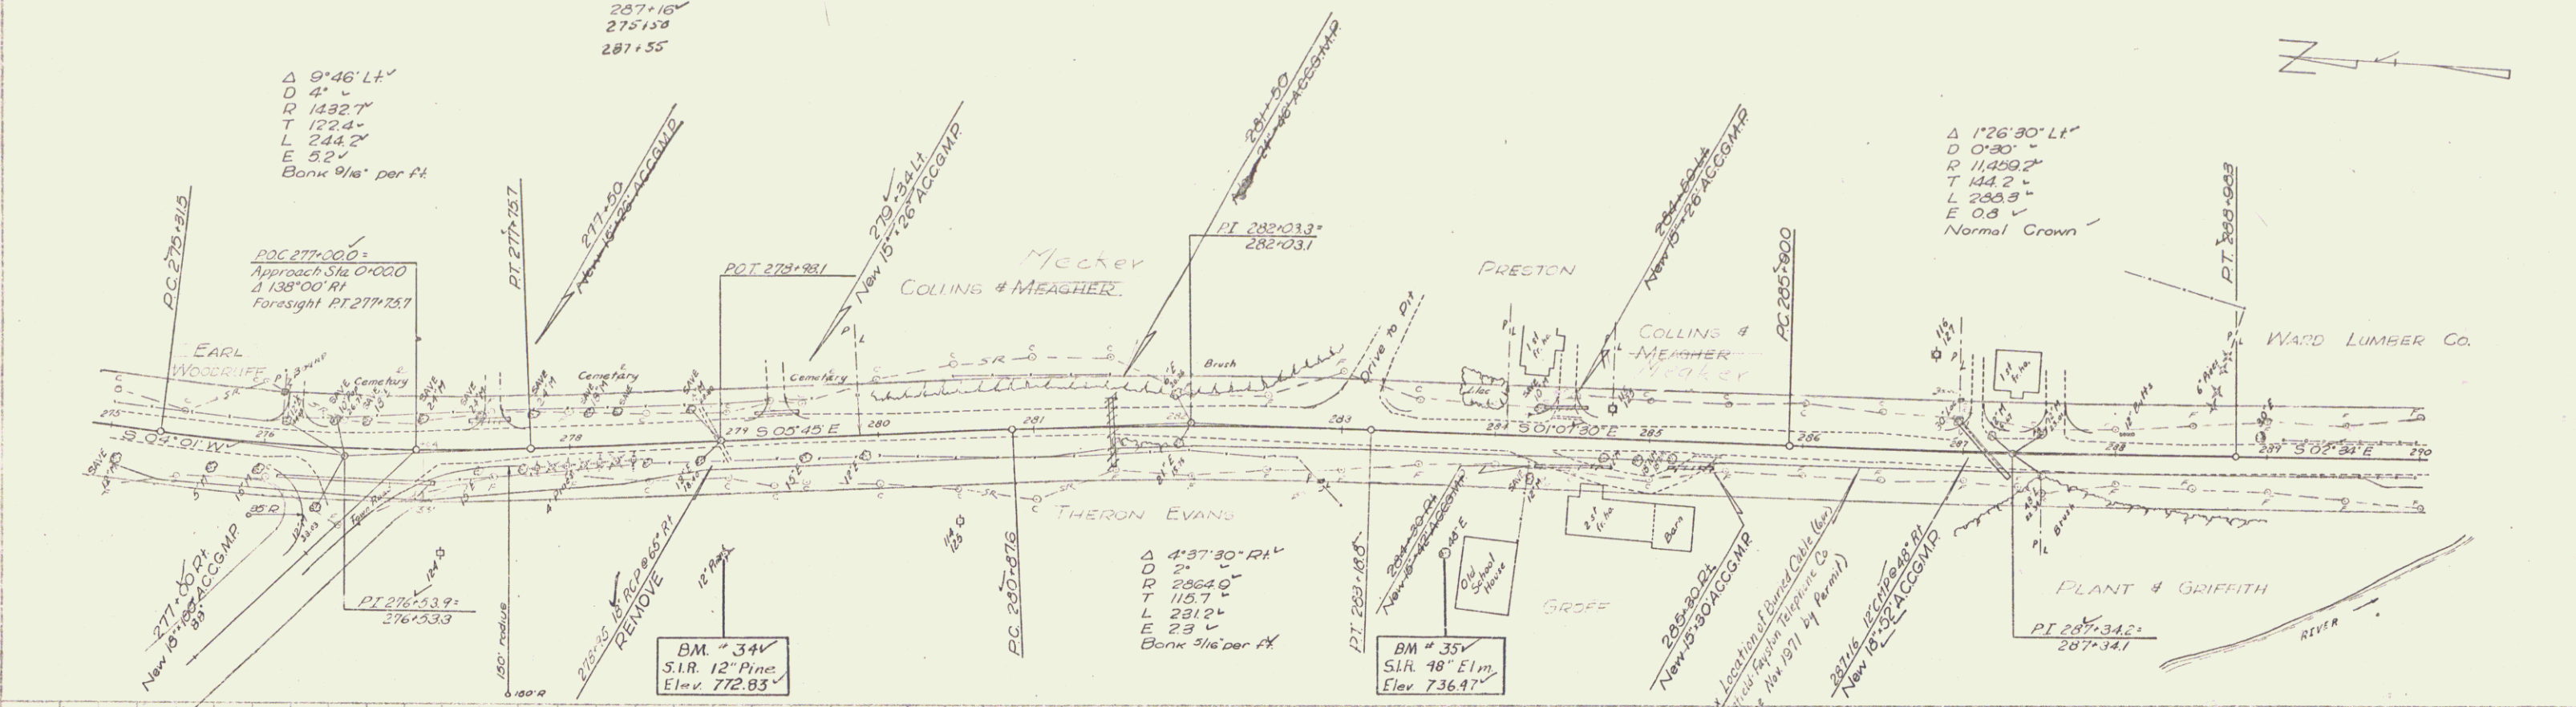

PLAN
DATE
BY
CHECKED

PROFILES
DATE
BY
CHECKED

DUNBURY
Proj. S. No. 02.13.12
Sheet 12 of 56