
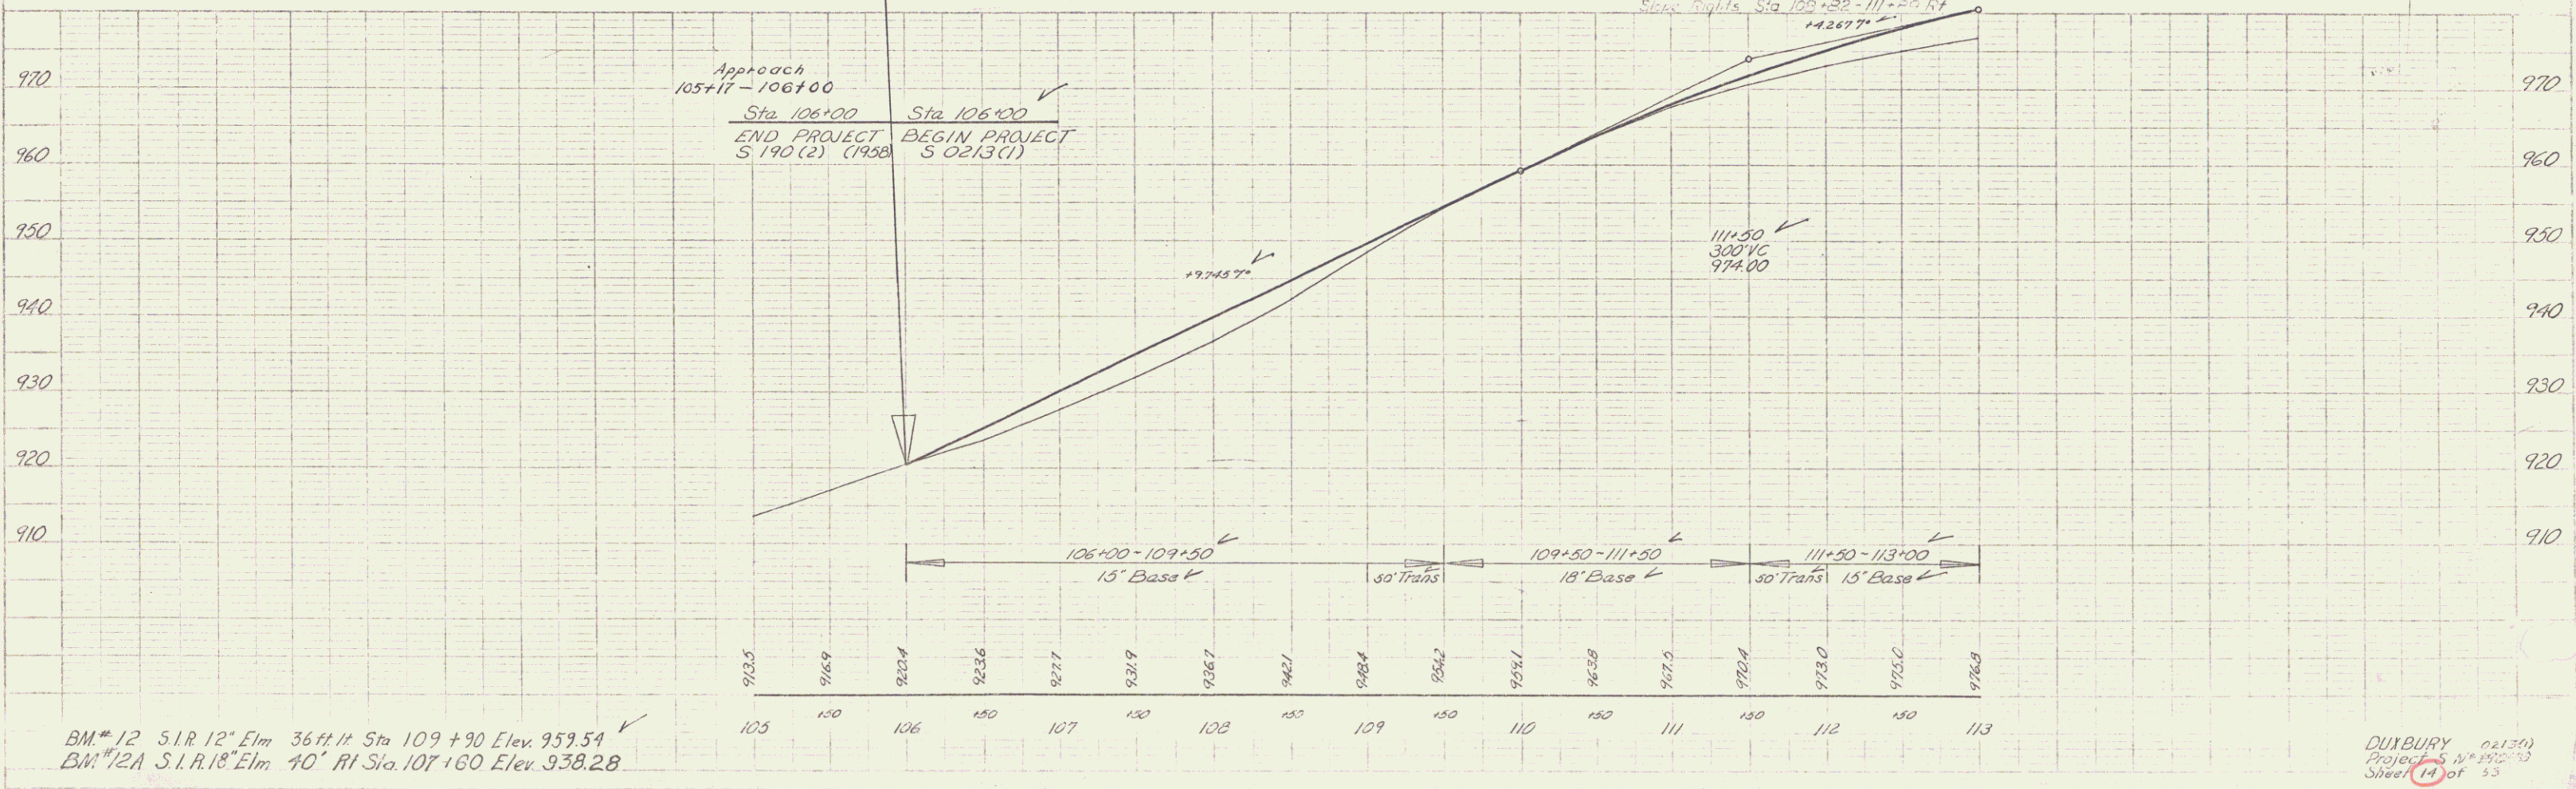


Wood Guide Posts
 Lt. Rt.
 11 105+00-107+50

Construct Drives
 110+7.1 Lt.
 111+10 Lt.

Burns
 9/57

Burns
 9/57

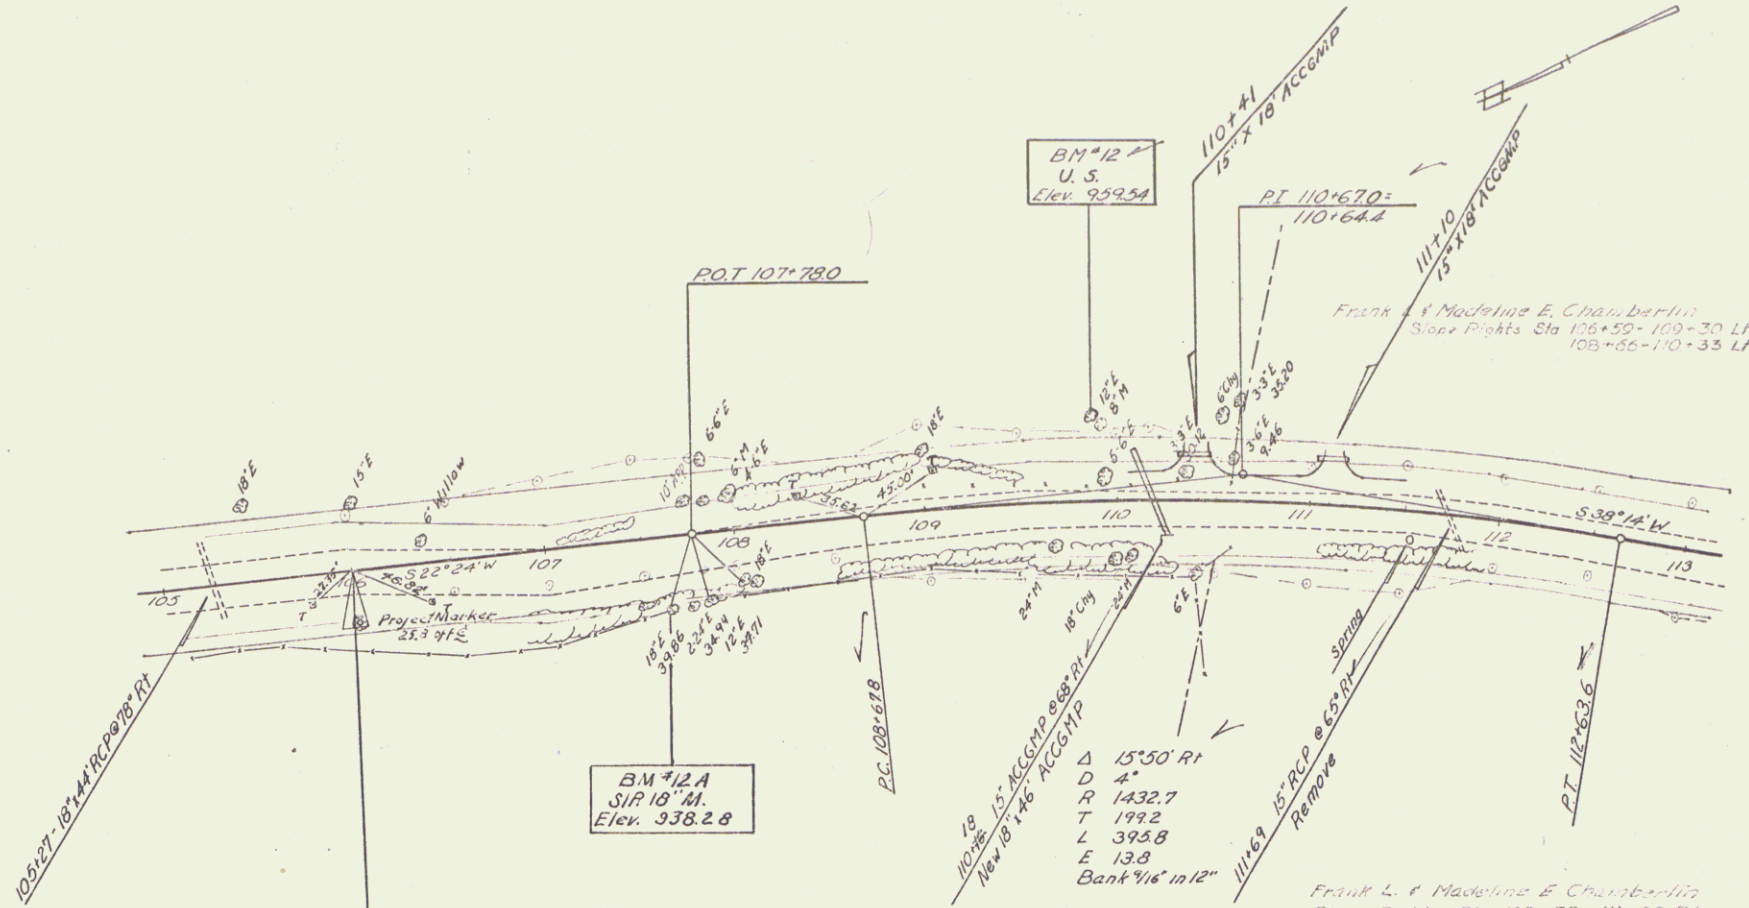

BM #12 S.I.R. 12" Elm 36ft. H. Sta 109+90 Elev. 959.54
 BM #12A S.I.R. 18" Elm 40' RI Sta. 107+60 Elev. 938.28