

Wood Guide Posts
 RT 126+25-122+40
 LT 126+15


Two Cable Guard Rail
 RT 126+20-128+10

Drilling & Blasting of
 Solid Rock Subgrade
 126+00-127+50
 128+15-129+38


Construct Drives
 RT 113+88
 LT 117+75
 RT 117+75
 LT 118+90
 RT 118+33
 LT 122+62

Construct Approach
 RT 126+50

Jewett
Burns

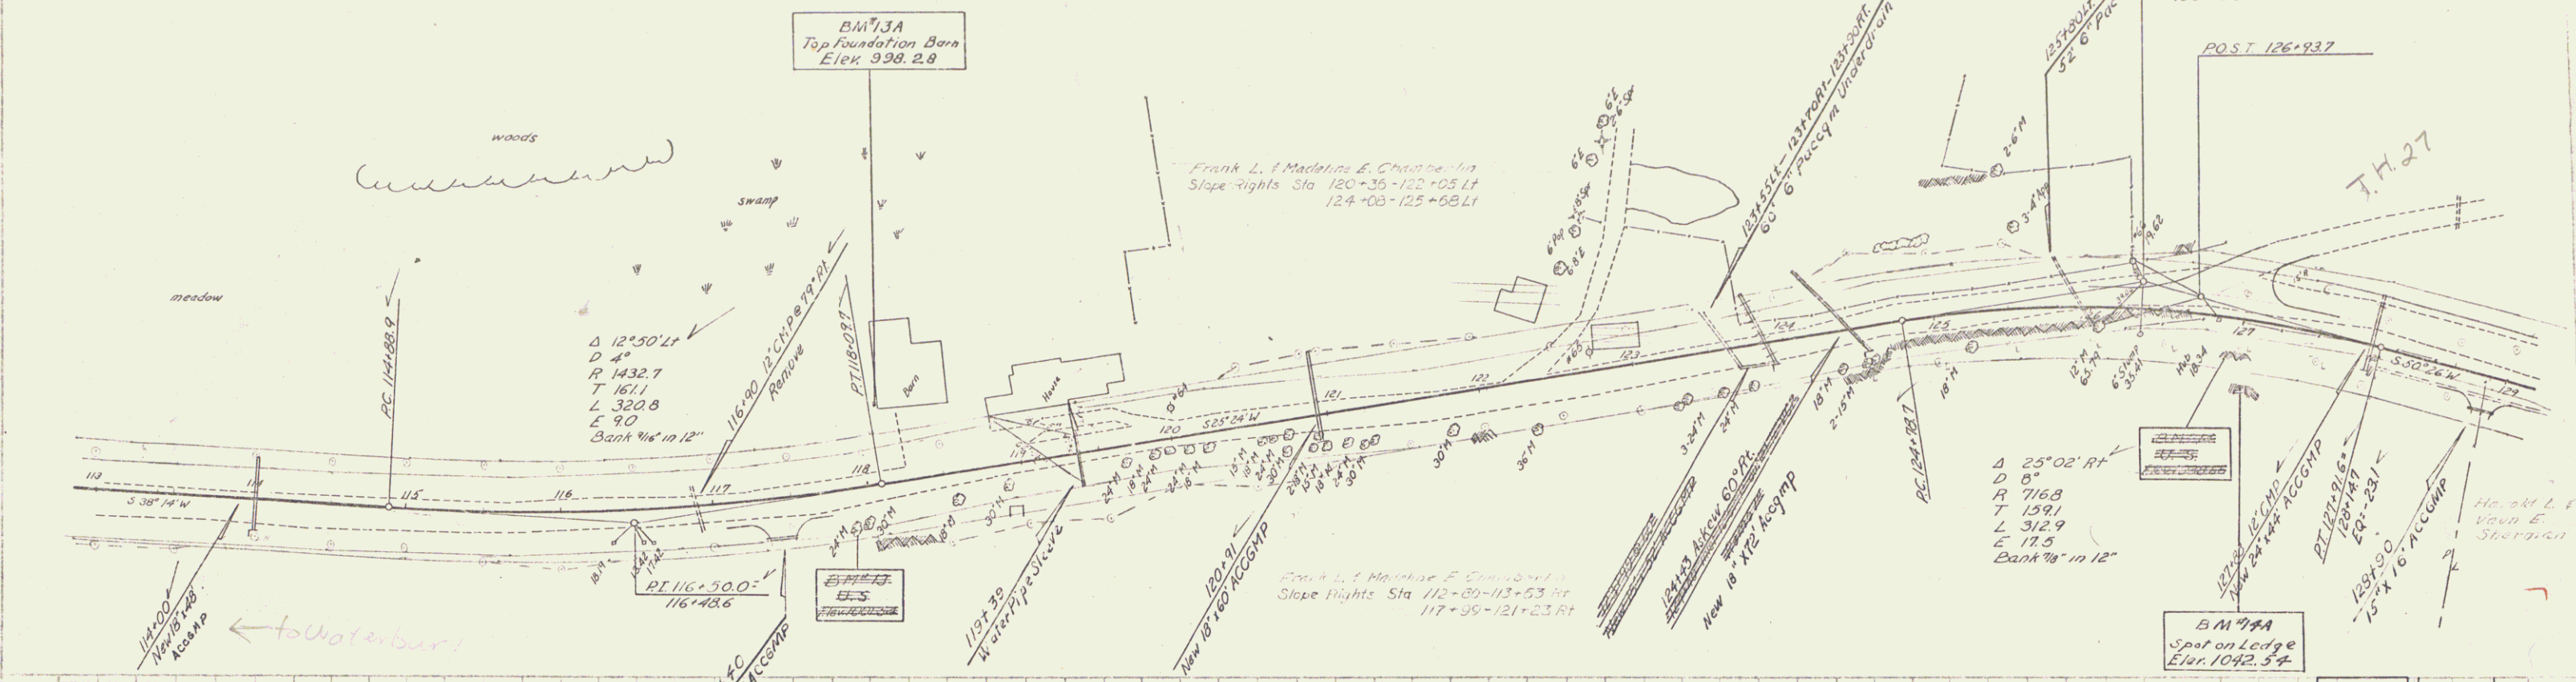

Jewett
Burns

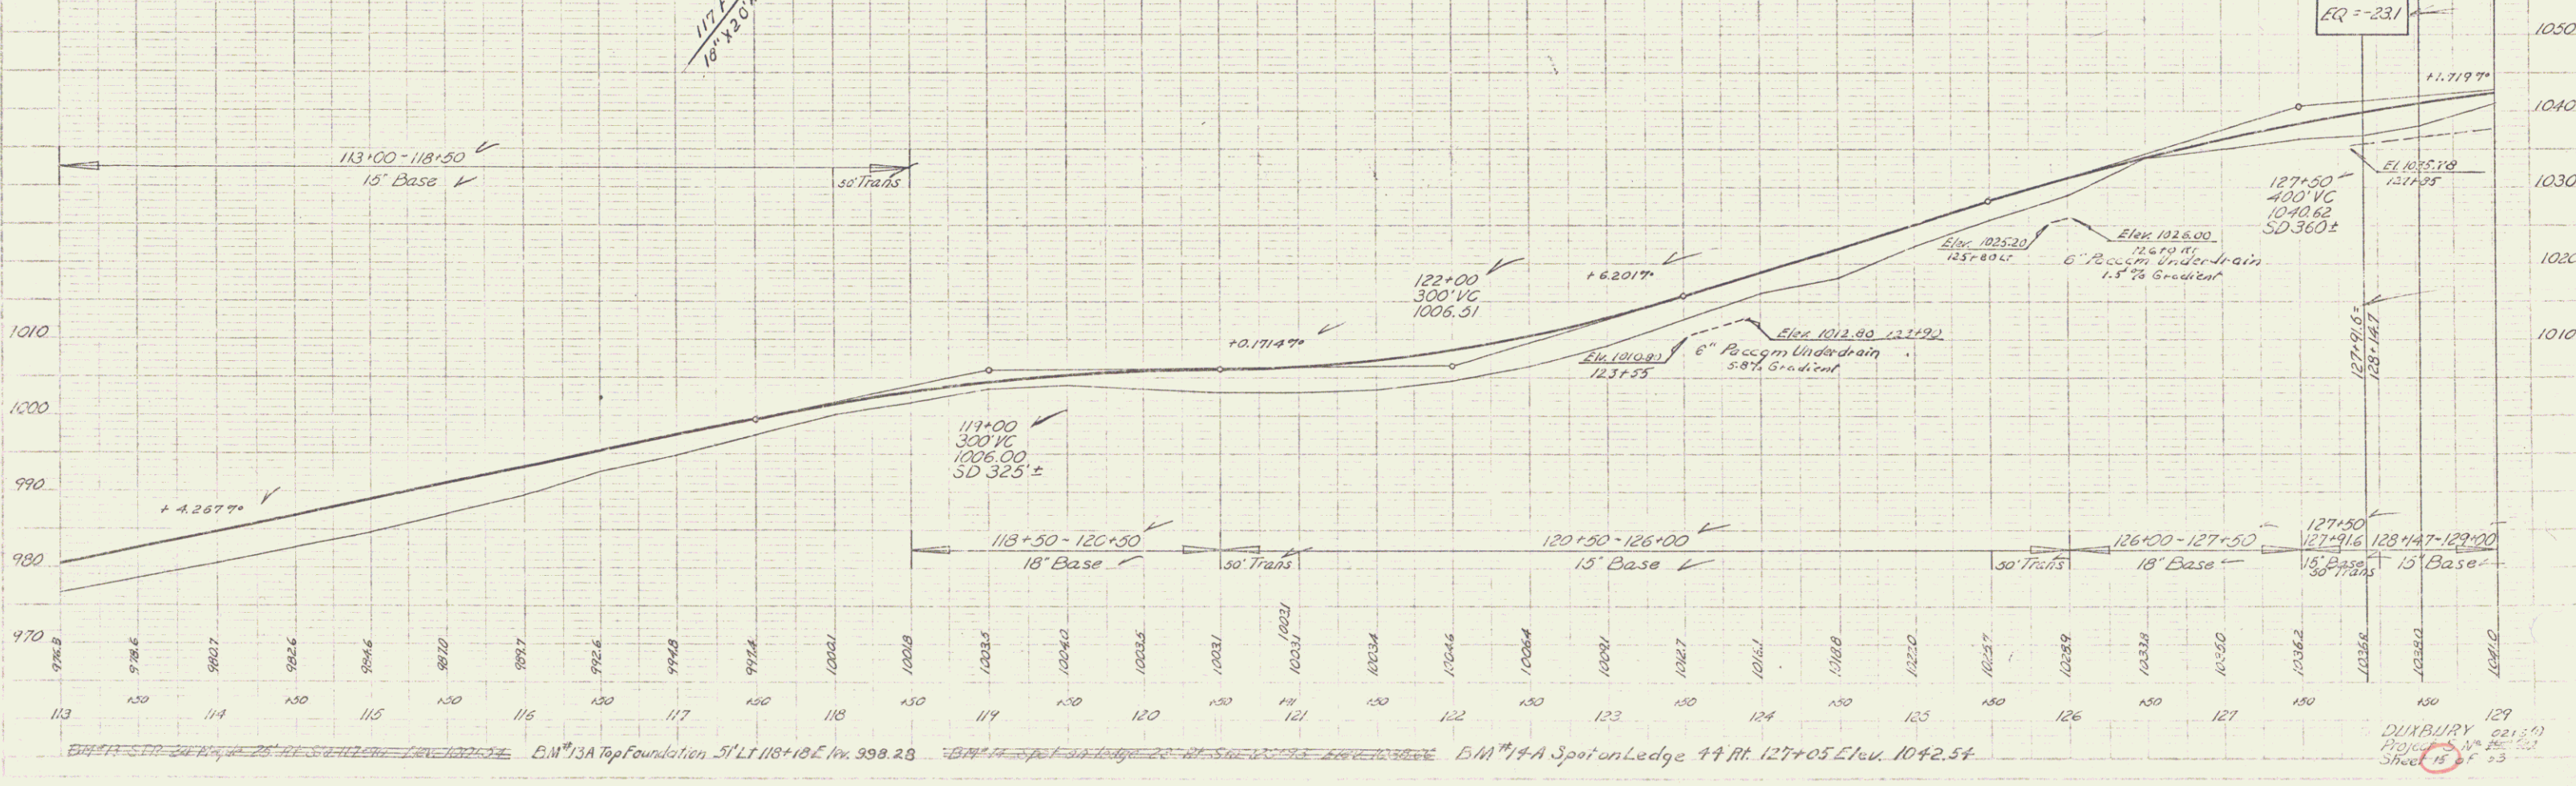

BM 73A Top Foundation 51' LT 118+18 E. 998.28 BM 74A Spot on Ledge 44' RT 127+05 Elev. 1042.54

DUNBURY 02130
 Project No. 15
 Sheet 15 of 33