


Wood Guide Posts  
 Lt. 176+20-177+80

Two Cable Guard Rail  
 Rt. 172+00-175+95

Drilling & Blasting of  
 Solid Rock Subgrade  
 Lt. 176+50-176+94


Construct Drives  
 Rt. 177+90 181+25

Delano A. Gagnan  
 01/27  
 Mar 58

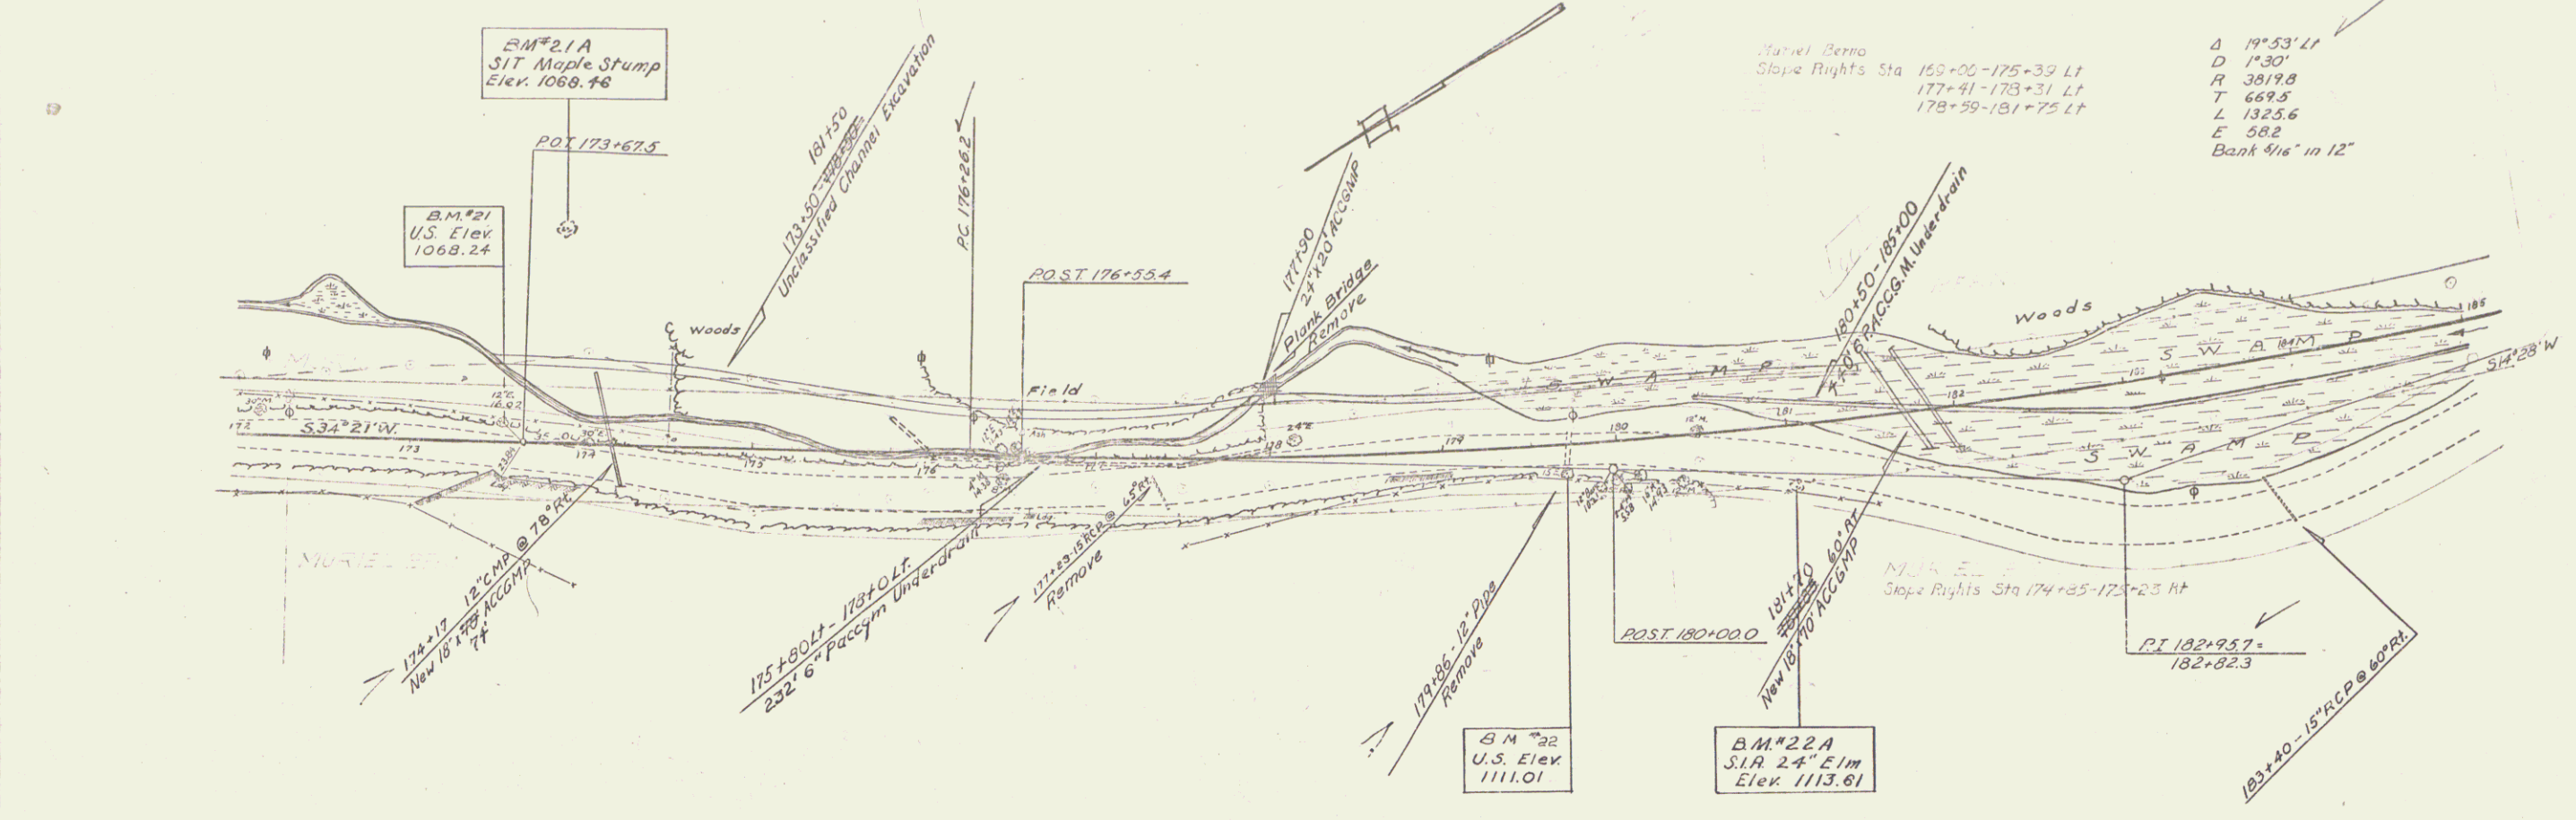

Market Bena  
 Slope Rights Sta 150+00-175+39 Lt.  
 177+41-178+31 Lt.  
 178+99-181+75 Lt.

Δ 19° 53' Lt  
 D 1' 30"  
 R 3819.8  
 T 669.5  
 L 1325.6  
 E 58.2  
 Bank 4/16" in 12"

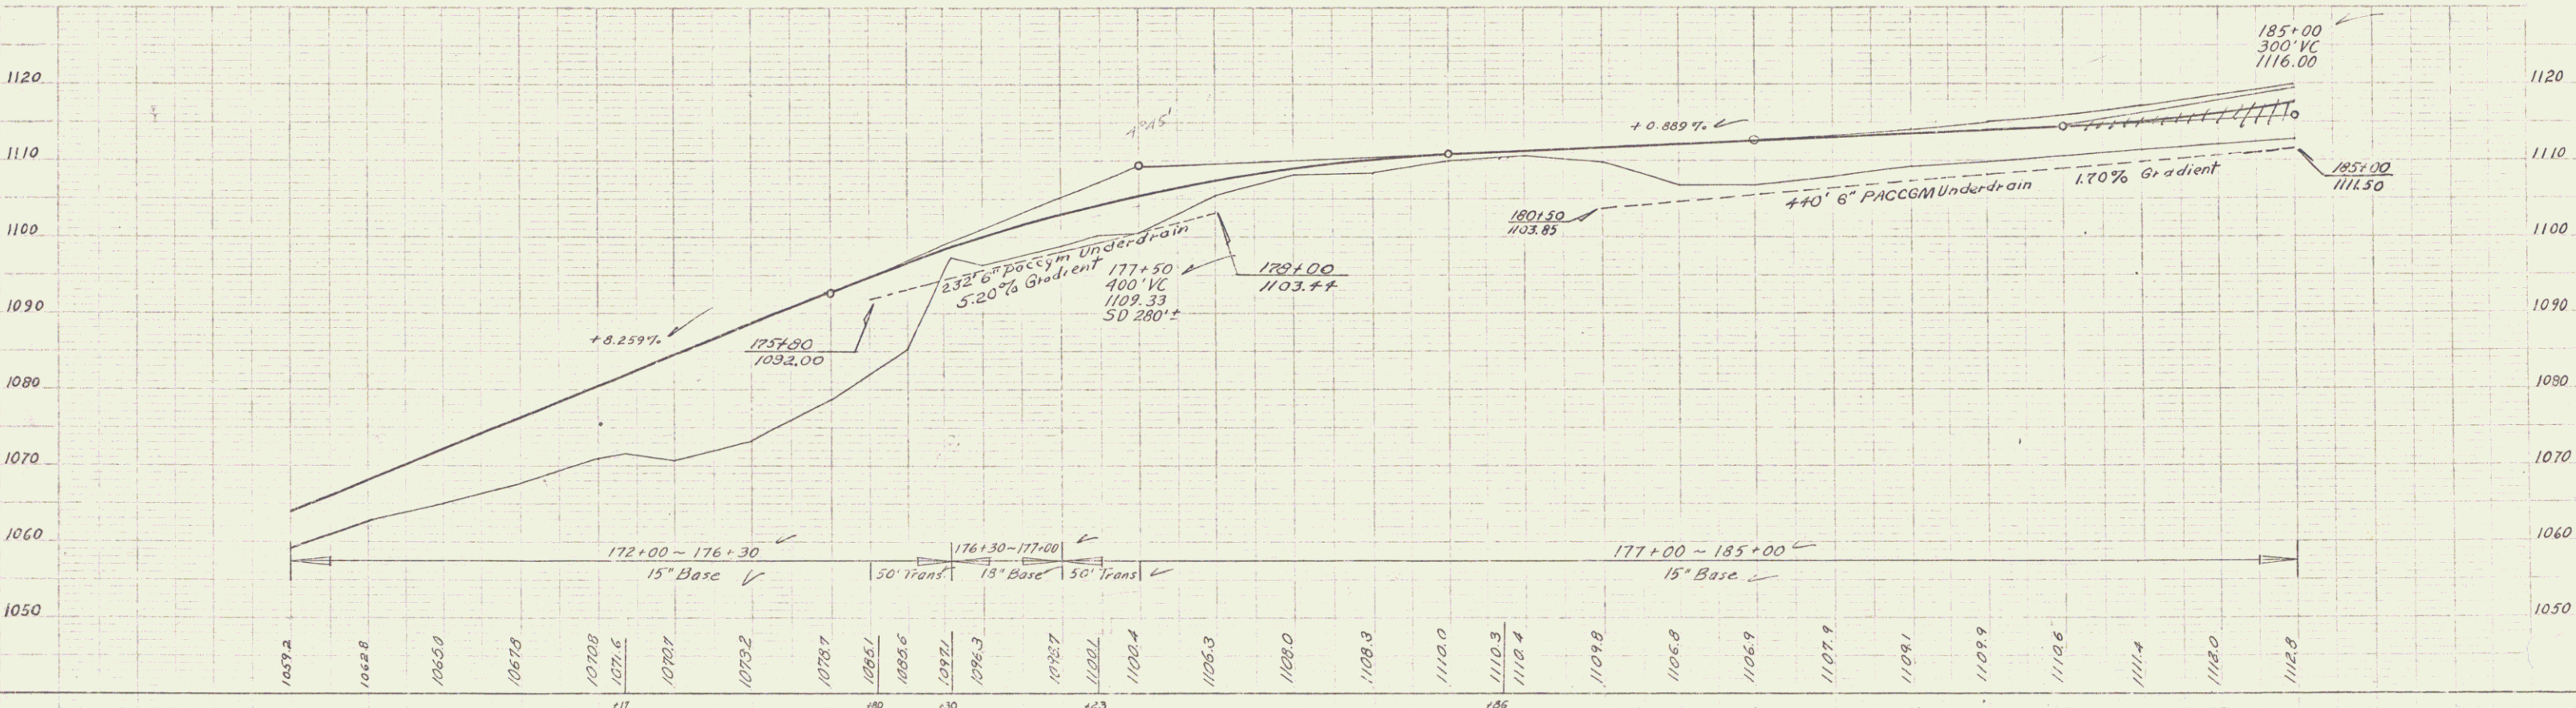

B.M.#21 - S.I.T. 12" Elm 13' Lt. Sta. 173+55 Elev. 1068.24 B.M.#21A S.I.T. Maple Stump 125' Lt. 173+90 Elev. 1068.46 B.M.#22A S.I.R. 24" Elm 36' Rt. 181+03 Elev. 1113.61

DUXBURY 0213(1)  
 Project No. 5-1800  
 Sheet 19 of 23