


LI Wood Guide Posts RI
 #5 87+00 1
 93+10 1
 90+00 3

Plank Guard Rail
 30+85 Rt. 16'
 31+10 Rt. 16'

14 Two Cable Guard Rail RI
 376 84+00 - 87+86
 248 87+50 - 91+50
 371 92+00 - 92+10
 200 90+00 - 92+00
 30+33 - 91+77 144

11 Construct Driver RI
 93+00
 94+10
 94+80

Scale
 1" = 40'
 1" = 80'

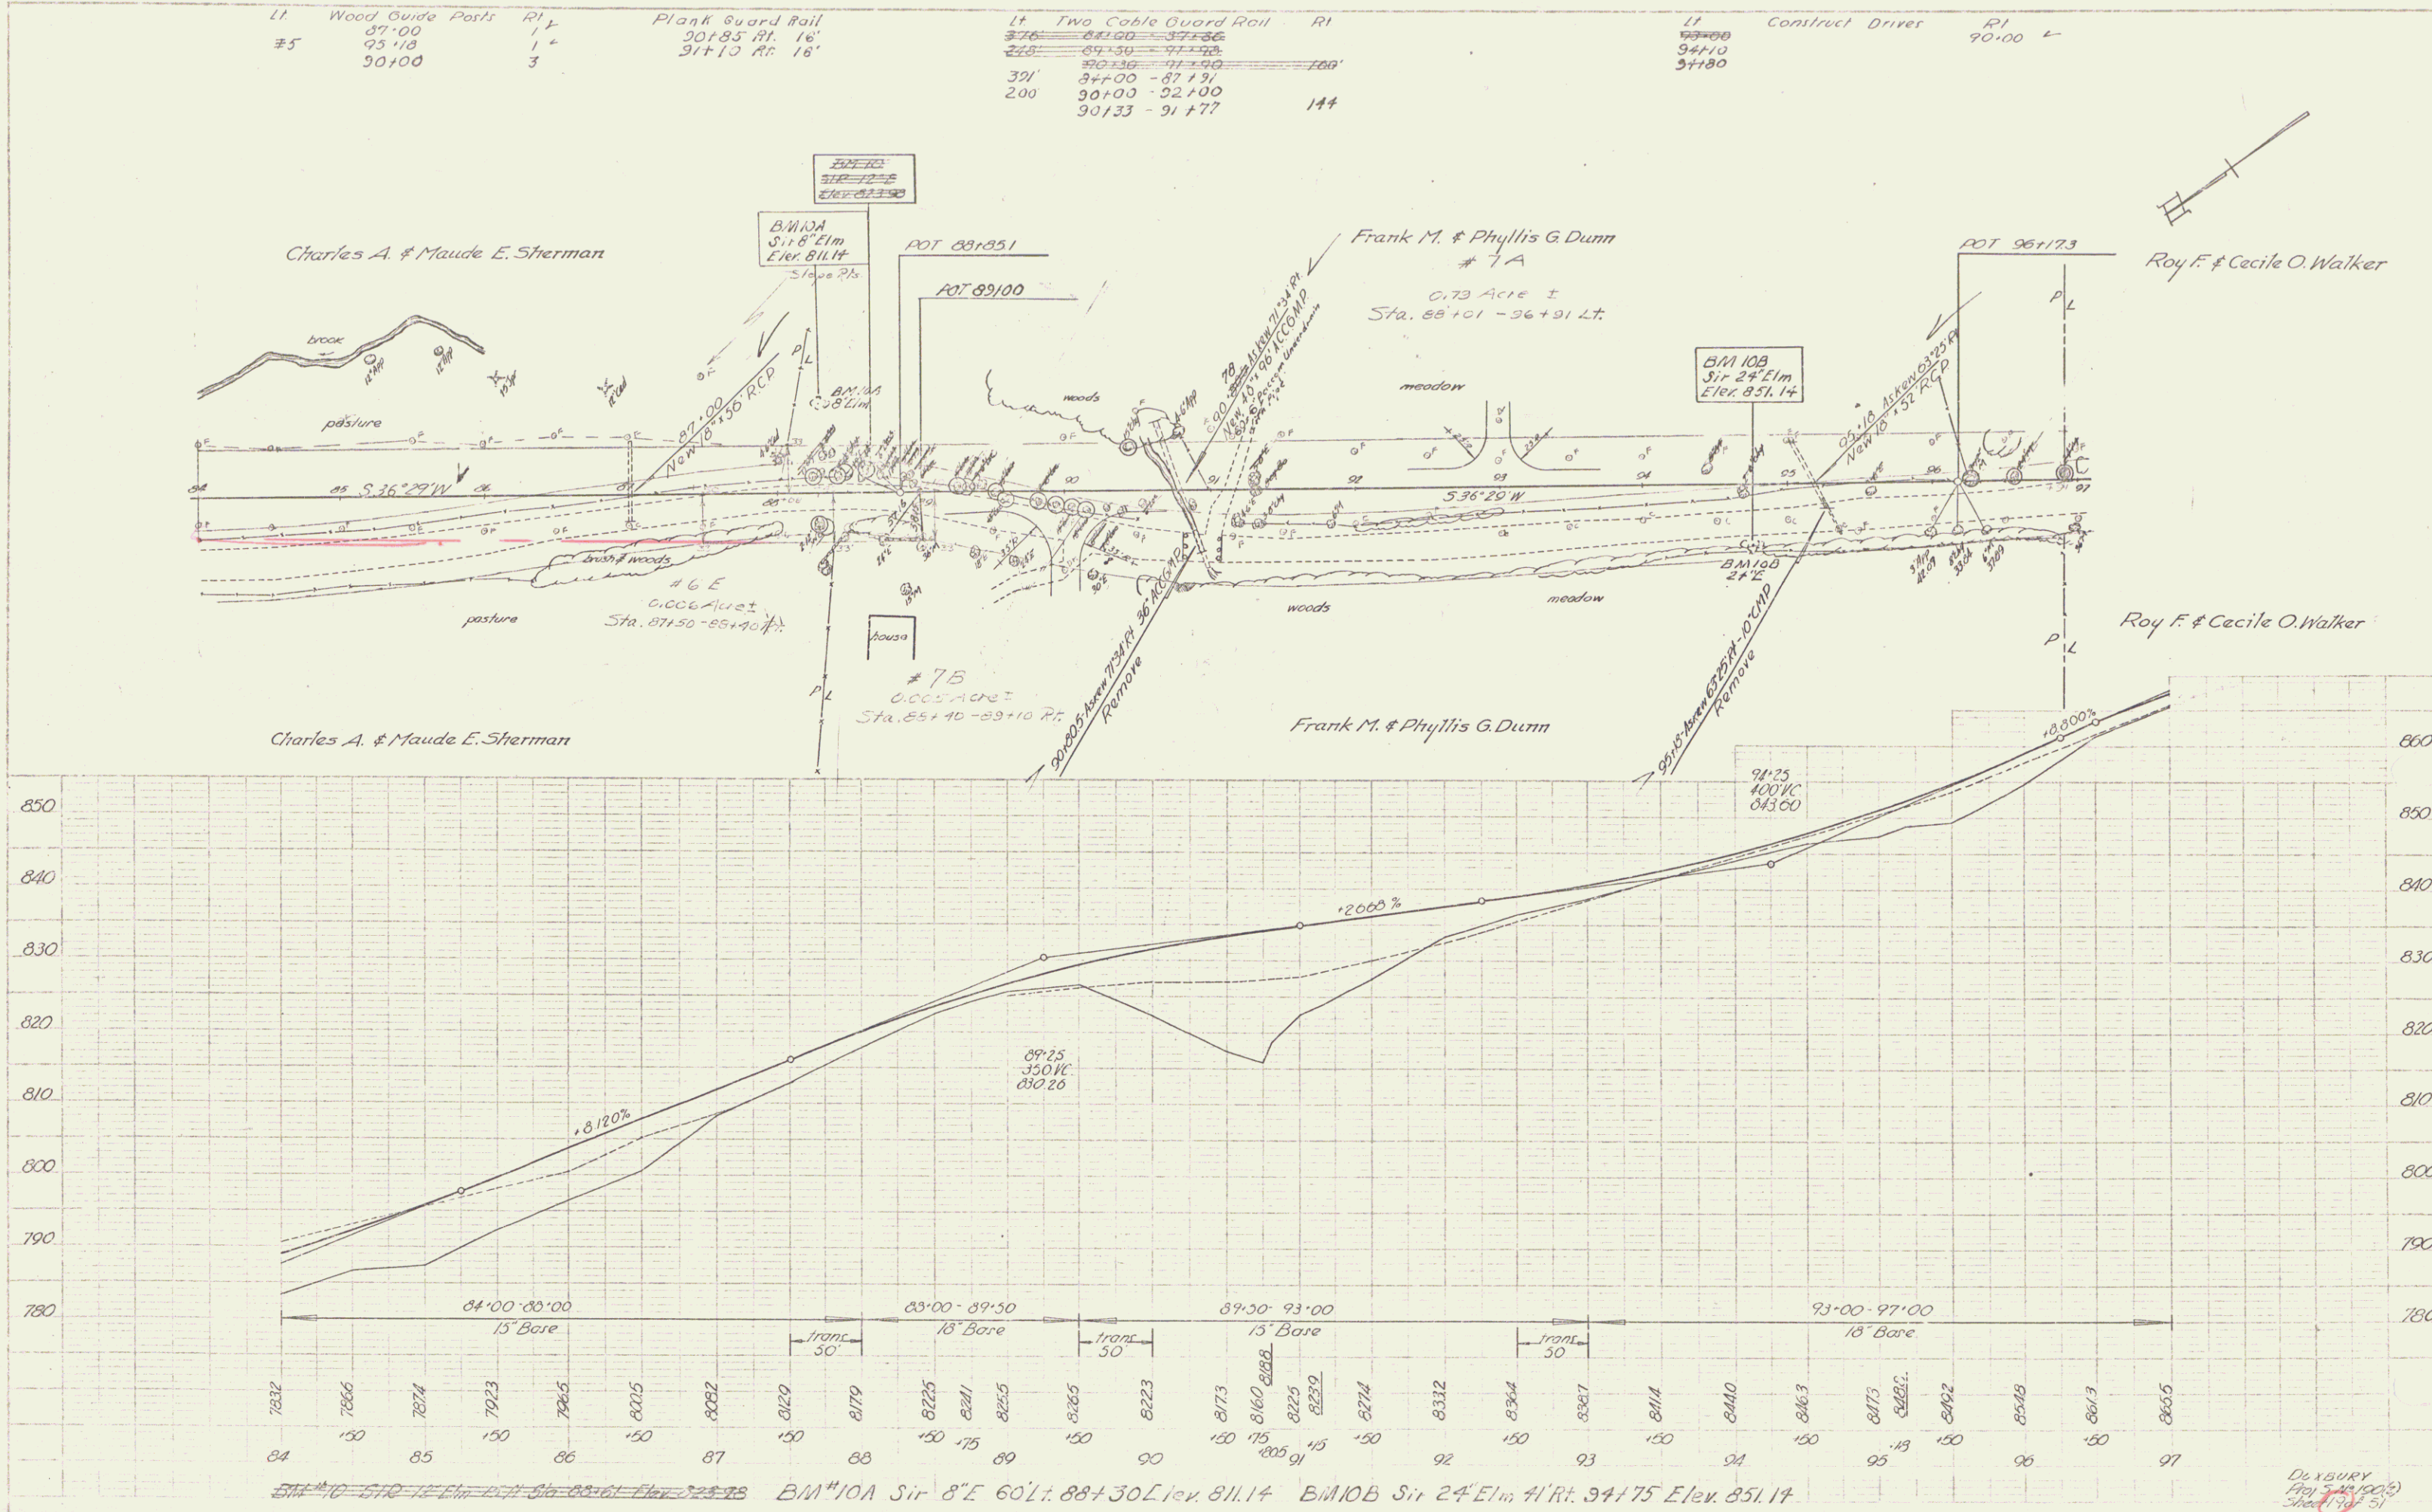

Scale
 1" = 40'
 1" = 80'

B.M. #10 Sir 8" E 60' Lt. 88+30 L. Elev. 811.14 B.M. #10B Sir 2 1/2" Elm. 71' Rt. 94+75 Elev. 851.14

DAYBURY
 Proj. 2-10-1902
 Sheet 13 of 51