

PLAN
 DATE: 10/1/66
 DRAWN BY: S.M.
 CHECKED BY: B.M.S.
 PROJECT: 100-1962
 SHEET NO.: 2

PROFILE
 DATE: 10/1/66
 DRAWN BY: S.M.
 CHECKED BY: B.M.S.
 PROJECT: 100-1962
 SHEET NO.: 2

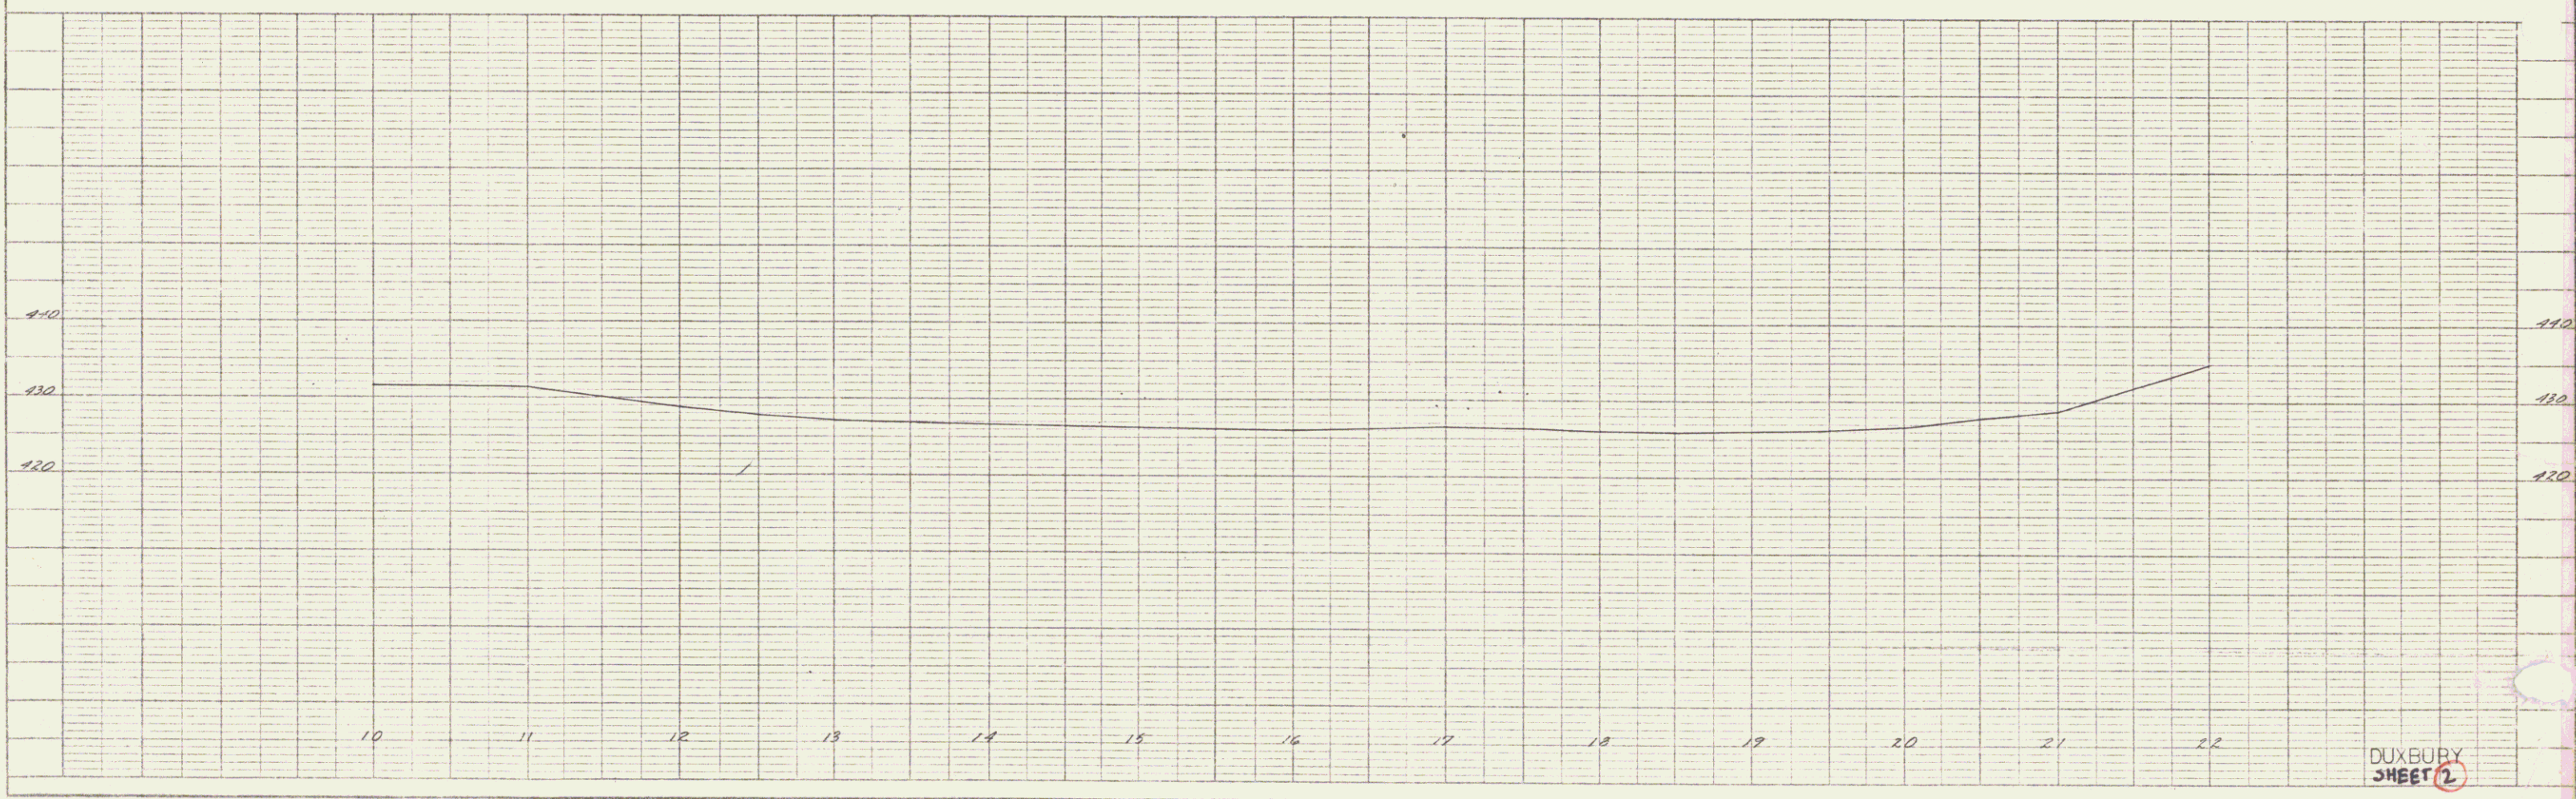
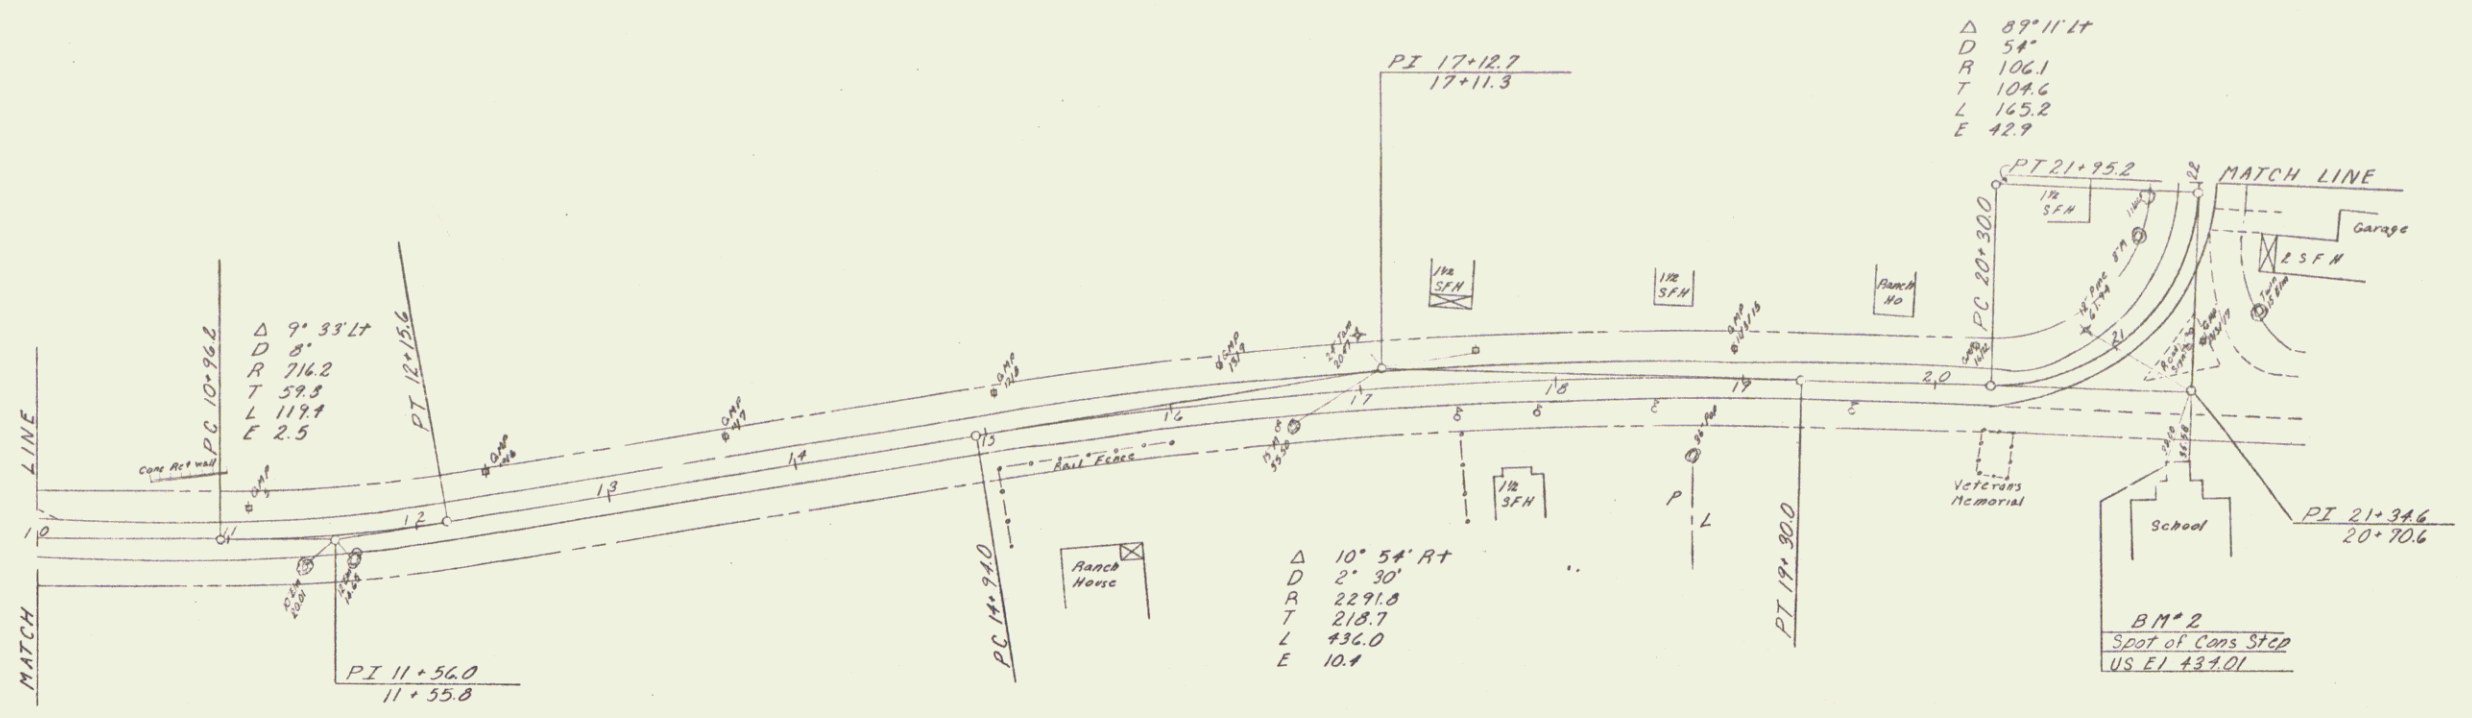



PLATE 3. PLAN - PROFILE. D.P.R. & E. STANDARD. KEUFFEL & ESSER CO. NEW YORK.

DUXBURY SHEET 2

(To be Returned to R.O.W. Division)
 Form of 4/100
 PERMITAL
 TOWN FILE
 RIGHT-OF-WAY DIVISION

Duxbury MTS.52-6.359
 Montebur MP 1.13-1.228

PLAN
 SCALE: 1" = 40'
 DATE: 10/1/81
 DRAWN BY: J. J. [unclear]
 CHECKED BY: [unclear]

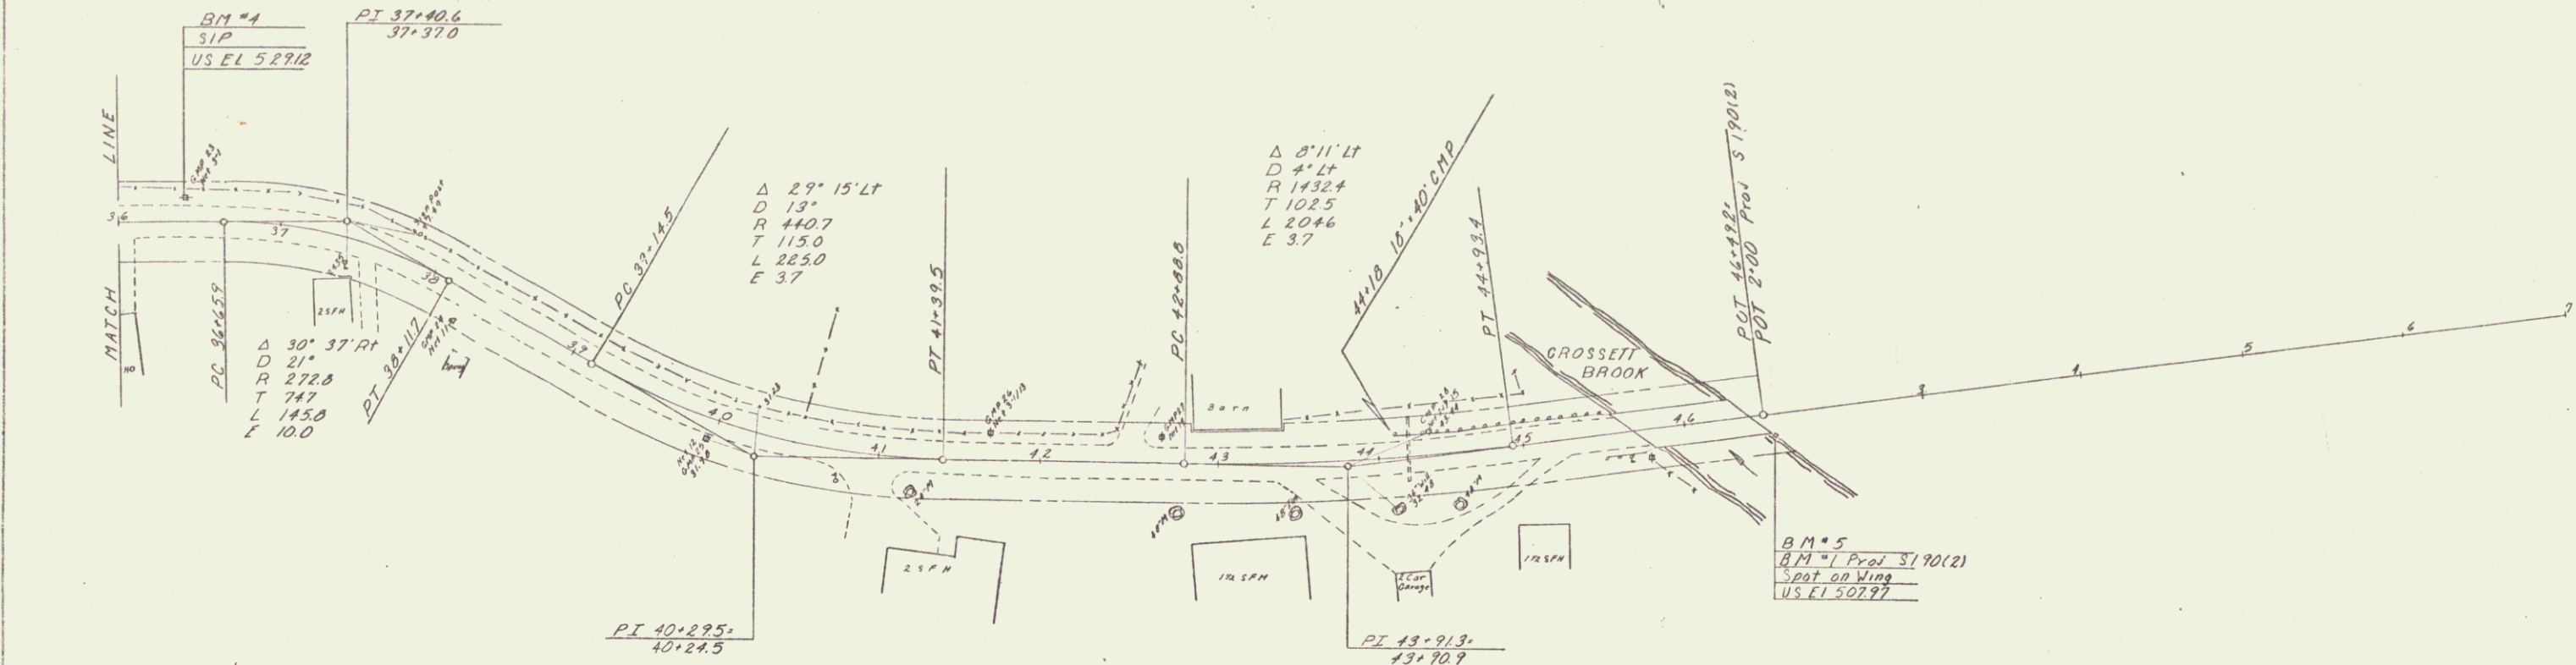

PROFILE
 SCALE: 1" = 10'
 DATE: 10/1/81
 DRAWN BY: J. J. [unclear]
 CHECKED BY: [unclear]

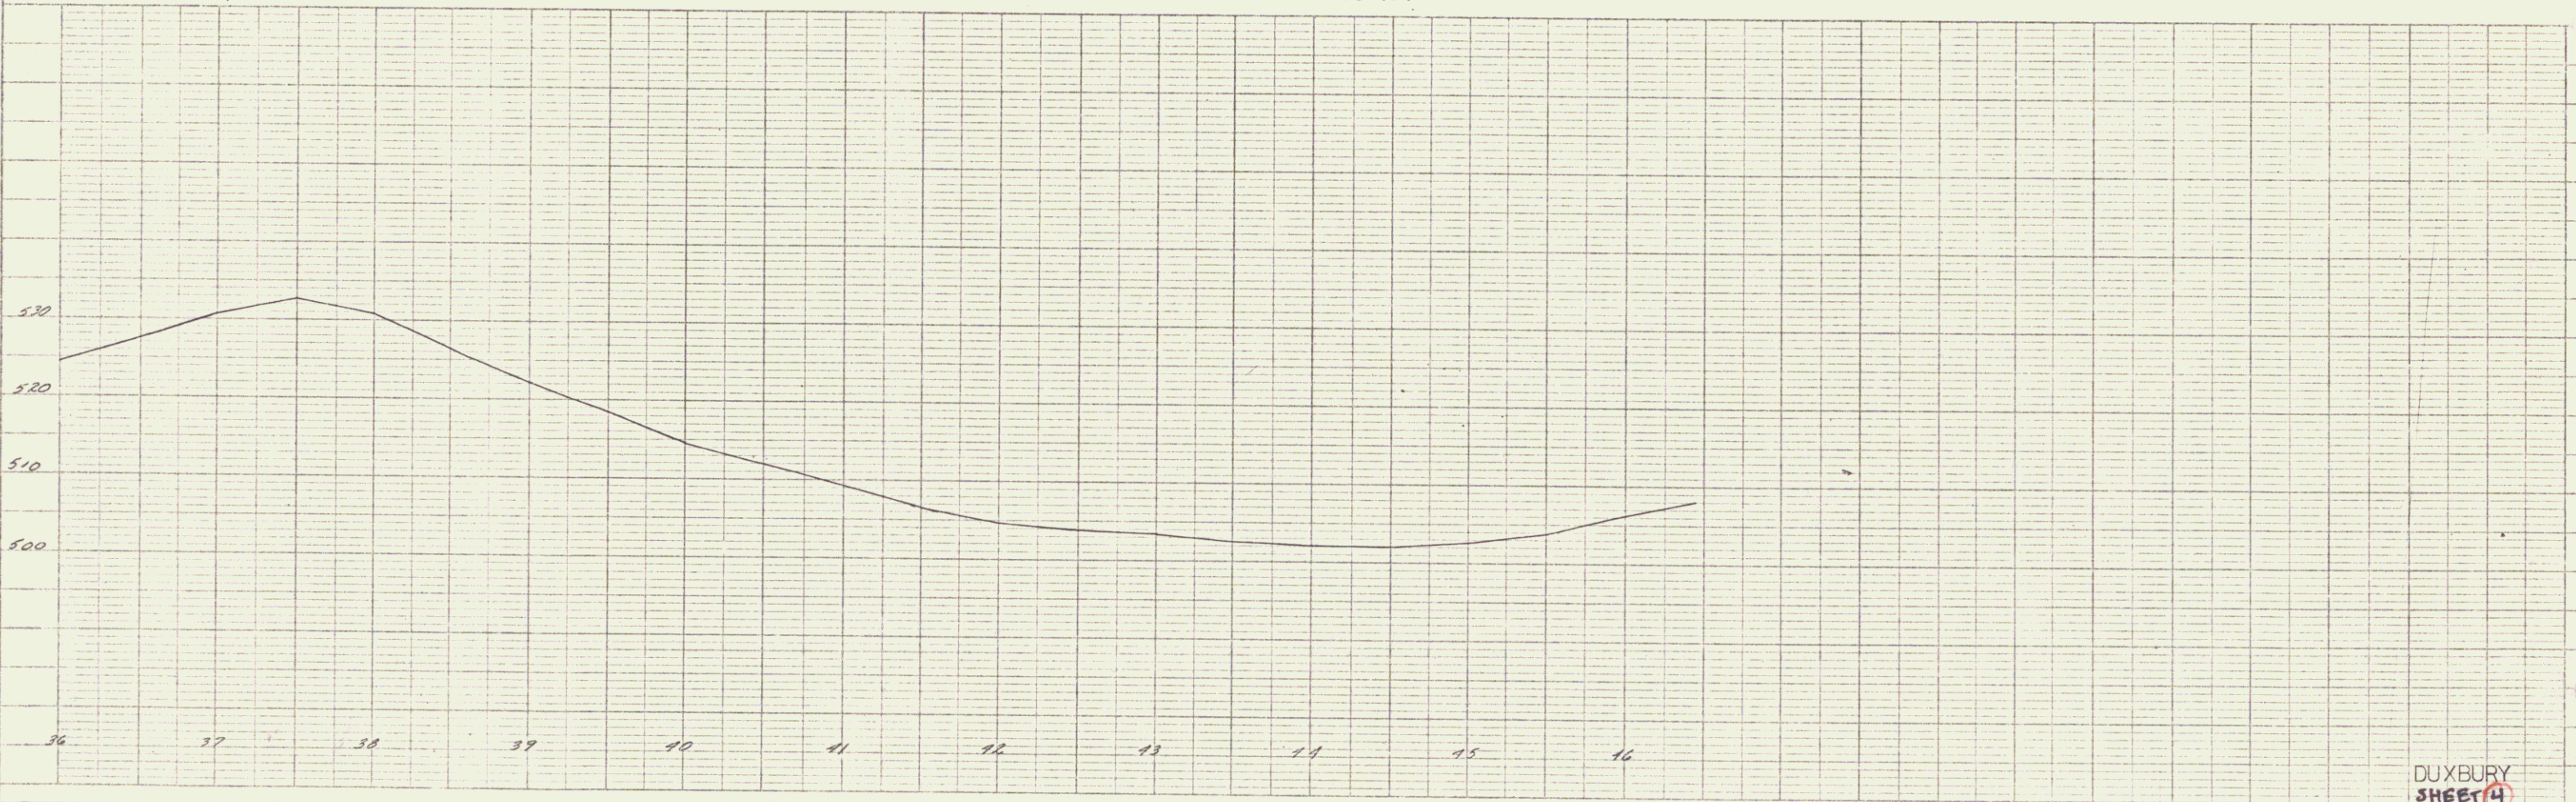


PLATE 1 - PLAN PROFILE - S.P. & R.E. EDWARDS
 ADPTEL & ESSER CO. NEW YORK
 1/4" = 100' PLAN
 1" = 10' PROFILE

DUXBURY SHEET 4

4

D. J. [unclear] 10/1/81