

INDEX OF SHEETS		
SHEET NO.	1	TITLE PAGE
"	2	TYPICAL CROSS-SECTION OF IMPROVEMENT [2 1/2" CRUSHED GRAVEL MIXED IN PLACE SURFACE COURSE WITH CUTBACK ASPHALT AND PRIME COAT OF REFINED TAR, ITEMS 26, 30 & 31]
"	3	BANKING AND WIDENING TABLES
"	4-13	PLAN AND PROFILE
"	14	STANDARD STRUCTURE SHEET S28 PIPE CULVERTS
"	15	" S30 WOOD GUARD RAIL
"	16	" S30A BOUNDARY MARKERS
"	17	" S40 BARRICADES, SIGNS & LIGHTS
"	18	" S41 TYPICAL GRADING CROSS SECTIONS
"	19	" S49-46 SPRING MOUNTED PANEL TYPE GUARD RAIL WITH STEEL POSTS
"	20-43	CROSS SECTIONS


STANDARD STRUCTURE SHEETS APPROVED BY THE CHIEF
ENGINEER VERMONT STATE DEPARTMENT OF HIGHWAYS

S 28 APRIL 26, 1941
S 30 MAY 12, 1941
S 30A APRIL 19, 1941
S 40 DEC. 16, 1945
S 49-46 JAN. 13, 1947

STATE OF VERMONT
STATE HIGHWAY DEPARTMENT
**PLAN AND PROFILE OF PROPOSED
STATE HIGHWAY**
FEDERAL PROJECT
TOWN OF HYDE PARK
VERMONT ROUTE 100
HYDE PARK - EDEN ROAD

BEGINNING AT A POINT 1550 FEET FROM THE
INTERSECTION OF VERMONT ROUTES 15 & 100
AND EXTENDING NORTHEASTERLY 14,008.3 FEET
LENGTH OF PROJECT 14,008.3 FEET = 2.653 MILES

For MP 0.00 - MP 2.65
See Project F39(2)
Sheet 15

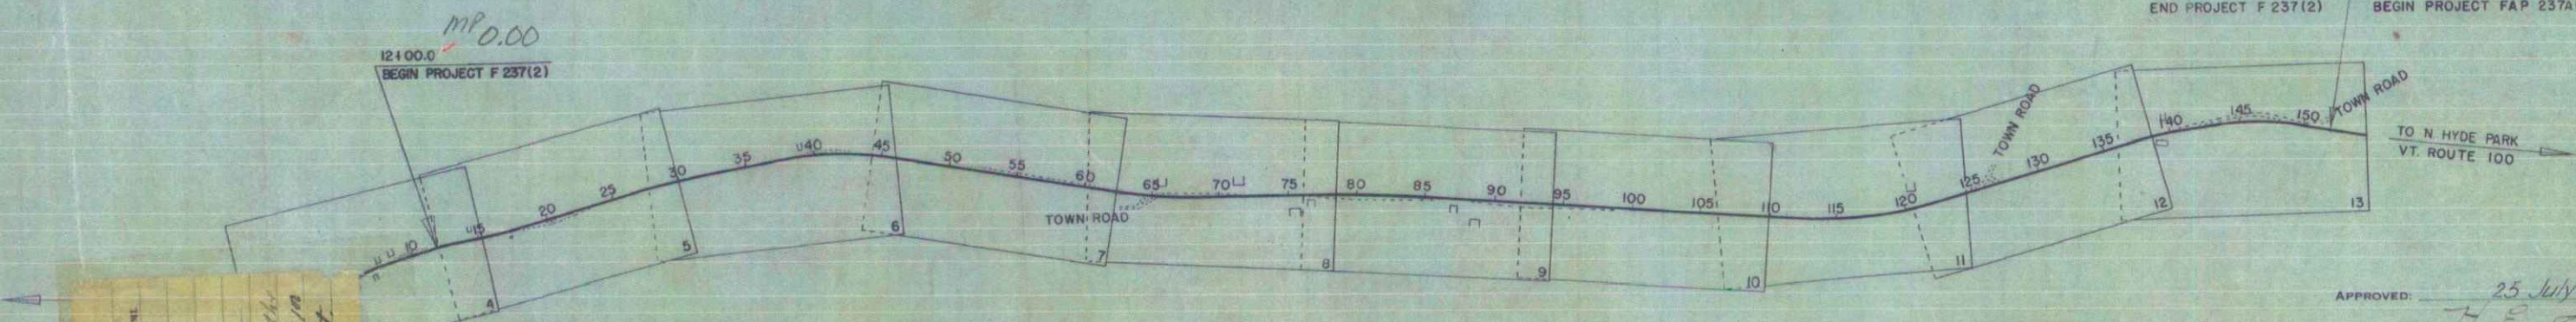

COUNTY
TOWN
FENCE
STONE
UNFENCE
GUARD
TRAVEL
RAILROAD
RETAINING
CENTER
SURVEY
CULVERT
DROP IN
TROLLEY
POWER
TELEPHONE
POLE
TREES
HEDGE

Hyde Park
F 237(2)
2 1/2" in Crushed Gravel M.P.
Location of Vermont Route 15-100
Intersection of Vermont Routes 15-100
Station 0.00 - 2.653 miles
Hyde Park F 237(2)
Contractor - S. V. Rossi Const. Co.
Res. Eng. - G. W. Sawyer

GROUND ELEVATION DATUM LINE
GRADE ELEVATION DATUM CURVE

CURVE DATA
DEFLECTION ANGLE
DEGREE OF CURVE
RADIUS OF CURVE
TANGENT DISTANCE
LENGTH OF CURVE
EXTERNAL DISTANCE
POINT OF INTERSECTION
POINT OF CURVE
POINT OF TANGENT
POINT ON TANGENT


SCALES
TITLE
TYPICAL
PLAN
PROFILE
HORIZONTAL
VERTICAL
CROSS SECTIONS

RECORD PLANS
Hyde Park F 237(2)
Contractor - S. V. Rossi Const. Co.
Res. Eng. - G. W. Sawyer

THESE PLANS ARE SUBJECT TO SUCH REVISIONS AS MAY BE
REQUIRED BY THE PUBLIC ROADS ADMINISTRATION OR THE COM-
MISSIONER OF HIGHWAYS.
CONSTRUCTION IS TO BE CARRIED ON IN ACCORDANCE WITH
THE PLANS AND THE STANDARD ROAD AND BRIDGE SPECIFICATIONS
OF 1936, AS APPROVED DECEMBER 29TH, 1936 BY THE PUBLIC
ROADS ADMINISTRATION, INCLUDING ALL SUBSEQUENT APPROVED
REVISIONS AND SUCH REVISED SPECIFICATIONS AND SPECIAL
PROVISIONS AS ARE SUBMITTED WITH THE PLANS.

APPROVED: [Signature] DISTRICT HIGHWAY ENGINEER
APPROVED: [Signature] DISTRICT HIGHWAY COMMISSIONER
SERIES F NO. 237(2) FILED
SHEET 1 OF 43

FED. ROAD DIST. NO.	STATE	FED. PROJ. NO.	FED. YEAR	SHEET NO.	TOTAL SHEETS
9	VT.	237(2)	1947	1	43

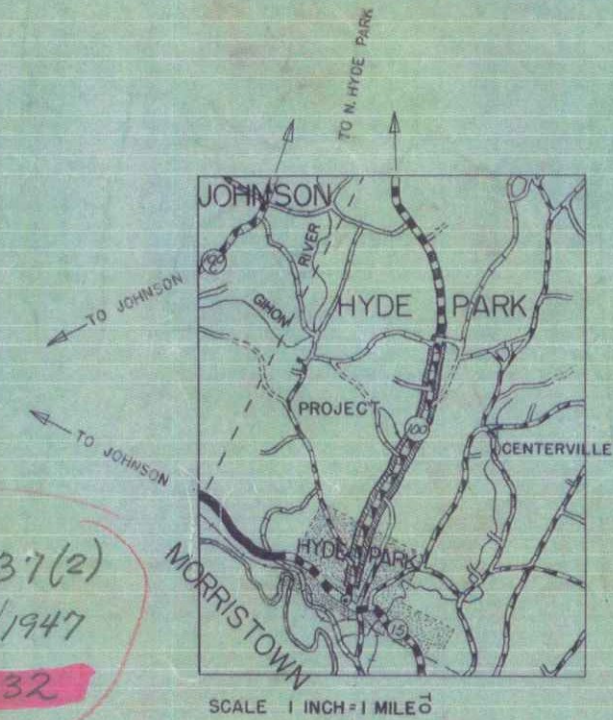

APPROVED: 25 July 47
[Signature]
COMMISSIONER OF HIGHWAYS
SUBMITTED BY ORDER OF THE STATE HIGHWAY BOARD

RECOMMENDED FOR APPROVAL
DISTRICT ENGINEER
PUBLIC ROADS ADMINISTRATION
FEDERAL WORKS AGENCY
APPROVED
DISTRICT ENGINEER
PUBLIC ROADS ADMINISTRATION
FEDERAL WORKS AGENCY