
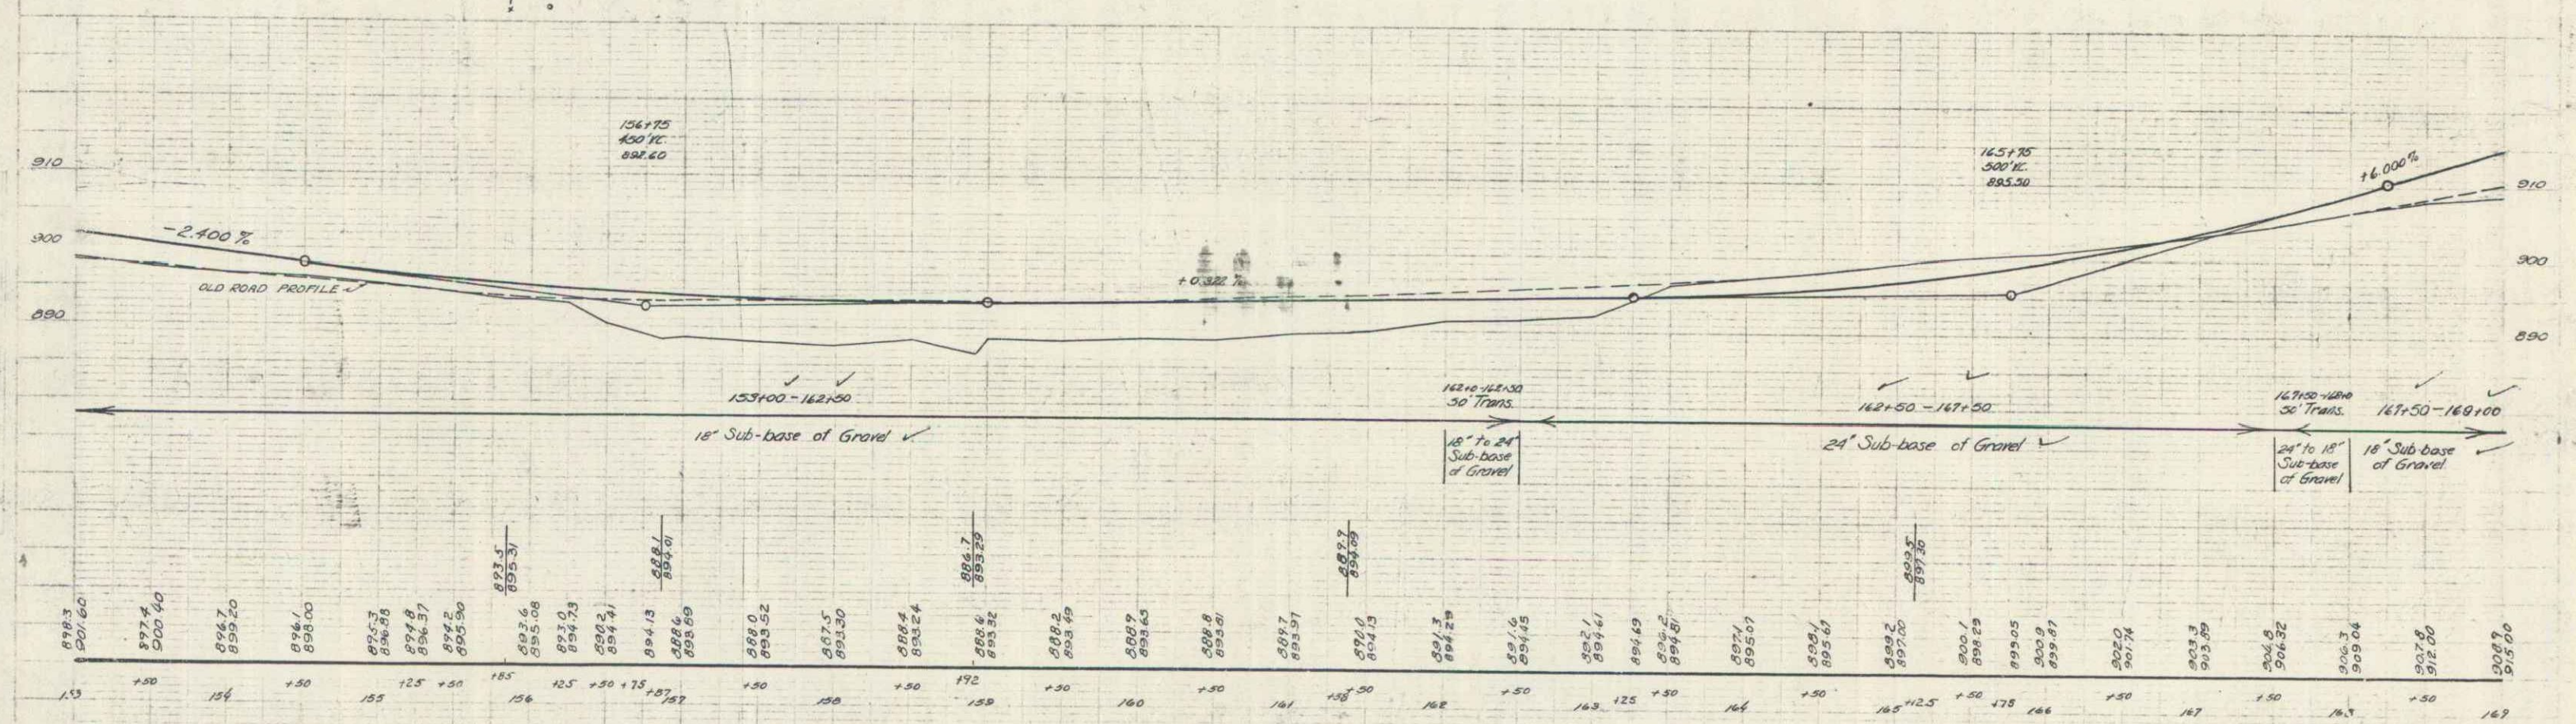


PARCEL	INSTRUMENT	DATE	GRANTOR	GRANTEE	RECORDED	REMARKS
A B	WDOE	8-13-40	WILLIE LULLIAN GRIMES	ST OF HY	BOOK 225	8-21-40
A'	WDOE	8-26-40	SAMUEL ELLA ALEXANDER	ST OF HY	31 32	8-26-41 3 CULV

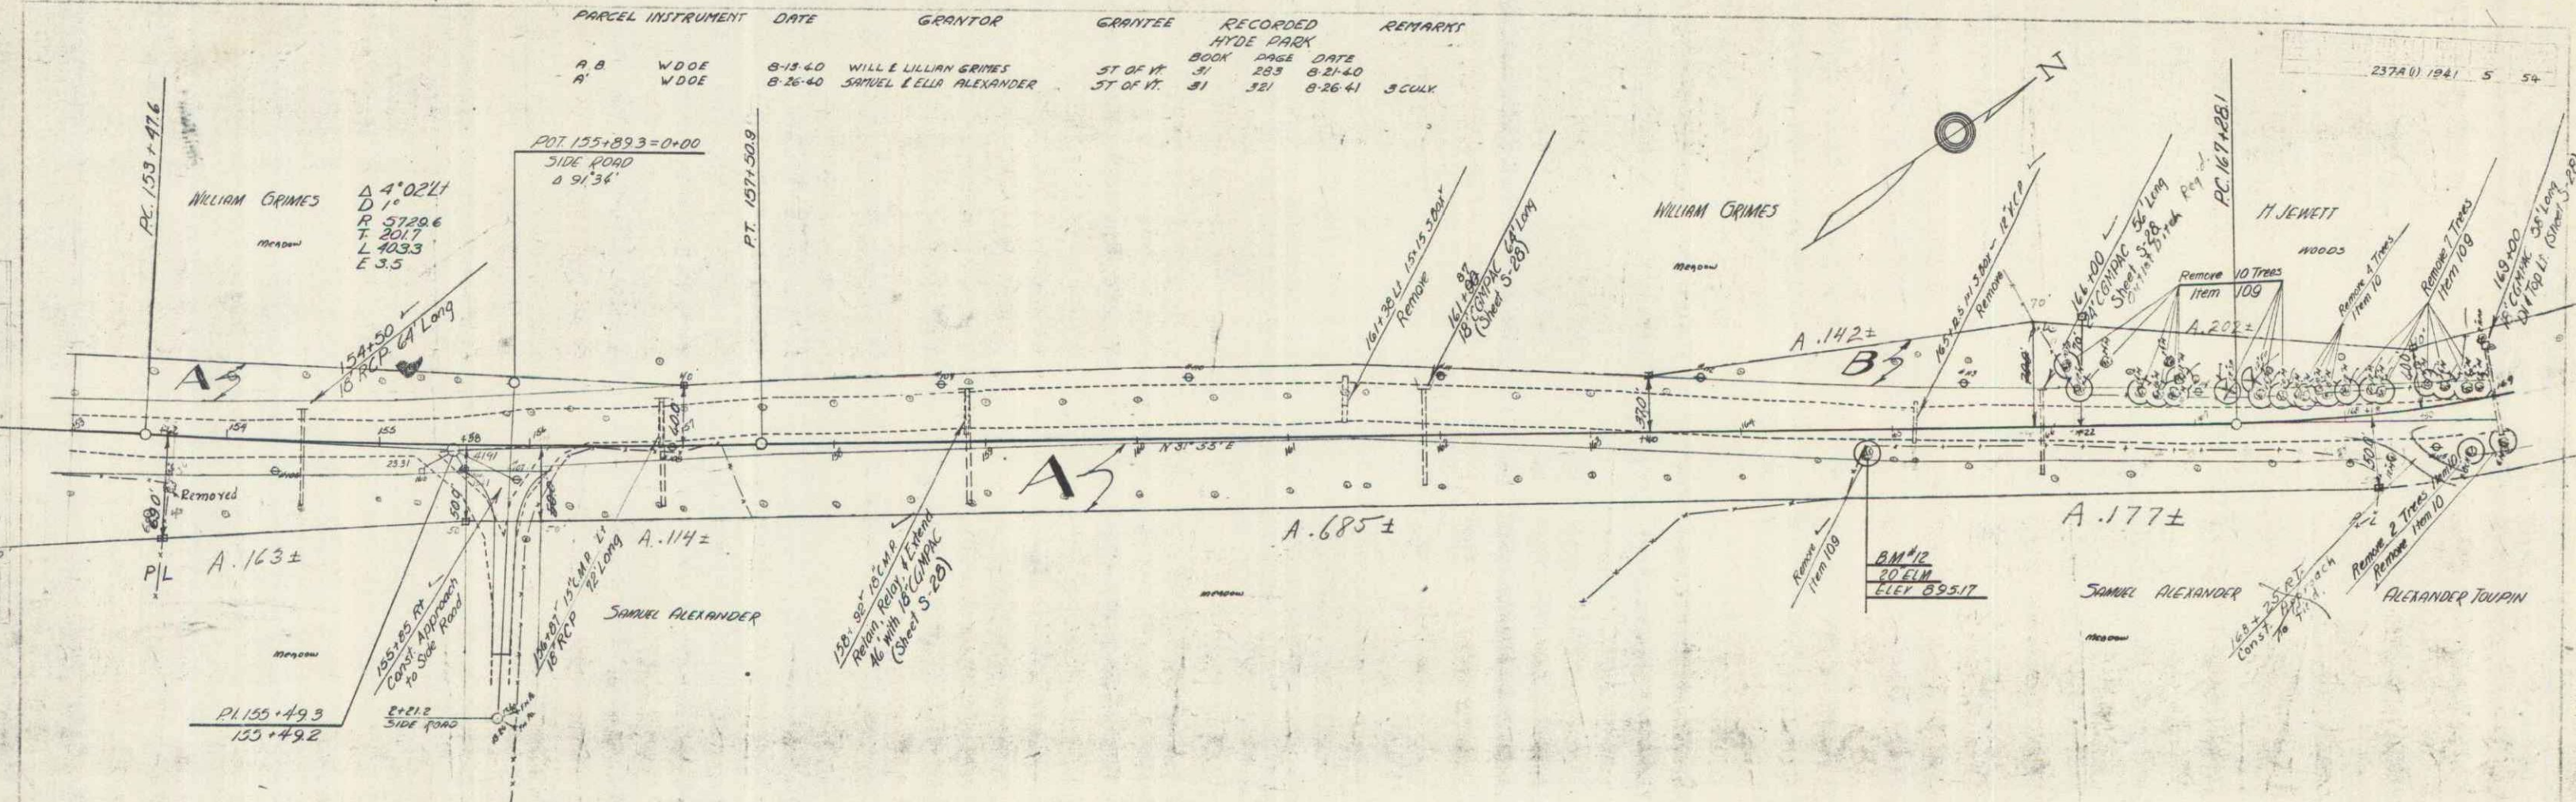

BM #12 SPIKE IN FOOT 20' ELM 19' PL 574.16170 ELEV 895.17

SERIES MAP NO. 237A(1) SHEET 5 OF 31