


PARCEL	INSTRUMENT	DATE	GRANTOR	GRANTEE	RECORDED	REMARKS
A.B.C.	W.D.G.E.	B.13-40	FRANK & GLADYS LOCKE	ST. OF H. HIDE PARK	BOOK PAGE DATE	514 514 8-13-40

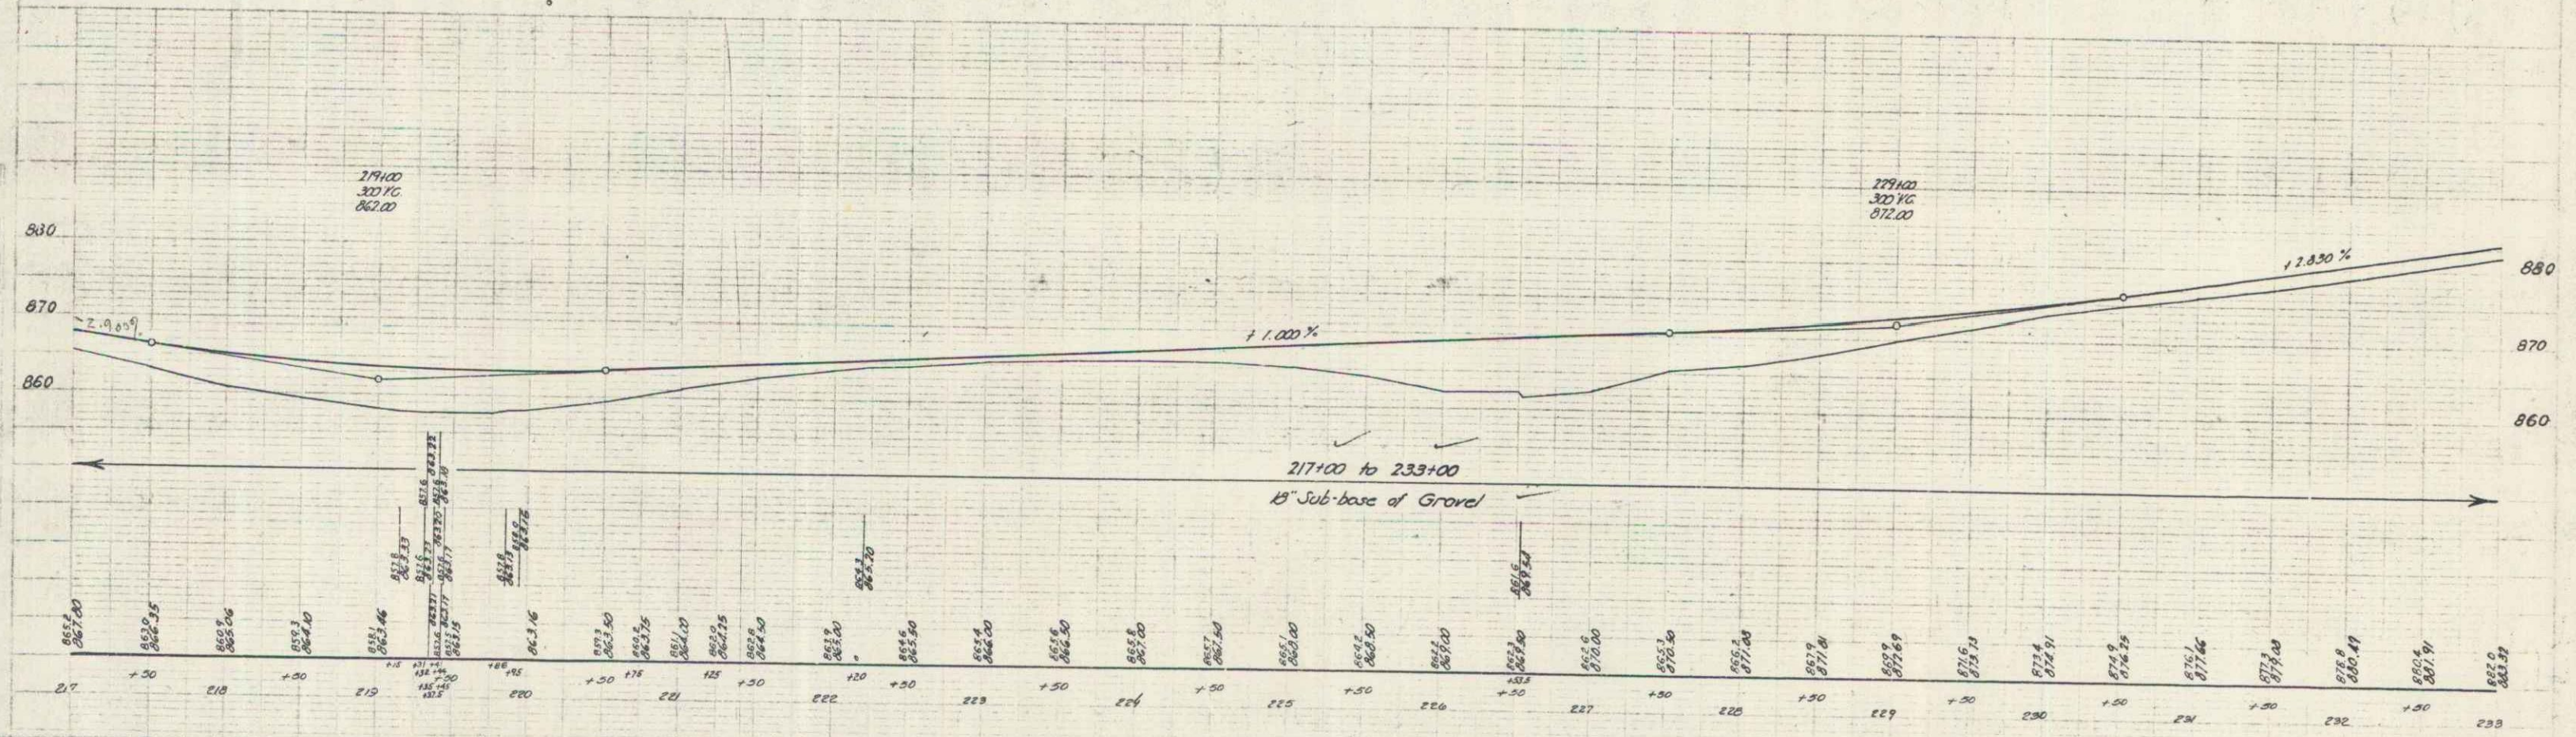

B.M. #7 Spot on Dunes Pk. 13 Rt Sta 219+42 Elev 360.01

SERIES P.A.C. NO. 231A(1) SHEET 9 OF 14

1