


A. 31° 54' BT
 D. 386.9
 T. 810.8
 L. 1595.0
 E. 114.7

PARCEL	INSTRUMENT	DATE	GRANTOR	GRANTEE	RECORDED	REMARK
A	W.D.O.E.	8-13-40	HOWARD & MATTIE SARAGUE	ST. OF VT	31	313 8-21-40
A'	W.D.O.E.	8-13-40	W. H. RUGGLES	ST. OF VT	31	294 8-21-40
A''	W.D.O.E.	8-13-40	LINCOLN & NELLIE GRISWOLD	ST. OF VT	31	315 8-21-40
A'''	W.D.O.E.	8-13-40	CASSIUS & MABEL GRISWOLD	ST. OF VT	31	289 8-21-40

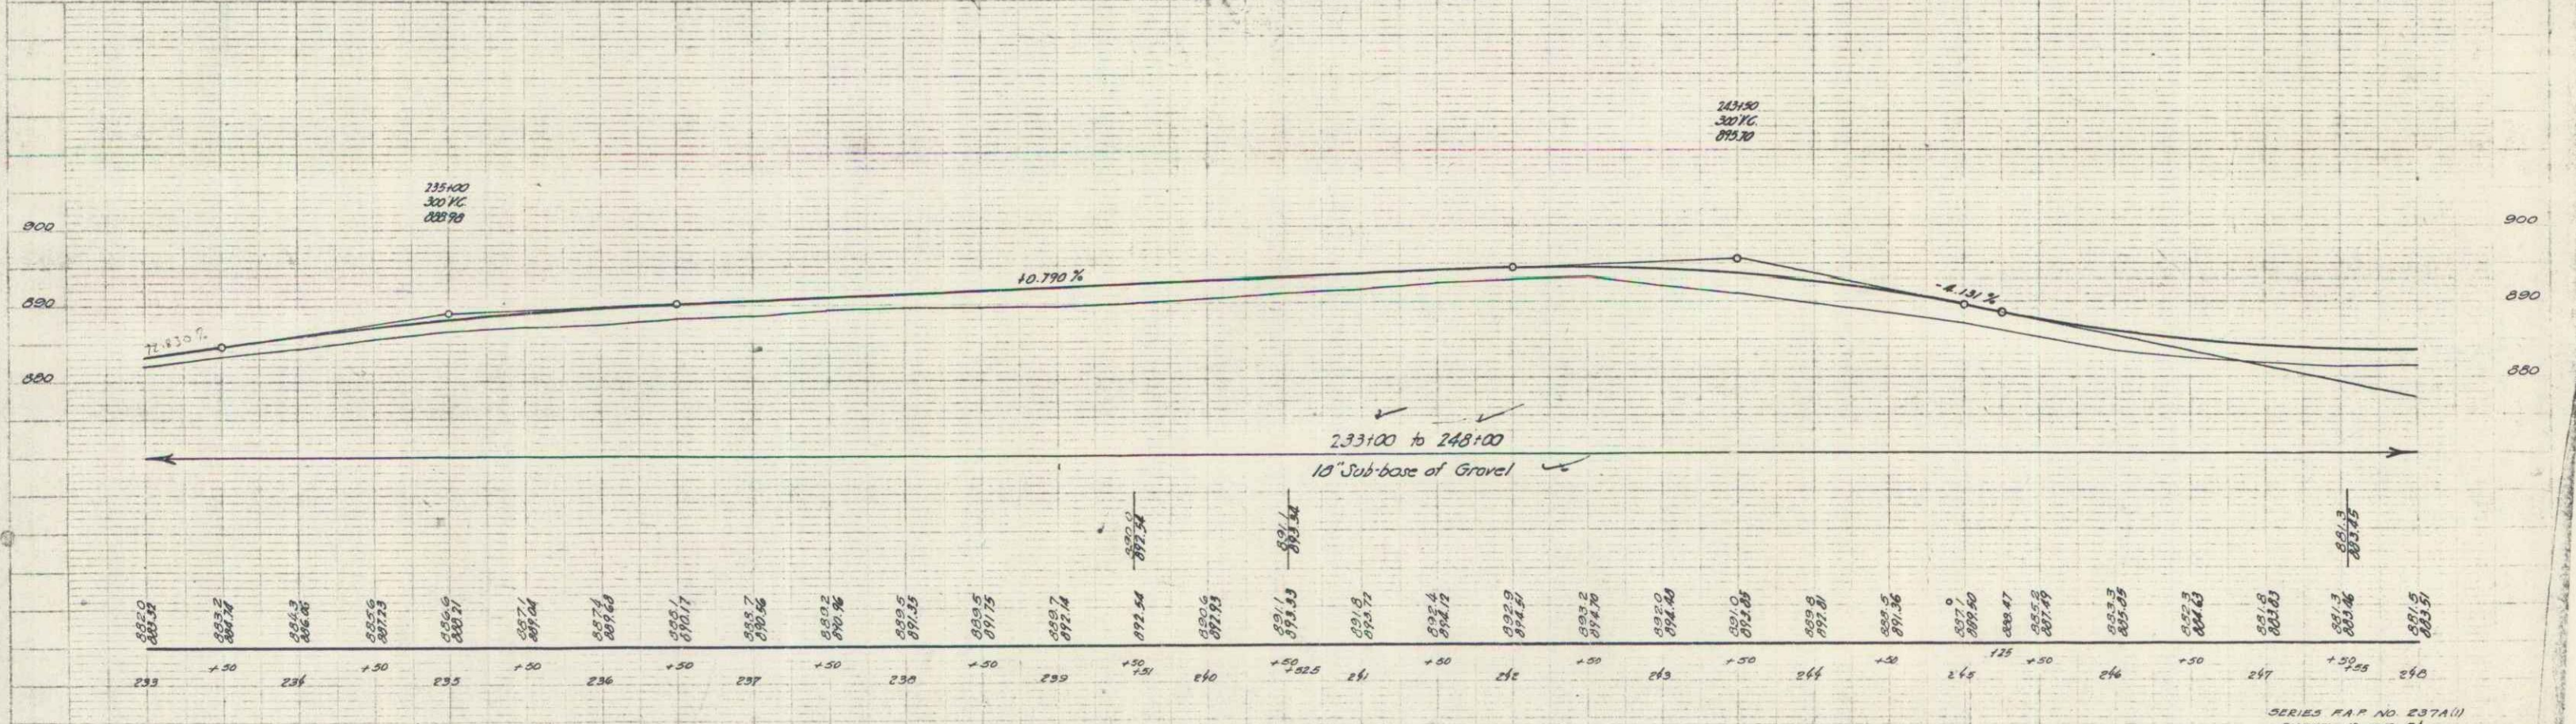

BM 5 SPARE IN DOOR 24' ELM. 21' LT. STA 246+92 ELEV 877.35
 BM 6 SPOT ON LEDGE 30' LT. STA 234+06 ELEV 886.39

11/11/41 11/11/41 8