
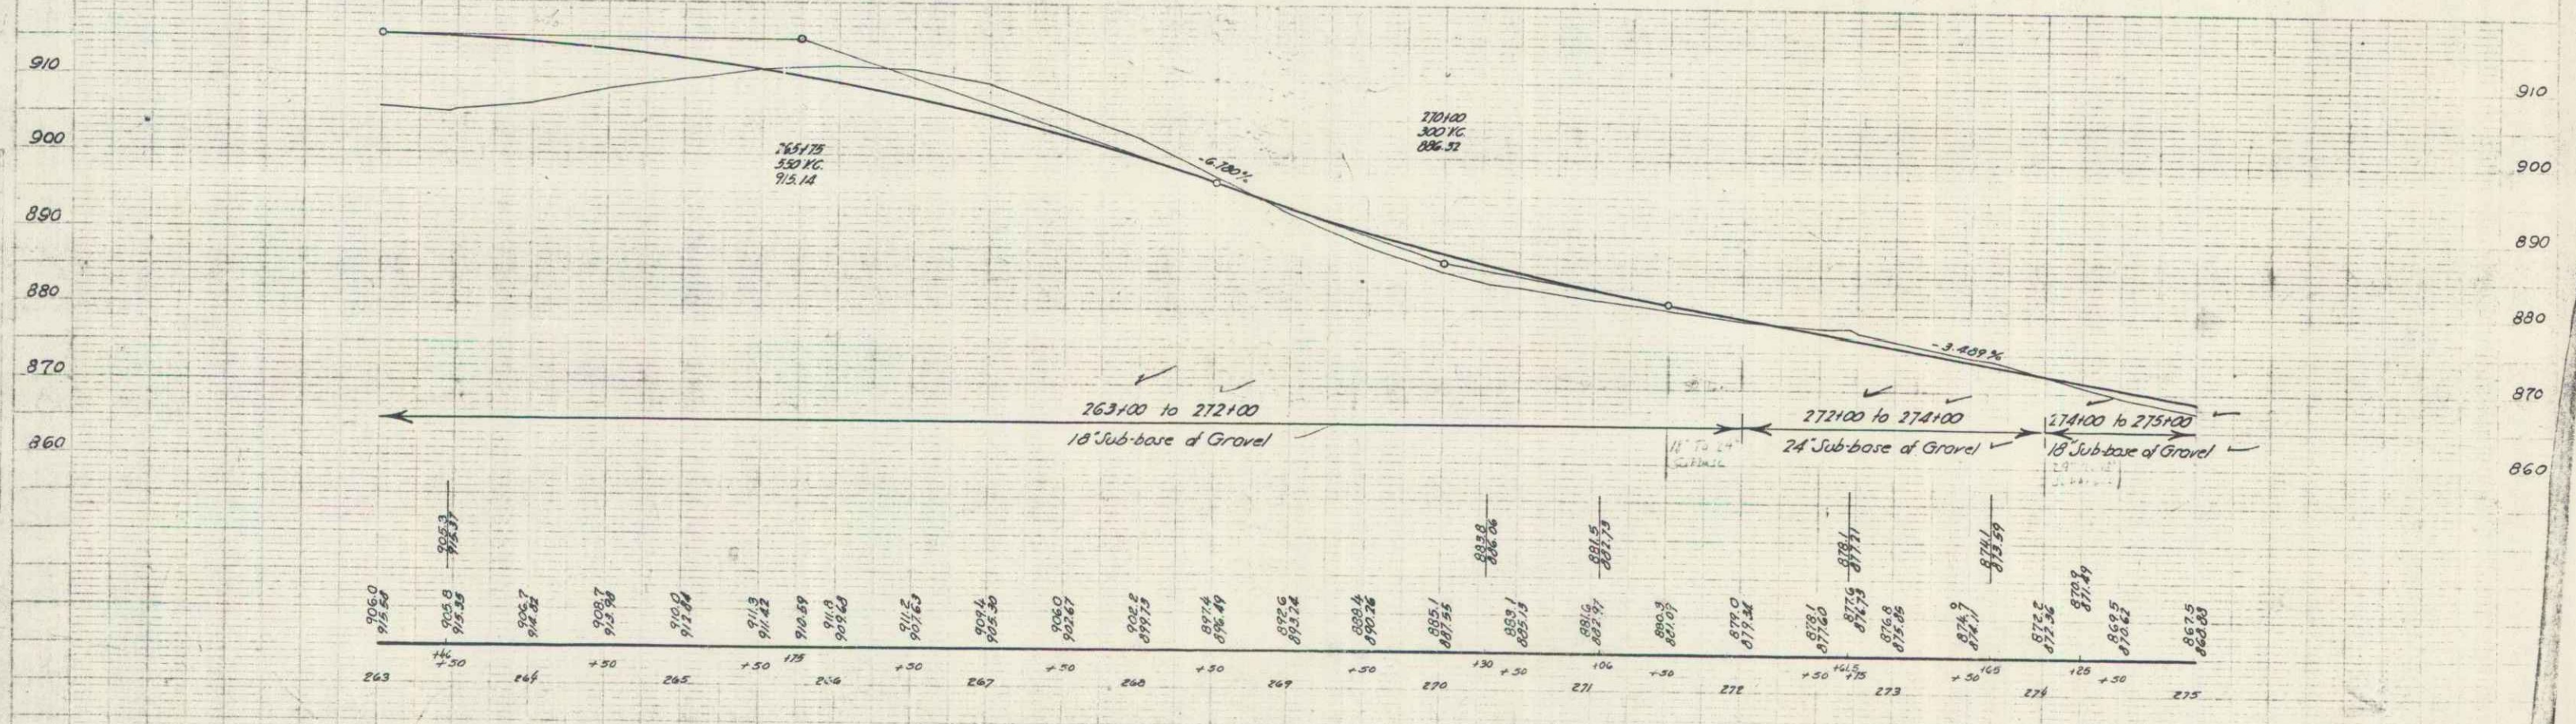


PARCEL	INSTRUMENT	DATE	GRANTOR	GRANTEE	RECORDED	REMARK
A-B	W.D.O.E.	8-26-40	ADA & ALONZO BIDWELL	ST OF VT	BOOK PAGE DATE 31 217-8 8-28-40	
B-C	W.D.O.E.	8-13-40	FRANK & JENNIE KNEELAND	ST OF VT	31 295-6 8-21-40	OUTLET DITCH

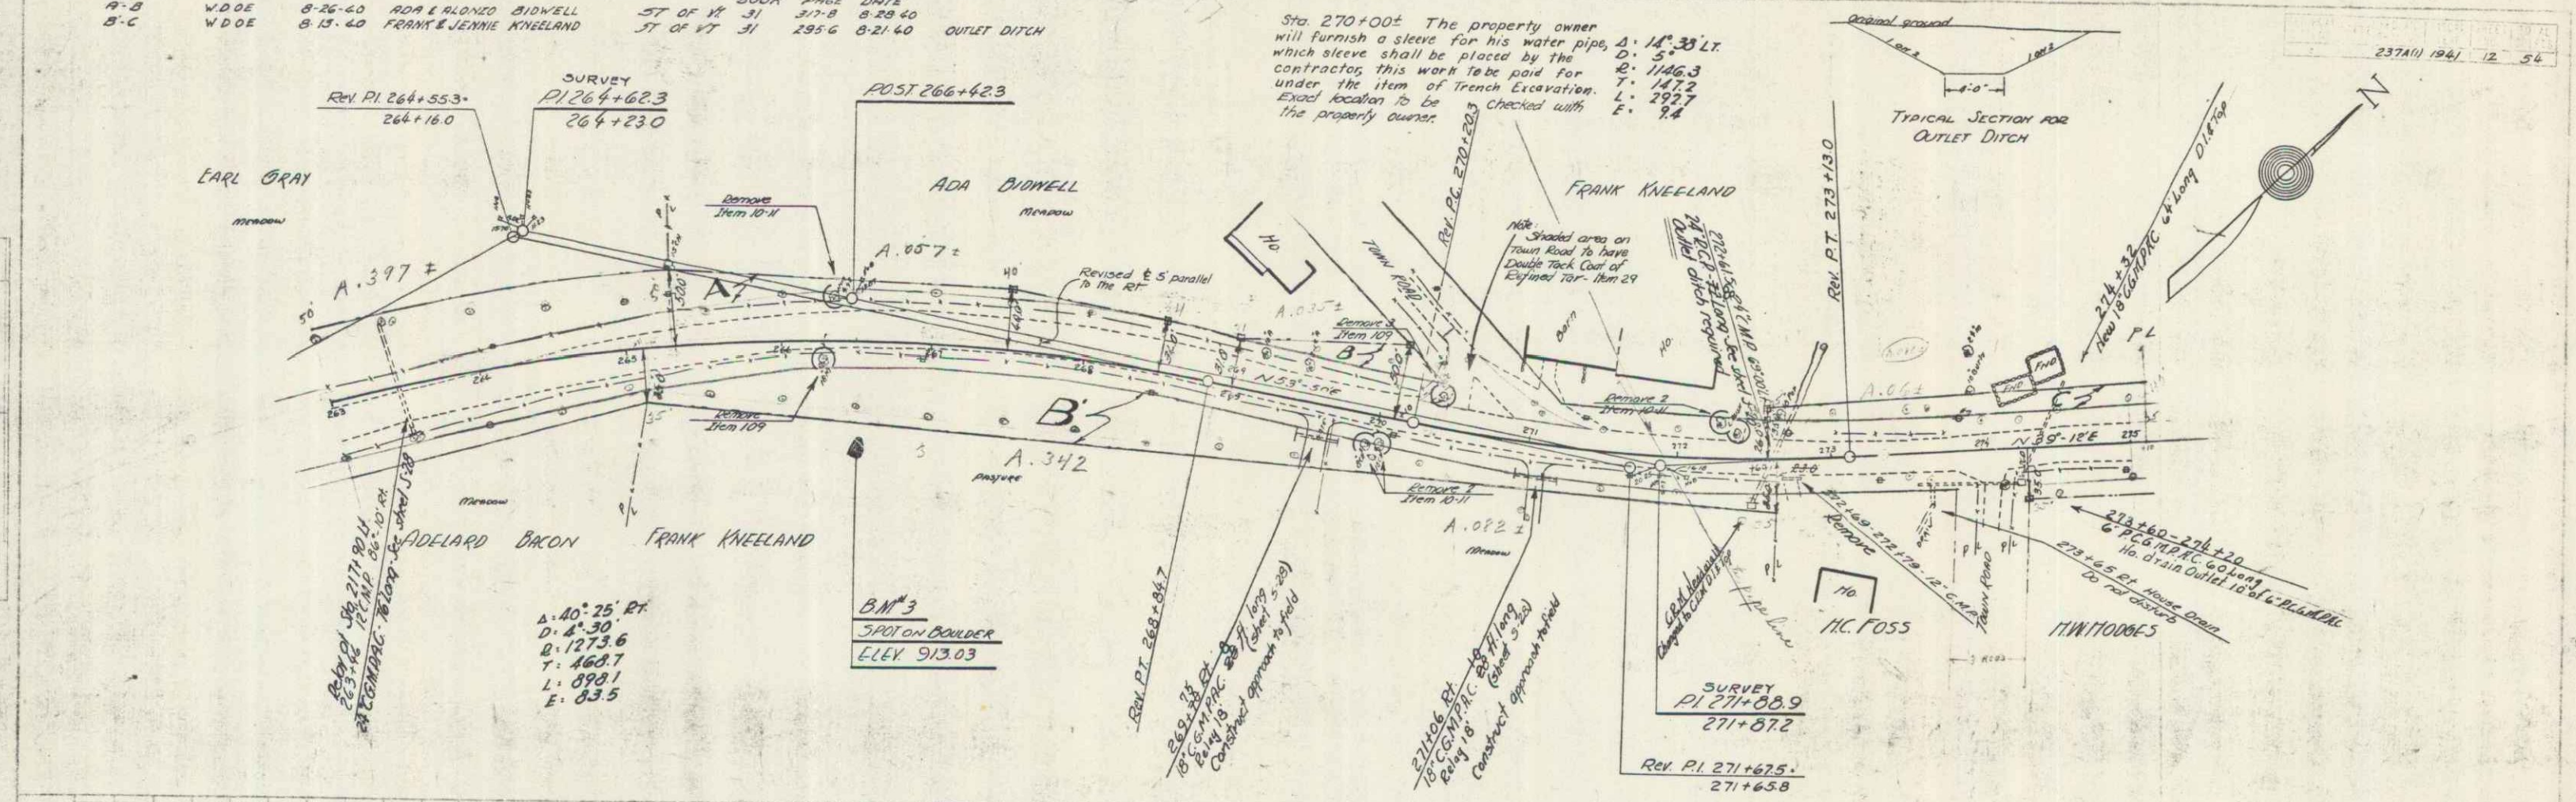

BM#3 SPOT ON BOULDER 67 FT STA 266+48 ELEV 913.03

SERIES F.A.P. NO 237A(1)
SHEET 12 OF 54