
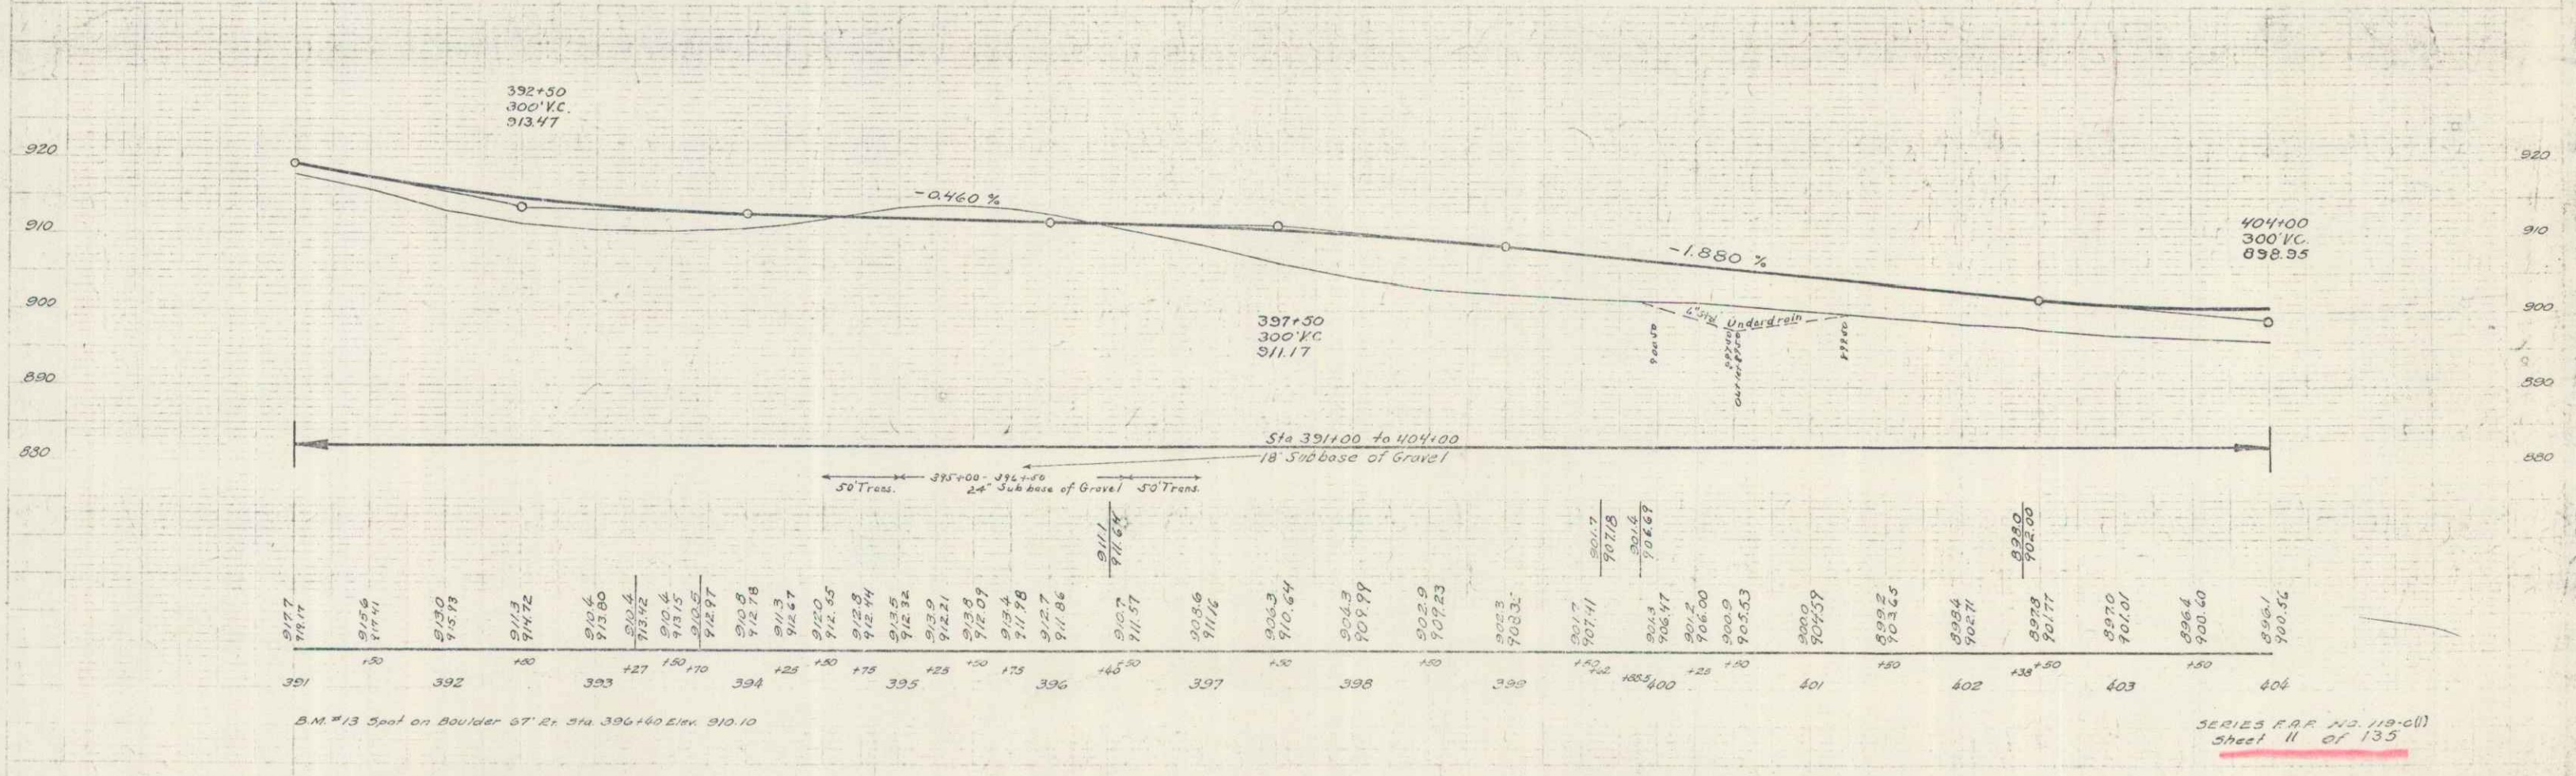


PARCEL INSTRUMENT	DATE	GRANTOR	GRANTEE	RECORDED	REMARKS
C.D. W.D.G.E.	5-20-40	CLARENCE PARIZO	STOFIT	EDEN BOOK 22 PAGE 434-35	1 CULV.

1:5 C(1)1939 11 135

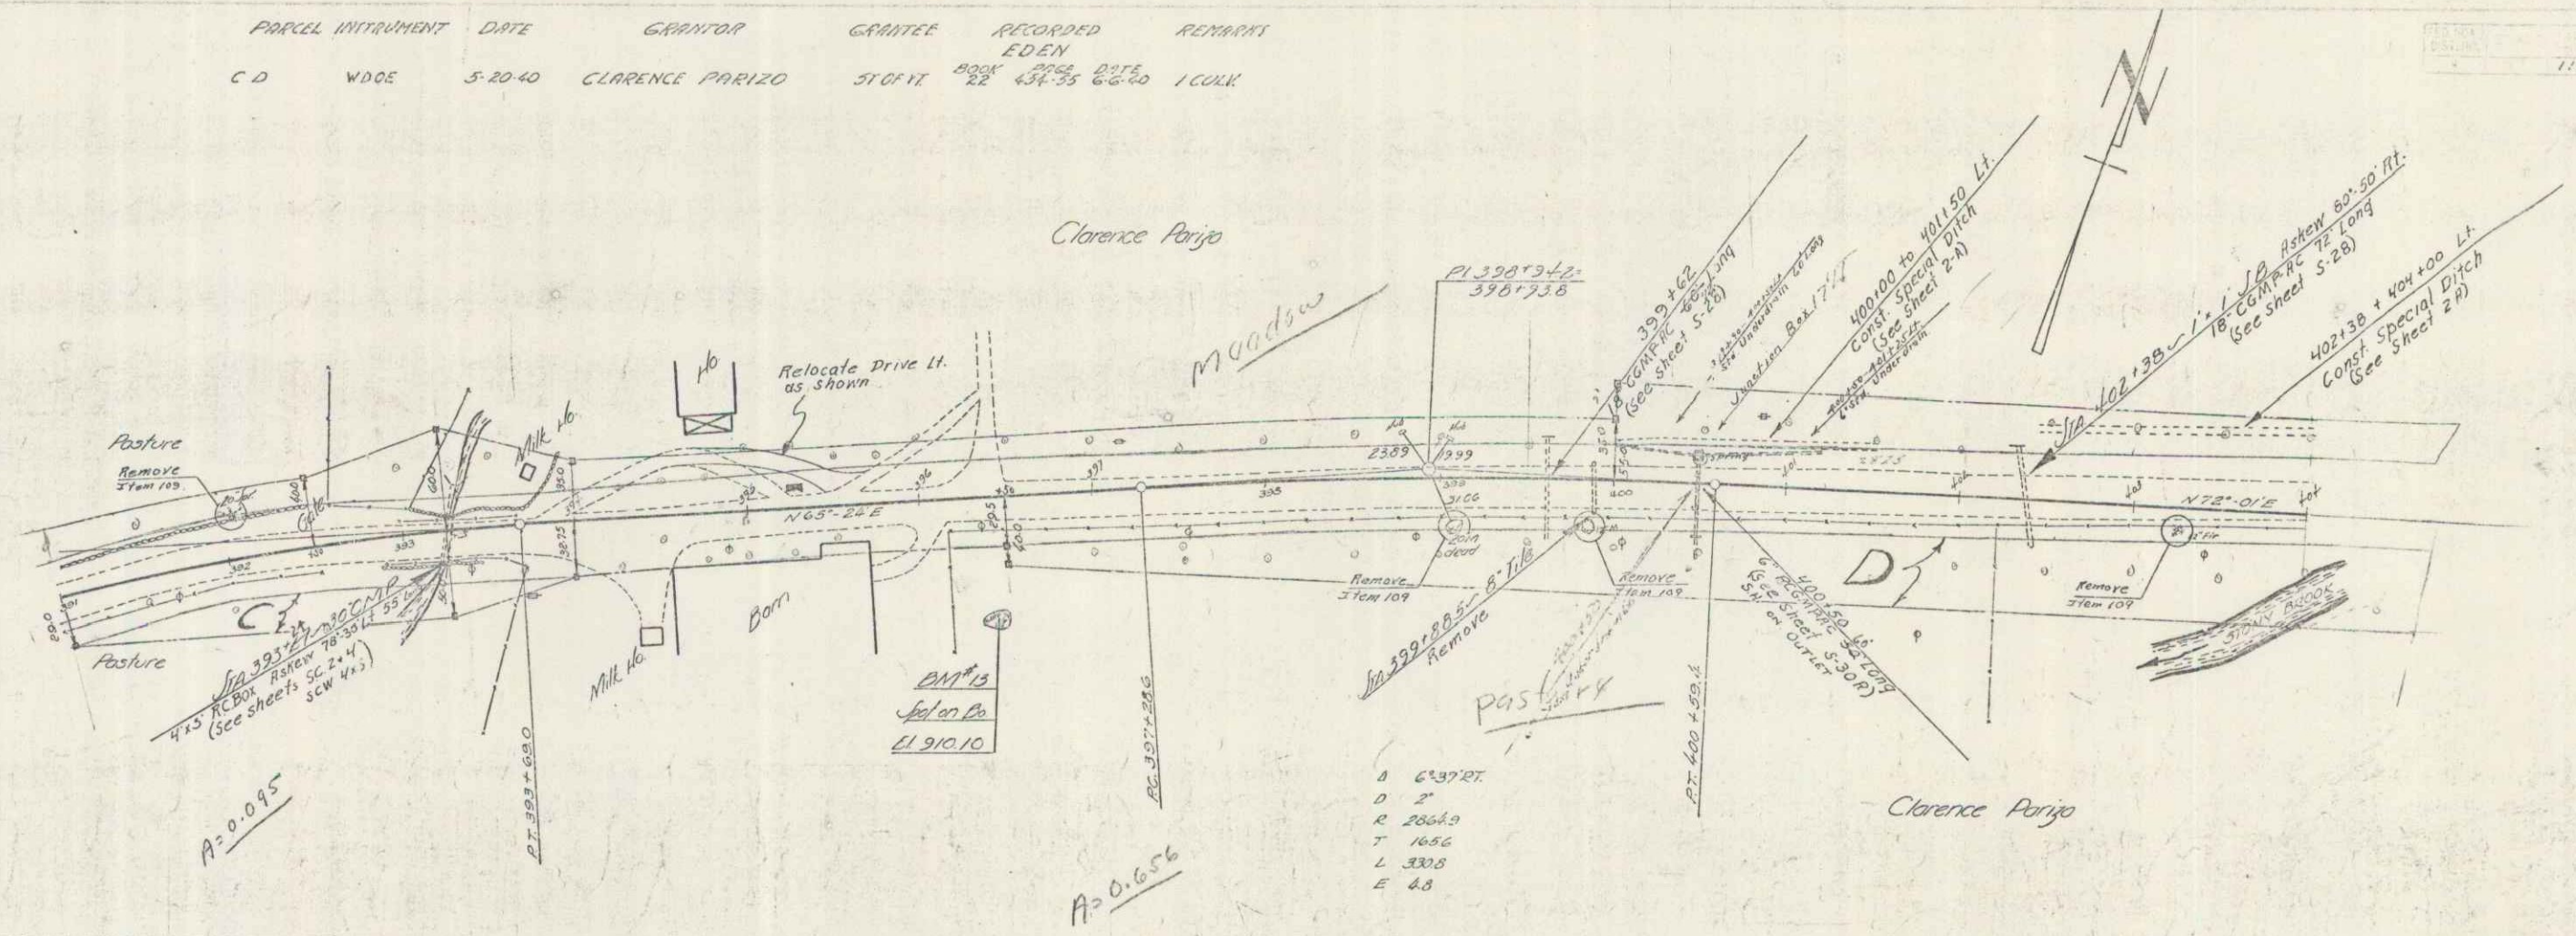

SERIES R.R. NO. 119-C(1)
Sheet 11 of 135