
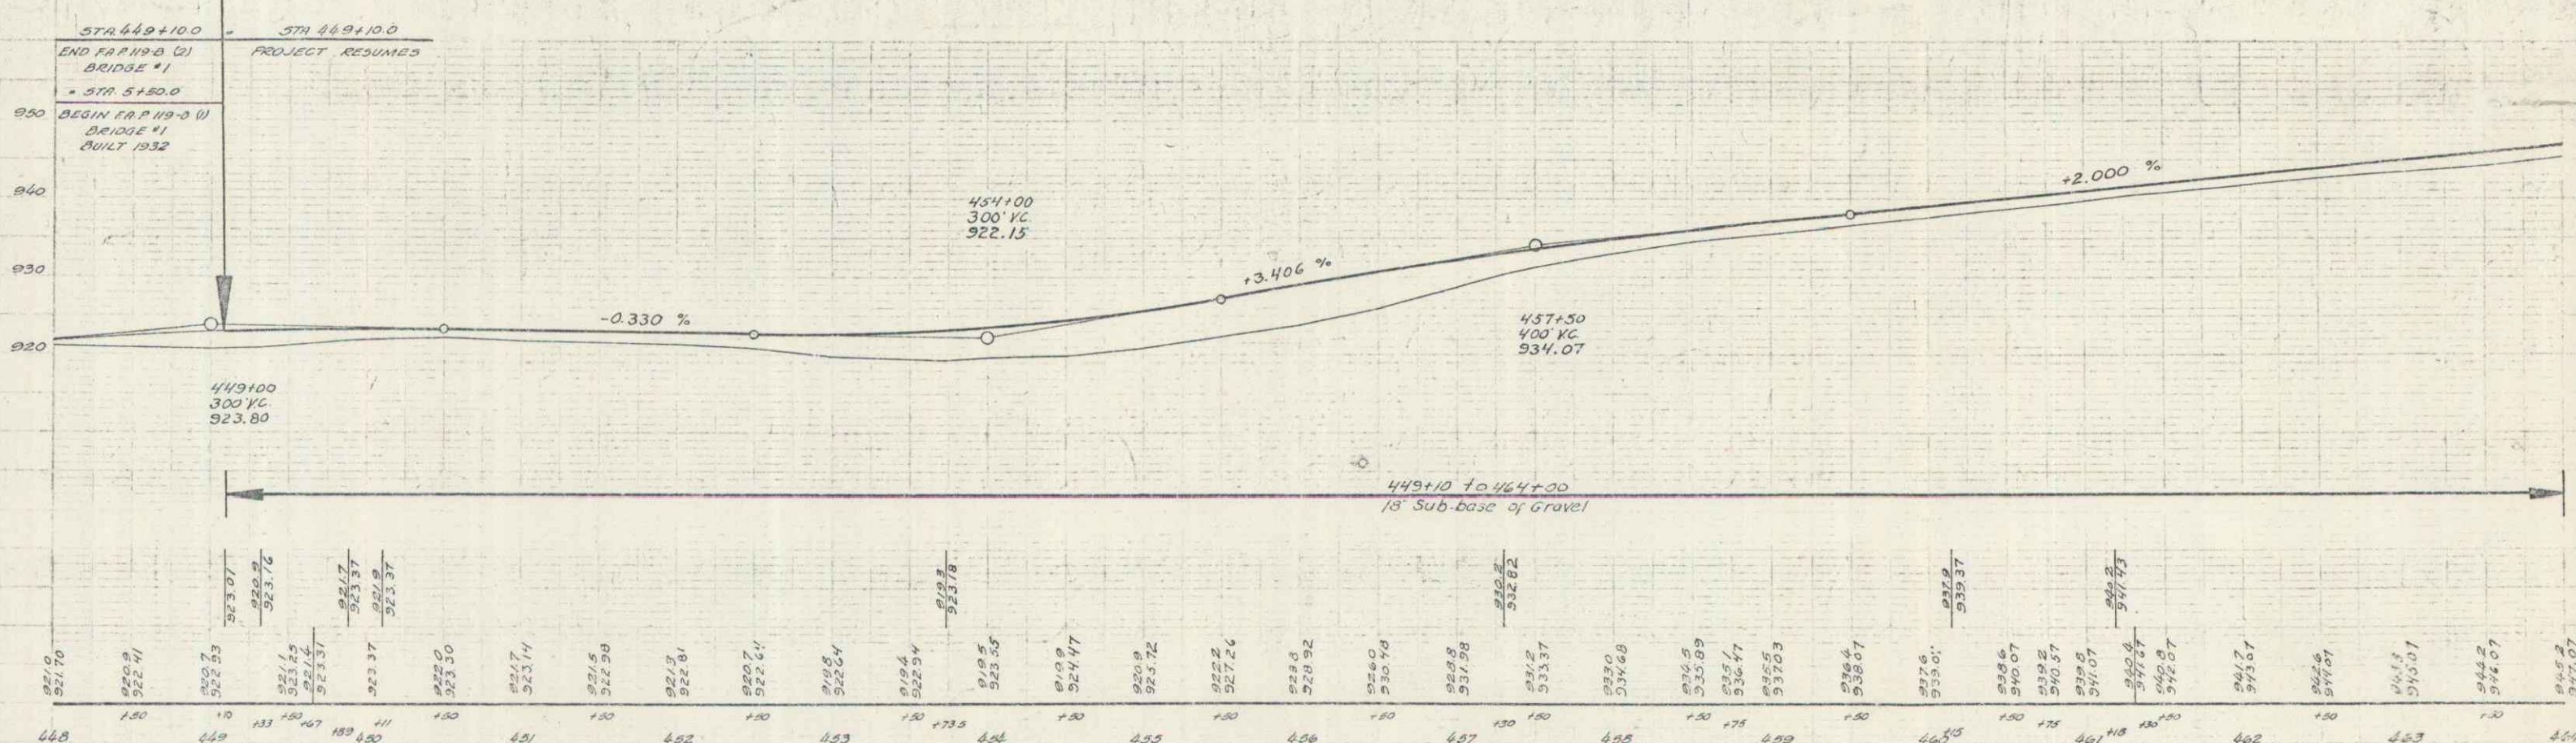


PARCEL	INSTRUMENT	DATE	GRANTOR	GRANTEE	RECORDED	REMARKS
C	WDOE	5-20-40	H.C. PARKER	ST OF VT	BOOK PAGE DATE	
A	WDOE	5-20-40	G.G. & MARY F. CHILTON	ST OF VT	22 422.25 5-21-40	
A'	WDOE	5-20-40	MARY R. & ALMA SWARTZ	ST OF VT	22 422.40 5-21-40	
A''	WDOE	5-20-40	FRED E. SMITH	ST OF VT	22 425.26 5-21-40	

STATE 76-01 1933 15 135

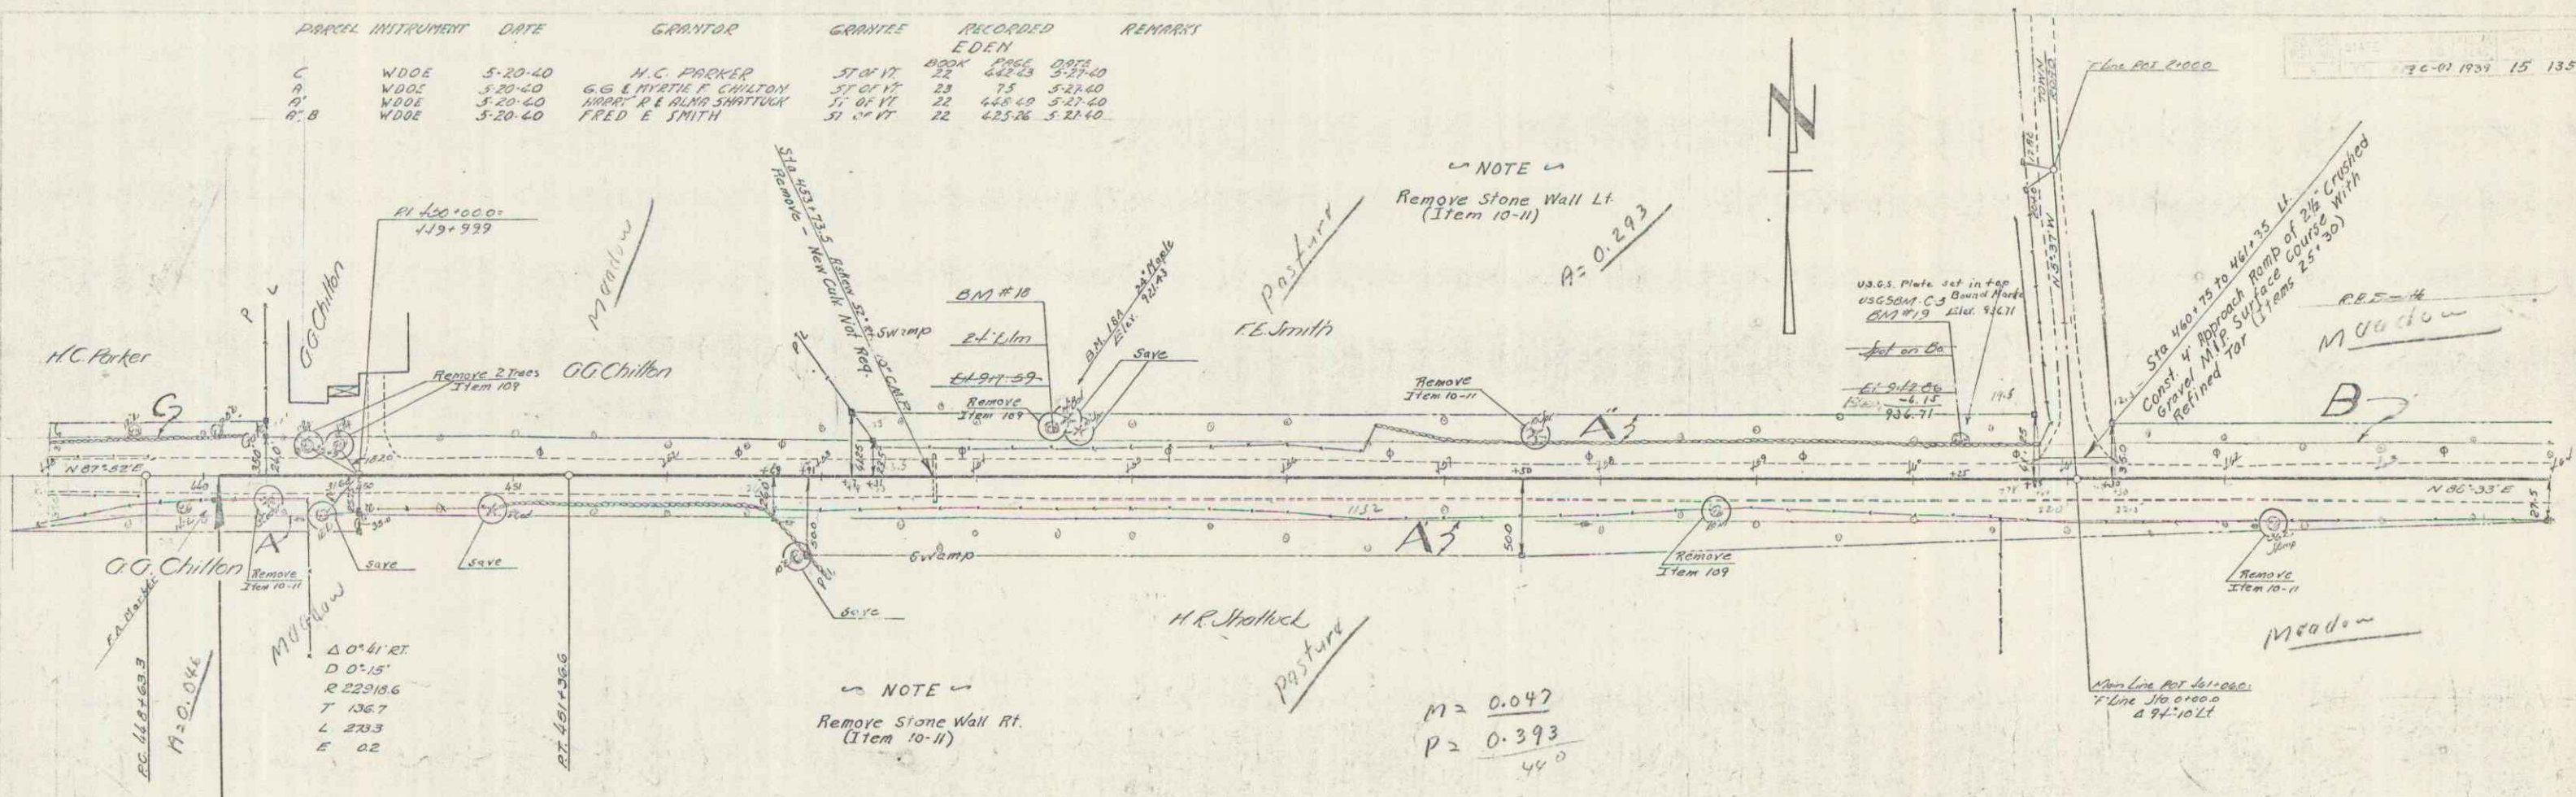

B.M. #18 Spike in Root 2 1/2" E.L.M. 27.5' L. Sta. 449+14.9 Elev. 917.59
 B.M. #19 U.S.G.S. B.M. Bronze Plate in Boulder 22.5' L. Sta. 460+13.0 Elev. 942.89

SERIES F.A. NO. 19-C
 Sheet 15 of 135