



PLAN SHEET
No. 1
Scale 1" = 100'
Date 10-1-51

PLAN SHEET
No. 1
Scale 1" = 100'
Date 10-1-51

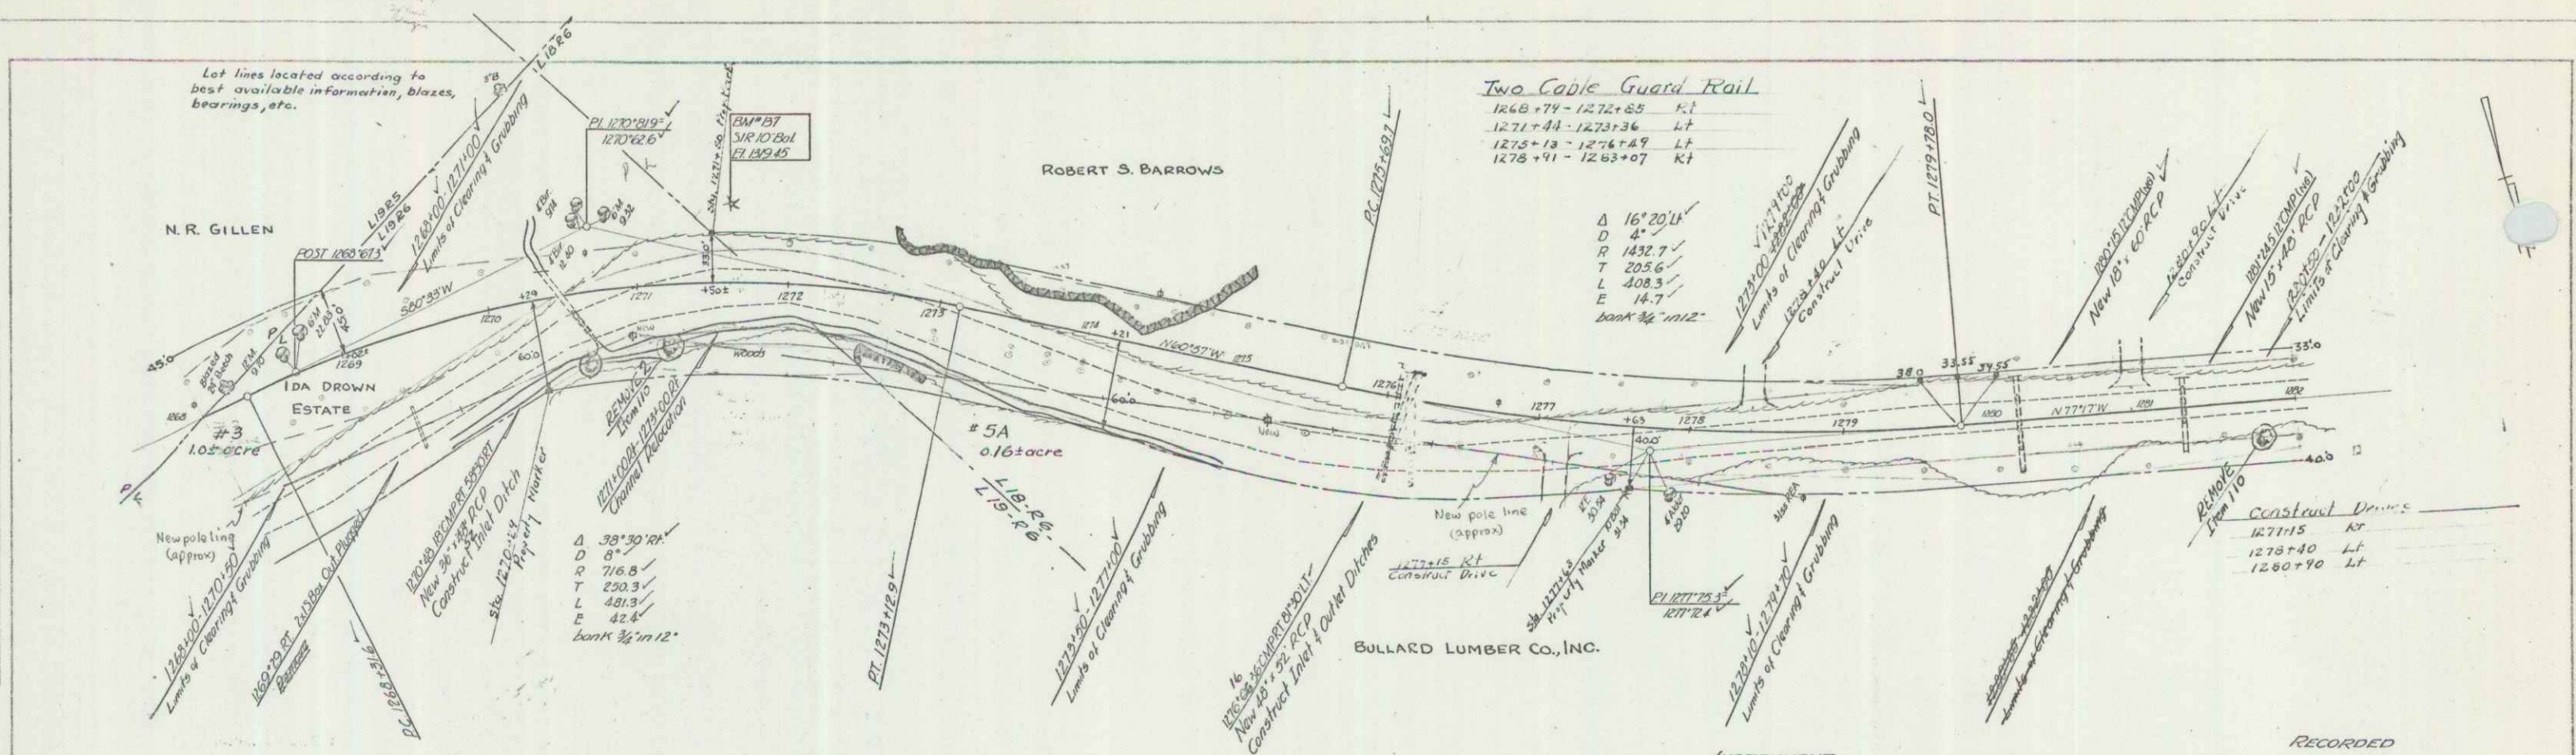

PARCEL	INSTRUMENT	GRANTOR	GRANTEE	BOOK	PAGE	DATE	REMARKS
5, A, B	CORP. D.O.E.	BULLARD LUMBER COMPANY	ST. OF VT.	12	385-87	10-6-51	
3	Q.C.D. 8-27-51	CLADYS D. HAWTHORNE & GOLDIE WOOD	ST. OF VT.	21	376	4-26-52	

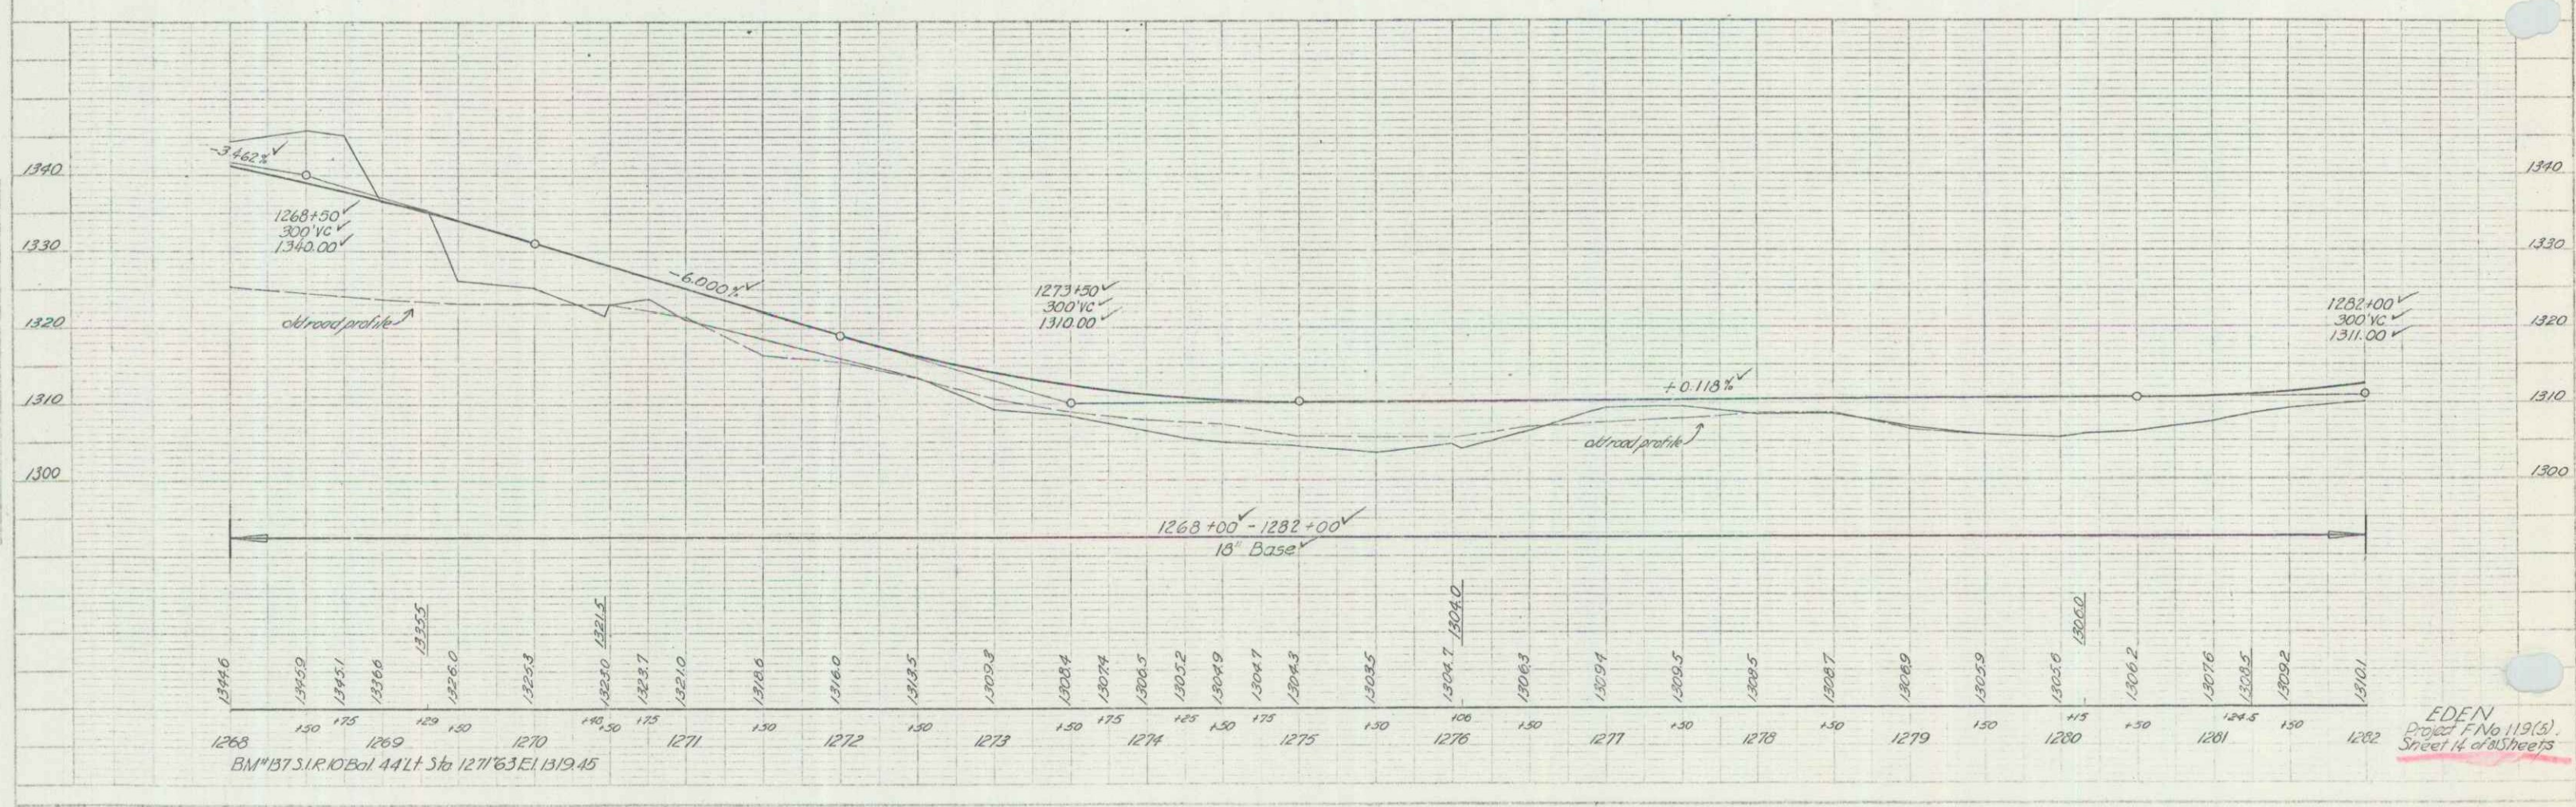

EDEN
Project No 119(3)
Sheet 14 of 15 sheets