
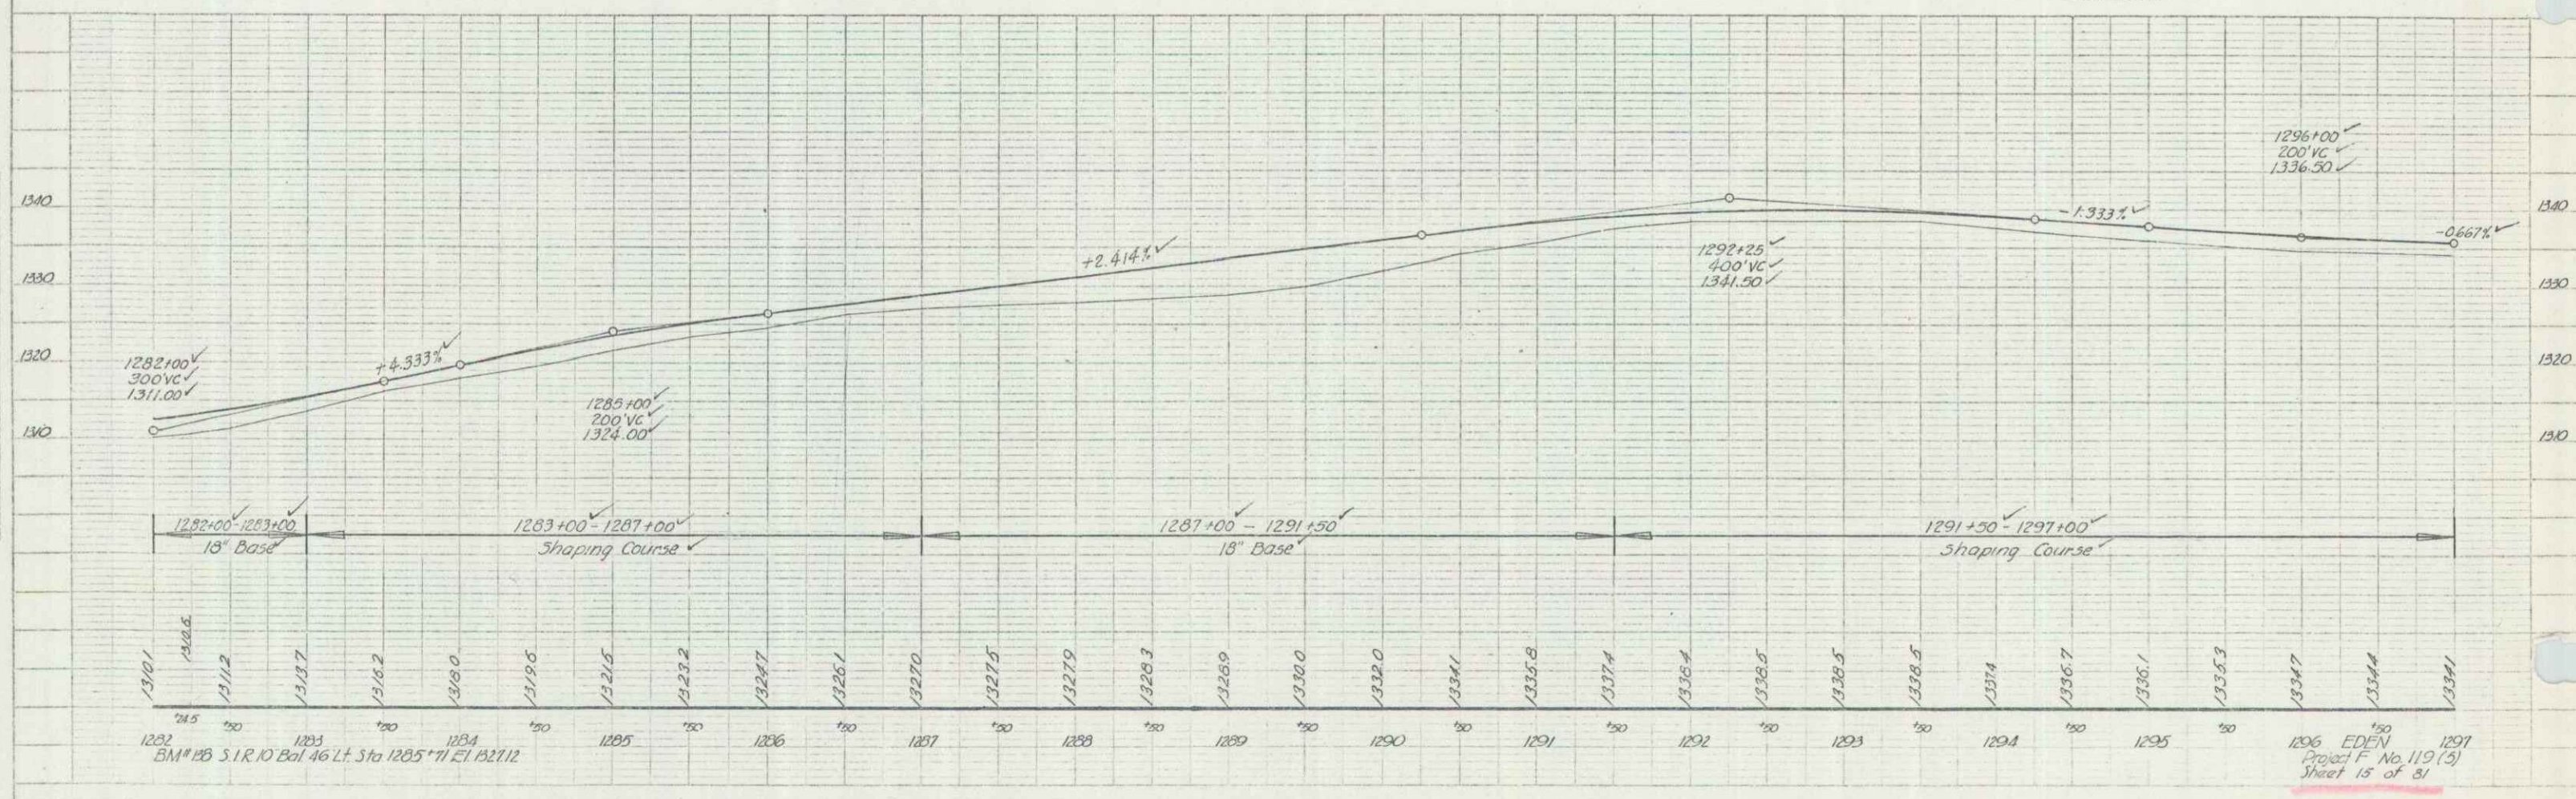


PLAN
 1/2" = 100'
 1/4" = 100'
 1/8" = 100'

PROFILE
 1/2" = 100'
 1/4" = 100'
 1/8" = 100'

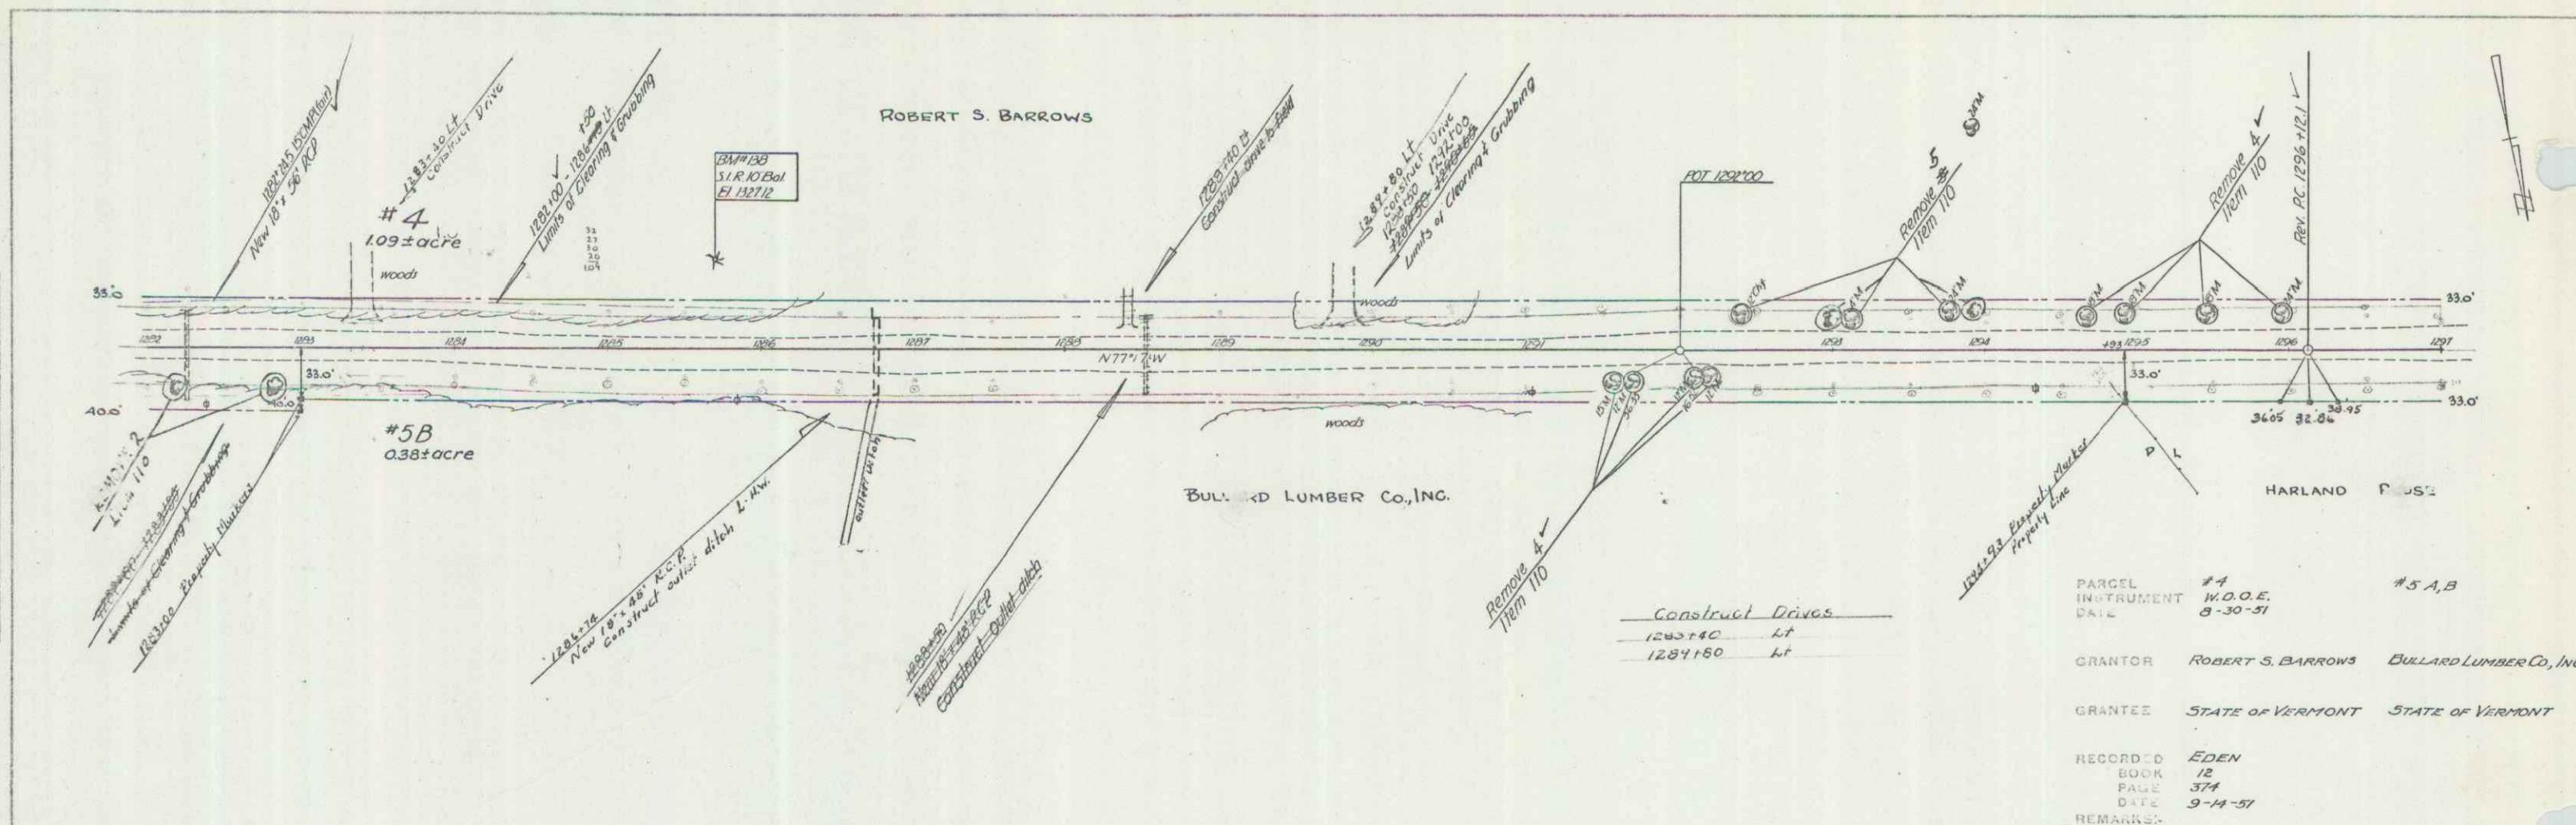

PARCEL #4
 INSTRUMENT W.D.O.E.
 DATE 8-30-51

GRANTOR ROBERT S. BARROWS BULLARD LUMBER CO., INC.

GRANTEE STATE OF VERMONT STATE OF VERMONT

RECORD D EDEN
 BOOK 12
 PAGE 374
 DATE 9-14-51

REMARKS:

EDEN
 Project F No. 119 (3)
 Sheet 15 of 81