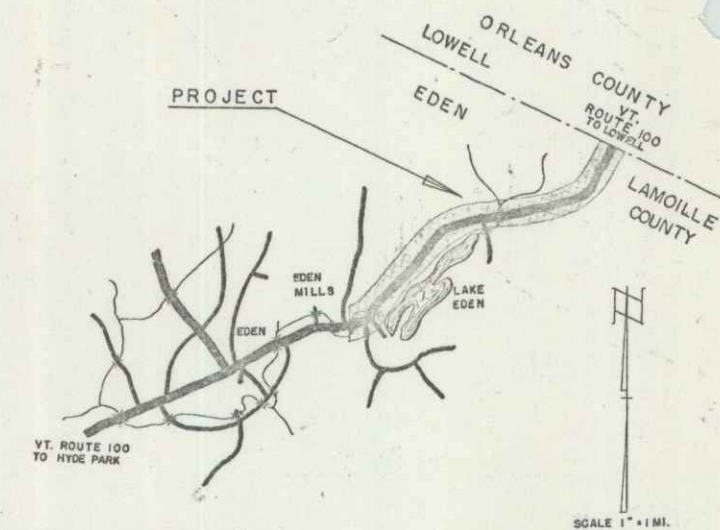


PLAN AND PROFILE OF PROPOSED STATE HIGHWAY

BEGINNING AT THE LOWELL-EDEN TOWN LINE AND EXTENDING SOUTH-
WESTERLY 18,306.5 FEET.

NOTE: Any further information concerning final quantities, amounts or other details relative to this project may be found in either the field books or the estimate file.

[illegible]

STANDARD STRUCTURE SHEETS APPROVED BY THE CHIEF
ENGINEER, VERMONT STATE DEPARTMENT OF HIGHWAYS
S - 40 JUNE 10, 1950

(To Be Returned To R.O.W. Division)

47100
PERPETUAL
W N F I L E
OF-WAY DIVISION

LENGTH OF PROJECT

LENGTH OF ROADWAY	18,258.5 FEET = 3.458 MILES
LENGTH OF BRIDGE	480 FEET = 0.009 MILE
TOTAL LENGTH	18,306.5 FEET = 3.467 MILES

Project: F119C5)
DATE: 07/05/1957
PIN: 00R637



RIGHT-OF-WAY DIVISION
TOWN FILE

PERPETUAL
 Town of Uxio
 (To Be Returned To R.O.W. Division)

APPROVED: JULY 2, 1951
W. E. Sargent
 CHIEF ENGINEER
 SUBMITTED BY ORDER OF THE STATE HIGHWAY BOARD

[illegible]

GROUND ELEVATION _____ DATUM _____

GRADE ELEVATION _____ DATUM _____

CURVE DATA

DEFLECTION ANGLE.....	Δ
DEGREE OF CURVE.....	D.
RADIUS OF CURVE.....	R.
TANGENT DISTANCE.....	T.
LENGTH OF CURVE.....	L
EXTERNAL DISTANCE.....	E.
POINT OF INTERSECTION.....	P. I.
POINT OF CURVE.....	P. C.
POINT OF TANGENT.....	P. T.
POINT ON TANGENT.....	P. O. T.

EVEN F 119(5)

WHITEHALL CONST. CO.
RECORD PLANS.
CONST. COMPLETED NOV. 26 1952.

SCALES	
	1"= 1000'
	1"= 2'
	1"= 50'
HORIZONTAL	1"= 50'
VERTICAL	1"= 10'
PROFILES	1"= 5'

PROJECT NAME AND NUMBER	TYPE	CONST. BEGINNEMENT AREA
EVEN F119(S)	M.I.E.	44,749 SQ.YDS
RECORD PLANS		
MATERIALS		
CEMENT, ALPHA PORT. AND CEMENT		A CEMENT- BENSER PIPE CO.
CONC. AGGREGATES- M. DENIN PLANT		CRUSHED GRAVEL- MAUDEN P.T.
REIN. STEEL- J. TRINER, W. 30 S.		GRAVEL- DOLAN PIT
TAR- E.S.S. STANWAX OIL		- HARRINGTON PIT
ASPHALT- E.S.S. STANWAX OIL		# FIBER CEMENT PIPE
R.C.P.- VERMONT CONC. PIPE CO.		ORANGEBURG MANF. CO.
CONTRACTOR WHITECLOUD CONST. CO.		CONTRACT LATER- OCT. 1, 1951
E.C. ENGR.- E.C. GLYSON		" STARTED- OCT. 10 "
INSPECTOR- C. H. CROSSETT		" COMPLETED- NOV. 26, 1951
RECORD PLANS- E.C.G. MINK S. 1953		" ACCEPTED- NOV. 26, 1951

THESE PLANS ARE SUBJECT TO SUCH REVISIONS AS MAY BE REQUIRED BY THE BUREAU OF PUBLIC ROADS OR THE COMMISSIONER OF HIGHWAYS.

CONSTRUCTION IS TO BE CARRIED ON IN ACCORDANCE WITH THE PLANS AND THE STANDARD ROAD AND BRIDGE SPECIFICATIONS OF 1948, AS APPROVED JULY 25, 1949 BY THE BUREAU OF PUBLIC ROADS, INCLUDING ALL SUBSEQUENT APPROVED REVISIONS AND SUCH REVISED SPECIFICATIONS AND SPECIAL PROVISIONS AS ARE SUBMITTED WITH THE PLANS.

DEPARTMENT OF COMMERCE
BUREAU OF PUBLIC ROADS
RECOMMENDED FOR APPROVAL

DISTRICT ENGINEER

APPROVED



DIVISION		ENGINEER	DATE
PROJECT	F NO. 119(5) FILED		
SHEET	1 OF 8/		

APPROVED JULY 2, 1951 <i>C. D. Bishop</i> BRIDGE ENGINEER	APPROVED JULY 2, 1951 <i>H. W. Mansueti</i> HIGHWAY ENGINEER	APPROVED JULY 5, 1951 <i>E. H. Stickney</i> DISTRICT ENGINEER
---	--	---

PLAN
 DATE BOOK
 5/27/69
 11:50
 HURLEY


PROF.
 DATE BOOK
 5/27/69
 11:50
 HURLEY


Construct Drive
 1237+00 K+

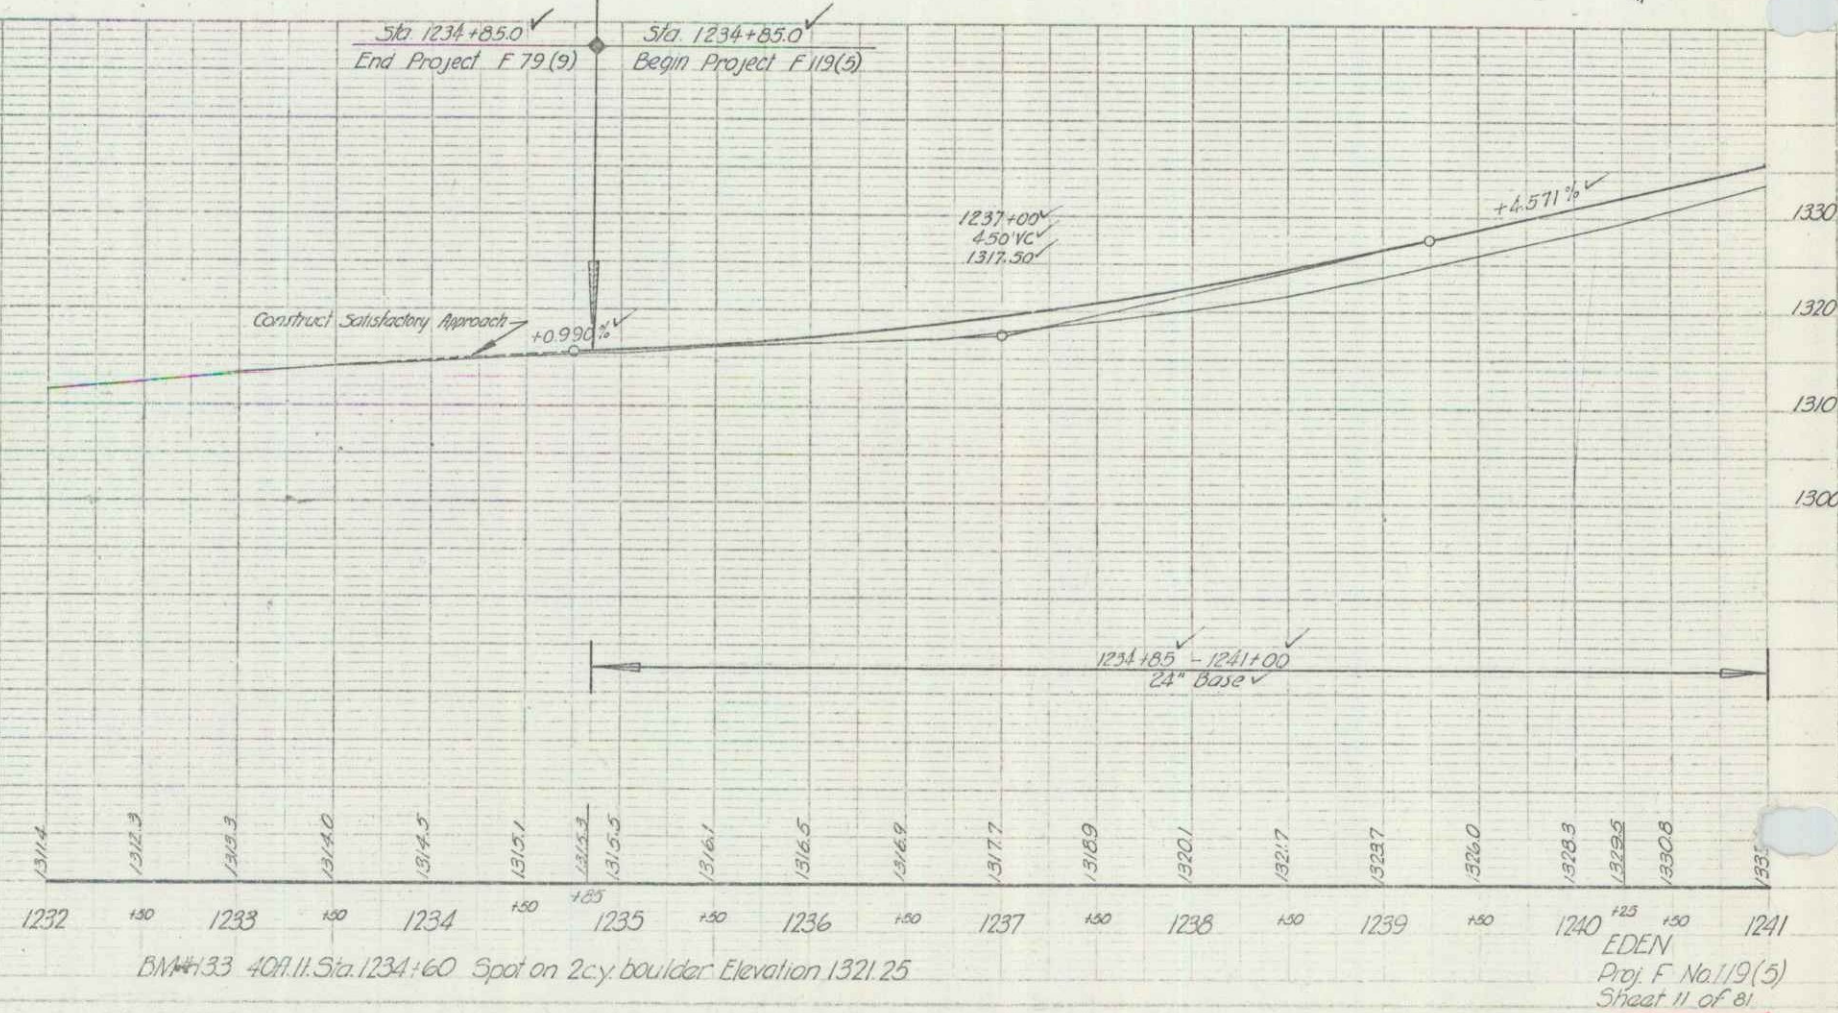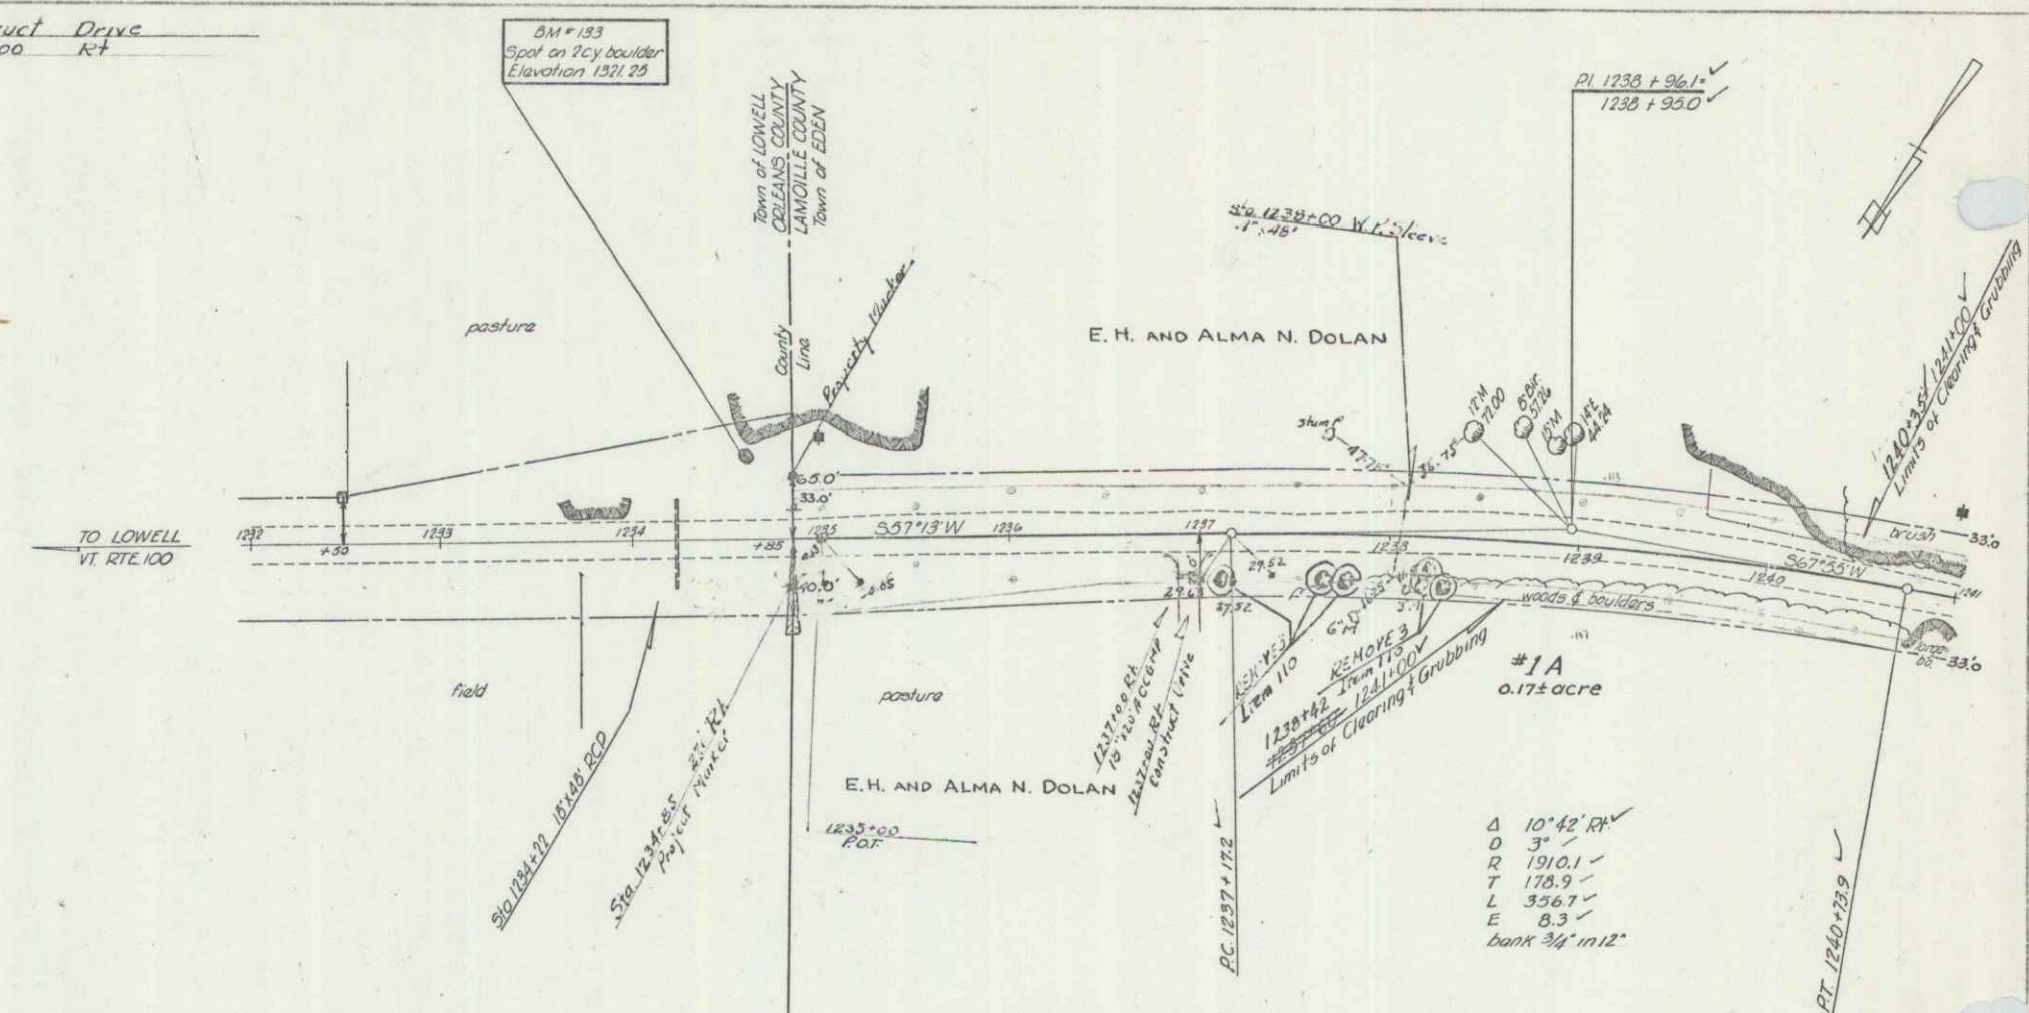

BM #33 401.11 Sta. 1234+60 Spot on 2cy boulder Elevation 1321.25



EDEN
 Proj. F No. 119(5)
 Sheet 11 of 81

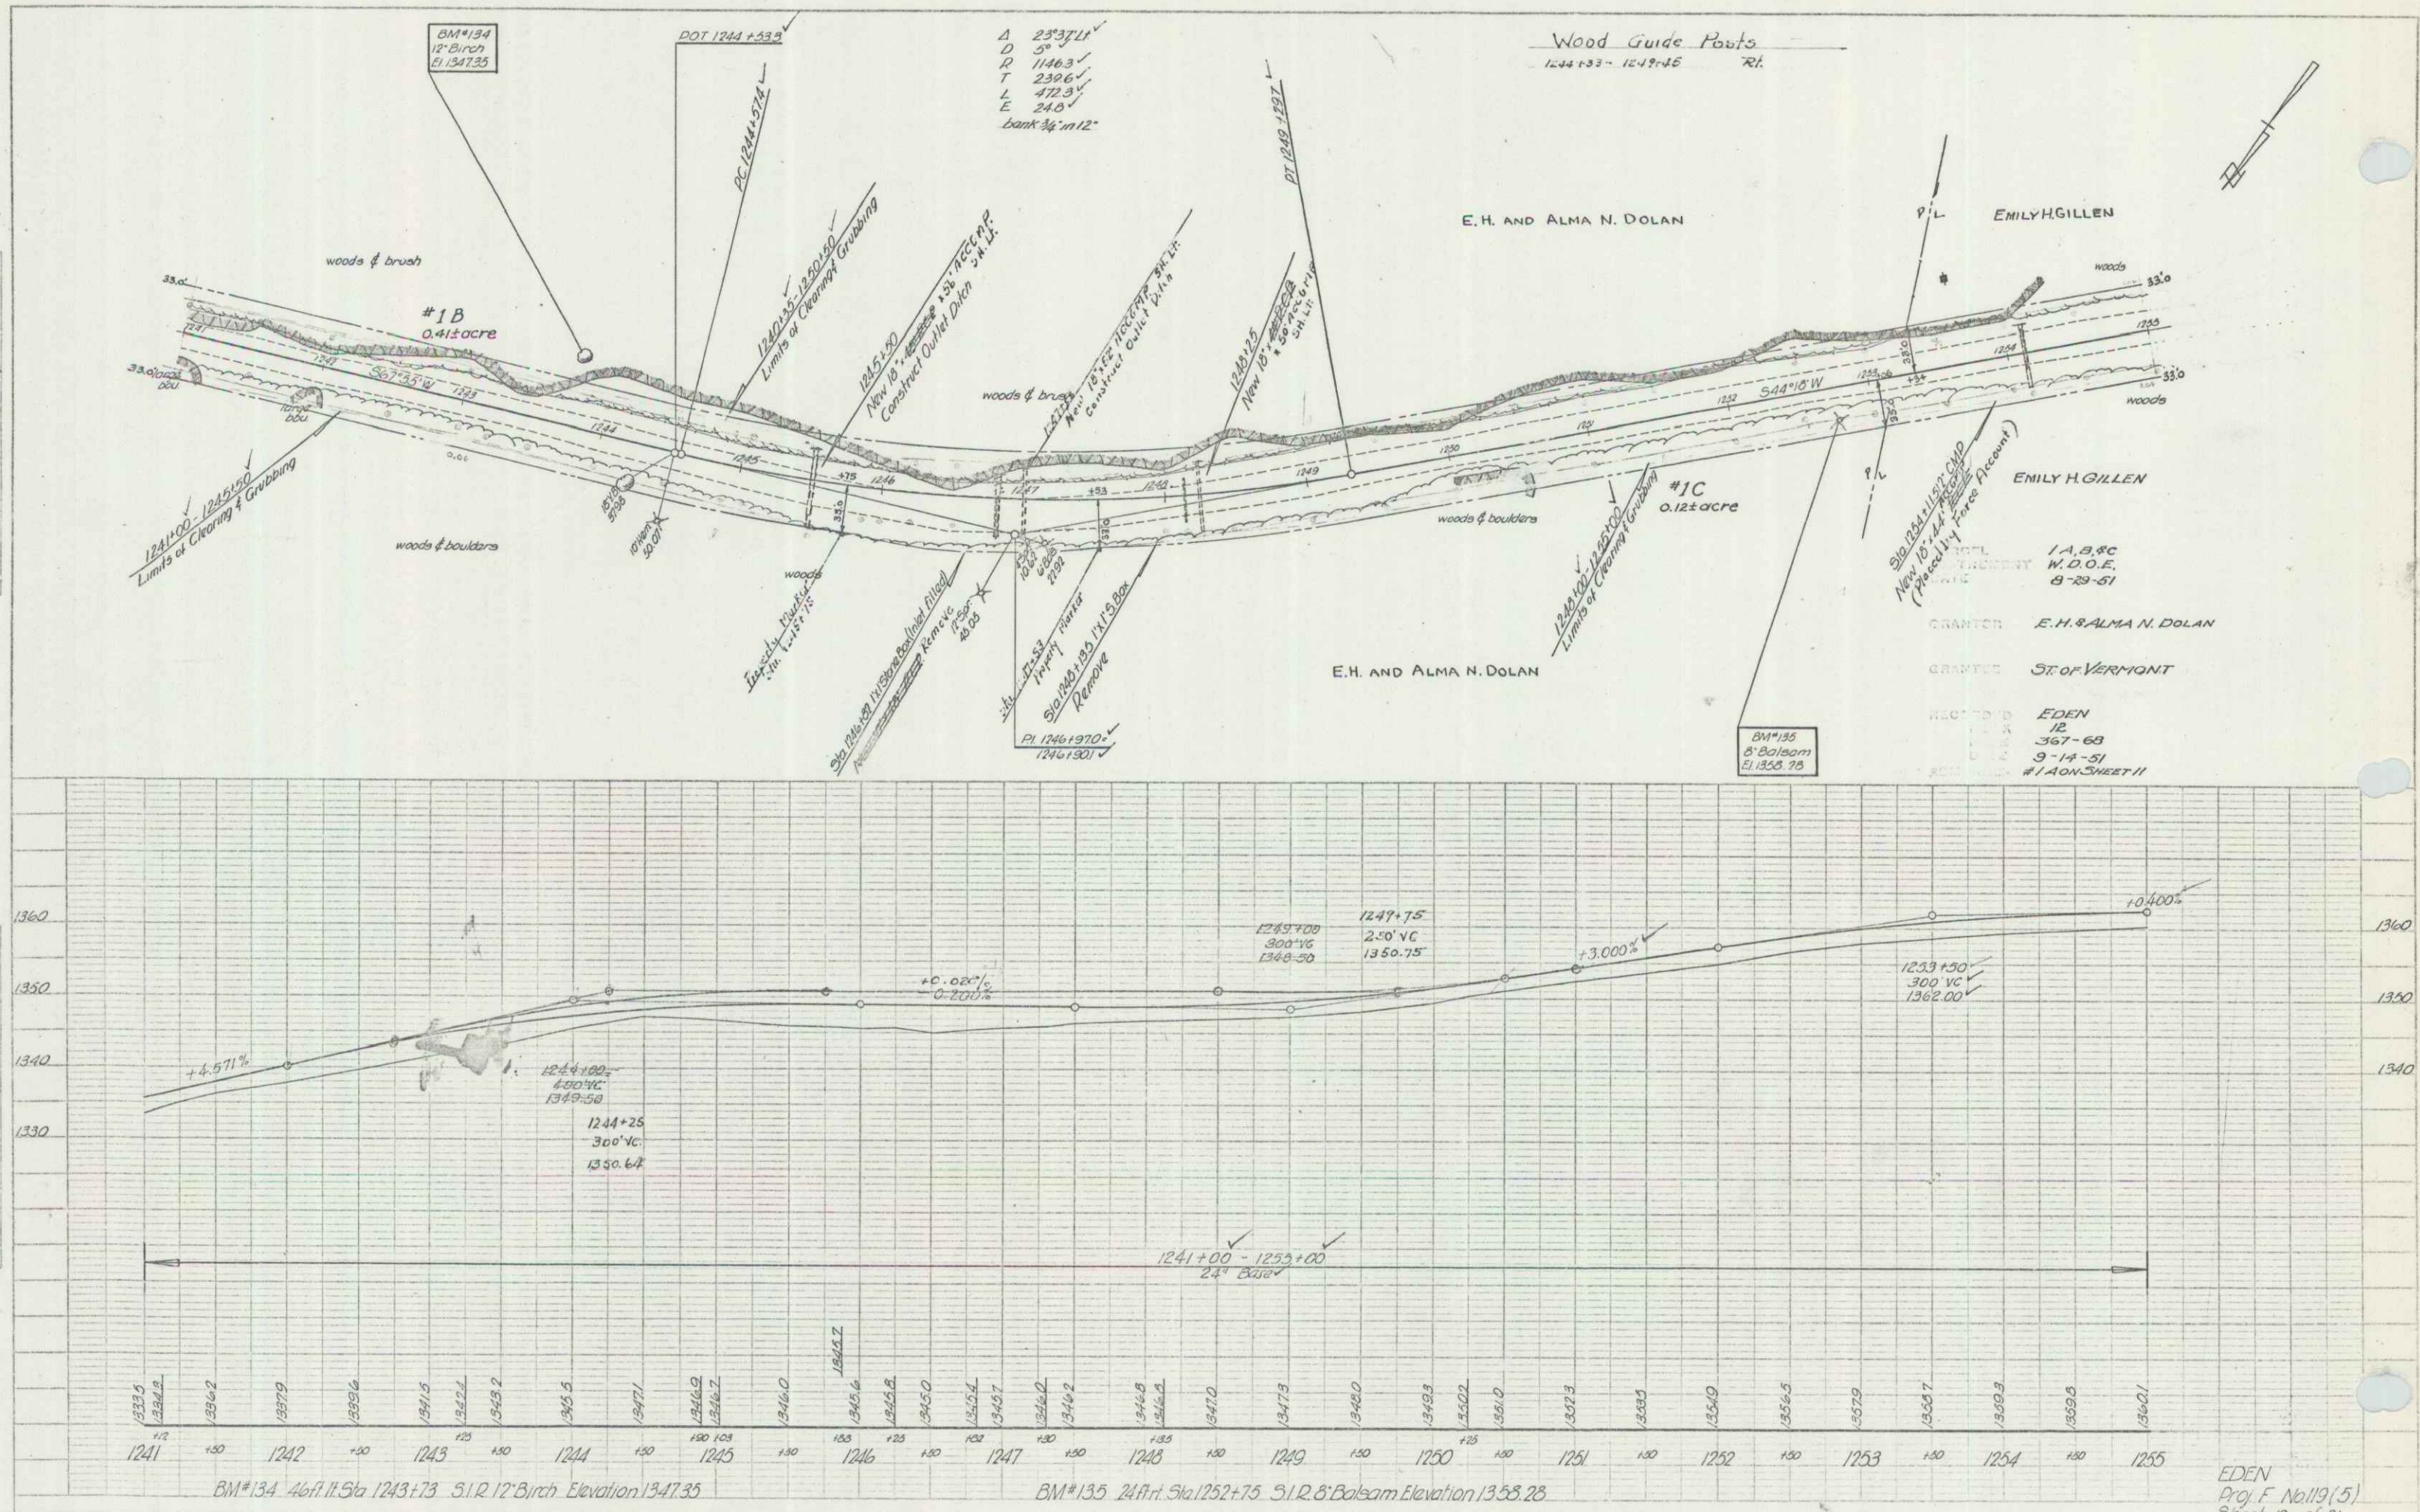

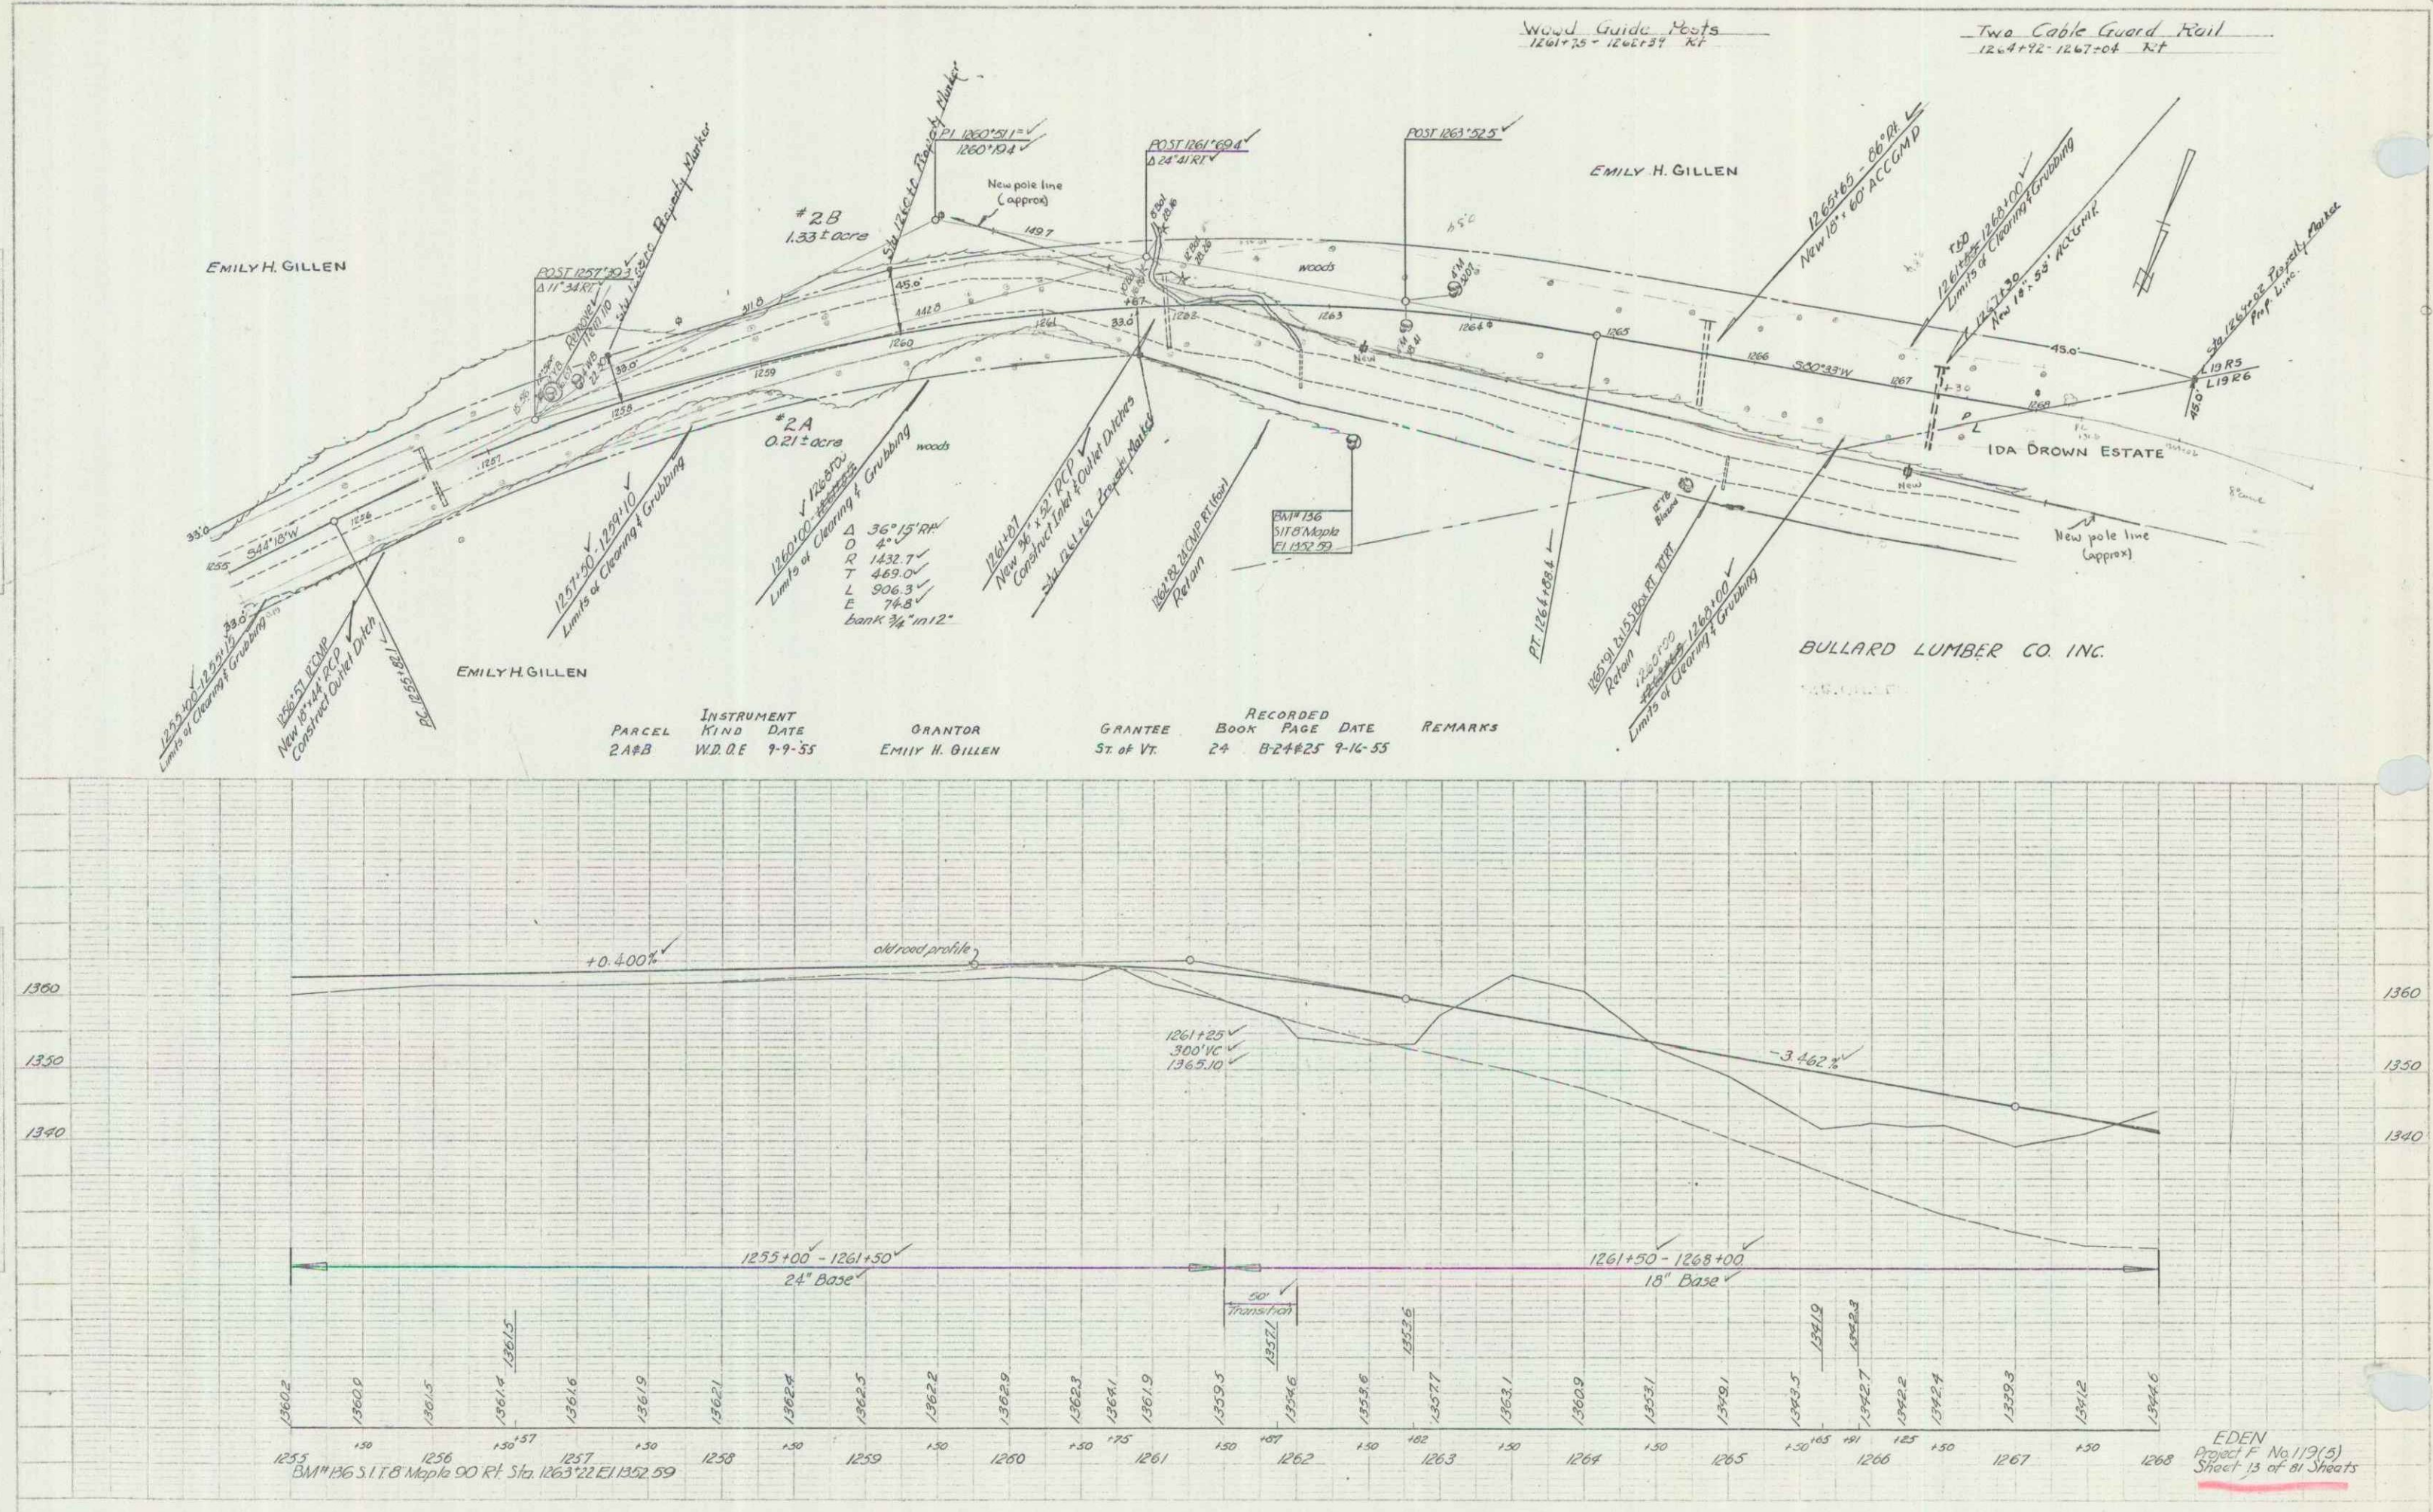

PLAN
 1/2" = 100'
 1/4" = 100'
 1/8" = 100'

PROFILE
 1/2" = 100'
 1/4" = 100'
 1/8" = 100'

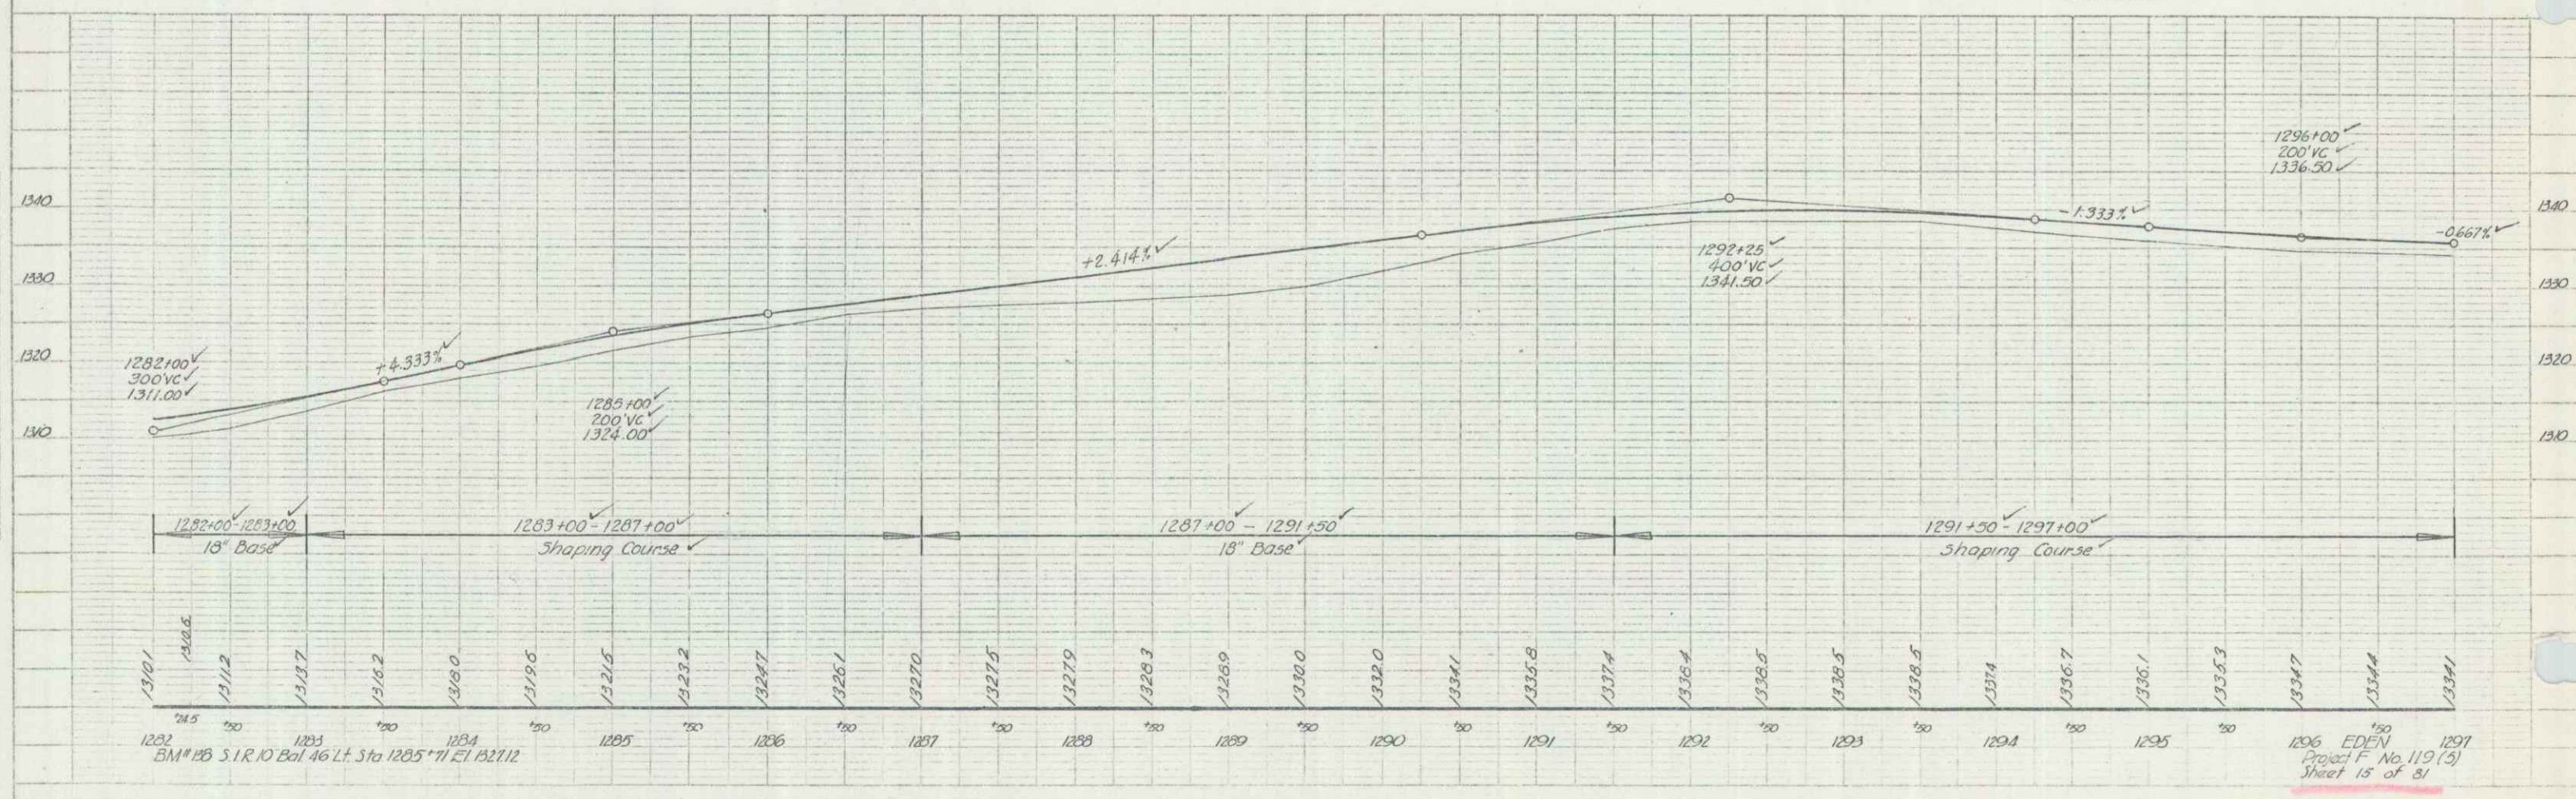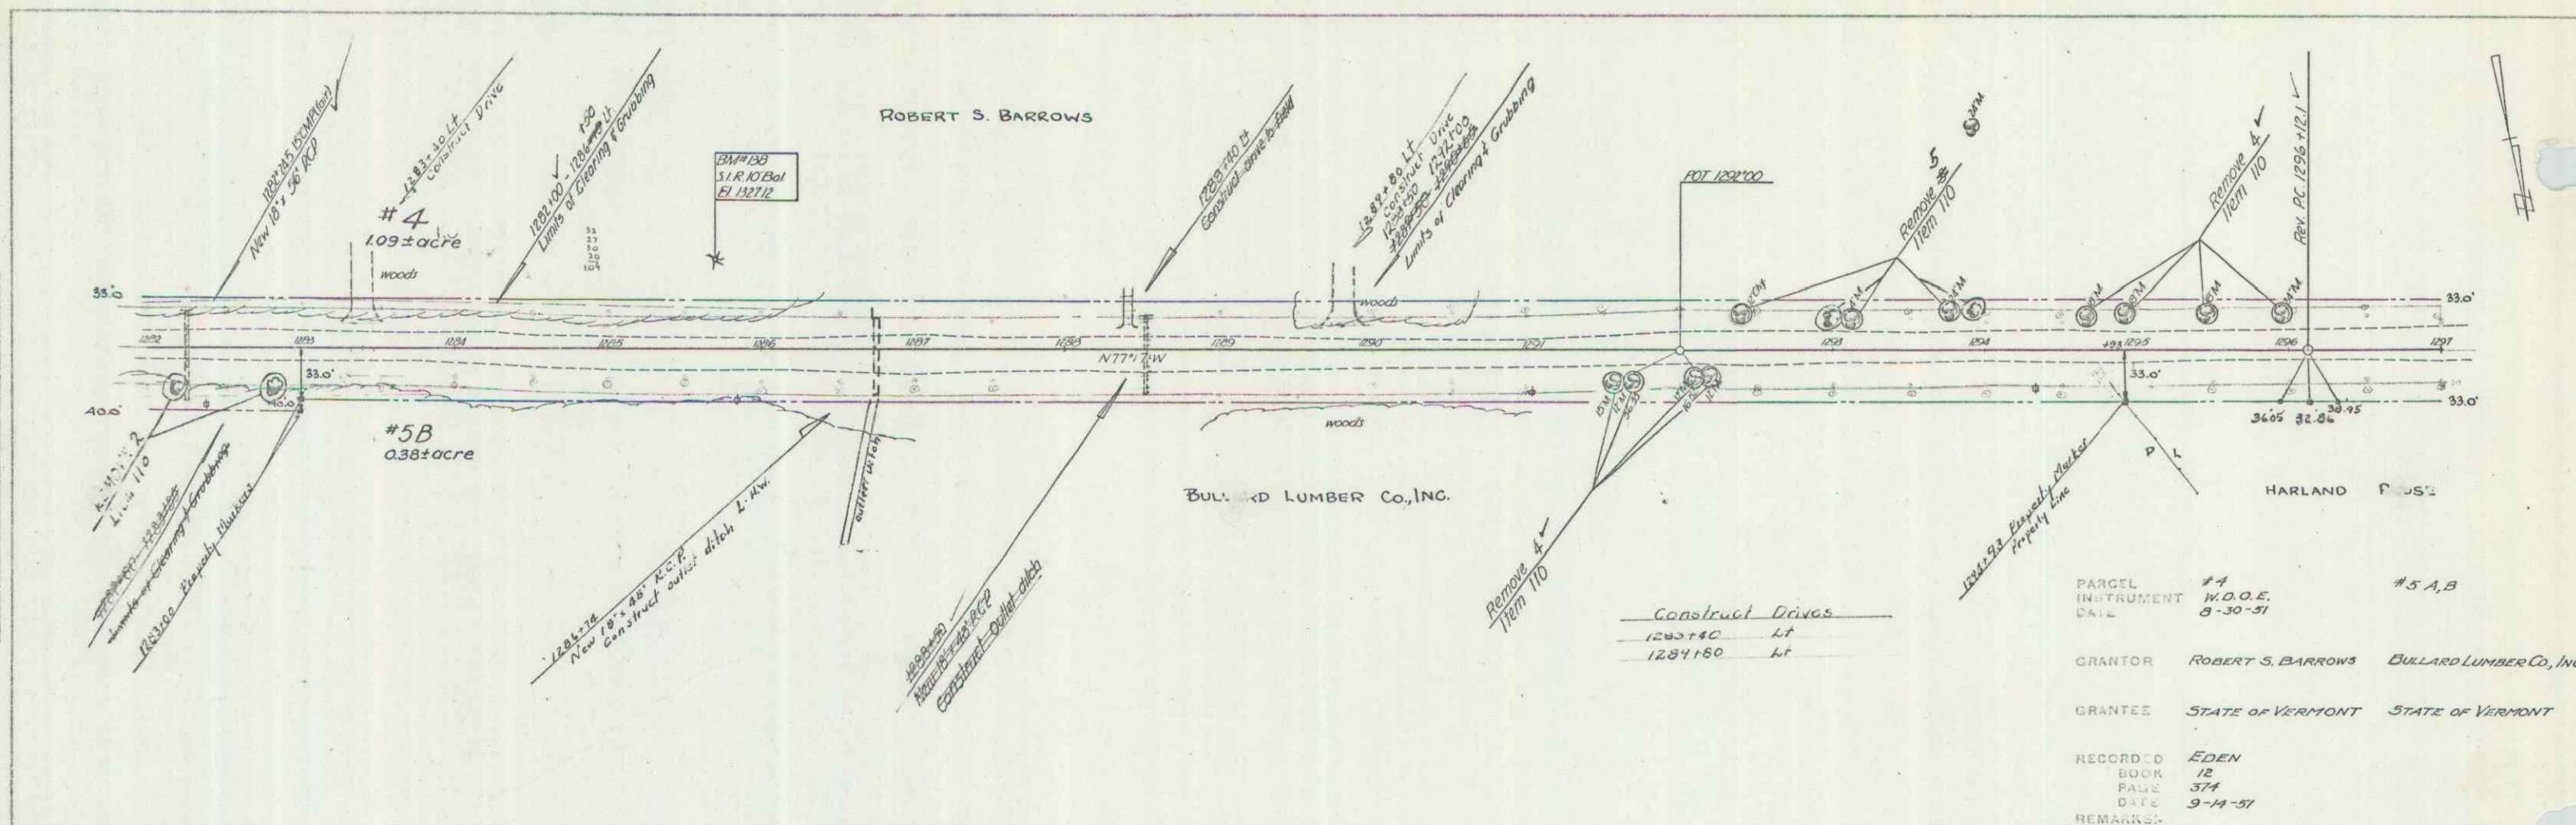

PARCEL #4
 INSTRUMENT W.D.O.E.
 DATE 8-30-51


GRANTOR ROBERT S. BARROWS BULLARD LUMBER CO., INC.

GRANTEE STATE OF VERMONT STATE OF VERMONT

RECORD D EDEN
 BOOK 12
 PAGE 374
 DATE 9-14-51



REMARKS:


EDEN
 Project F No. 119 (3)
 Sheet 15 of 81

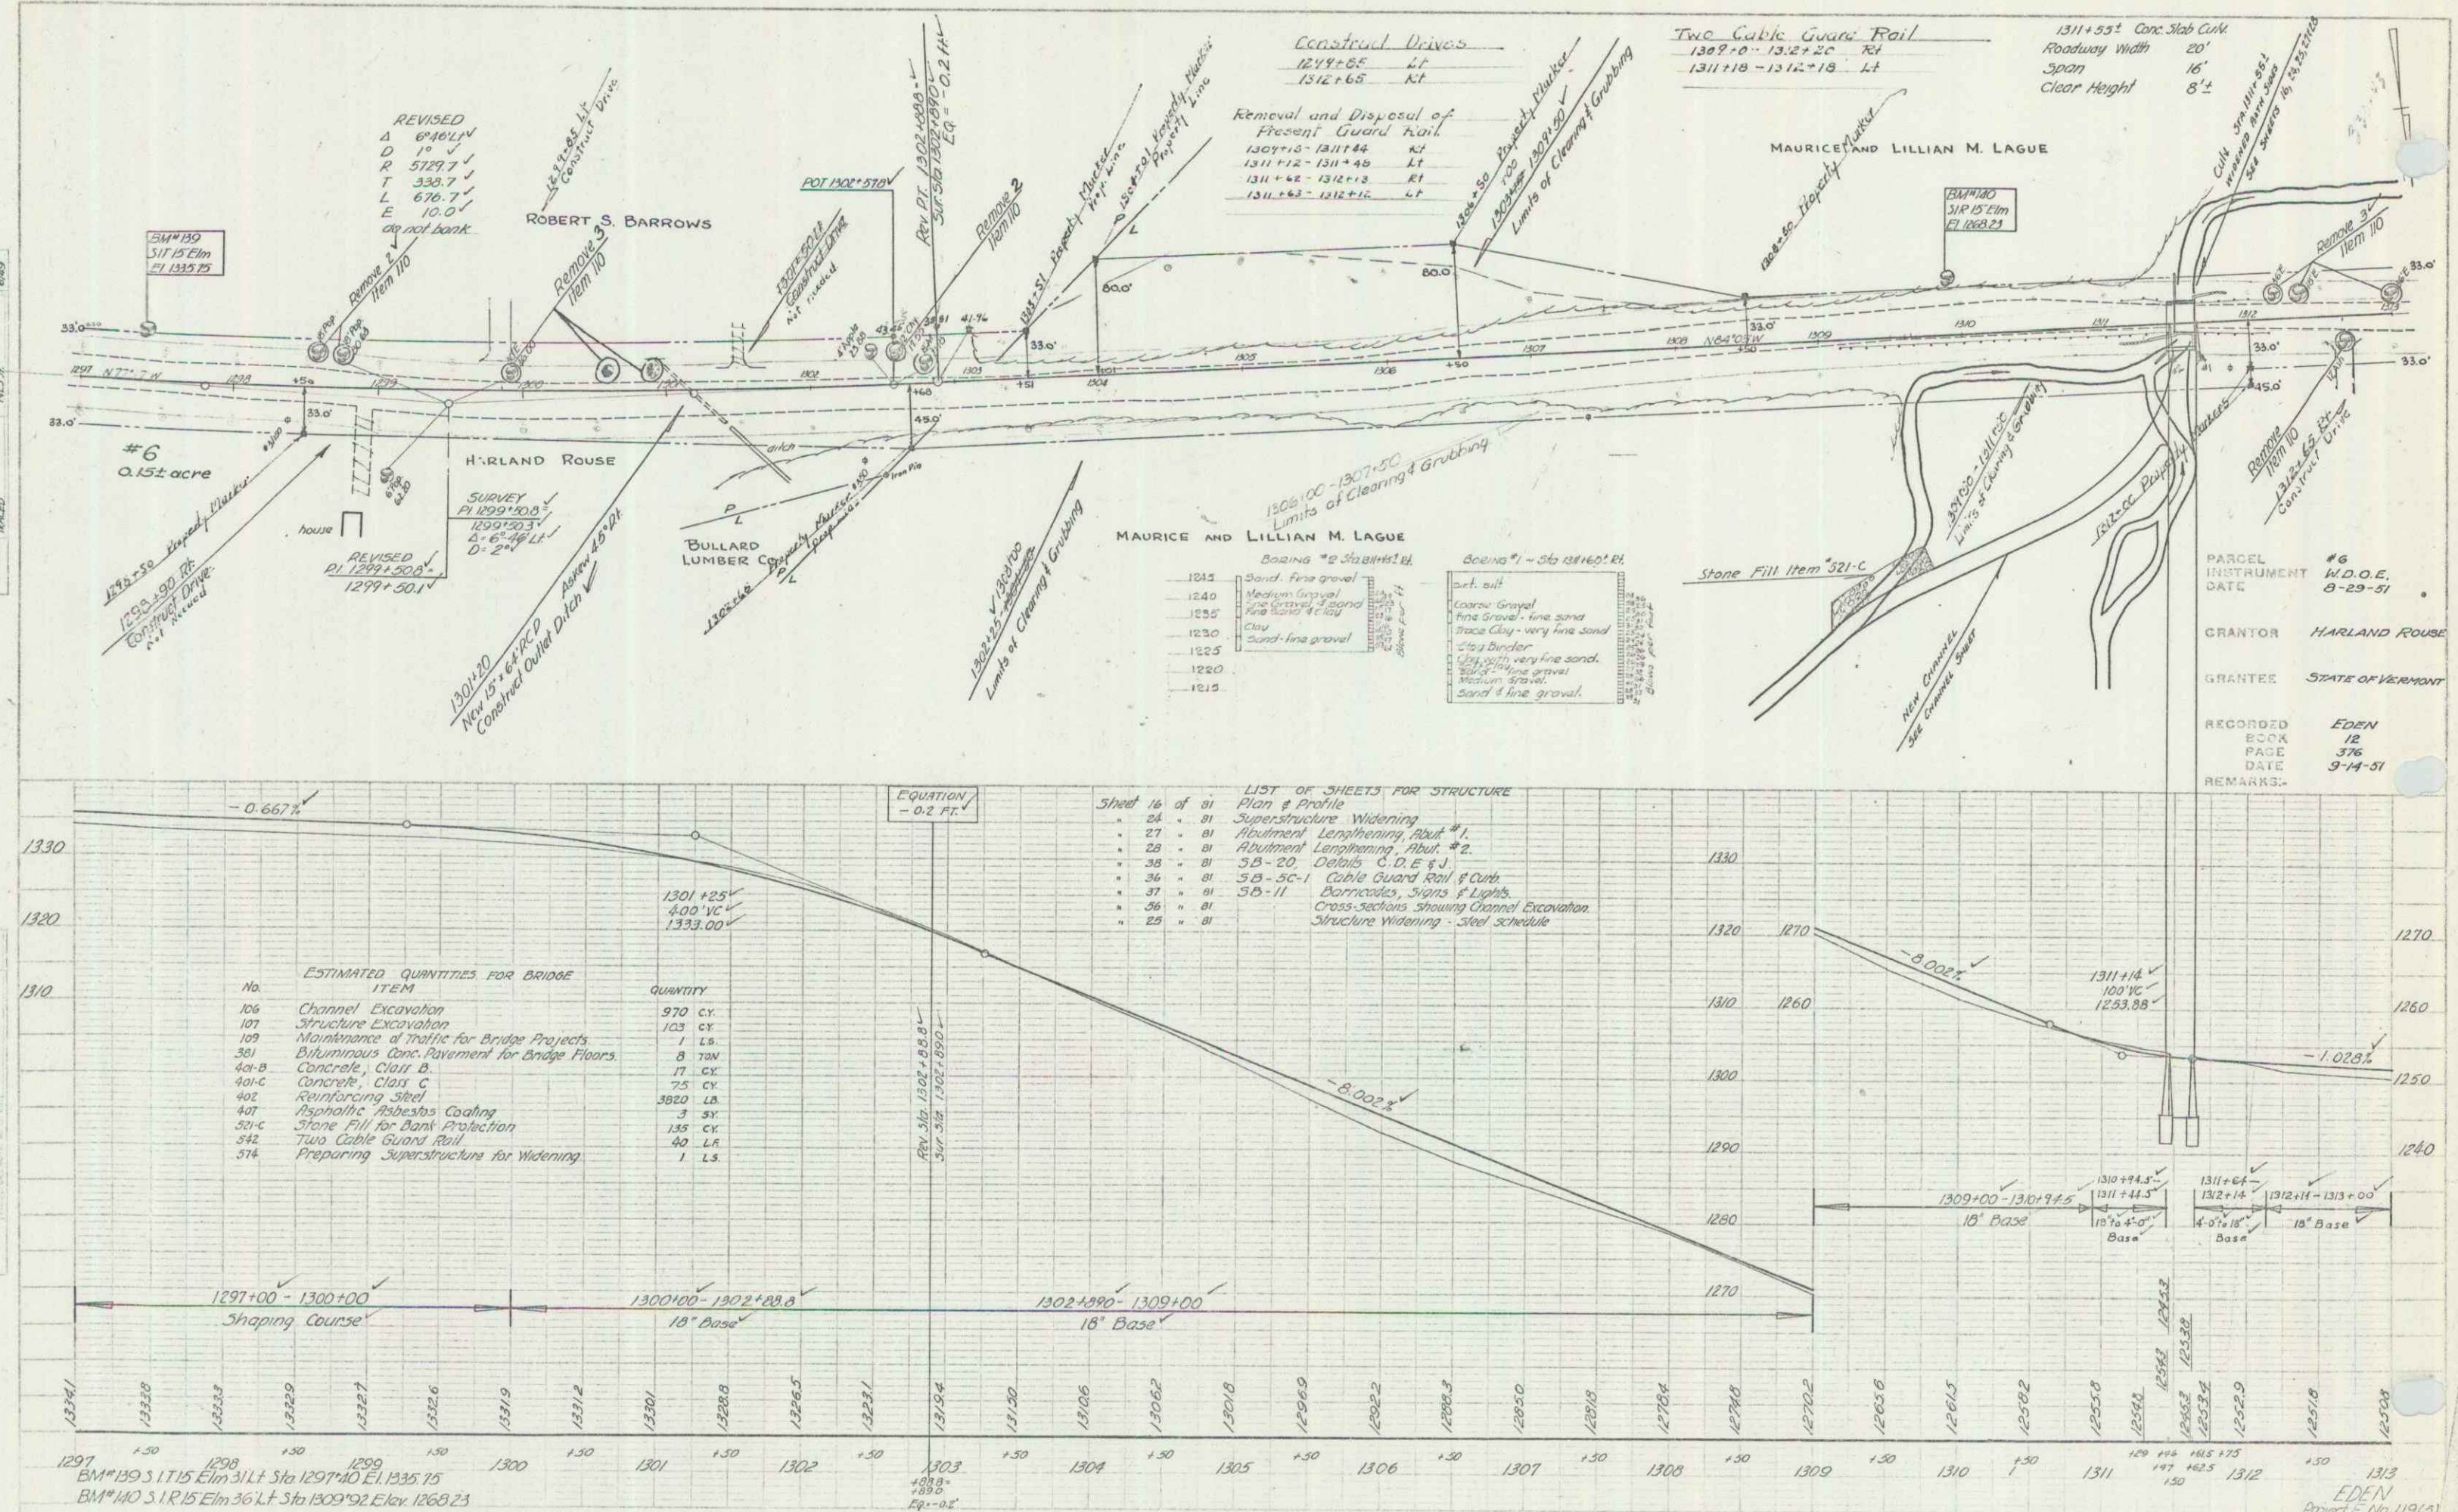


EDEN
Project F No 119(3)
Sheet 16 of 81 Shee

PLAN
 174
 175
 176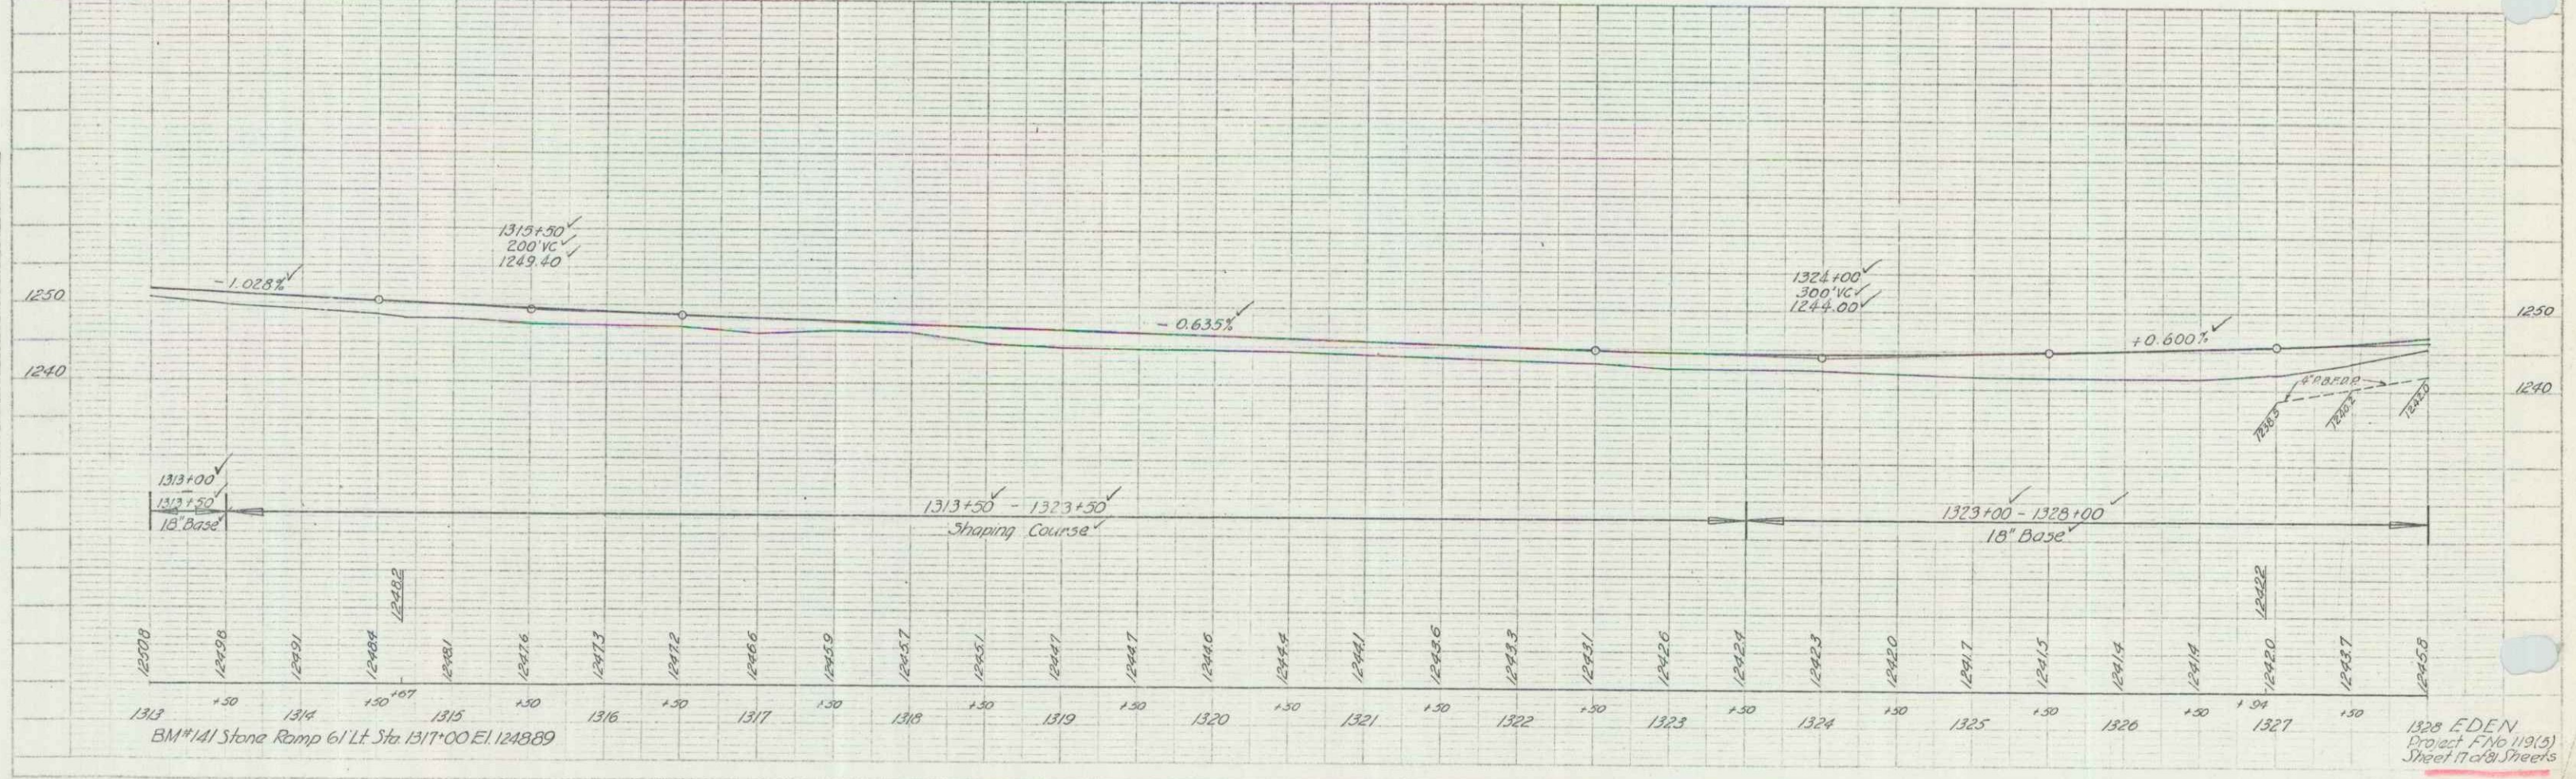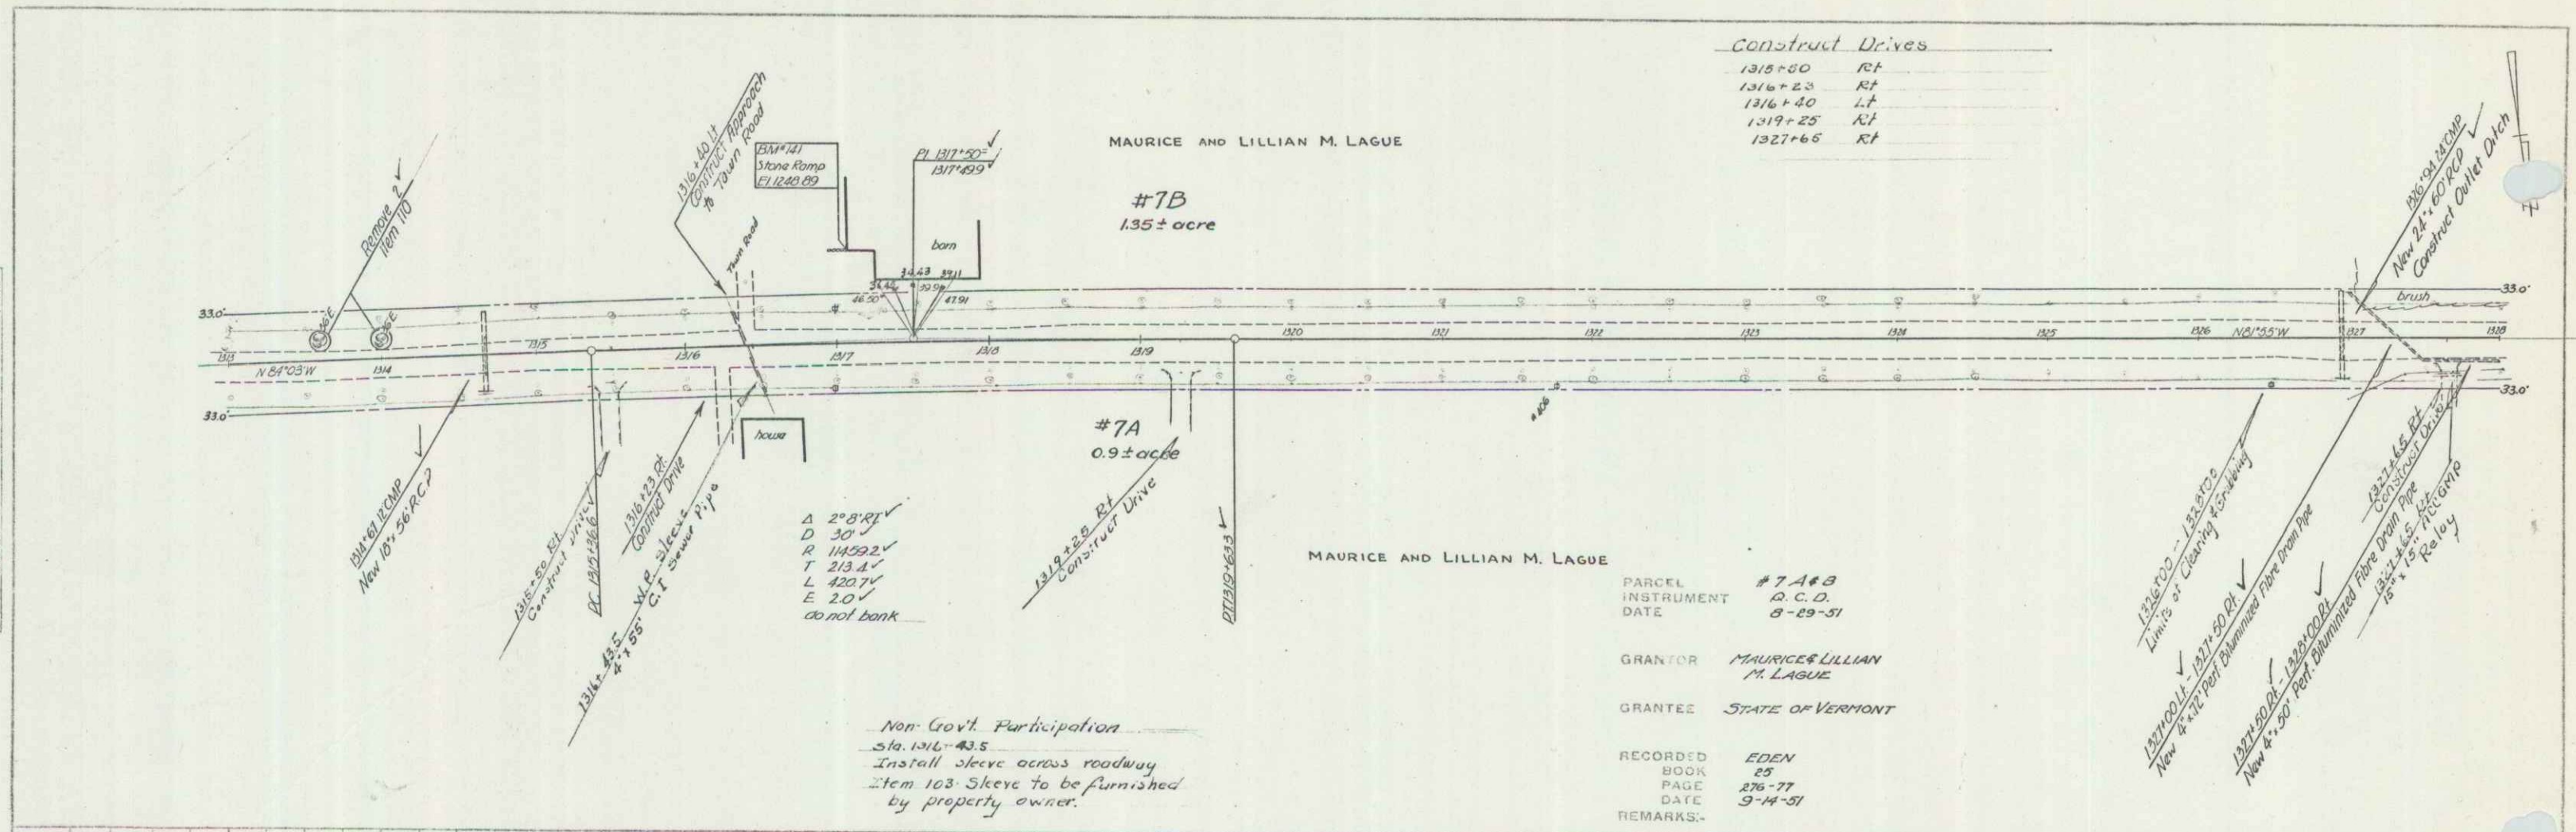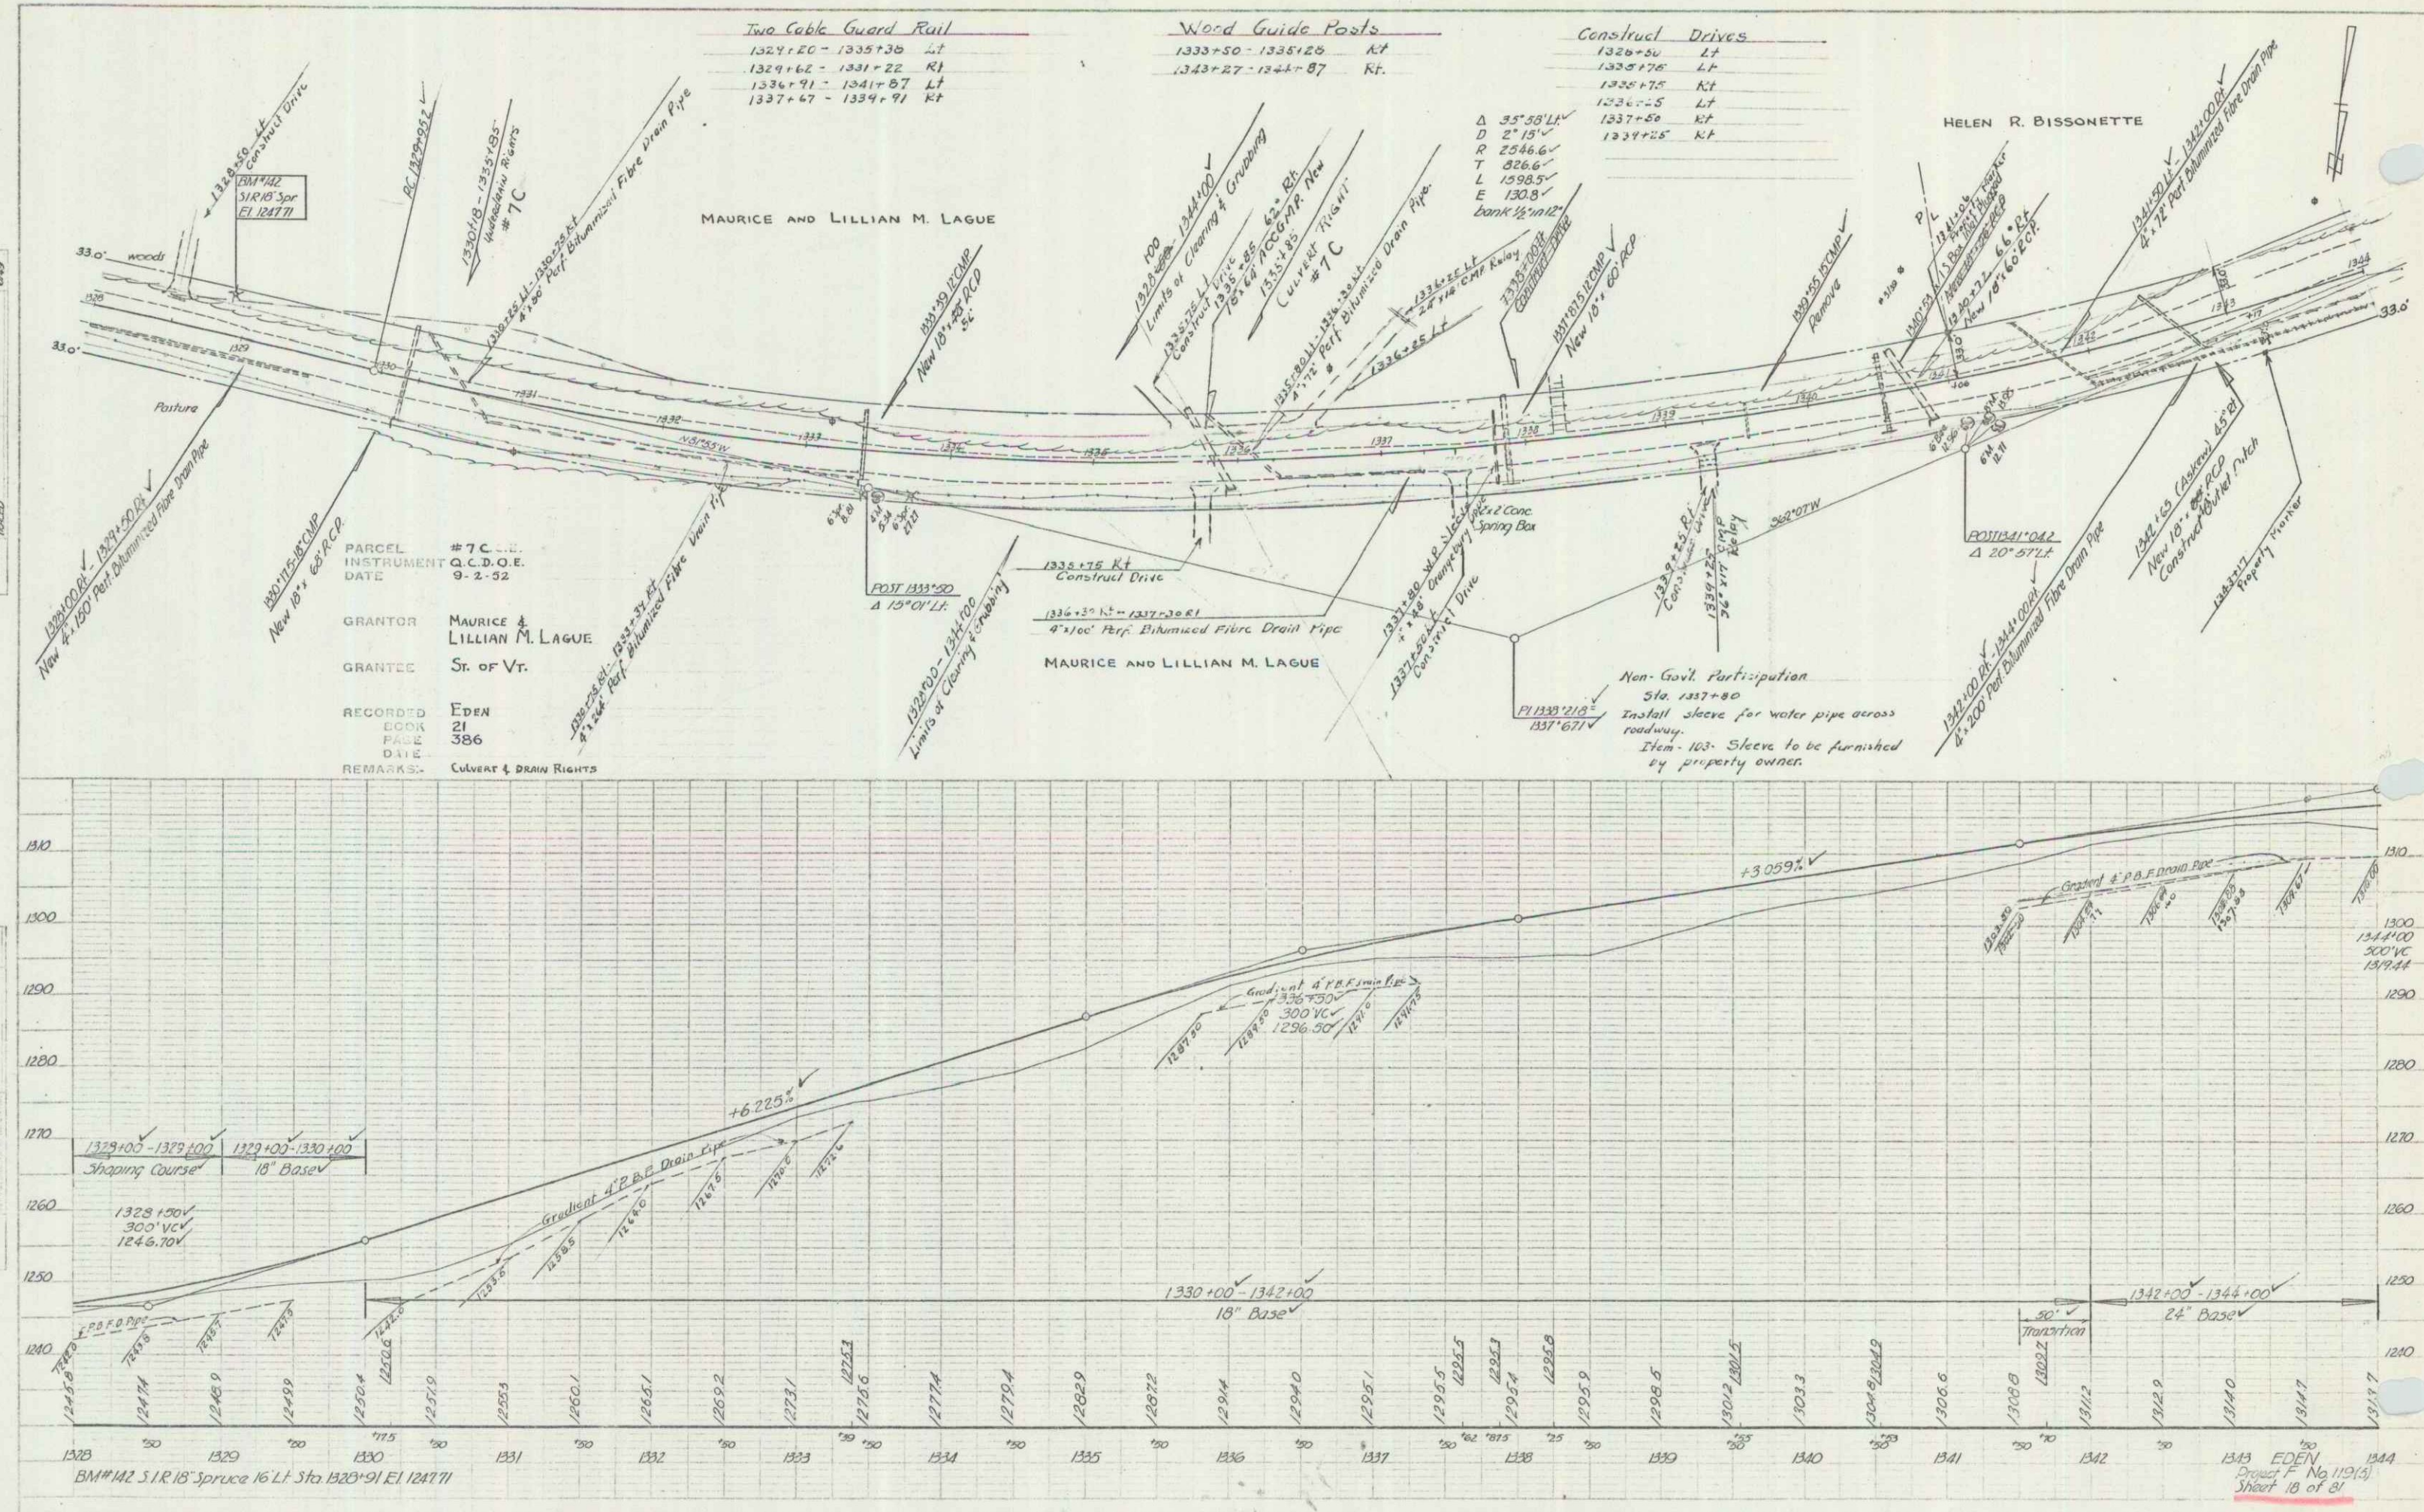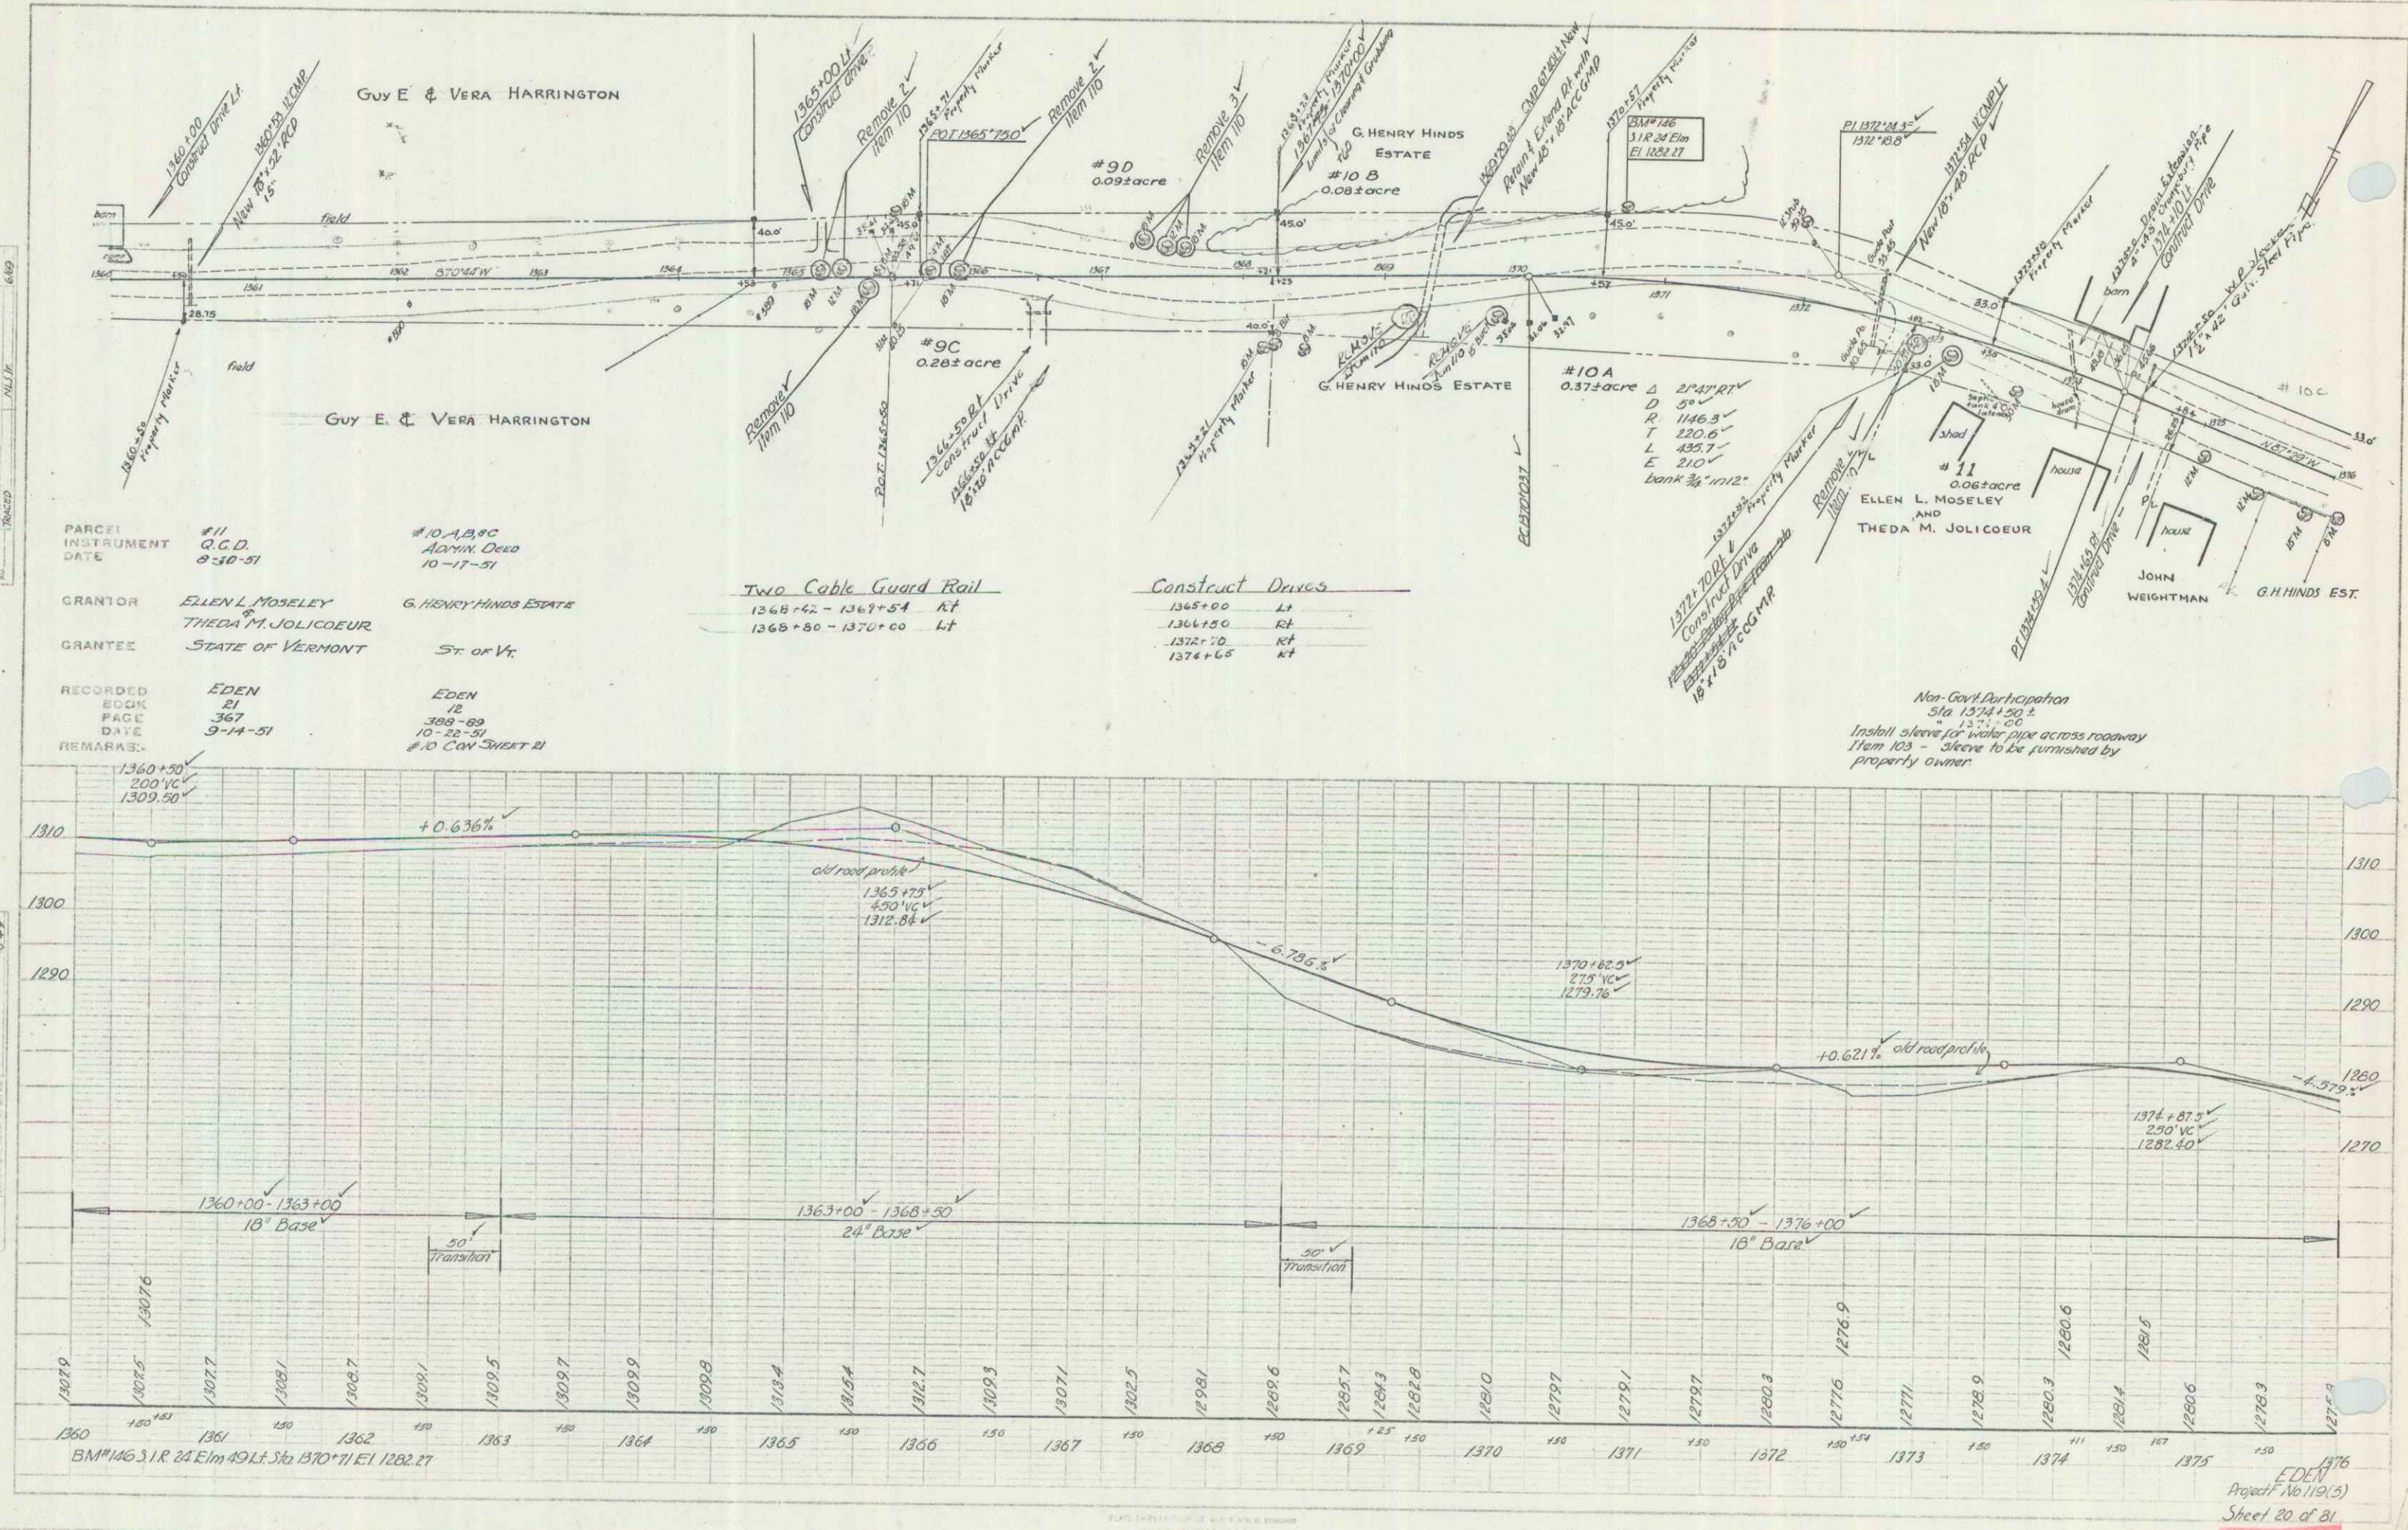
PLAN
 1/2" = 100'
 1/4" = 50'
 1/8" = 25'
 1/16" = 12.5'
 1/32" = 6.25'
 1/64" = 3.125'
 1/128" = 1.5625'
 1/256" = 0.78125'
 1/512" = 0.390625'
 1/1024" = 0.1953125'
 1/2048" = 0.09765625'
 1/4096" = 0.048828125'
 1/8192" = 0.0244140625'
 1/16384" = 0.01220703125'
 1/32768" = 0.006103515625'
 1/65536" = 0.0030517578125'
 1/131072" = 0.00152587890625'
 1/262144" = 0.000762939453125'
 1/524288" = 0.0003814697265625'
 1/1048576" = 0.00019073486328125'
 1/2097152" = 9.5367431640625e-05
 1/4194304" = 4.76837158203125e-05
 1/8388608" = 2.384185791015625e-05
 1/16777216" = 1.1920928955078125e-05
 1/33554432" = 5.9604644775390625e-06
 1/67108864" = 2.98023223876953125e-06
 1/134217728" = 1.490116119384765625e-06
 1/268435456" = 7.450580596923828125e-07
 1/536870912" = 3.7252902984619140625e-07
 1/1073741824" = 1.86264514923095703125e-07
 1/2147483648" = 9.31322574615478515625e-08
 1/4294967296" = 4.656612873077392578125e-08
 1/8589934592" = 2.3283064365386962890625e-08
 1/17179869184" = 1.16415321826934814453125e-08
 1/34359738368" = 5.82076609134674072265625e-09
 1/68719476736" = 2.910383045673370361328125e-09
 1/137438953472" = 1.4551915228366851806640625e-09
 1/274877906944" = 7.2759576141834259033203125e-10
 1/549755813888" = 3.63797880709171295166015625e-10
 1/1099511627776" = 1.818989403545856475830078125e-10
 1/2199023255552" = 9.094947017729282379150390625e-11
 1/4398046511104" = 4.5474735088646411895751953125e-11
 1/8796093022208" = 2.27373675443232059478759765625e-11
 1/17592186044416" = 1.136868377216160297393798828125e-11
 1/35184372088832" = 5.684341886080801486968994140625e-12
 1/70368744177664" = 2.8421709430404007434844970703125e-12
 1/140737488355328" = 1.42108547152020037174224853515625e-12
 1/281474976710656" = 7.10542735760100185871124267578125e-13
 1/562949953421312" = 3.552713678800500929355621337890625e-13
 1/1125899906842624" = 1.7763568394002504646778106689453125e-13
 1/2251799813685248" = 8.8817841970012523233890533447265625e-14
 1/4503599627370496" = 4.44089209850062616169452667236328125e-14
 1/9007199254740992" = 2.220446049250313080847263336181640625e-14
 1/18014398509481984" = 1.1102230246251565404236316680908203125e-14
 1/36028797018963968" = 5.5511151231257827021181583340541015625e-15
 1/72057594037927936" = 2.77555756156289135105907916702705078125e-15
 1/144115188075855872" = 1.387778780781445675529539583513525390625e-15
 1/288230376151711744" = 6.938893903907228377647697917567626953125e-16
 1/576460752303423488" = 3.4694469519536141888238489587838134765625e-16
 1/1152921504606846976" = 1.73472347597680709441192447939190673828125e-16
 1/2305843009213693952" = 8.67361737988403547205962239695953369140625e-17
 1/4611686018427387904" = 4.336808689942017736029811198479766845703125e-17
 1/9223372036854775808" = 2.1684043449710088680149055992398834228515625e-17
 1/18446744073709551616" = 1.08420217248550443400745279961994171142578125e-17
 1/36893488147419103232" = 5.42101086242752217003726399809970855712890625e-18
 1/73786976294838206464" = 2.710505431213761085018631999049854278564453125e-18
 1/147573952589676412928" = 1.3552527156068805425093159995249271392822265625e-18
 1/295147905179352825856" = 6.7762635780344027125465799976246356964111328125e-19
 1/590295810358705651712" = 3.38813178901720135627328999881231784820556640625e-19
 1/1180591620717411303424" = 1.694065894508600678136644999406158924102783203125e-19
 1/2361183241434822606848" = 8.470329472543003390683224997030794620513916015625e-20
 1/4722366482869645213696" = 4.2351647362715016953416124985153973102569580078125e-20
 1/9444732965739290427392" = 2.11758236813575084767080624925769865512847900390625e-20
 1/18889465931478580854784" = 1.058791184067875423835403124628849327564239501953125e-20
 1/37778931862957161709568" = 5.293955920339377119177015623144246637821197509765625e-21
 1/75557863725914323419136" = 2.6469779601696885595885078115721233189105987548828125e-21
 1/151115727451828646838272" = 1.32348898008484427979425390578606165945529937744140625e-21
 1/302231454903657293676544" = 6.61744490042422139897126952893030829727649688720703125e-22
 1/604462909807314587353088" = 3.308722450212110699485634764465154148638248443603515625e-22
 1/1208925819614629174706176" = 1.6543612251060553497428173822325770743191242218017578125e-22
 1/2417851639229258349412352" = 8.2718061255302767487140869111628853715956211094087890625e-23
 1/4835703278458516698824704" = 4.13590306276513837435704345558144268579781055470439453125e-23
 1/9671406556917033397649408" = 2.067951531382569187178521727790721342898905277352197265625e-23
 1/19342813113834066795298816" = 1.0339757656912845935892608638953606714494526386760986328125e-23
 1/38685626227668133590597632" = 5.16987882845642296794630431697680335724726319337804931640625e-24
 1/77371252455336267181195264" = 2.584939414228211483973152158488401678623631596689024658203125e-24
 1/154742504910672534362390528" = 1.2924697071141057419865760792442008393118157983445123291015625e-24
 1/309485009821345068724781056" = 6.4623485355705287099328803962210041965590789917225616455078125e-25
 1/618970019642690137449562112" = 3.23117426778526435496644019811050209827953949586128082275390625e-25
 1/1237940039285380274899124224" = 1.615587133892632177483220099055251049139769747930640411376953125e-25
 1/2475880078570760549798248448" = 8.077935669463160887416100495276255245698848739653202056884765625e-26
 1/4951760157141521099596496896" = 4.0389678347315804437080502476381276228494243698266010284423828125e-26
 1/9903520314283042199192993792" = 2.01948391736579022185402512381906381142471218491330051422119140625e-26
 1/19807040628566084398385987584" = 1.009741958682895110927012561909531905712356092456650257110595703125e-26
 1/39614081257132168796771975168" = 5.048709793414475554635062809547659528561780462283251285552978515625e-27
 1/79228162514264337593543950336" = 2.5243548967072377773175314047738297642808902311416256427764892578125e-27
 1/158456325028528675187087900672" = 1.26217744835361888865876570238691488214044511557081253138824462890625e-27
 1/316912650057057350374175801344" = 6.31088724176809444329382851193457441070222557785406265694122314453125e-28
 1/633825300114114700748351602688" = 3.155443620884047221646914255967287205351112788927031328470611572265625e-28
 1/1267650600228229401496703205376" = 1.5777218104420236108234571279836436026755563944635156642353057861328125e-28
 1/2535301200456458802993406410752" = 7.8886090522101180541172856399182180133777819723175783211765289306640625e-29
 1/5070602400912917605986812821504" = 3.94430452610505902705864281995910900668889098615878916058826446533203125e-29
 1/10141204801825835211973625643008" = 1.972152263052529513529321409979554503344445493079394580294132232666015625e-29
 1/20282409603651670423947251286016" = 9.86076131526264756764660704989777251672222746539697290147066116333203125e-30
 1/40564819207303340847894502572032" = 4.930380657631323783823303524948886258361113732698486450735330581666015625e-30
 1/81129638414606681695789005144064" = 2.4651903288156618919116517624744431291805568663492432253676652908330078125e-30
 1/162259276829213363391578010288128" = 1.23259516440783094595582588123722156459027843317462161268383264541650390625e-30
 1/324518553658426726783156020576256" = 6.16297582203915472977912790618610782295139216587310806341916322708250000000e-31
 1/649037107316853453566312041152512" = 3.08148791101957736488956395309305391147569608293655403170958161354125000000e-31
 1/1298074214633706907132624082305024" = 1.54074395550978868244478197654652695573784804146827701585479080677062500000e-31
 1/2596148429267413814265248164610048" = 7.7037197775489434122239098827326347786892402073413850792739540338531250000e-31
 1/5192296858534827628530496329220096" = 3.85185988877447170611195494136631738934462010367069253963697701692656250000e-31
 1/10384593717069655257060992658440192" = 1.92592994438723585305597747068315869467231005183534626981848850846328125000e-31
 1/20769187434139310514121985316880384" = 9.62964972193617926527988735341579347336155025917673134909244254231640625000e-31
 1/41538374868278621028243970633760768" = 4.814824860968089632639943676707896736680775129588365674546221271158203125000e-31
 1/83076749736557242056487941267521536" = 2.4074124304840448163199718383539483683403875647941828372731106355791015625000e-31
 1/166153499473114484112975882535043072" = 1.20370621524202240815998591917697418417019378239709141863655531778955078125000e-31
 1/332306998946228968225951765070086144" = 6.01853107621011204079992959588487092085096891198545709318277658894775000000e-31
 1/664613997892457936451903530140172288" = 3.00926553810505602039996479794243546042548445599272854659138829447387500000e-31
 1/1329227995784915872903807060280344576" = 1.50463276905252801019998239897121773021274222799636427329569414723693750000e-31
 1/2658455991569831745807614120560689152" = 7.52316384526264005099991199485608865106371113998182136647847073618468750000e-31
 1/5316911983139663491615228241121378304" = 3.76158192263132002549995599742804432553185556999091068323923536809234375000e-31
 1/10633823966279326983230456482242756608" = 1.880790961315660012749977998714022162765927784995455341619617684046171875000e-31
 1/21267647932558653966460912964485513216" = 9.403954806578300063749889993570110813829638924977276708098088420230859375000e-31
 1/42535295865117307932921825928971026432" = 4.7019774032891500318749449967850554069148194624886383540490442101154296875000e-31
 1/85070591730234615865843651857942052864" = 2.35098870164457501593747249839252770345740973124431917702452210505771484375000e-31
 1/170141183460469231731687303715884105728" = 1.175494350822287507968736249196263851728704865622159588512261052528857421875000e-31
 1/340282366920938463463374607431768211456" = 5.877471754111437539843681245981319258643524328110797942561305262644287109375000e-31
 1/680564733841876926926749214863536422912" = 2.9387358770557187699218406229906596293217621640553989712806526313221435546875000e-31
 1/1361129467683753853853498429727072845824" = 1.46936793852785938496092031149532981466088108202769948564032631566107177734375000e-31
 1/2722258935367507707706996859454145691648" = 7.346839692639296924804601557476649073304405410138499728201631578305358888671875000e-31
 1/5444517870735015415413993718908291383296" = 3.6734198463196484624023007787383245366522027050692498641008157891526794443359375000e-31
 1/10889035741470030830827987437816582766592" = 1.83670992315982423120115038936916226832610135253462493205040789457633972216796875000e-31
 1/21778071482940061661655974875633165533184" = 9.18354961579912115600575194684581134163050676267312466025203947288169861083984375000e-31
 1/43556142965880123323311949751266331066368" = 4.591774807899560578002875973422905670815253381336562330126019736440849305419921875000e-31
 1/87112285931760246646623899502532662132736" = 2.2958874039497802890014379867114528354076266906682811650630098682204246527099609375000e-31
 1/174224571863520493293247799005065324265472" = 1.14794370197489014450071899335572641770381334533414058253150493411021232635498046875000e-31
 1/348449143727040986586495598010130648530944" = 5.73971850987445072250035949677863208851906672667070291265752467055106163177494034375000e-31
 1/696898287454081973172991196020261297061888" = 2.869859254937225361250179748389316044259533363335351456328762335275530815887470171875000e-31
 1/1393796574908163946345982392040522594123776" = 1.4349296274686126806250898741946580221297666816676757281643811676377654079437350859375000e-31
 1/2787593149816327892691964784081045188247552" = 7.1746481373430634031250493709732901106488333683378786408219058381888272397196750859375000e-31
 1/5575186299632655785383929568162090376495104" = 3.58732406867153170156252468548664505532441668416893932041095291909441361985983754296875000e-31
 1/11150372599265311570767859136324180752990208" = 1.793662034335765850781262342743322527662208342084469660205476459547206809929918771484375000e-31
 1/22300745198530623141535718272648361505980416" = 8.968260171678829253906311701173262638311041710422348260821877297736027239649593859375000e-

PARCEL	INSTRUMENT DATE	GRANTOR	GRANTEE	BOOK	RECORDED	DATE	REMARKS
#16	W.D.O.E. 8-29-51	G.E. & D.S. McALLISTER	ST. OF VT.	12	EDEN 31-12	9-14-51	
#17	W.D.O.E. 8-29-51	HARRY A. RHODES	ST. OF VT.	12	EDEN 31-12	9-14-51	
#18	W.D.O.E. 8-29-51	HARRY A. RHODES	ST. OF VT.	12	EDEN 31-12	9-14-51	
#19	W.D.O.E. 8-29-51	A.F. & L.E. LOCKE	ST. OF VT.	12	EDEN 31-12	9-14-51	
#20	W.D.O.E. 8-29-51	SIDNEY C. BROWN	ST. OF VT.	12	EDEN 31-12	9-14-51	
#21	W.D.O.E. 8-29-51	CONEST C. VAILLIE & BENWARE	ST. OF VT.	12	EDEN 31-12	9-14-51	
#22	W.D.O.E. 8-29-51	DAN B. SMITH & MARY ZANE MILES	ST. OF VT.	12	EDEN 31-12	9-14-51	
#23	W.D.O.E. 8-29-51	J. ALFRED & BLANCHE CHOUINARD	ST. OF VT.	12	EDEN 31-12	9-14-51	
#24	W.D.O.E. 8-29-51	OLIVER F. & EMILY M. DIETTE	ST. OF VT.	12	EDEN 31-12	9-14-51	
#25	W.D.O.E. 8-29-51	ETHEL WHITTEMORE	ST. OF VT.	12	EDEN 31-12	9-14-51	
#26	W.D.O.E. 8-29-51	E.E. & LOUISE F. GOODWIN	ST. OF VT.	12	EDEN 31-12	9-14-51	
#27	W.D.O.E. 8-29-51	OLIN & MARION BROWN	ST. OF VT.	12	EDEN 31-12	9-14-51	
#28	W.D.O.E. 8-29-51	VERCIL & BARBARA WARNER	ST. OF VT.	12	EDEN 31-12	9-14-51	
#29	W.D.O.E. 8-29-51	VERCIL & BARBARA WARNER	ST. OF VT.	12	EDEN 31-12	9-14-51	

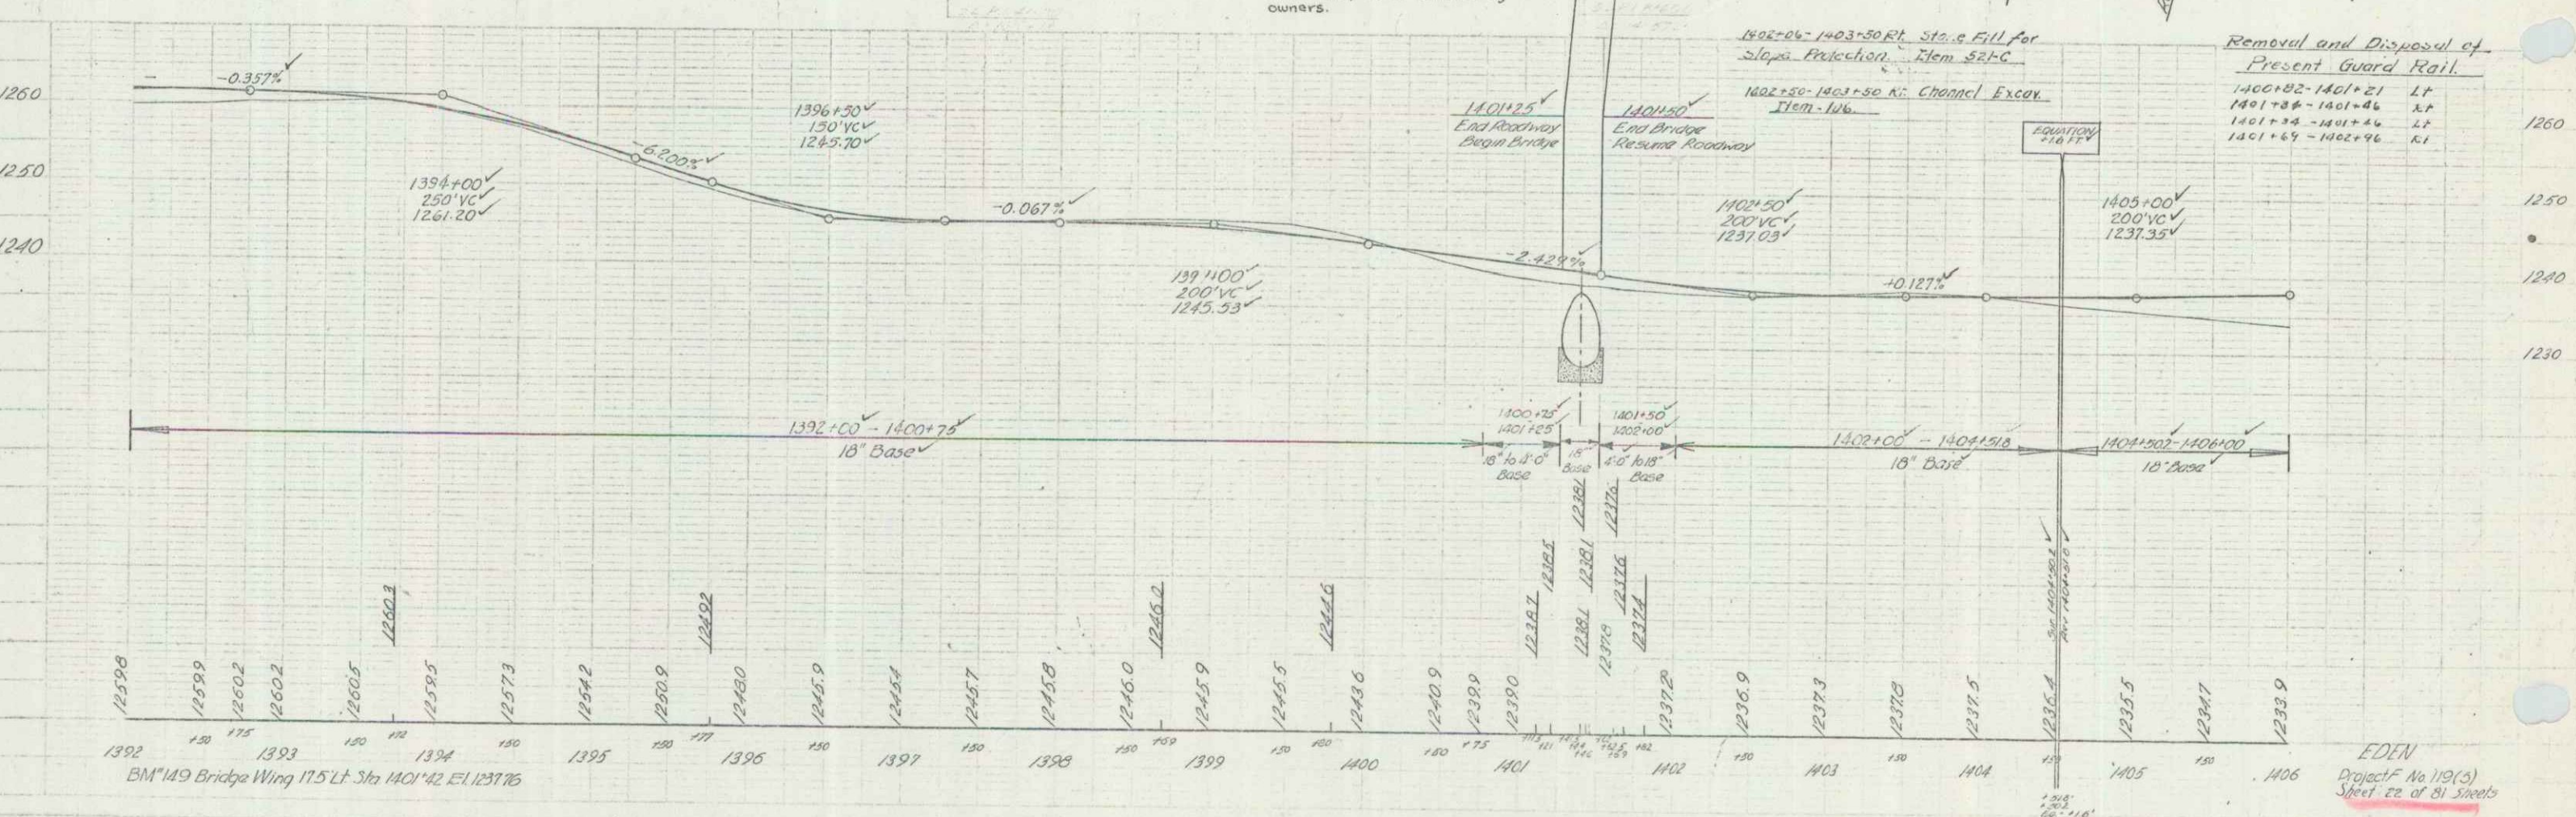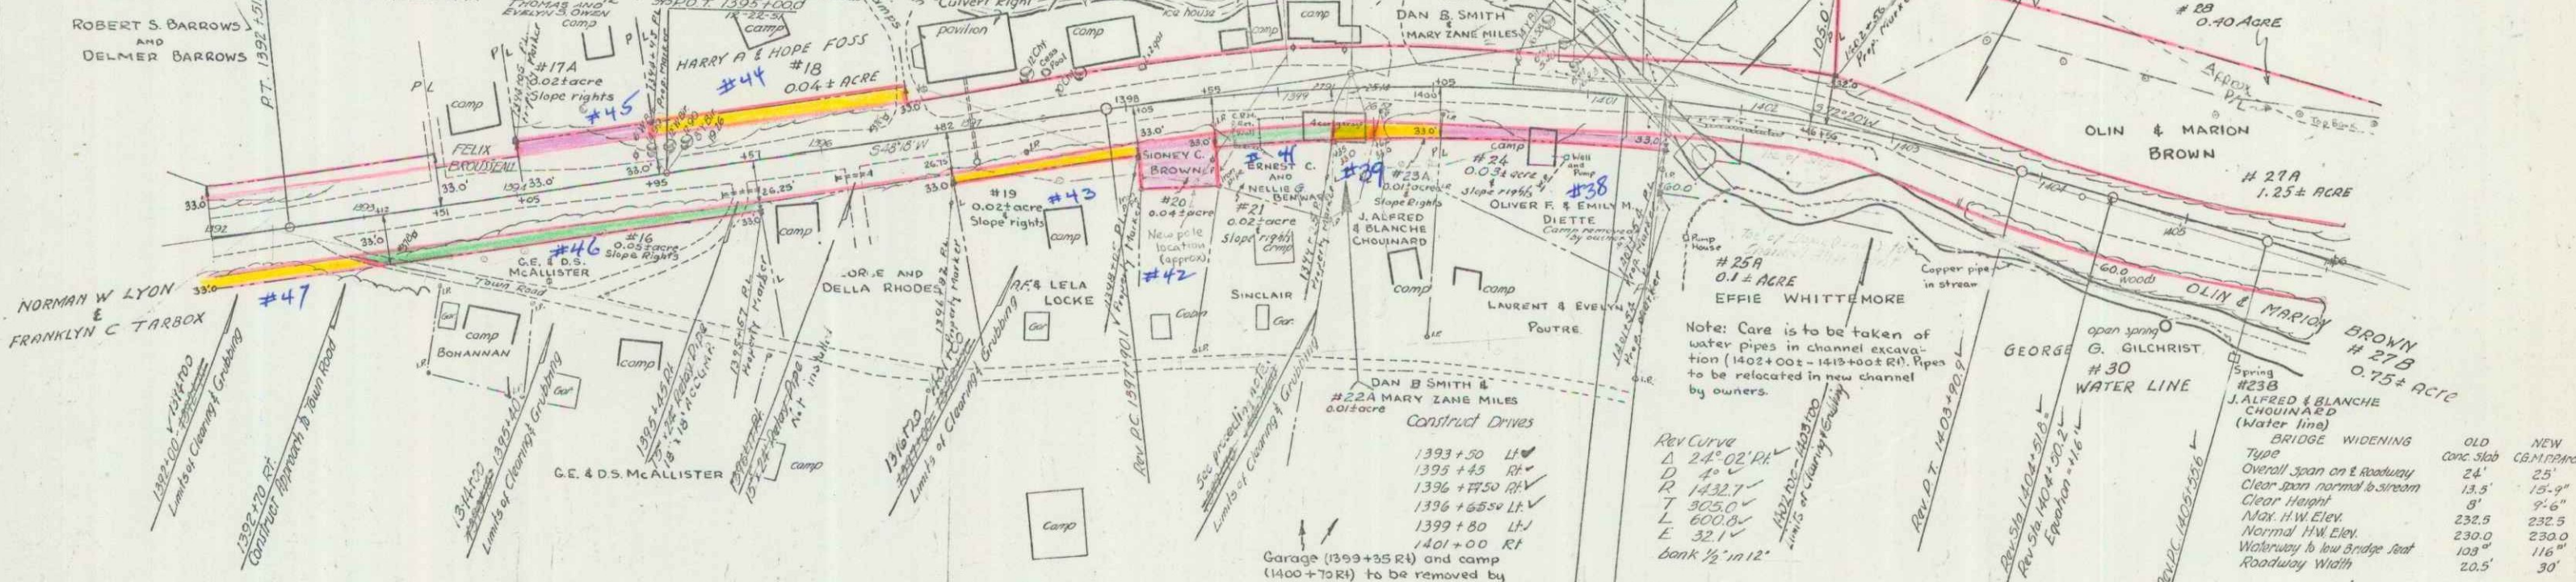

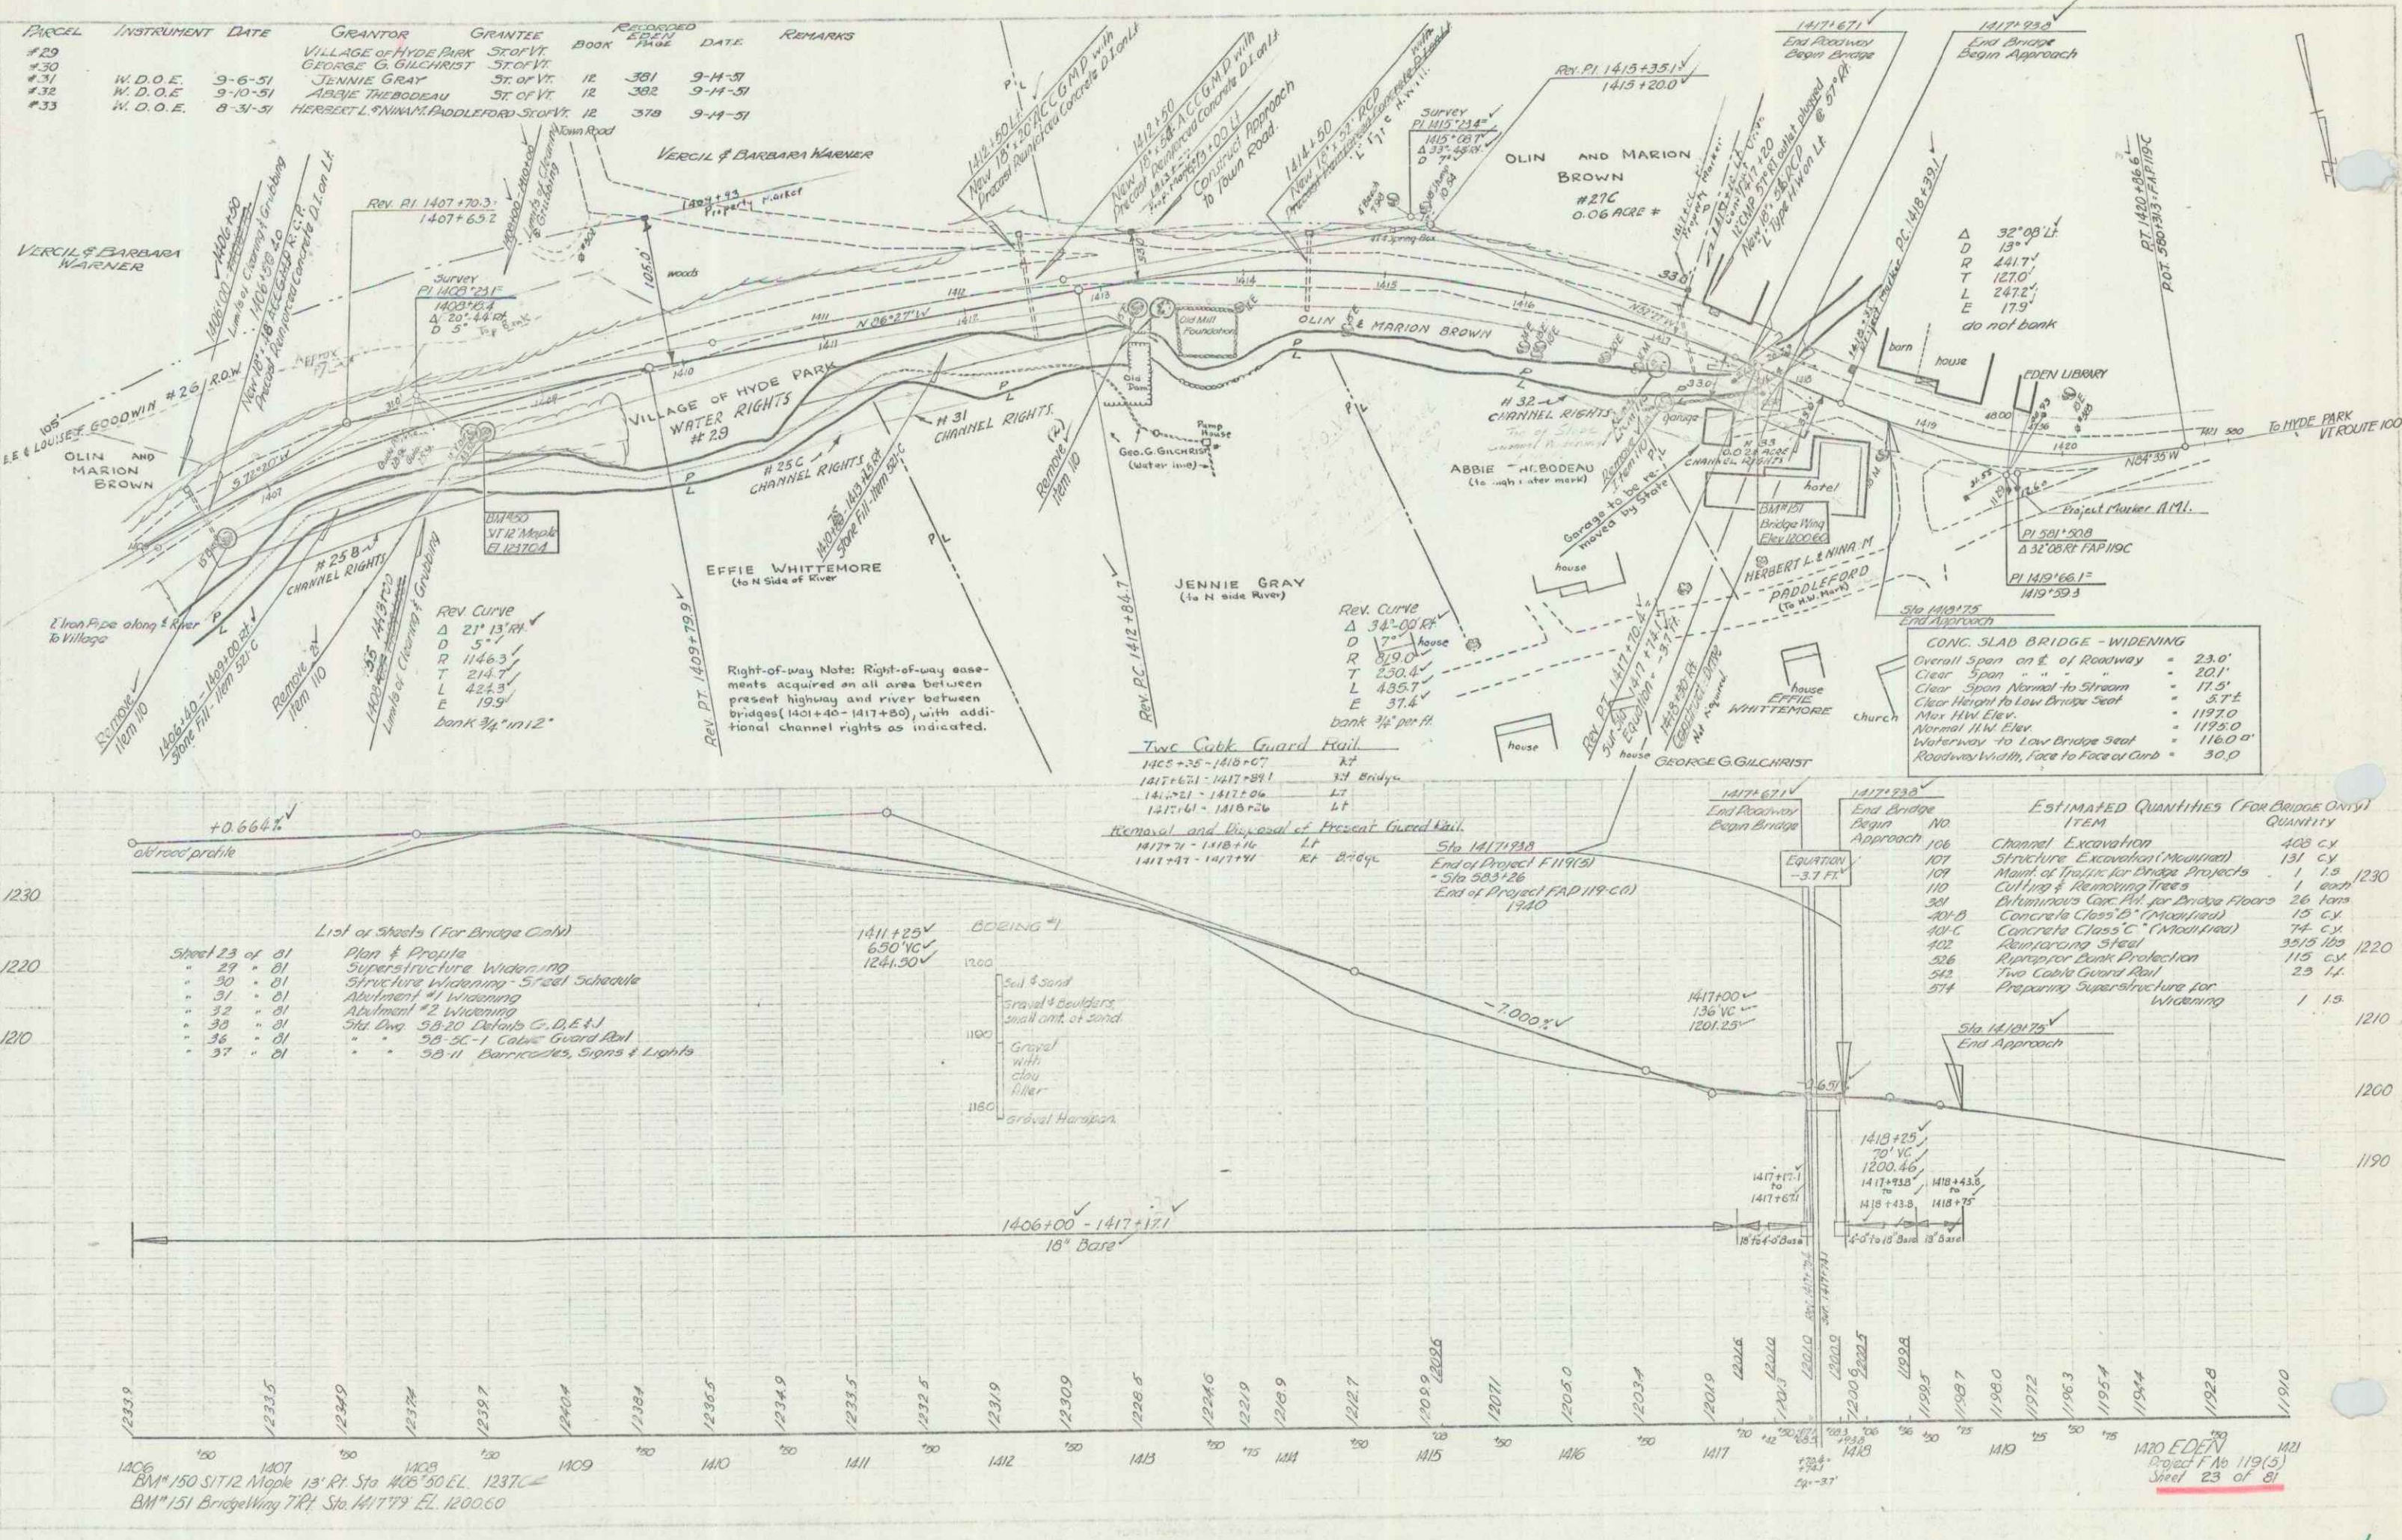

PARCEL	INSTRUMENT DATE	GRANTOR	GRANTEE	BOOK	PAGE	DATE	REMARKS
#29		VILLAGE OF HYDE PARK	ST OF VT				
#30		GEORGE G. GILCHRIST	ST OF VT				
#31	W.D.O.E. 9-6-51	JENNIE GRAY	ST OF VT	12	381	9-14-51	
#32	W.D.O.E. 9-10-51	ABBEY THEODORE	ST OF VT	12	382	9-14-51	
#33	W.D.O.E. 8-31-51	HERBERT L. WILKINSON	ST OF VT	12	378	9-14-51	

CONC. SLAB BRIDGE - WIDENING	
Overall Span on E. of Roadway	23.0'
Clear Span	20.1'
Clear Span Normal to Stream	17.5'
Clear Height to Low Bridge Seat	3.7'
Max. Hgt. Elev.	1197.0
Normal Hgt. Elev.	1195.0
Waterway to Low Bridge Seat	116.0'
Roadway Width, Face to Face of Curb	30.0'

ESTIMATED QUANTITIES (FOR BRIDGE ONLY)	
ITEM	QUANTITY
Channel Excavation	400 CY
Structure Excavation (Medium)	131 CY
Main of Traffic for Bridge Projects	1 1/2
Cutting & Retaining Walls	1 1/2
Dimensional Conc. for Bridge Floors	26 tons
Concrete Class D (Modified)	15 CY
Concrete Class C (Modified)	74 CY
Reinforcing Steel	35.5 lbs
Two Cable Guard Rail	115 CY
Preparing Superstructure for Widening	1 1/2

- List of Sheets (For Bridge Only)
- Sheet 23 of 31 Plan & Profile
 - Sheet 30 of 31 Superstructure Widening
 - Sheet 31 of 31 Structure Widening - Steel Schedule
 - Sheet 32 of 31 Abutment #2 Widening
 - Sheet 33 of 31 Abutment #2 Details C.D.E.T.
 - Sheet 34 of 31 S.B. 50-1 Cable Guard Rail
 - Sheet 35 of 31 S.B. 11 Barricades, Signs & Lights

1406+00 - 1417+171
18" Bare

1406+00
1407
1408
1409
1406+00
1407
1408
1409
1406+00
1407
1408
1409
1500