



CONSTRUCT DRAWS	
1	35
1225	199
1227	31

FED. ROAD DIST. NO.	STATE	FISCAL YEAR	SHEET NO.	TOTAL SHEETS
3	Vt.	29	9	89

POST WAR F A PRIMARY

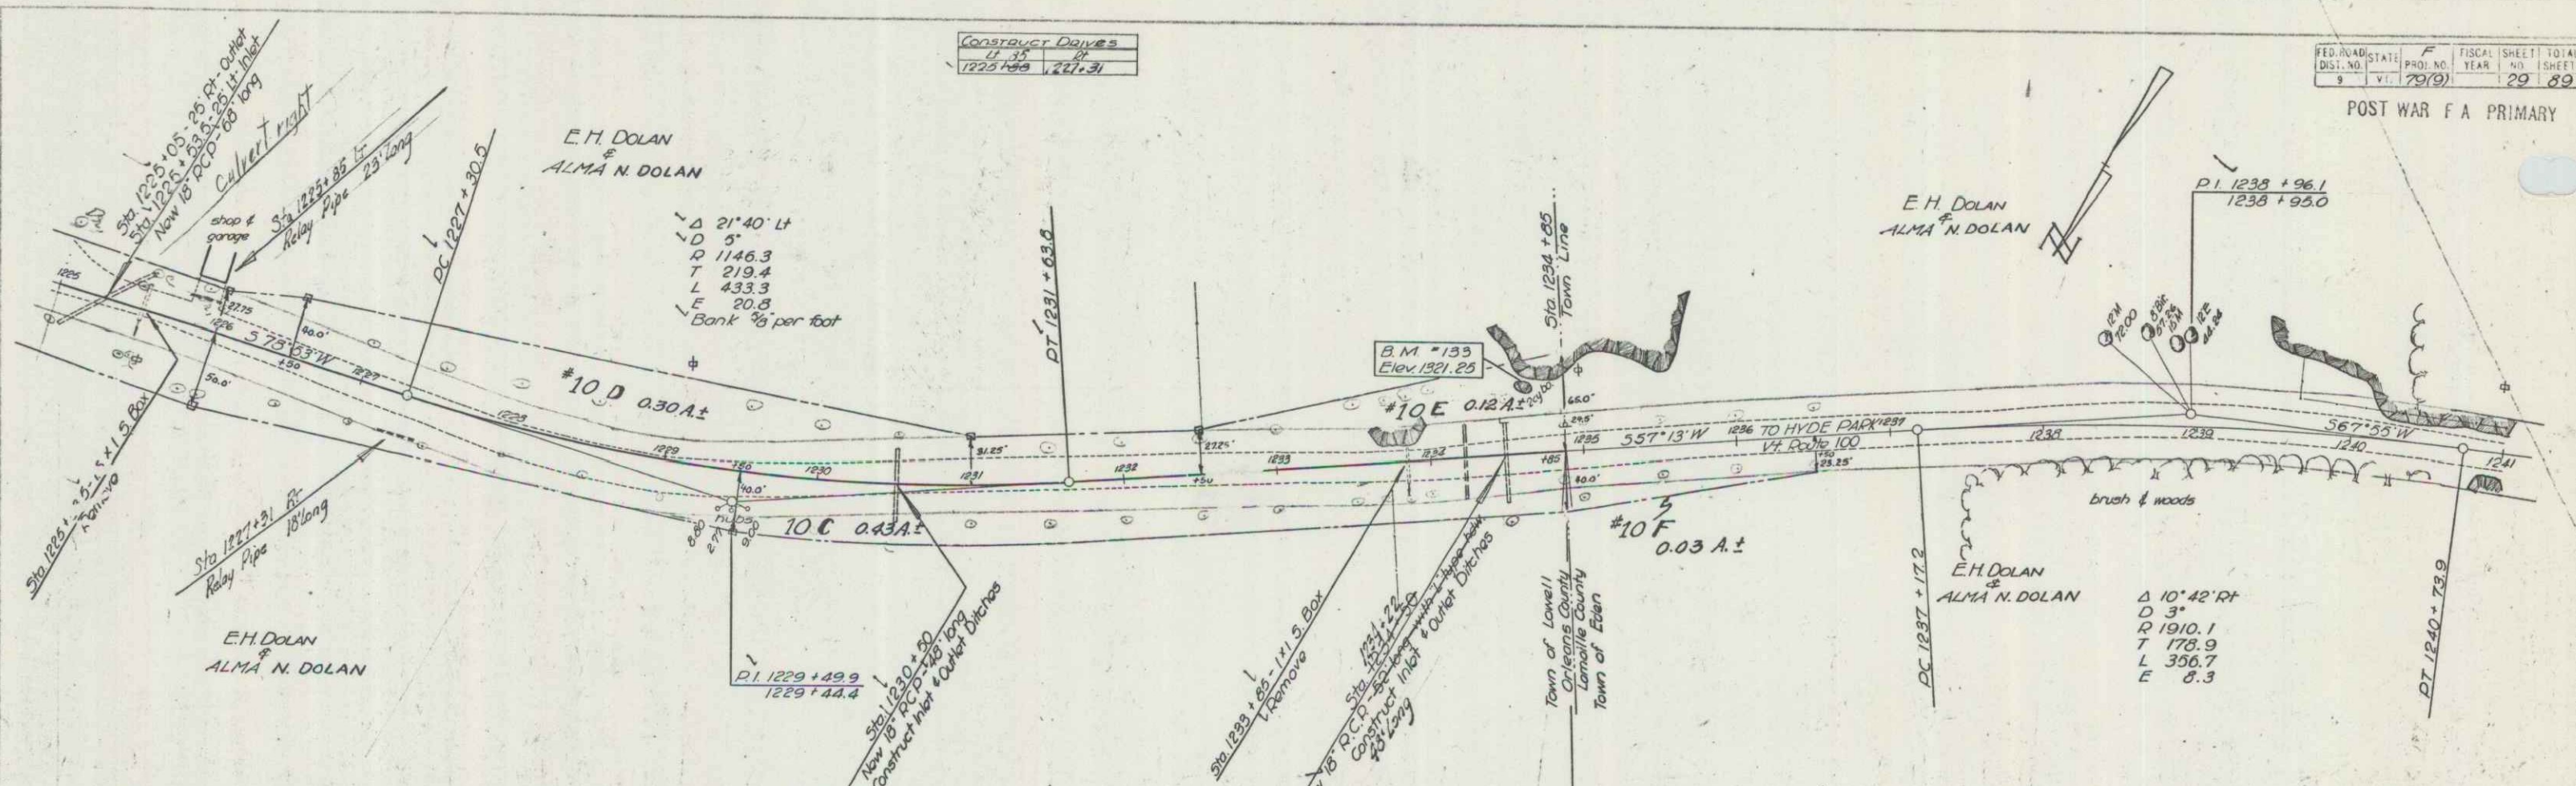

PARCEL	INSTRUMENT	DATE	GRANTOR	GRANTEE	RECORDED EDEN	REMARKS
10 F	W. D. O. E.	12-30-48	E. H. & ALMA DOLAN	STOFTVT.	BOOK 25 PAGE 177	DATE 1-4-49

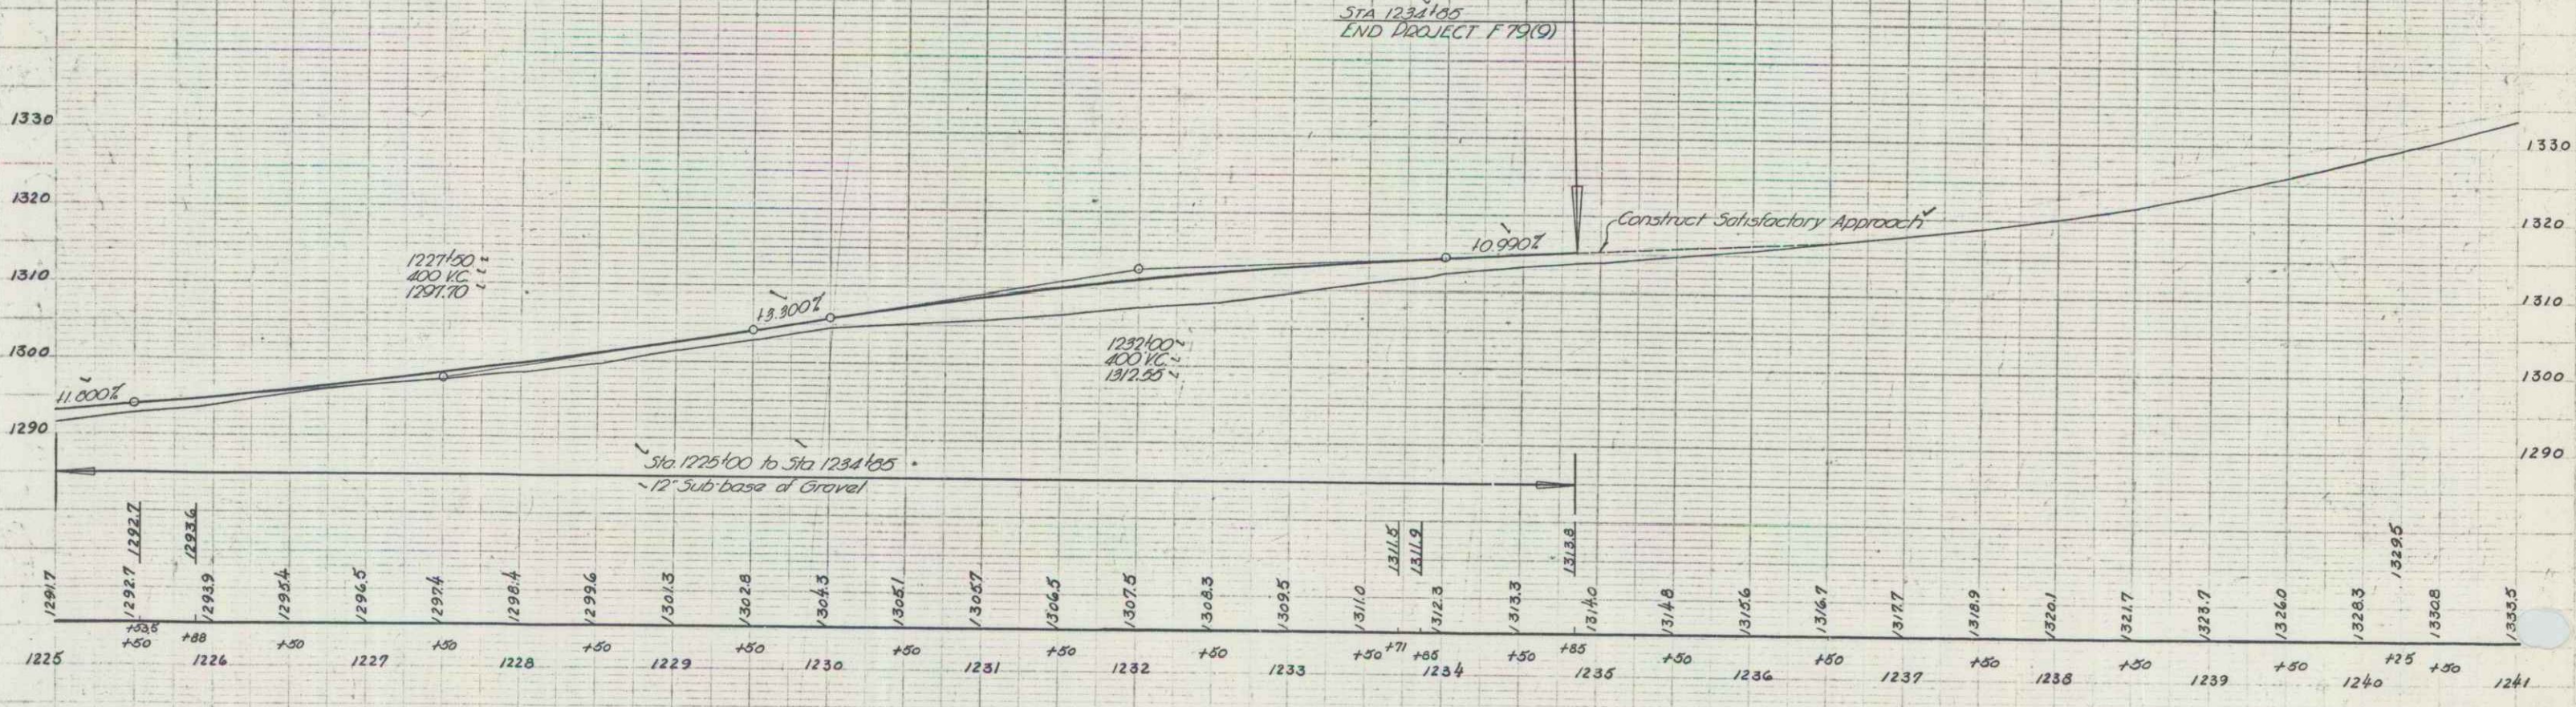

BM #133 Spot on 2cy boulder 40' lt sta 1234+60 Elev 1321.25

LOWELL Series F No 79(9) Sheet 29 of 29 sheets