
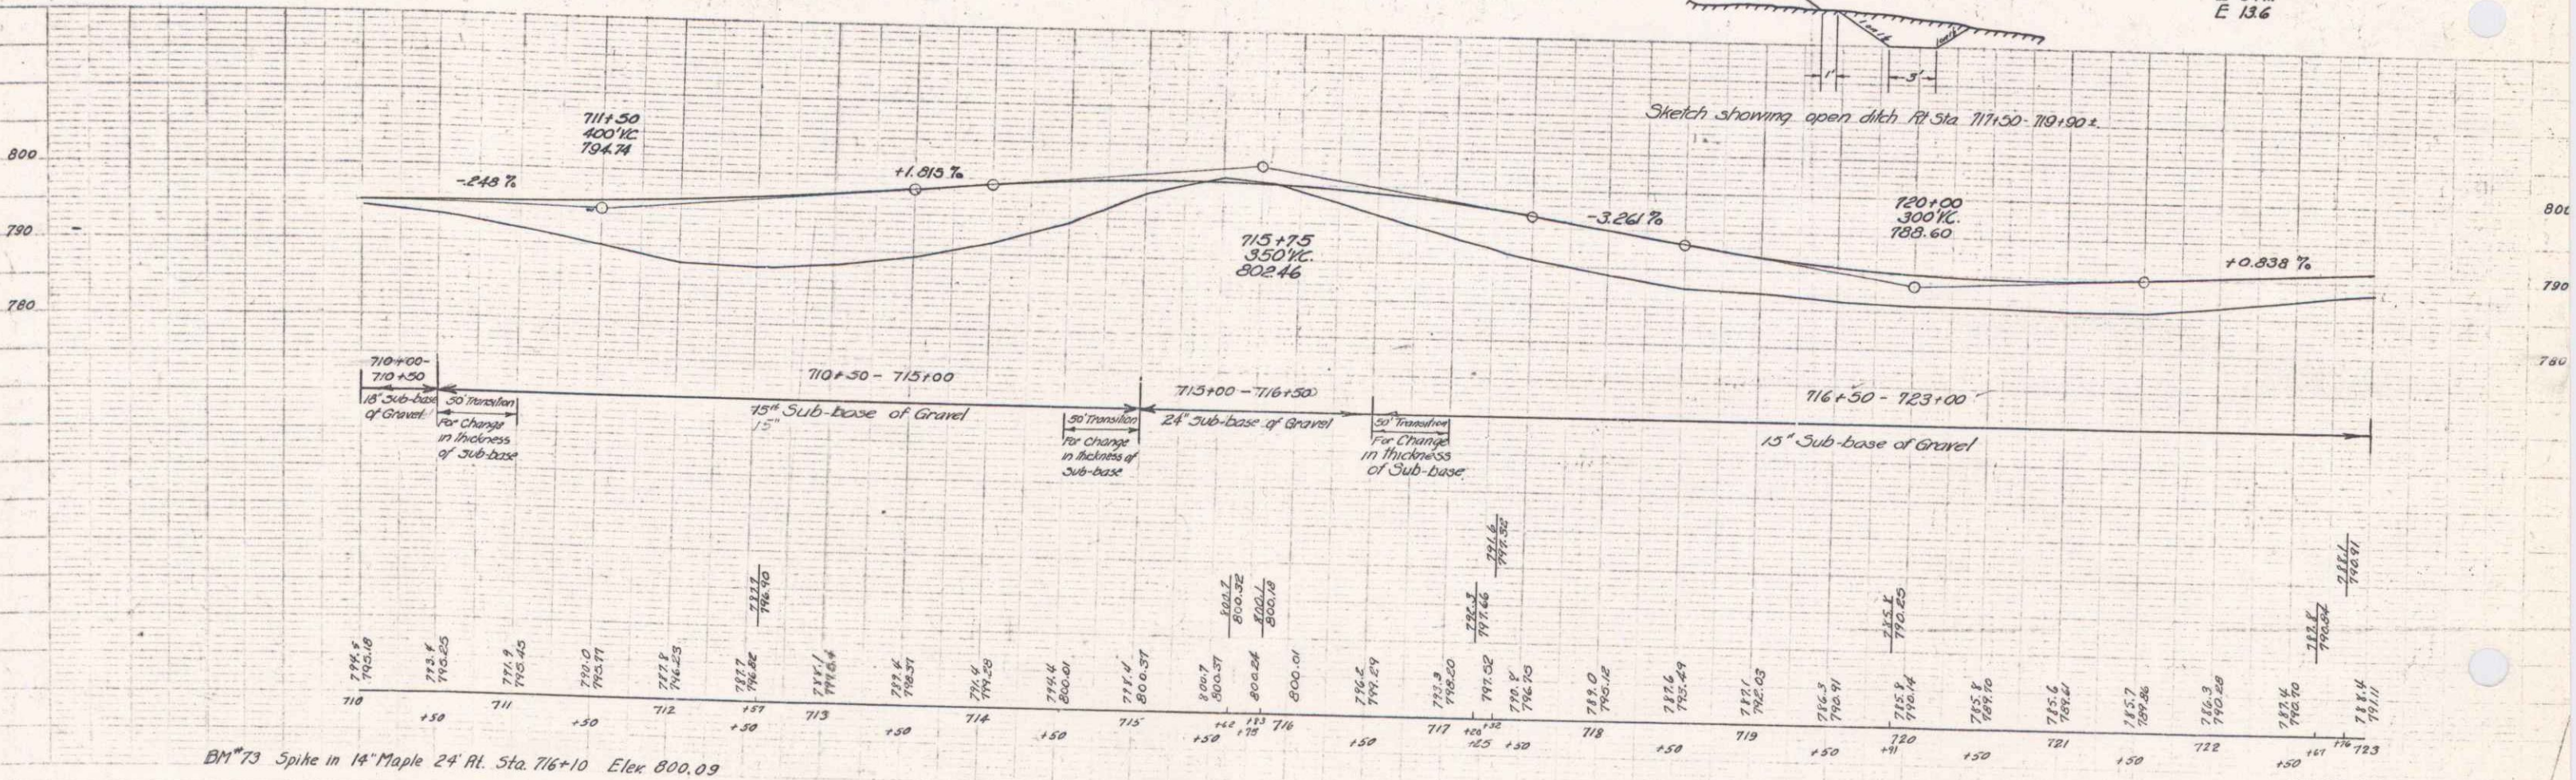


PARCEL INSTRUMENT DATE GRANTOR GRANTEE RECORDED REMARKS  
 A.B.C.D. W.D.O.E. 12-5-40 FLORINA SICOTTE WESTFIELD  
 ST. OF VT. BOOK PAGE DATE  
 76 666-7 12-27-40

STATE	FED. AID	FISCAL YEAR	SHEET NO.	TOTAL SHEETS
VT.	79.10	1941	6	708

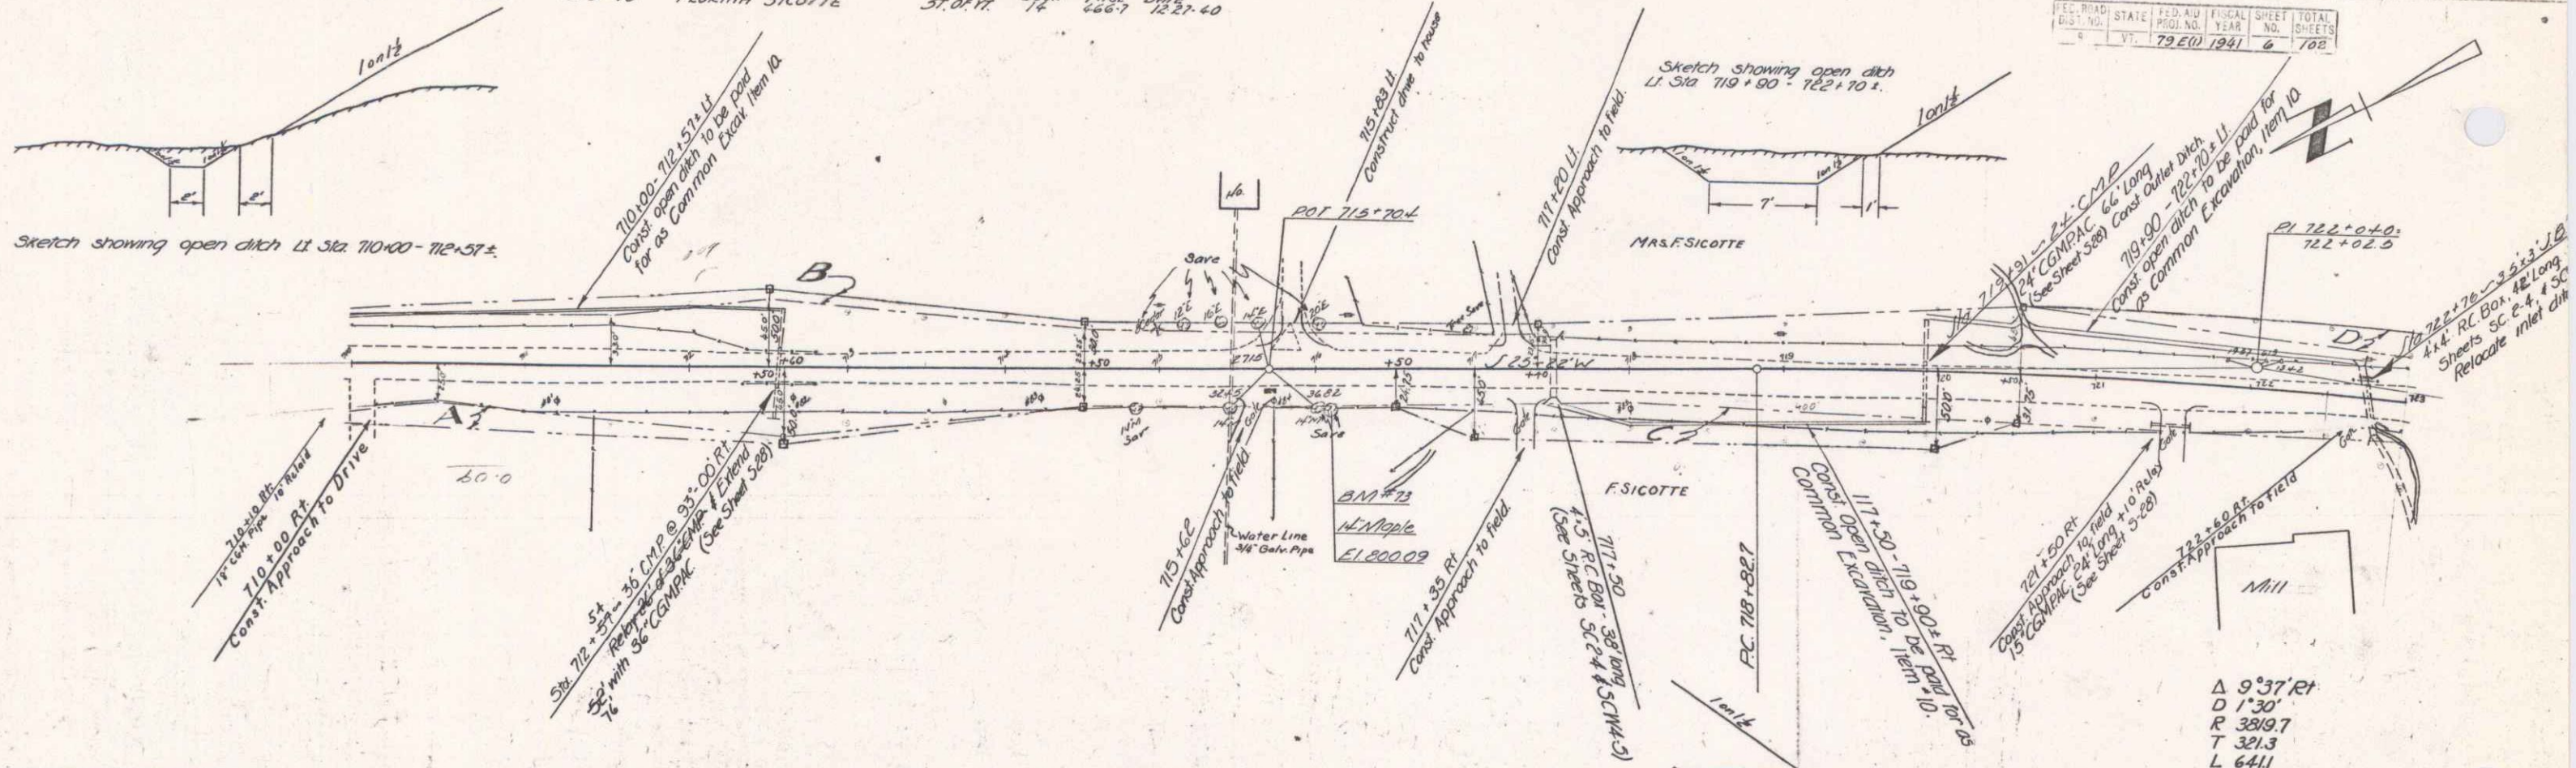

BM#73 Spike in 14" Maple 24' Rt. Sta. 716+10 Elev. 800.09

SERIES P.A.P. NO. 79E(11)  
 SHEET 6 OF 102