
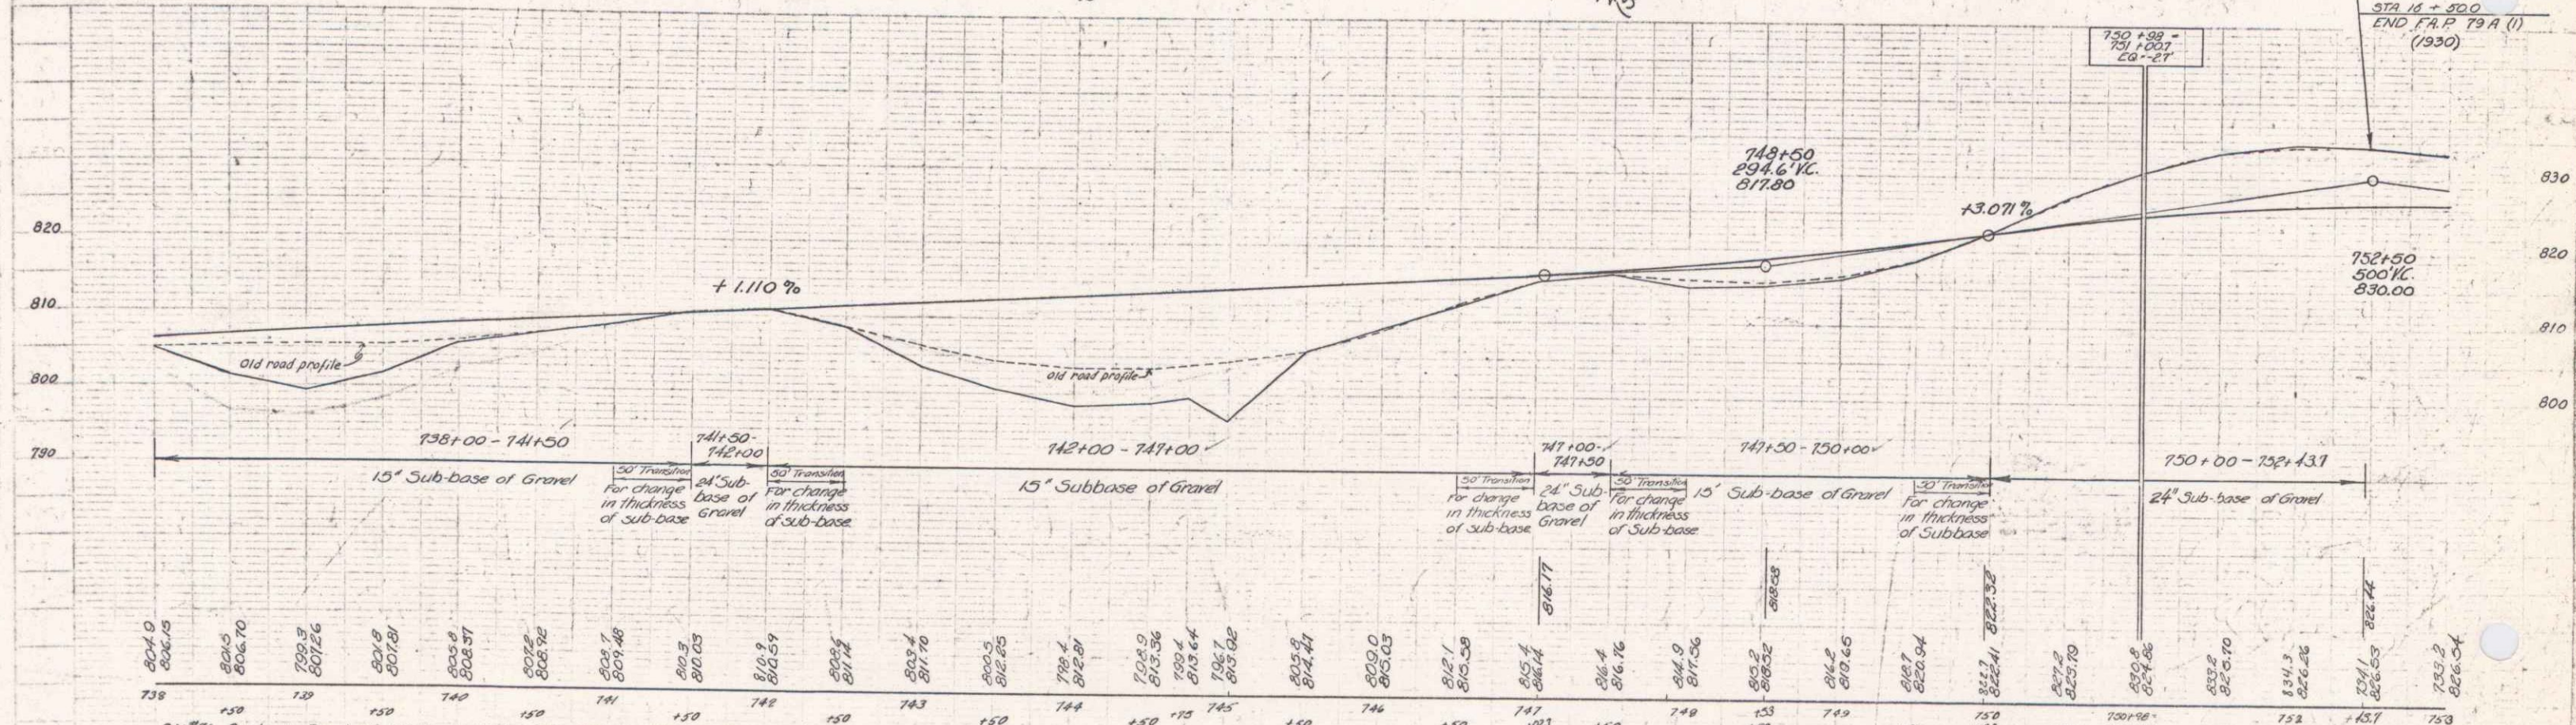


PARCEL INSTRUMENT DATE GRANTOR GRANTEE RECORDED REMARKS
 A.B. W.D.O.E. 12-13-40 ARTHUR L MARIE VERGE ST. OF VT. WESTFIELD
 BOOK 418-3 PAGE 162-163
 DATE 12-23-40

AA
 $\Delta 25^{\circ} 46' Lt$
 $D 1^{\circ} 45'$
 $R 3274.2$
 $T 148.8$
 $L 1472.4$
 $E 84.4$

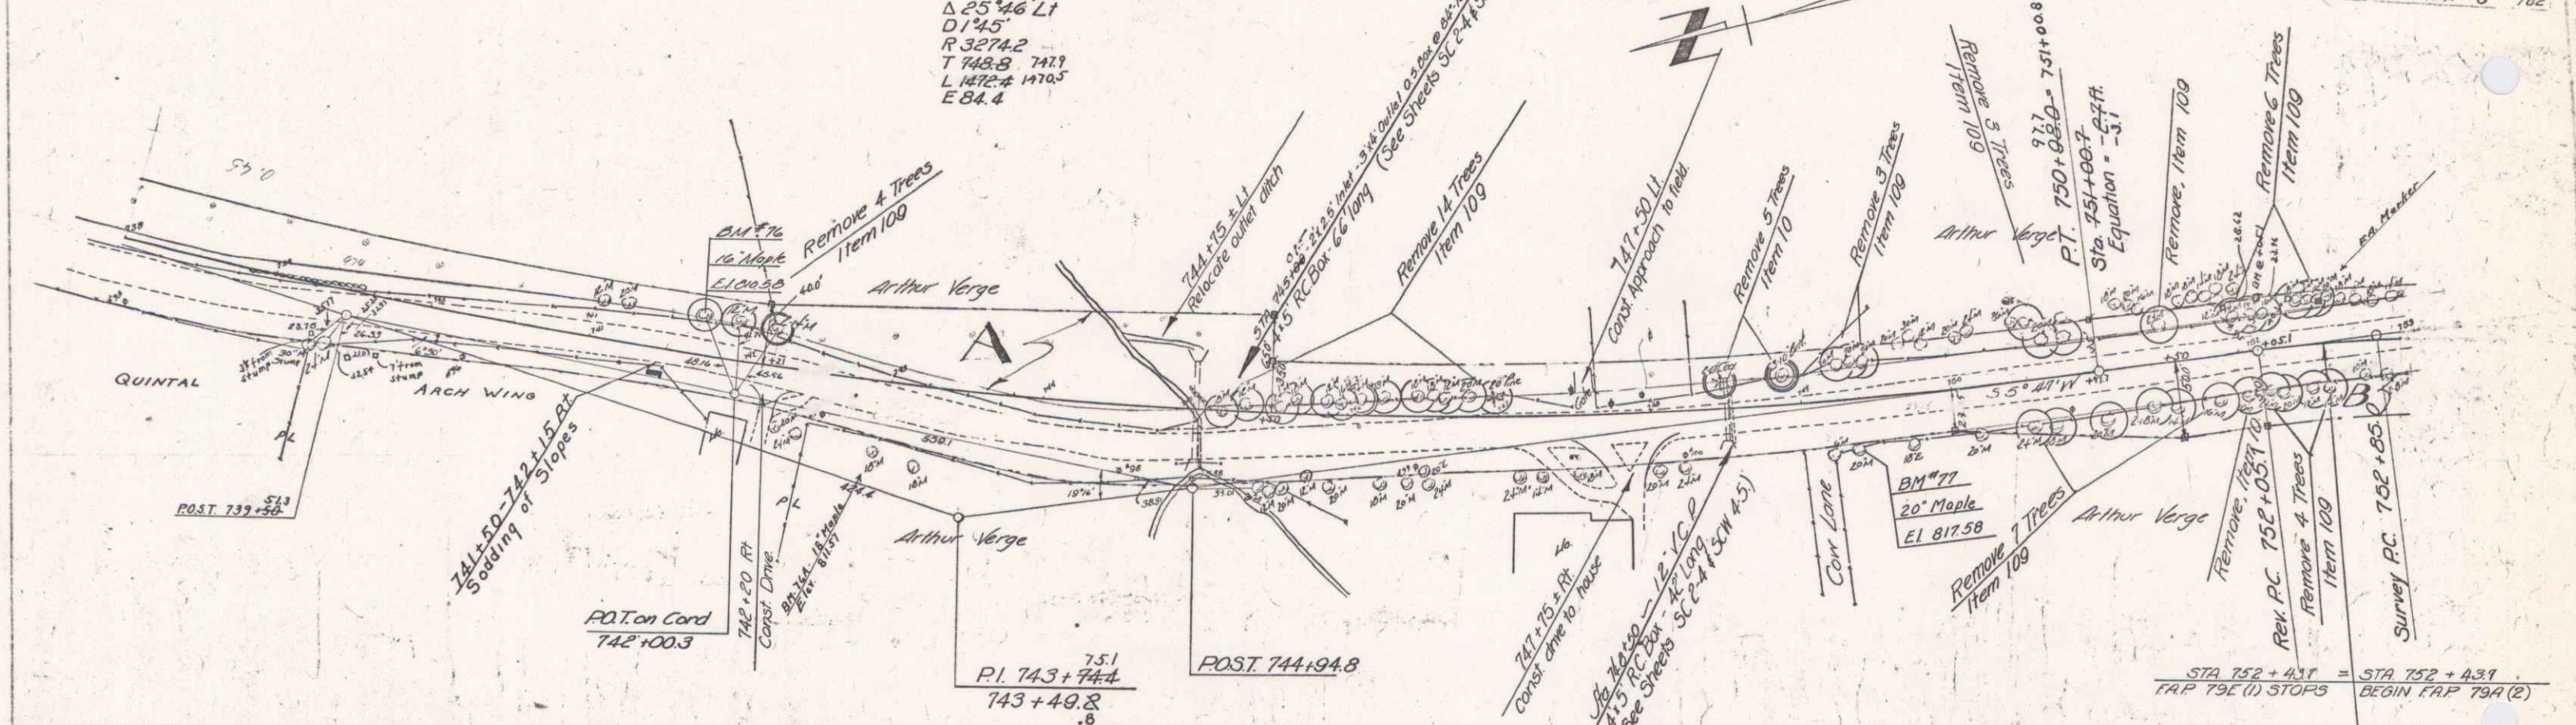

BM #76 Spike in Foot of 16" Maple 22' Lt. Sta 741+72 Elev 810.58
 BM #77 Spike in Foot of 20" Maple 28.5' Rt. Sta 749+34 Elev 817.58

STATE OF VERMONT
 DISTRICT OF WESTFIELD
 79E (1) 1941 8 102

SERIES F.A.P. NO. 79A (1)
 SHEET 8 OF 102