
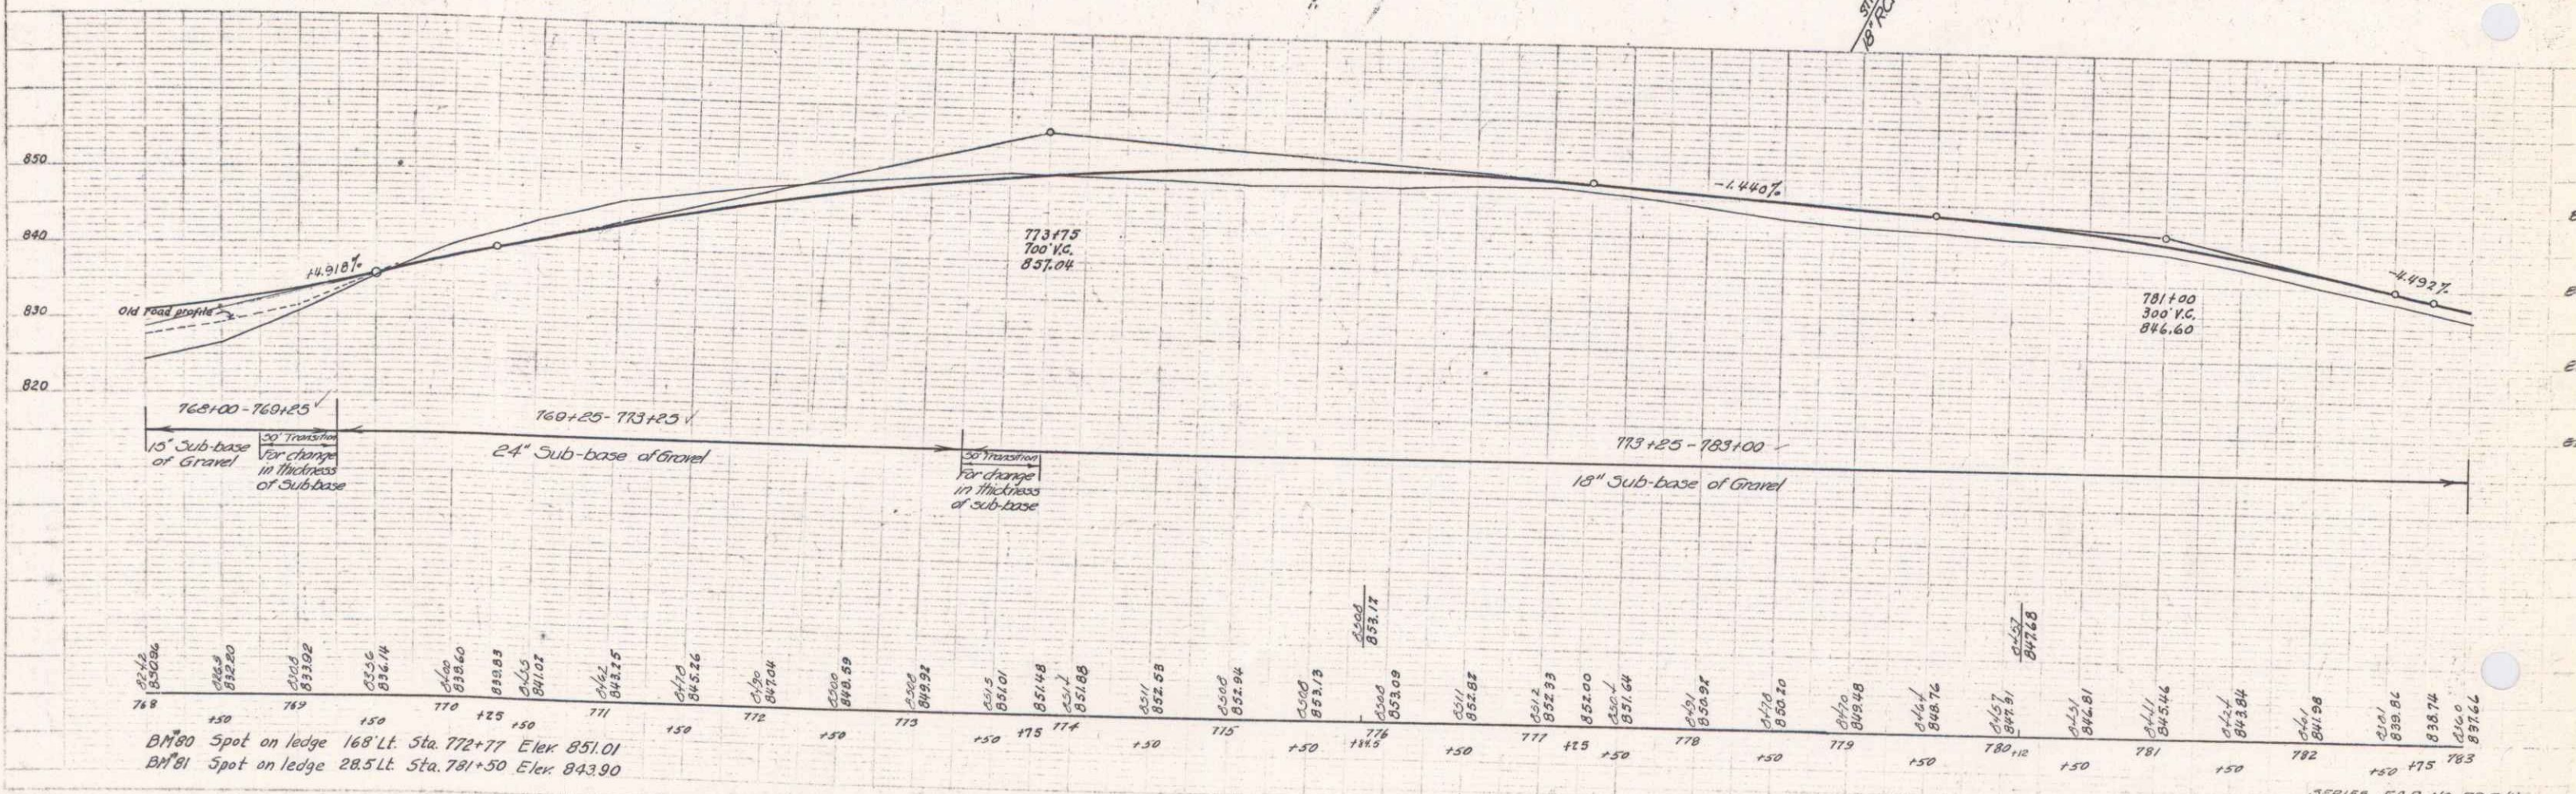


PARCEL INSTRUMENT	DATE	GRANTOR	GRANTEE	RECORDED	REMARKS
DM#80	12-19-40	I.S. & ALICE BARRE	ST. OF VT.	WESTFIELD	
Spot on Ledge	12-5-40	CHARLES & CORNELIA MAYNARD	ST. OF VT.	WESTFIELD	
LI 85101					

FED. ROAD DIST. NO. 79E(1) 1941 TO 102

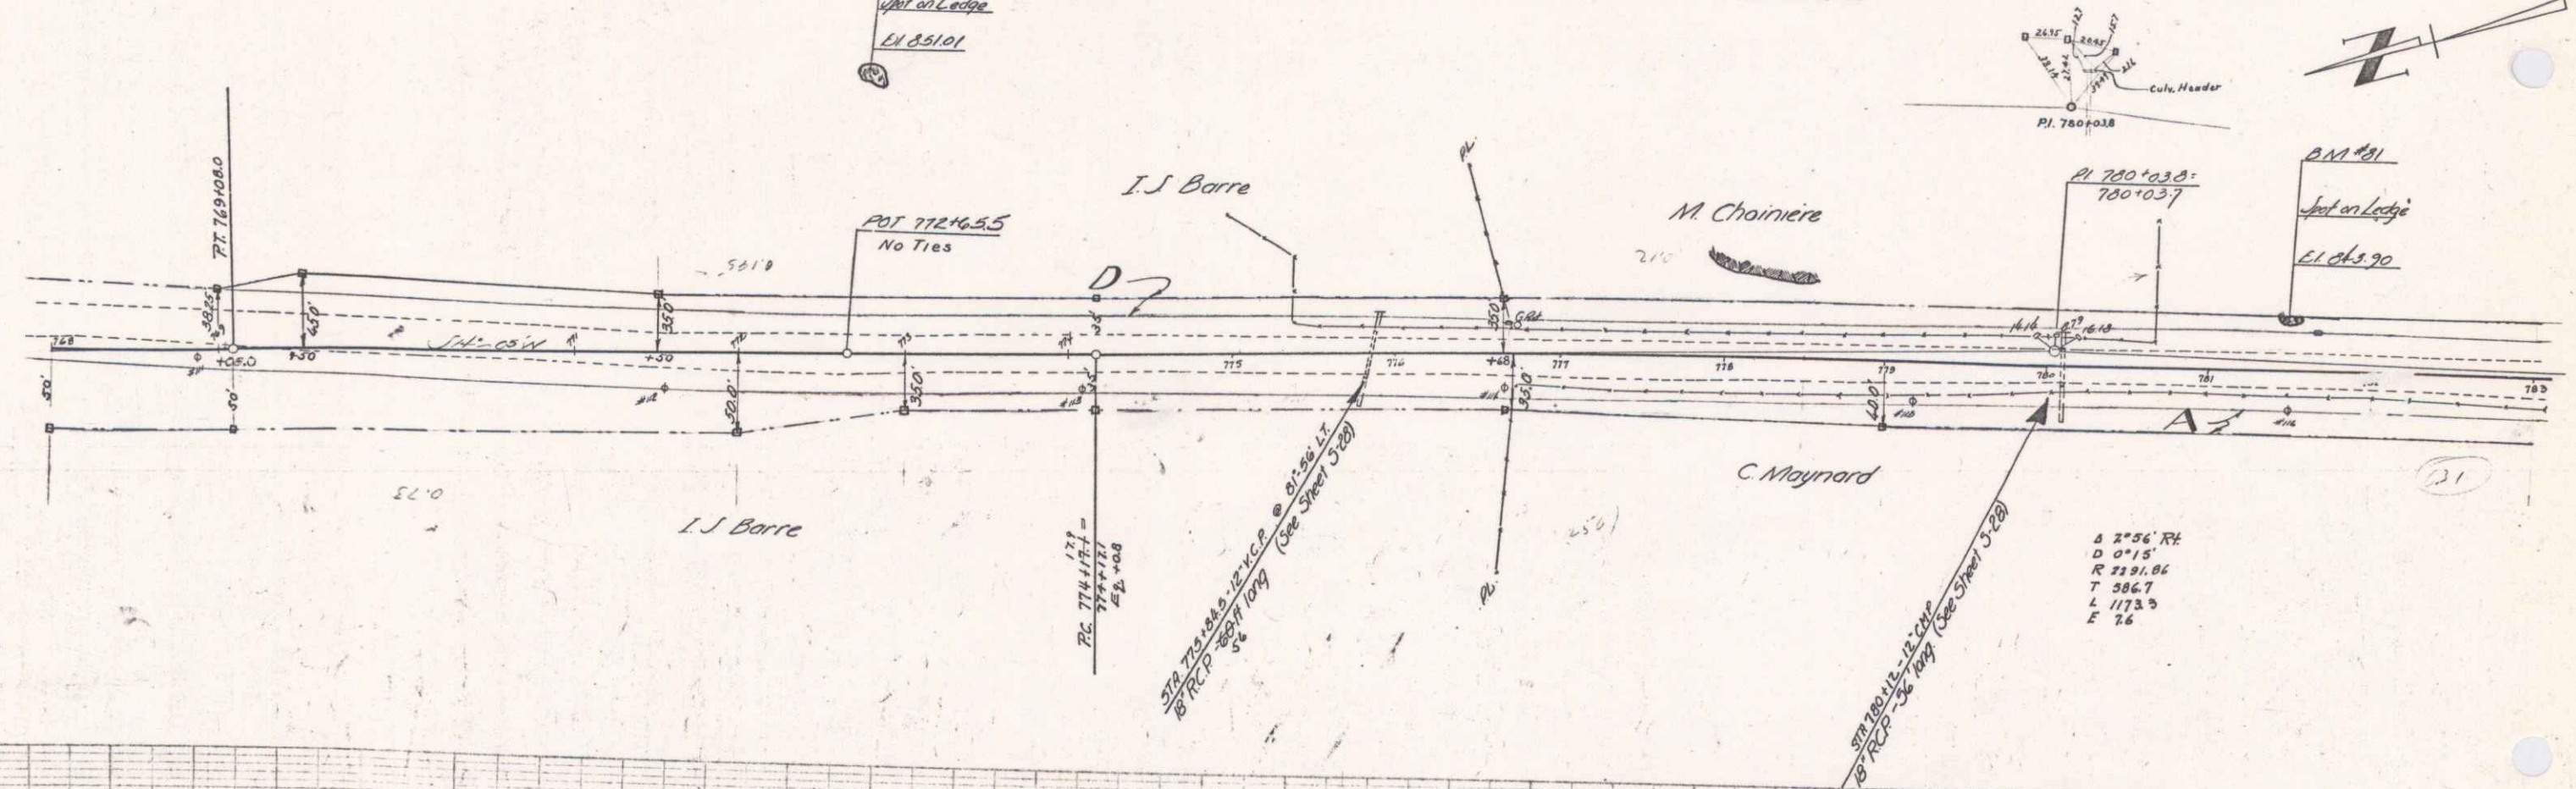

DM#80 Spot on ledge 168' Lt. Sta. 772+77 Elev. 851.01
 DM#81 Spot on ledge 28.5' Lt. Sta. 781+30 Elev. 843.90