
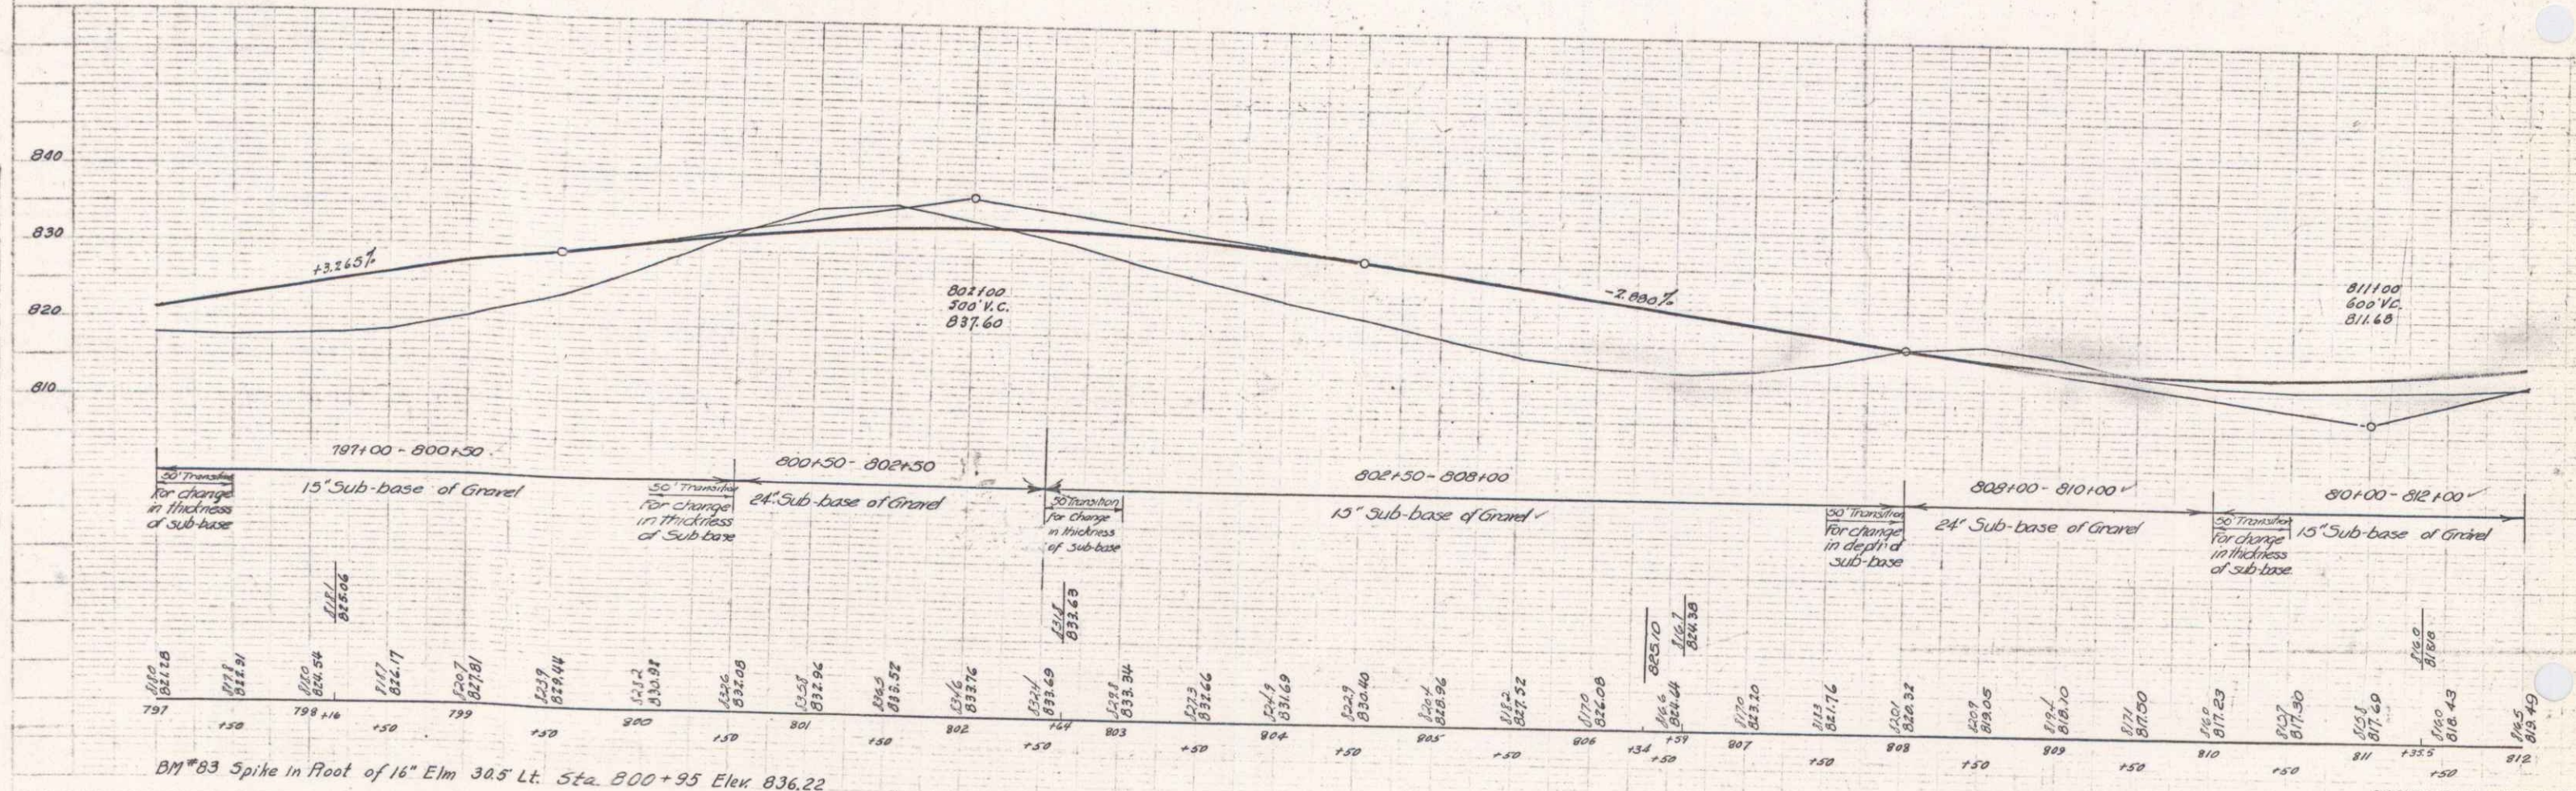


E. L. LORRY
 Faced
 1. LORRY

E. L. LORRY
 Faced
 1. LORRY

PARCEL INSTRUMENT	DATE	GRANTOR	GRANTEE	RECORDED	REMARKS
A	W.D.O.E. 12-11-40	AMIE LYONNE FONTAINE	ST. OF VT.	BOOK 14 PAGE 4	DATE 12-27-40
A	W.D.O.E. 12-5-40	ERNEST & YVONNE BIENVENU	ST. OF VT.	14 481	12-27-40

ED. L. AM. STATE 24x36 IN. FULL SPEED TOTAL
 DIST. NO. 79E (1) 1941 12 102 SHEETS

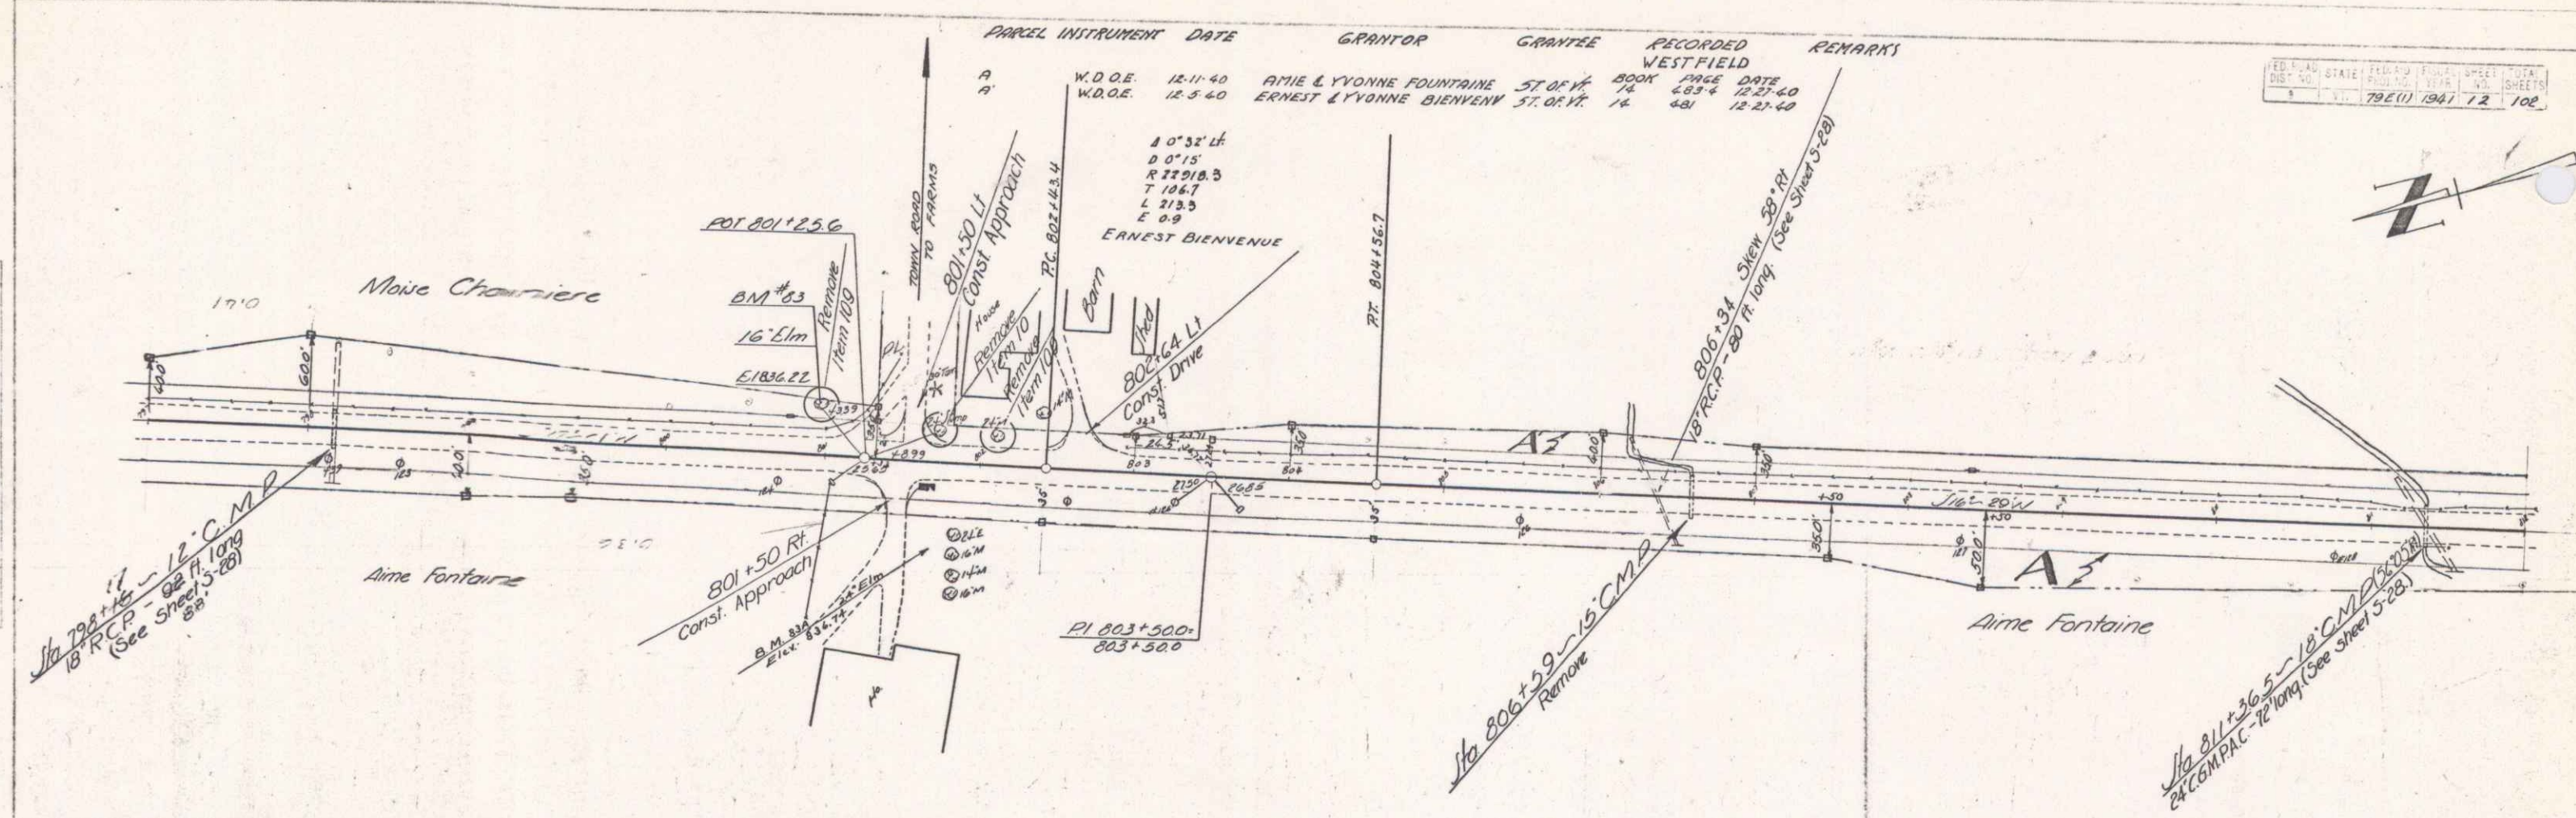

BM #83 Spike in Root of 16" Elm 385 Lt. Sta. 800+95 Elev. 836.22

SERIES P & P NO. 79E (1) SHEET 12 OF 102