



E. B. Linn
 Faced
 L. L. Linn

E. B. Linn
 Faced
 L. L. Linn

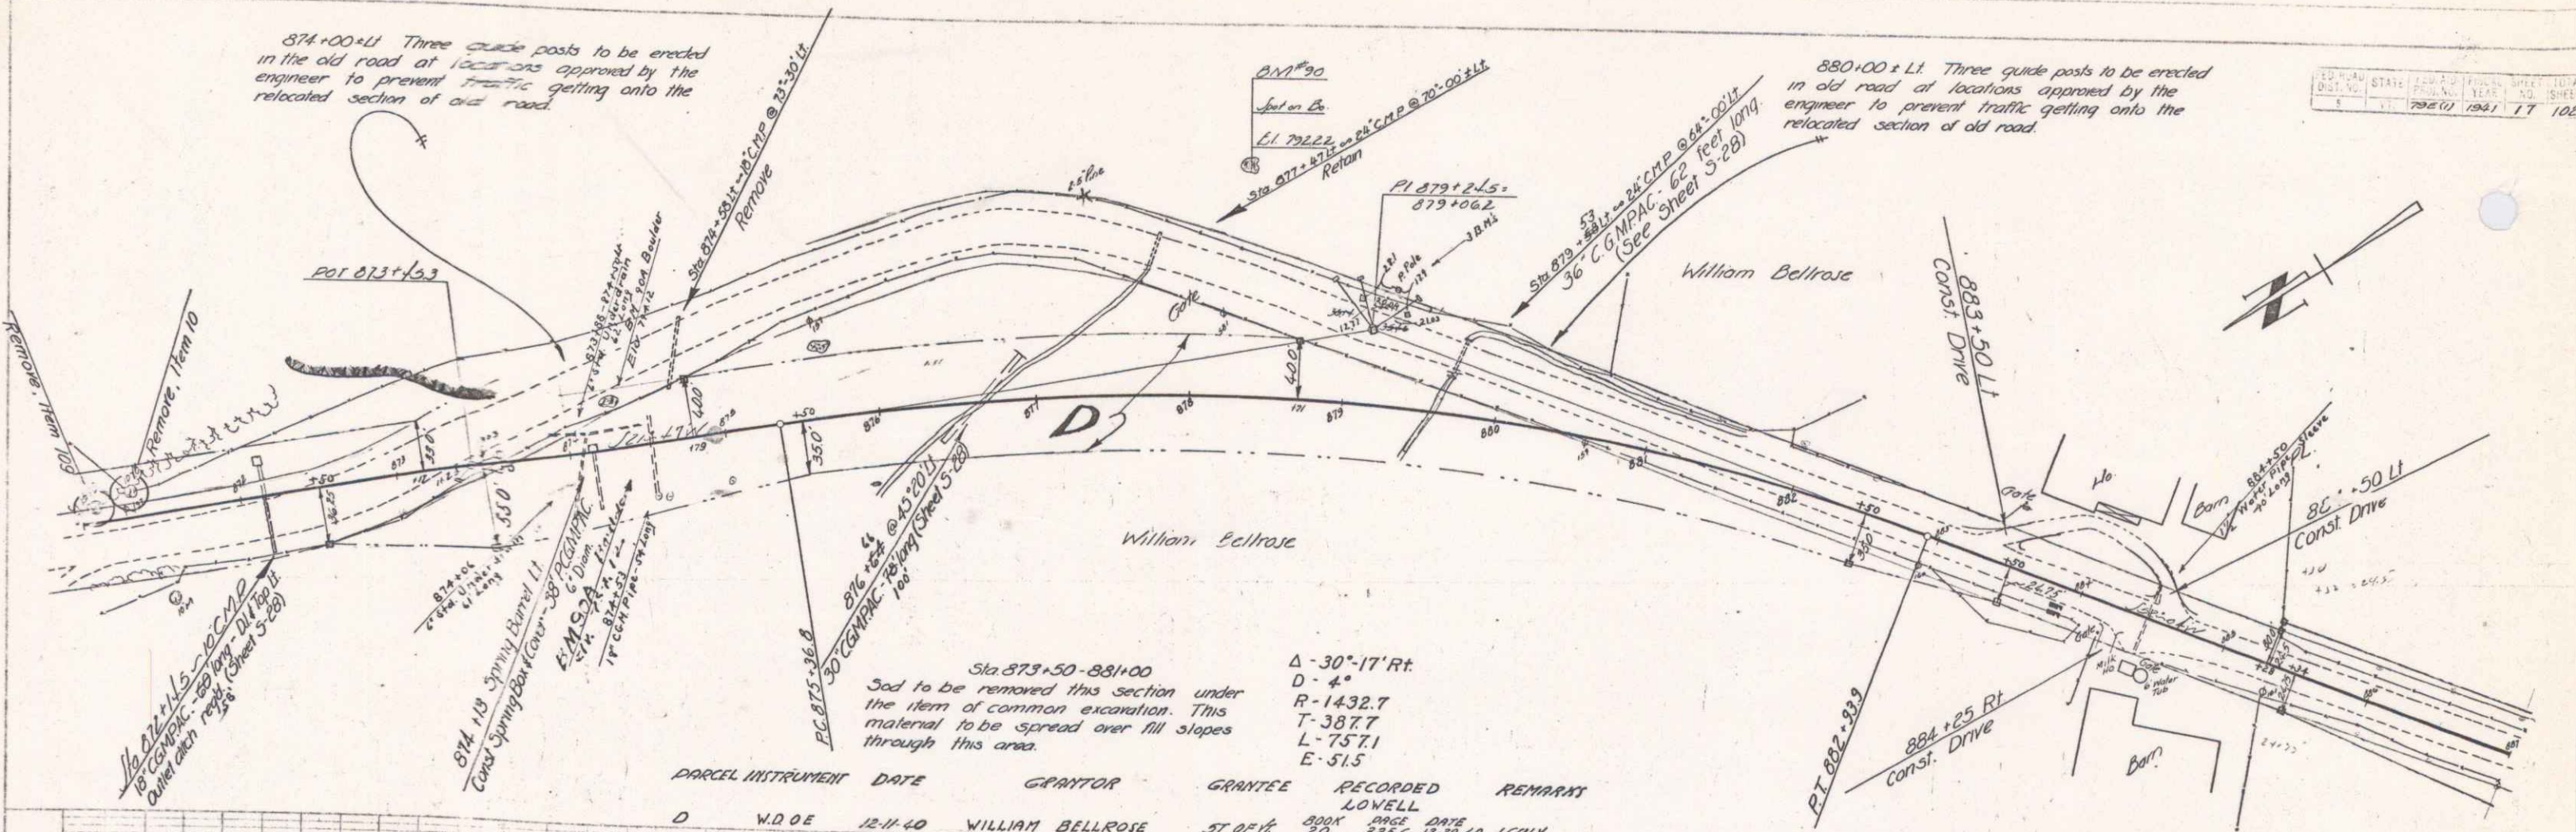

PARCEL INSTRUMENT	DATE	GRANTOR	GRANTEE	RECORDED	REMARKS
D	W.D. DE	12-11-60	WILLIAM BELLROSE	ST OF R	800' X 20' 325.6 12-18-60 1/4

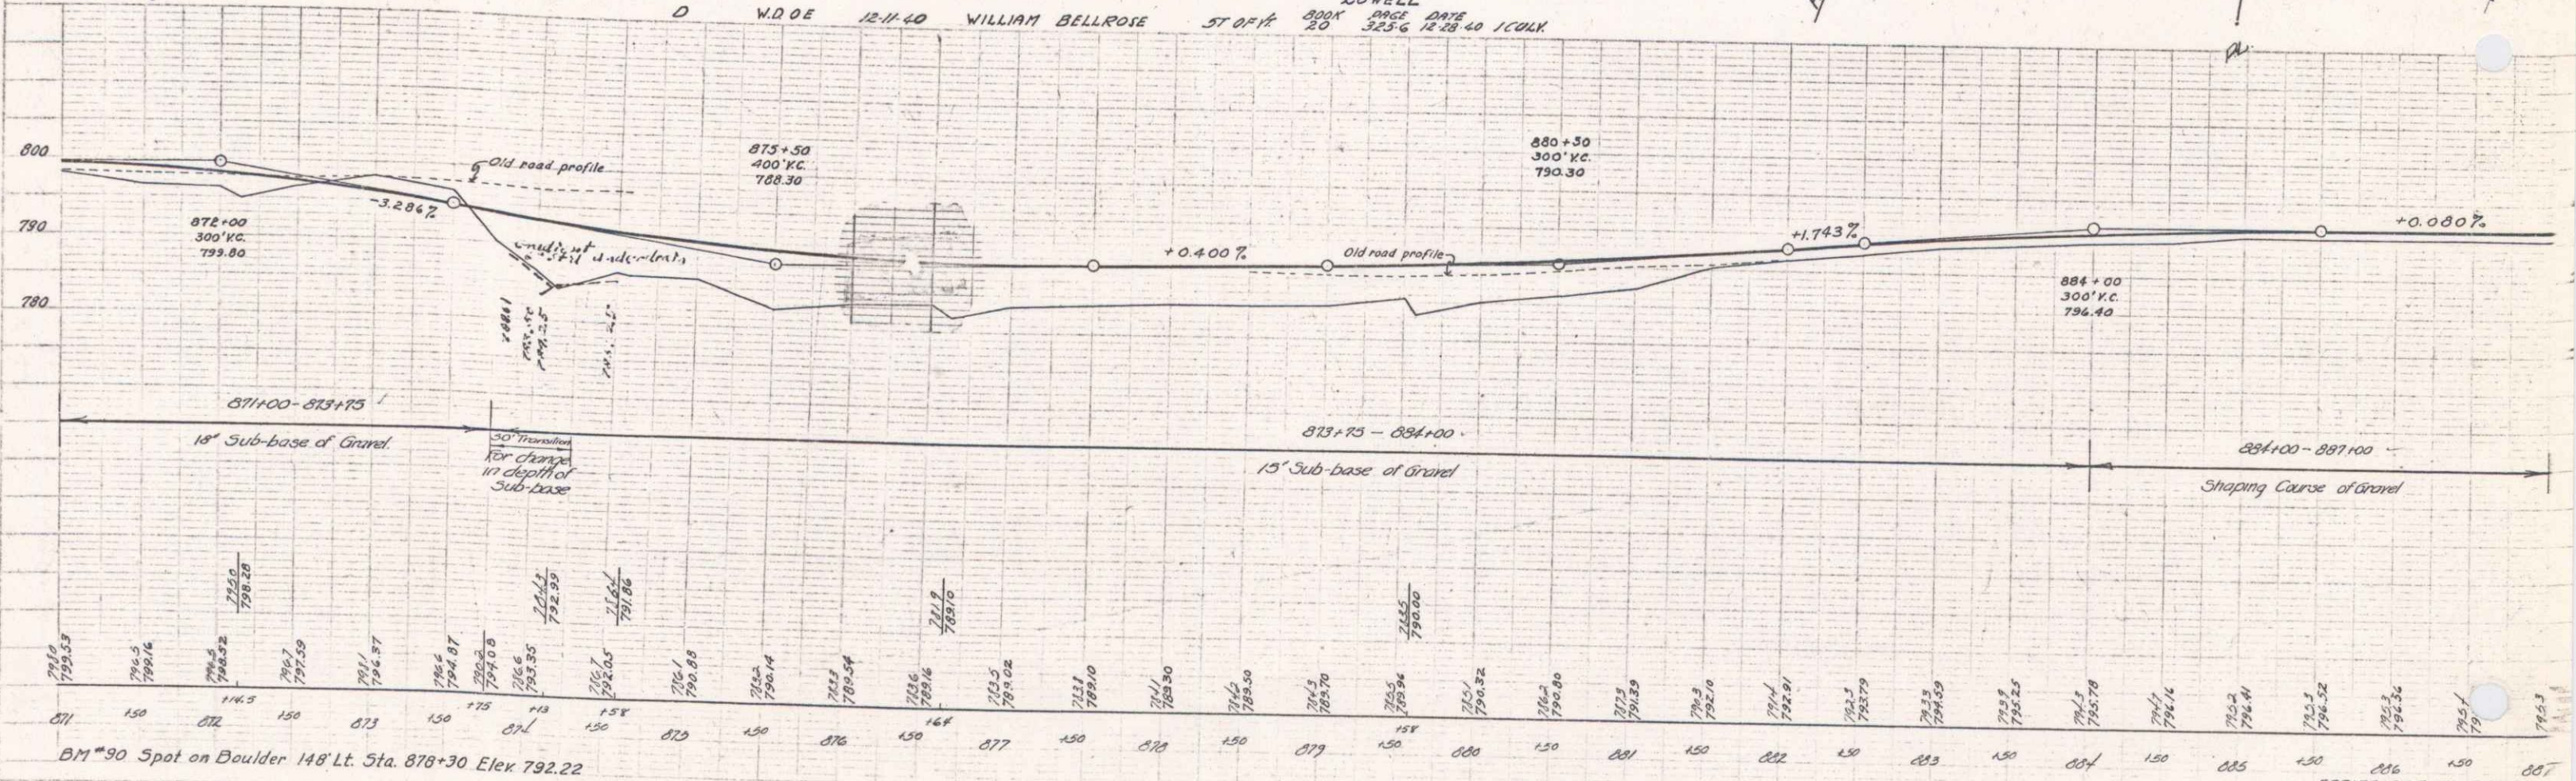

10' HAW STATE
 1981 11 102

SERIES R.P.P. NO. 792(U)
 SHEET 17 OF 102