




Rev. Curve 7.32  
 Δ 7.44' Lt (Approx)  
 D 1"  
 R 2565.3  
 T 387.3 377.2  
 L 743.2 733  
 E 6.5

Sta 895+15 ±  
 Property owner is to furnish a water pipe sleeve and the same is to be placed by the contractor, necessary excavation to be paid for as Trench Excavation.

Sta 892+25  
 Property owner is to furnish a water pipe sleeve and the same is to be placed by the contractor, necessary excavation to be paid for as Trench Excavation.

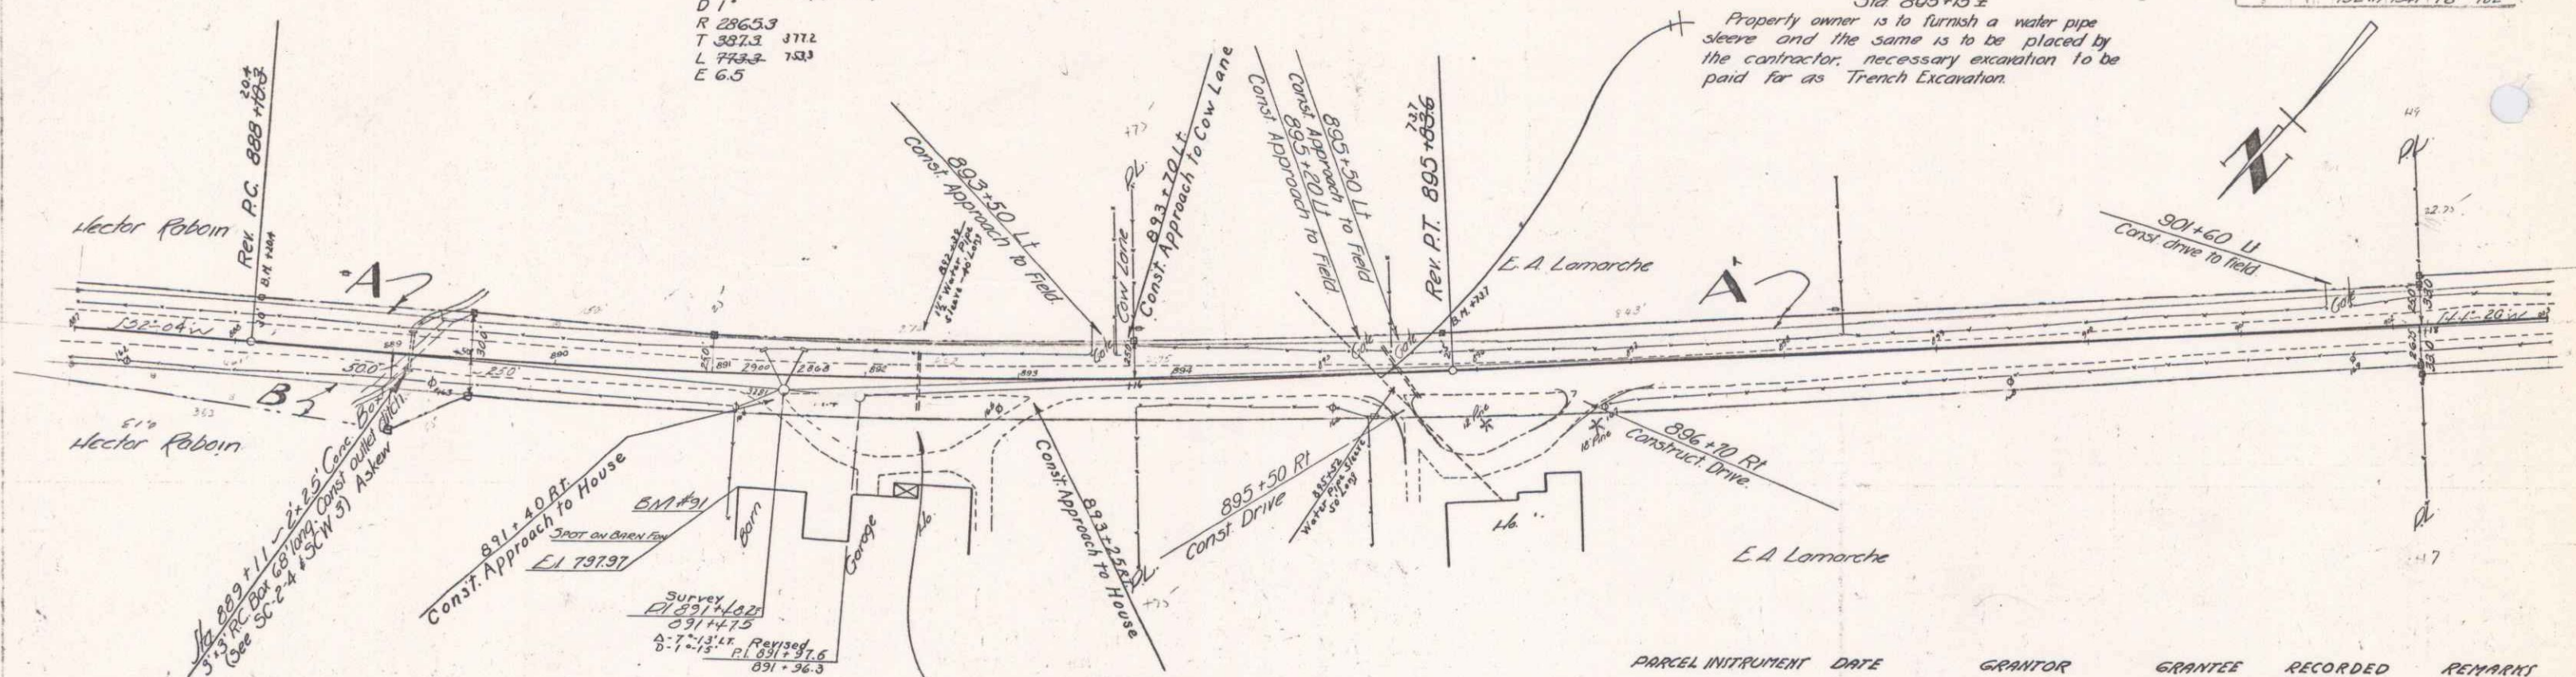

PARCEL	INSTRUMENT	DATE	GRANTOR	GRANTEE	RECORDED	REMARK
A, B	W.D.O.E.	12-21-40	HECTOR & VENALDA RABOIN	ST OF VT	20 332	12-28-40
A'	W.D.O.E.	12-19-40	E.A. LAMARCHE	ST OF VT	20 328	12-28-40

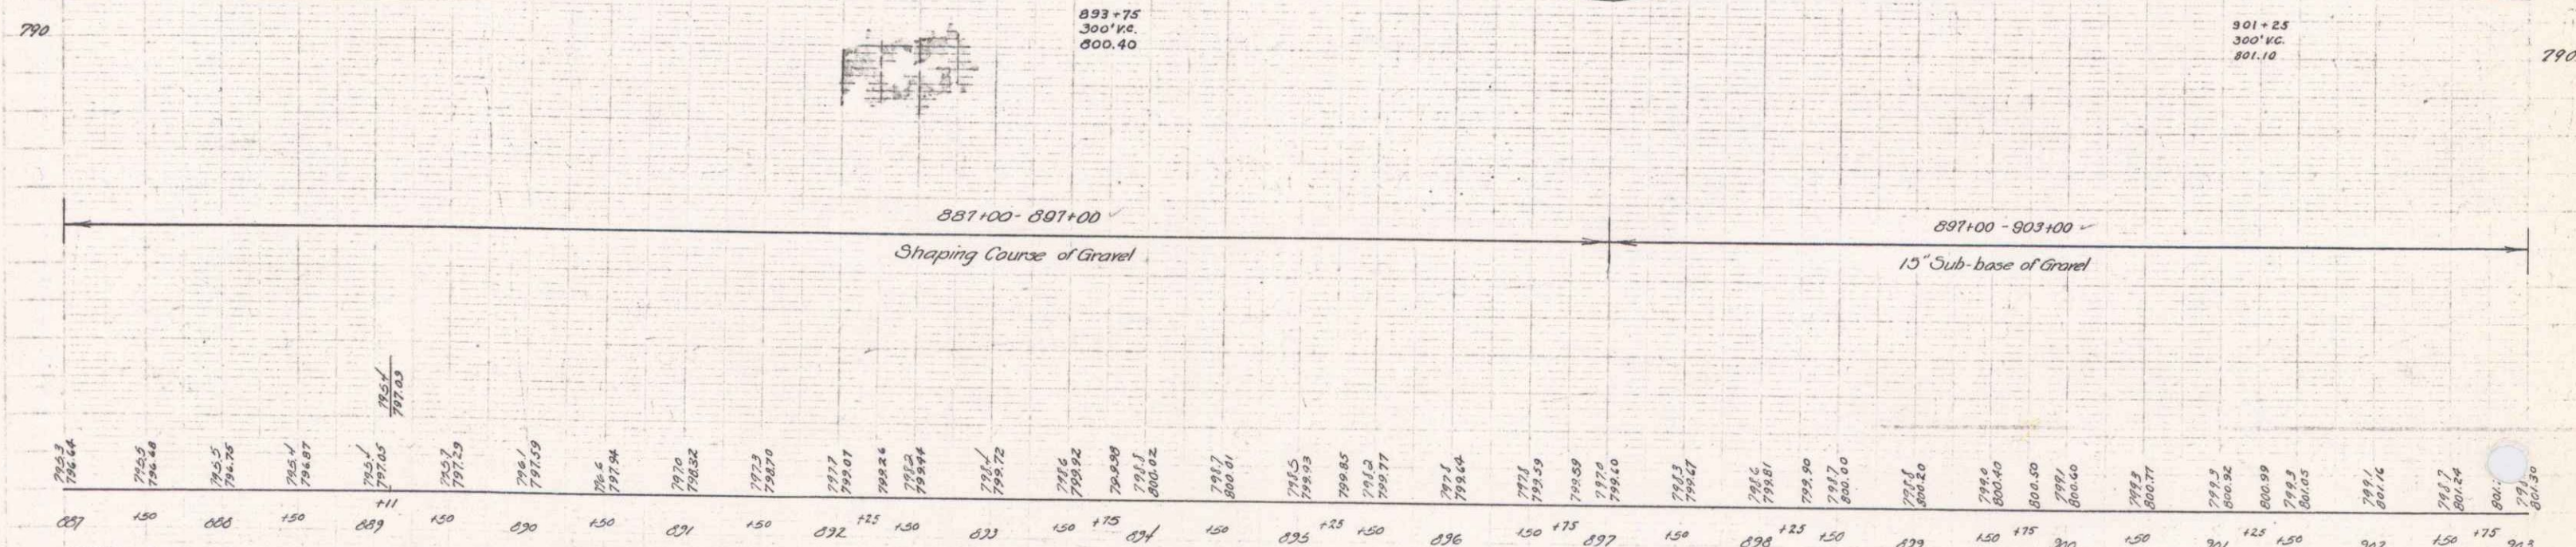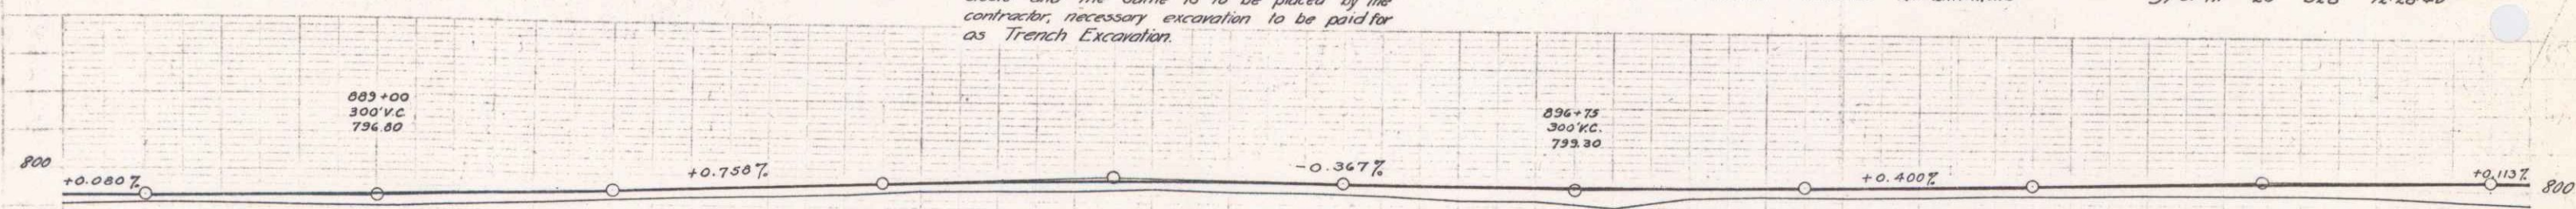

726.64	726.48	726.26	726.07	725.81	725.52	725.29	725.01	724.74	724.52	724.27	724.07	723.84	723.52	723.27	723.07	722.84	722.52	722.27	722.07	721.84	721.52	721.27	721.07	720.84	720.52	720.27	720.07	719.84	719.52	719.27	719.07	718.84	718.52	718.27	718.07	717.84	717.52	717.27	717.07	716.84	716.52	716.27	716.07	715.84	715.52	715.27	715.07	714.84	714.52	714.27	714.07	713.84	713.52	713.27	713.07	712.84	712.52	712.27	712.07	711.84	711.52	711.27	711.07	710.84	710.52	710.27	710.07	709.84	709.52	709.27	709.07	708.84	708.52	708.27	708.07	707.84	707.52	707.27	707.07	706.84	706.52	706.27	706.07	705.84	705.52	705.27	705.07	704.84	704.52	704.27	704.07	703.84	703.52	703.27	703.07	702.84	702.52	702.27	702.07	701.84	701.52	701.27	701.07	700.84	700.52	700.27	700.07	699.84	699.52	699.27	699.07	698.84	698.52	698.27	698.07	697.84	697.52	697.27	697.07	696.84	696.52	696.27	696.07	695.84	695.52	695.27	695.07	694.84	694.52	694.27	694.07	693.84	693.52	693.27	693.07	692.84	692.52	692.27	692.07	691.84	691.52	691.27	691.07	690.84	690.52	690.27	690.07	689.84	689.52	689.27	689.07	688.84	688.52	688.27	688.07	687.84	687.52	687.27	687.07	686.84	686.52	686.27	686.07	685.84	685.52	685.27	685.07	684.84	684.52	684.27	684.07	683.84	683.52	683.27	683.07	682.84	682.52	682.27	682.07	681.84	681.52	681.27	681.07	680.84	680.52	680.27	680.07	679.84	679.52	679.27	679.07	678.84	678.52	678.27	678.07	677.84	677.52	677.27	677.07	676.84	676.52	676.27	676.07	675.84	675.52	675.27	675.07	674.84	674.52	674.27	674.07	673.84	673.52	673.27	673.07	672.84	672.52	672.27	672.07	671.84	671.52	671.27	671.07	670.84	670.52	670.27	670.07	669.84	669.52	669.27	669.07	668.84	668.52	668.27	668.07	667.84	667.52	667.27	667.07	666.84	666.52	666.27	666.07	665.84	665.52	665.27	665.07	664.84	664.52	664.27	664.07	663.84	663.52	663.27	663.07	662.84	662.52	662.27	662.07	661.84	661.52	661.27	661.07	660.84	660.52	660.27	660.07	659.84	659.52	659.27	659.07	658.84	658.52	658.27	658.07	657.84	657.52	657.27	657.07	656.84	656.52	656.27	656.07	655.84	655.52	655.27	655.07	654.84	654.52	654.27	654.07	653.84	653.52	653.27	653.07	652.84	652.52	652.27	652.07	651.84	651.52	651.27	651.07	650.84	650.52	650.27	650.07	649.84	649.52	649.27	649.07	648.84	648.52	648.27	648.07	647.84	647.52	647.27	647.07	646.84	646.52	646.27	646.07	645.84	645.52	645.27	645.07	644.84	644.52	644.27	644.07	643.84	643.52	643.27	643.07	642.84	642.52	642.27	642.07	641.84	641.52	641.27	641.07	640.84	640.52	640.27	640.07	639.84	639.52	639.27	639.07	638.84	638.52	638.27	638.07	637.84	637.52	637.27	637.07	636.84	636.52	636.27	636.07	635.84	635.52	635.27	635.07	634.84	634.52	634.27	634.07	633.84	633.52	633.27	633.07	632.84	632.52	632.27	632.07	631.84	631.52	631.27	631.07	630.84	630.52	630.27	630.07	629.84	629.52	629.27	629.07	628.84	628.52	628.27	628.07	627.84	627.52	627.27	627.07	626.84	626.52	626.27	626.07	625.84	625.52	625.27	625.07	624.84	624.52	624.27	624.07	623.84	623.52	623.27	623.07	622.84	622.52	622.27	622.07	621.84	621.52	621.27	621.07	620.84	620.52	620.27	620.07	619.84	619.52	619.27	619.07	618.84	618.52	618.27	618.07	617.84	617.52	617.27	617.07	616.84	616.52	616.27	616.07	615.84	615.52	615.27	615.07	614.84	614.52	614.27	614.07	613.84	613.52	613.27	613.07	612.84	612.52	612.27	612.07	611.84	611.52	611.27	611.07	610.84	610.52	610.27	610.07	609.84	609.52	609.27	609.07	608.84	608.52	608.27	608.07	607.84	607.52	607.27	607.07	606.84	606.52	606.27	606.07	605.84	605.52	605.27	605.07	604.84	604.52	604.27	604.07	603.84	603.52	603.27	603.07	602.84	602.52	602.27	602.07	601.84	601.52	601.27	601.07	600.84	600.52	600.27	600.07	599.84	599.52	599.27	599.07	598.84	598.52	598.27	598.07	597.84	597.52	597.27	597.07	596.84	596.52	596.27	596.07	595.84	595.52	595.27	595.07	594.84	594.52	594.27	594.07	593.84	593.52	593.27	593.07	592.84	592.52	592.27	592.07	591.84	591.52	591.27	591.07	590.84	590.52	590.27	590.07	589.84	589.52	589.27	589.07	588.84	588.52	588.27	588.07	587.84	587.52	587.27	587.07	586.84	586.52	586.27	586.07	585.84	585.52	585.27	585.07	584.84	584.52	584.27	584.07	583.84	583.52	583.27	583.07	582.84	582.52	582.27	582.07	581.84	581.52	581.27	581.07	580.84	580.52	580.27	580.07	579.84	579.52	579.27	579.07	578.84	578.52	578.27	578.07	577.84	577.52	577.27	577.07	576.84	576.52	576.27	576.07	575.84	575.52	575.27	575.07	574.84	574.52	574.27	574.07	573.84	573.52	573.27	573.07	572.84	572.52	572.27	572.07	571.84	571.52	571.27	571.07	570.84	570.52	570.27	570.07	569.84	569.52	569.27	569.07	568.84	568.52	568.27	568.07	567.84	567.52	567.27	567.07	566.84	566.52	566.27	566.07	565.84	565.52	565.27	565.07	564.84	564.52	564.27	564.07	563.84	563.52	563.27	563.07	562.84	562.52	562.27	562.07	561.84	561.52	561.27	561.07	560.84	560.52	560.27	560.07	559.84	559.52	559.27	559.07	558.84	558.52	558.27	558.07	557.84	557.52	557.27	557.07	556.84	556.52	556.27	556.07	555.84	555.52	555.27	555.07	554.84	554.52	554.27	554.07	553.84	553.52	553.27	553.07	552.84	552.52	552.27	552.07	551.84	551.52	551.27	551.07	550.84	550.52	550.27	550.07	549.84	549.52	549.27	549.07	548.84	548.52	548.27	548.07	547.84	547.52	547.27	547.07	546.84	546.52	546.27	546.07	545.84	545.52	545.27	545.07	544.84	544.52	544.27	544.07	543.84	543.52	543.27	543.07	542.84	542.52	542.27	542.07	541.84	541.52	541.27	541.07	540.84	540.52	540.27	540.07	539.84	539.52	539.27	539.07	538.84	538.52	538.27	538.07	537.84	537.52	537.27	537.07	536.84	536.52	536.27	536.07	535.84	535.52	535.27	535.07	534.84	534.52	534.27	534.07	533.84	533.52	533.27	533.07	532.84	532.52	532.27	532.07	531.84	531.52	531.27	531.07	530.84	530.52	530.27	530.07	529.84	529.52	529.27	529.07	528.84	528.52	528.27	528.07	527.84	527.52	527.27	527.07	526.84	526.52	526.27	526.07	525.84	525.52	525.27	525.07	524.84	524.52	524.27	524.07	523.84	523.52	523.27	523.07	522.84	522.52	522.27	522.07	521.84	521.52	521.27	521.07	520.84	520.52	520.27	520.07	519.84	519.52	519.27	519.07	518.84	518.52	518.27	518.07	517.84	517.52	517.27	517.07	516.84	516.52	516.27	516.07	515.84	515.52	515.27	515.07	514.84	514.52	514.27	514.07	513.84	513.52	513.27	513.07	512.84	512.52	512.27	512.07	511.84	511.52	511.27	511.07	510.84	510.52	510.27	510.07	509.84	509.52	509.27	509.07	508.84	508.52	508.27	508.07	507.84	507.52	507.27	507.07	506.84	506.52	506.27	506.07	505.84	505.52	505.27	505.07	504.84	504.52	504.27	504.07	503.84	503.52	503.27	503.07	502.84	502.52	502.27	502.07	501.84	501.52	501.27	501.07	500.84	500.52	500.27	500.07	499.84	499.52	499.27	499.07	498.84	498.52	498.27	498.07	497.84	497.52	497.27	497.07	496.84	496.52	496.27	496.07	495.84	495.52	495.27	495.07	494.84	494.52	494.27	494.07	493.84	493.52	493.27	493.07	492.84	492.52	492.27	492.07	491.84	491.52	491.27	491.07	490.84	490.52	490.27	490.07	489.84	489.52	489.27	489.07	488.84	488.52	488.27	488.07	487.84	487.52	487.27	487.07	486.84	486.52	486.27	486.07	485.84	485.52	485.27	485.07	484.84	484.52	484.27	484.07	483.84	483.52	483.27	483.07	482.84	482.52	482.27	482.07	481.84	481.52	481.27	481.07	480.84	480.52	480.27	480.07	479.84	479.52	479.27	479.07	478.84	478.52	478.27	478.07	477.84	477.52	477.27	477.07	476.84	476.52	476.27	476.07	475.84	475.52	475.27	475.07	474.84	474.52	474.27	474.07	473.84	473.52	473.27	473.07	472.84	472.52	472.27	472.07	471.84	471.52	471.27	471.07	470.84	470.52	470.27	470.07	
--------	--------	--