


PARCEL	INSTRUMENT	DATE	GRANTOR	GRANTEE	RECORDED	REMARKS
B.C.	W.D.O.E.	7-21-41	W.H. POPE	ST OF VT	20 345	7-28-41
A	W.D.O.E.	7-21-41	R.E. GIBNEY	ST OF VT	20 366	7-28-41

Begin Section 251+50

NOTE
STA. 957+00
New cross sections to be taken at this location before a new project is started on district of the fill made as part of the 79E(1) project.

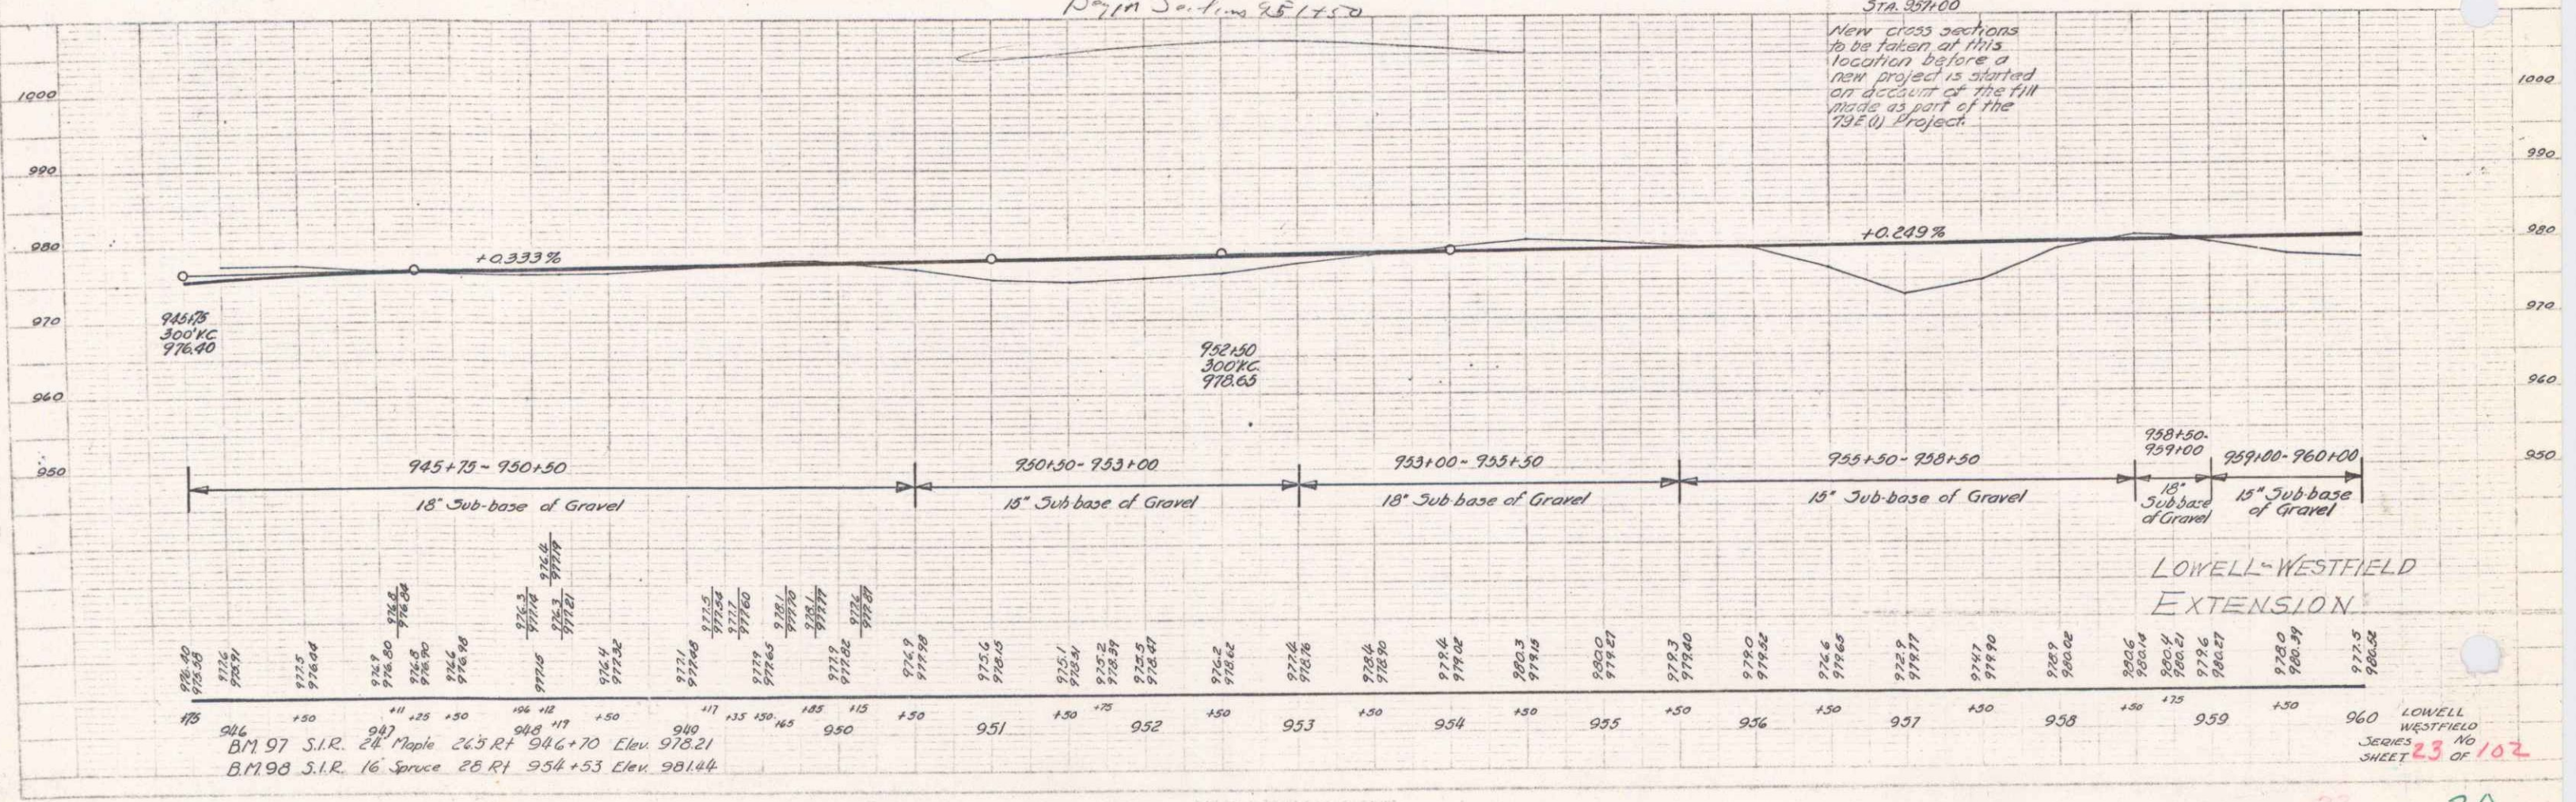

LOWELL-WESTFIELD EXTENSION

LOWELL WESTFIELD SERIES 23 OF 102 SHEET