
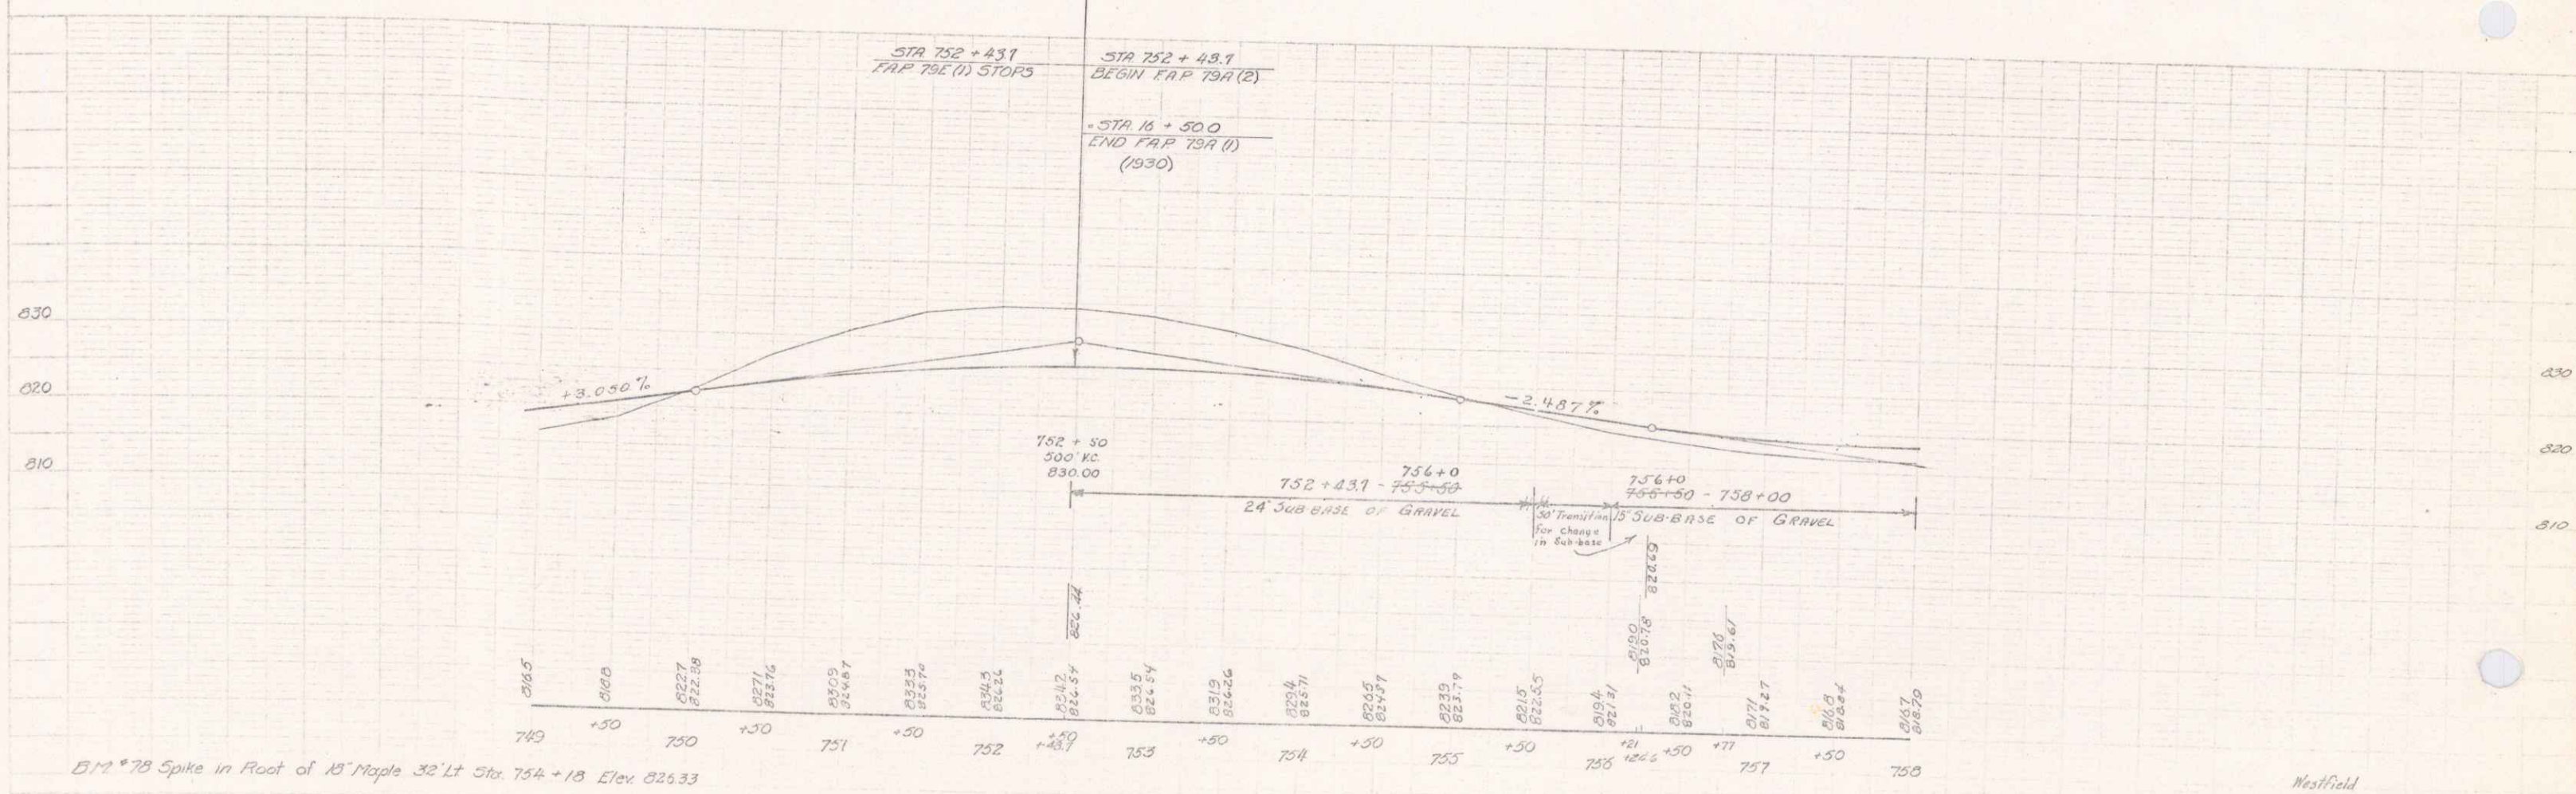


PLAN
I. Laurin
Traced

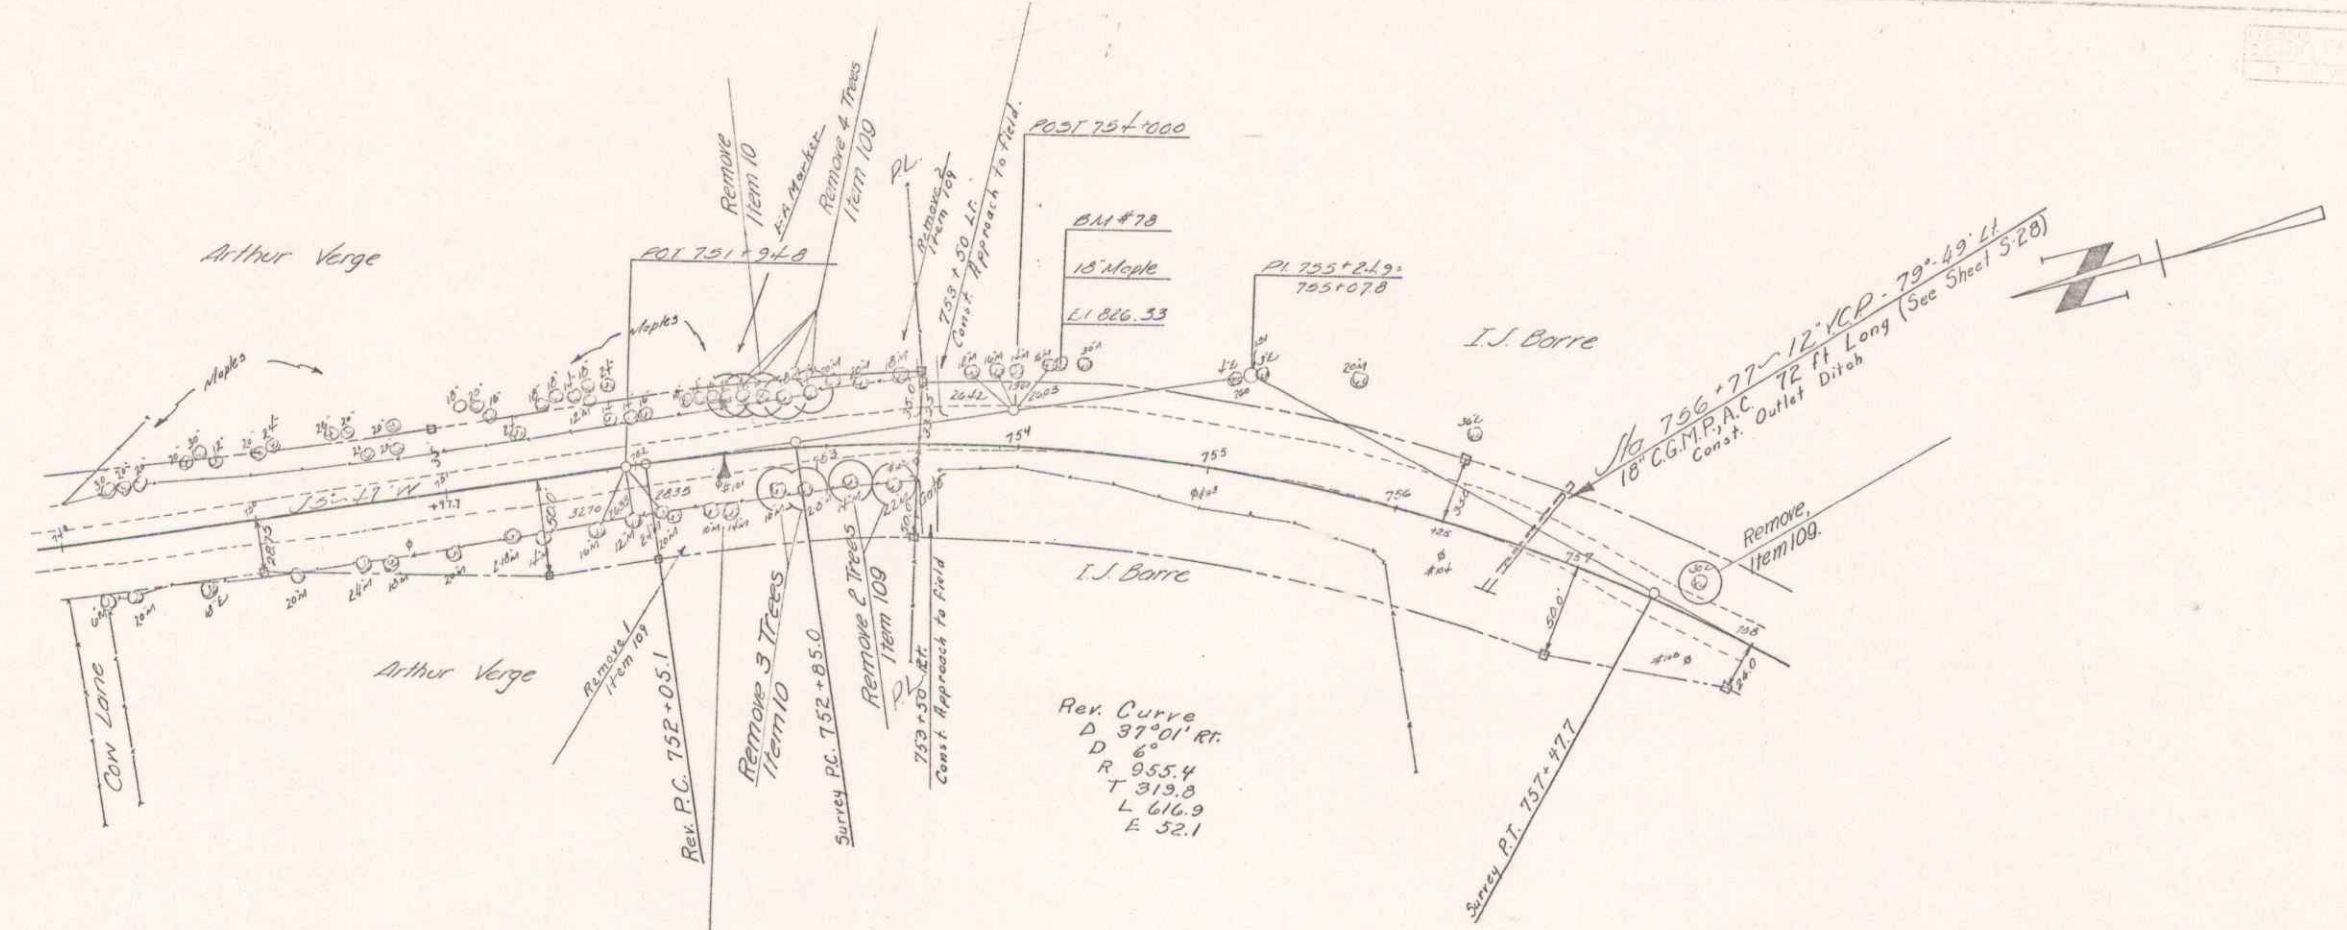

B 1/2" = 78 Spike in Root of 18' Maple 32' Lt Sta. 754+18 Elev. 826.33