


Parcel	Kind of Instrument	Date of Instrument	Grantor	Grantee	Recorded Book Page	Remarks
A	Q.C.D.	6-6-36	O.W. Bailey	St. of W.	1R 203	6-23-36
A'-B'-C'-D'-E'	Q.C.D.	6-25-36	Alphonse Bouffard	"	1R 219	7-2-36

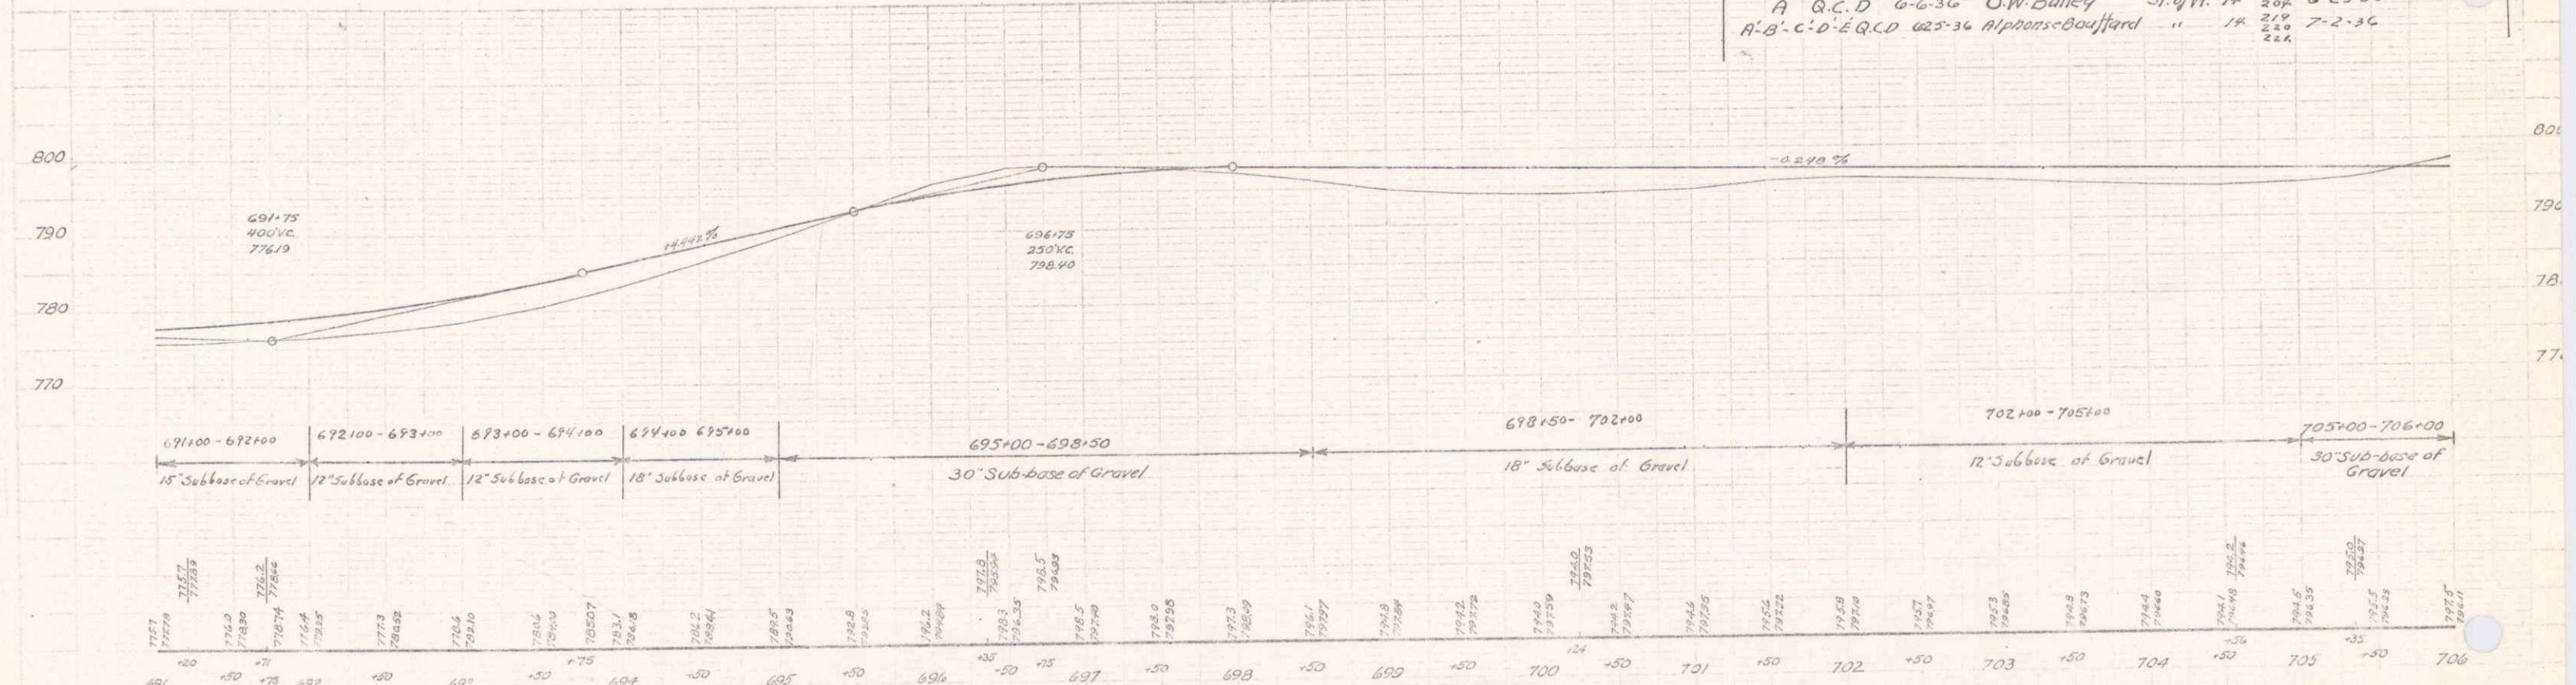

B.M. #71 Spike in Root of 24" Elm 35' RT of Sta 697+26 Elevation 797.33
 B.M. #72 Point Spot on Ledge 34' LT of Sta 704+83 Elevation 793.98