



PLAN  
 LEACH  
 12 31  
 12 31

LEACH  
 THOMAS  
 12 31  
 12 31

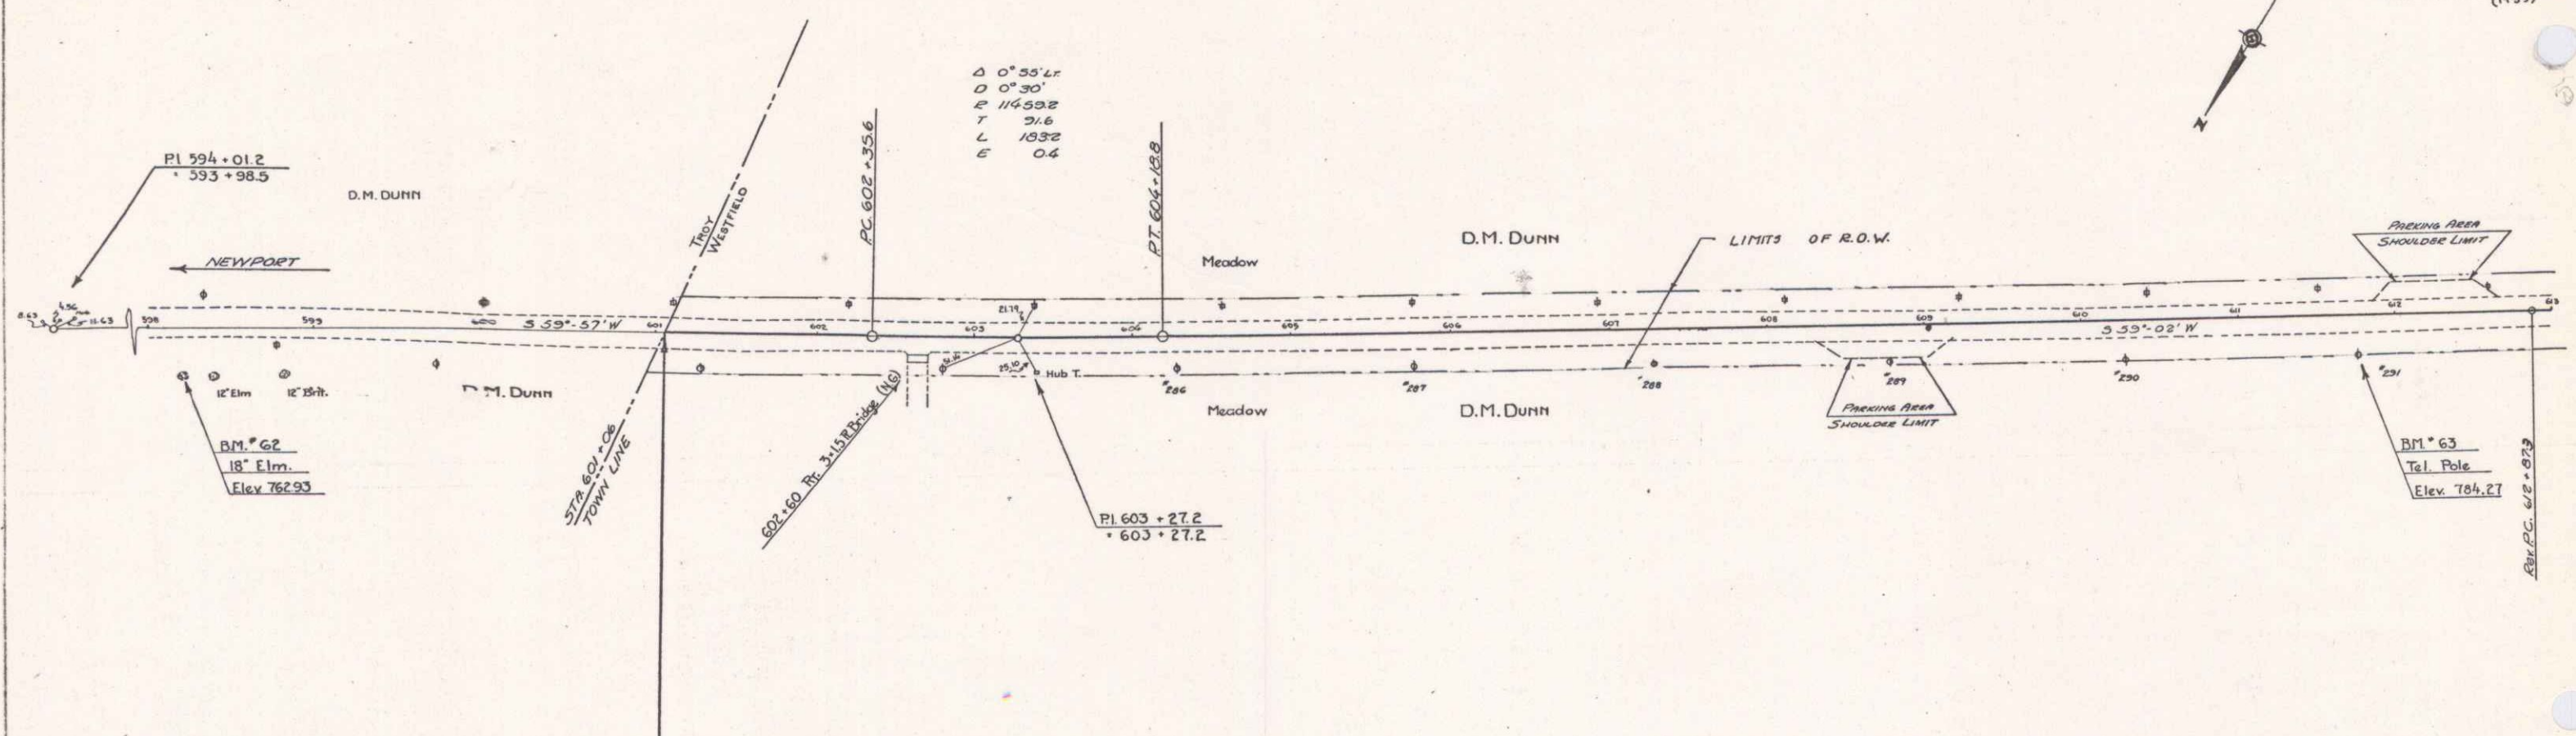

$\Delta$  0° 35' Lf  
 $\theta$  0° 30'  
 $R$  116.532  
 $T$  21.6  
 $L$  103.2  
 $E$  0.4

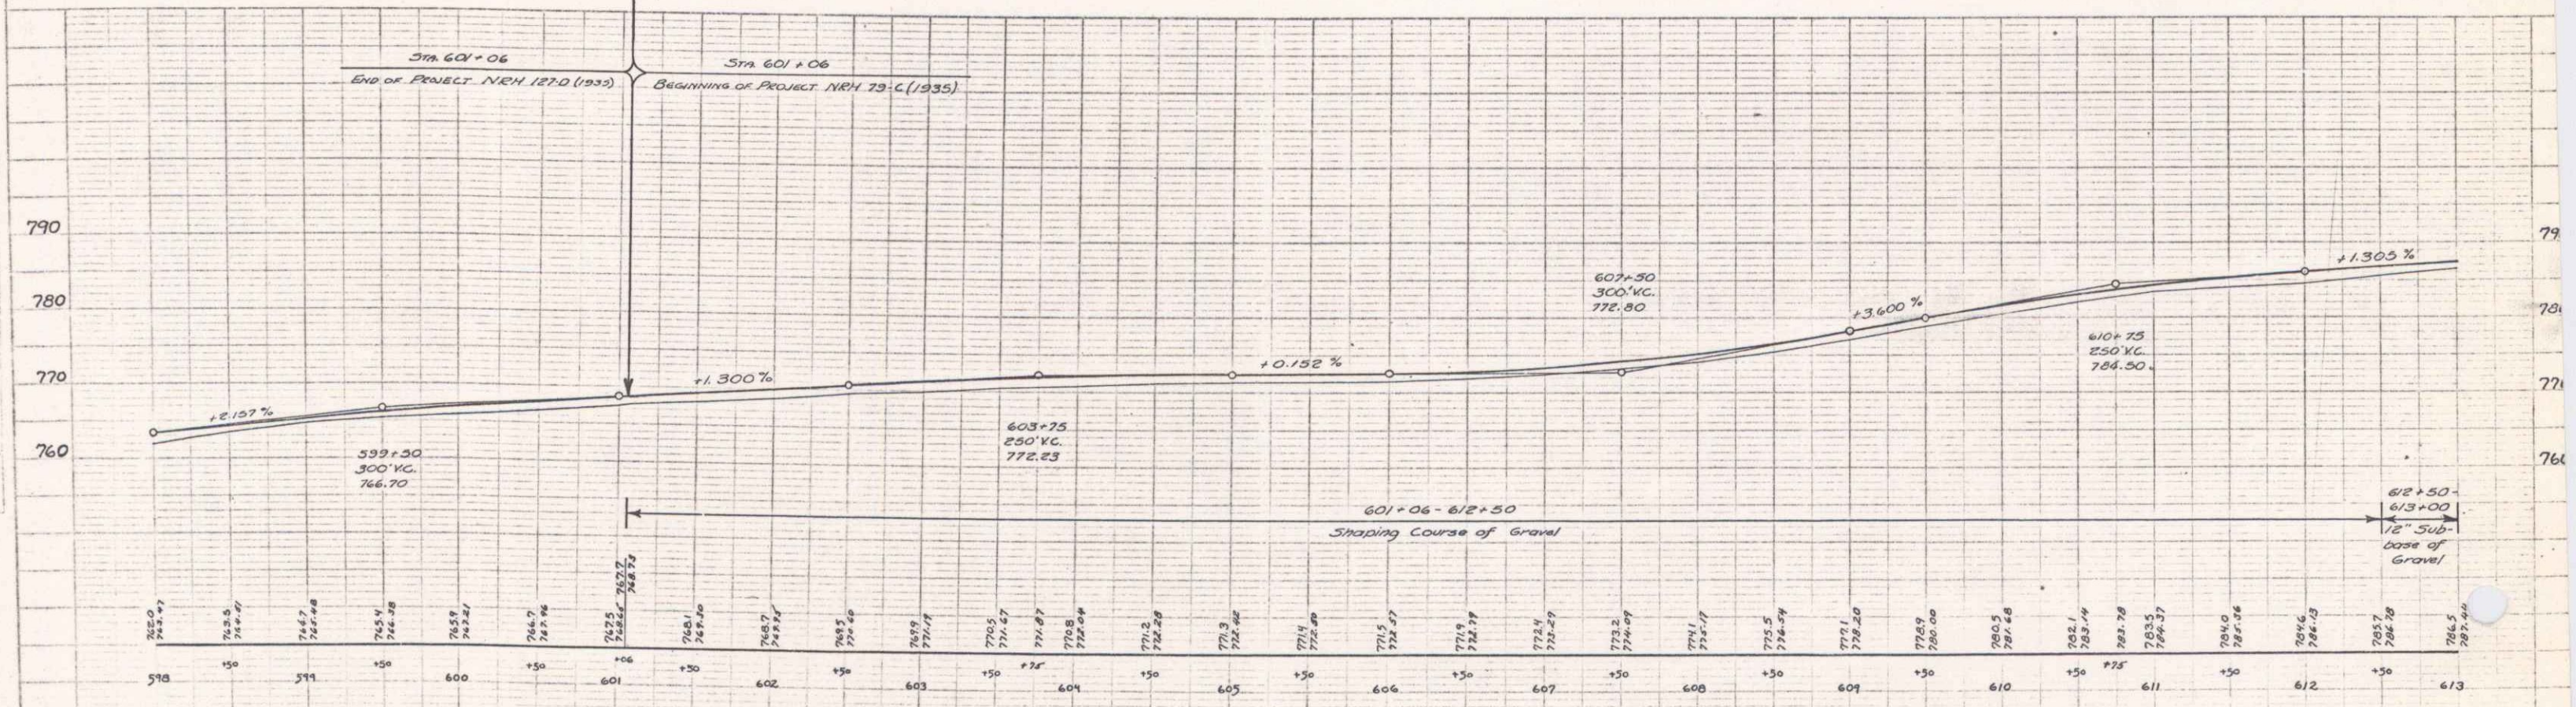

B.M. # 62 ~ SPIKE IN MUD 18" ELV ~ 28' W. STA. 598+25 ~ ELV. 762.93  
 B.M. # 63 ~ SPIKE IN TEL. POLE #211 ~ 25' W. STA. 611+77 ~ ELV. 704.27