



PLAN
NOTE: SEE SHEET 79-C(193) FOR PLAN LOCATIONS

LEACH
TRONAP
10-23

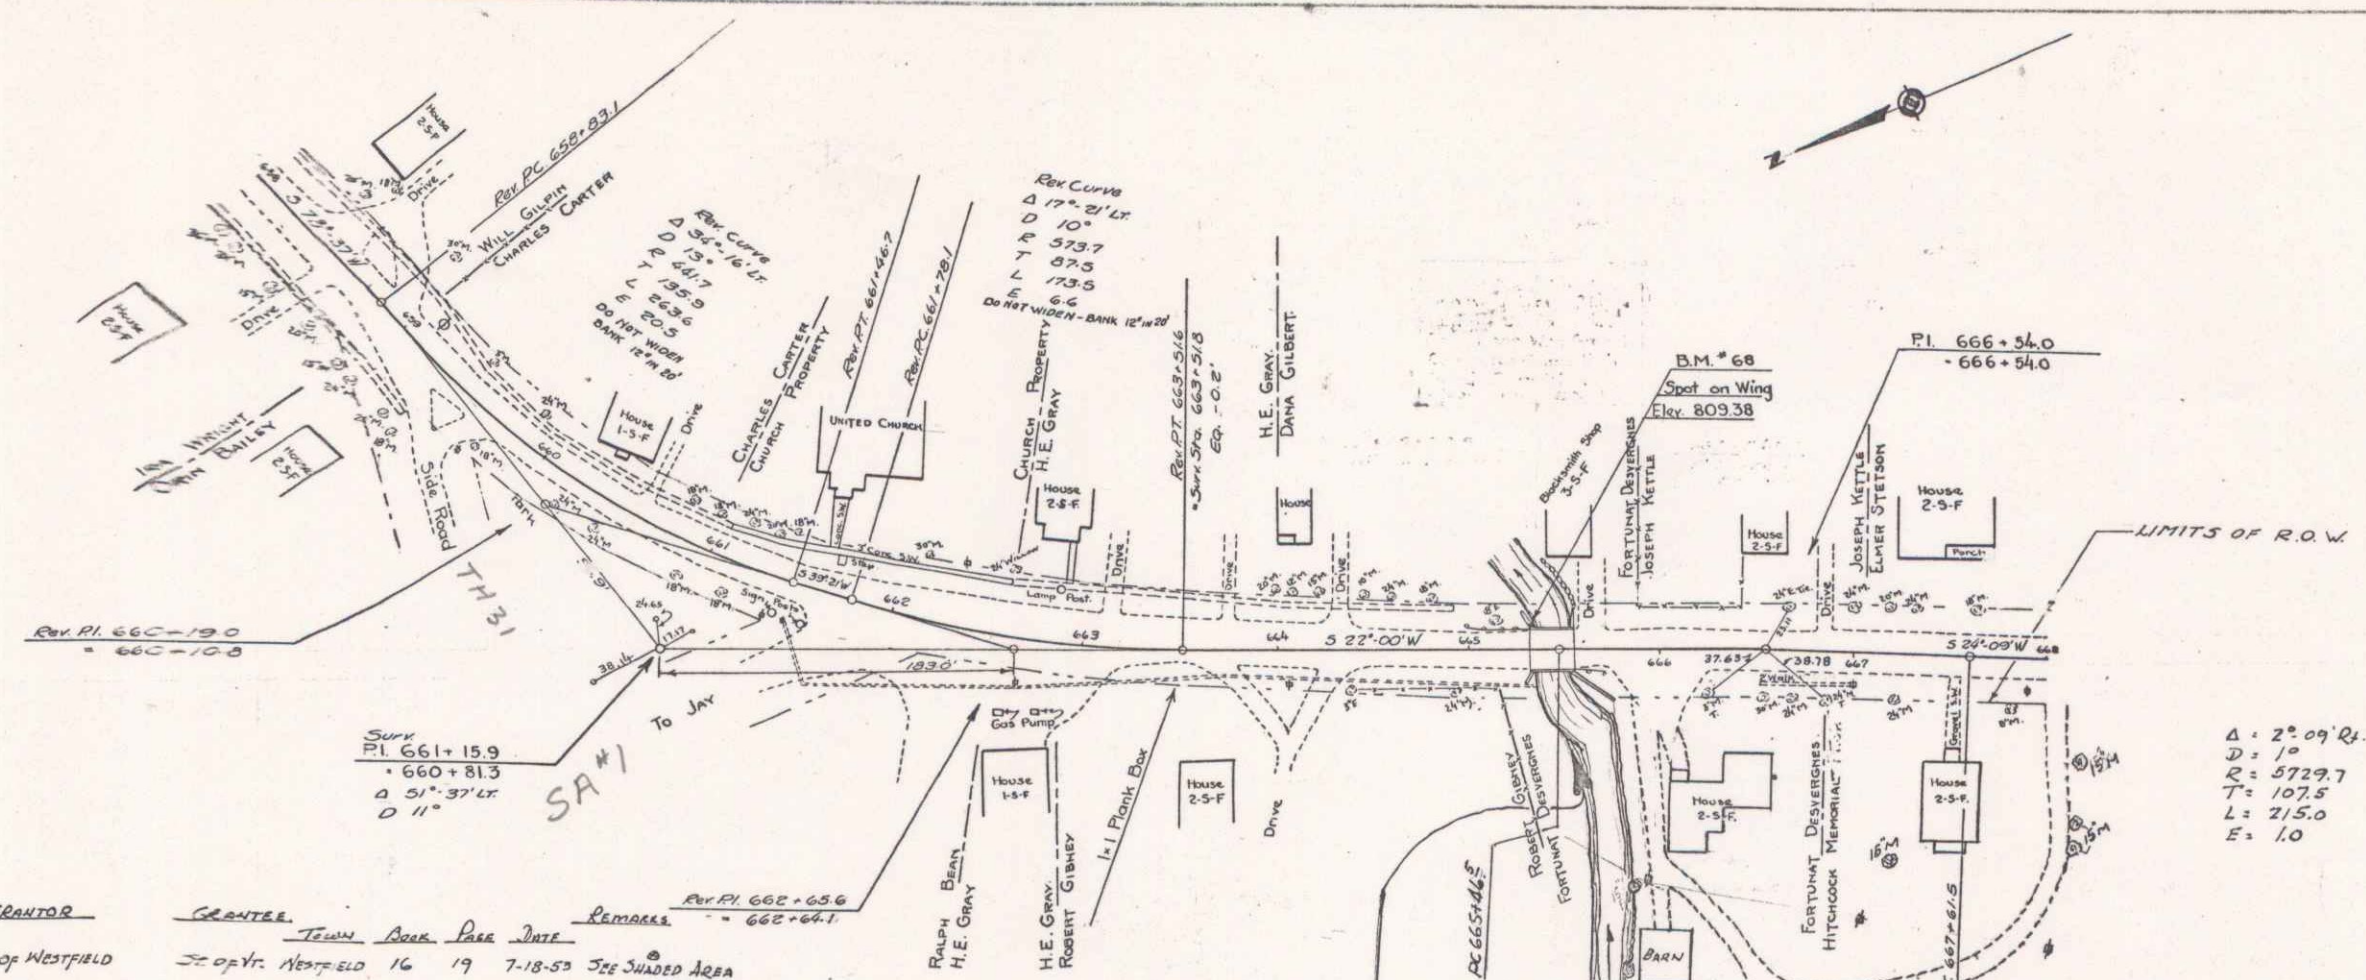

PARCEL	INSTRUMENT	DATE	GRANTOR	GRANTEE	TOWN	BOOK	PAGE	DATE	REMARKS
6	W0	7-1-53	TOWN OF WESTFIELD	J. E. GRAY	WESTFIELD	16	19	7-18-53	SEE SHARED AREA

Δ = 2° 09' R.
D = 10
E = 5729.7
T = 107.5
L = 215.0
E = 1.0

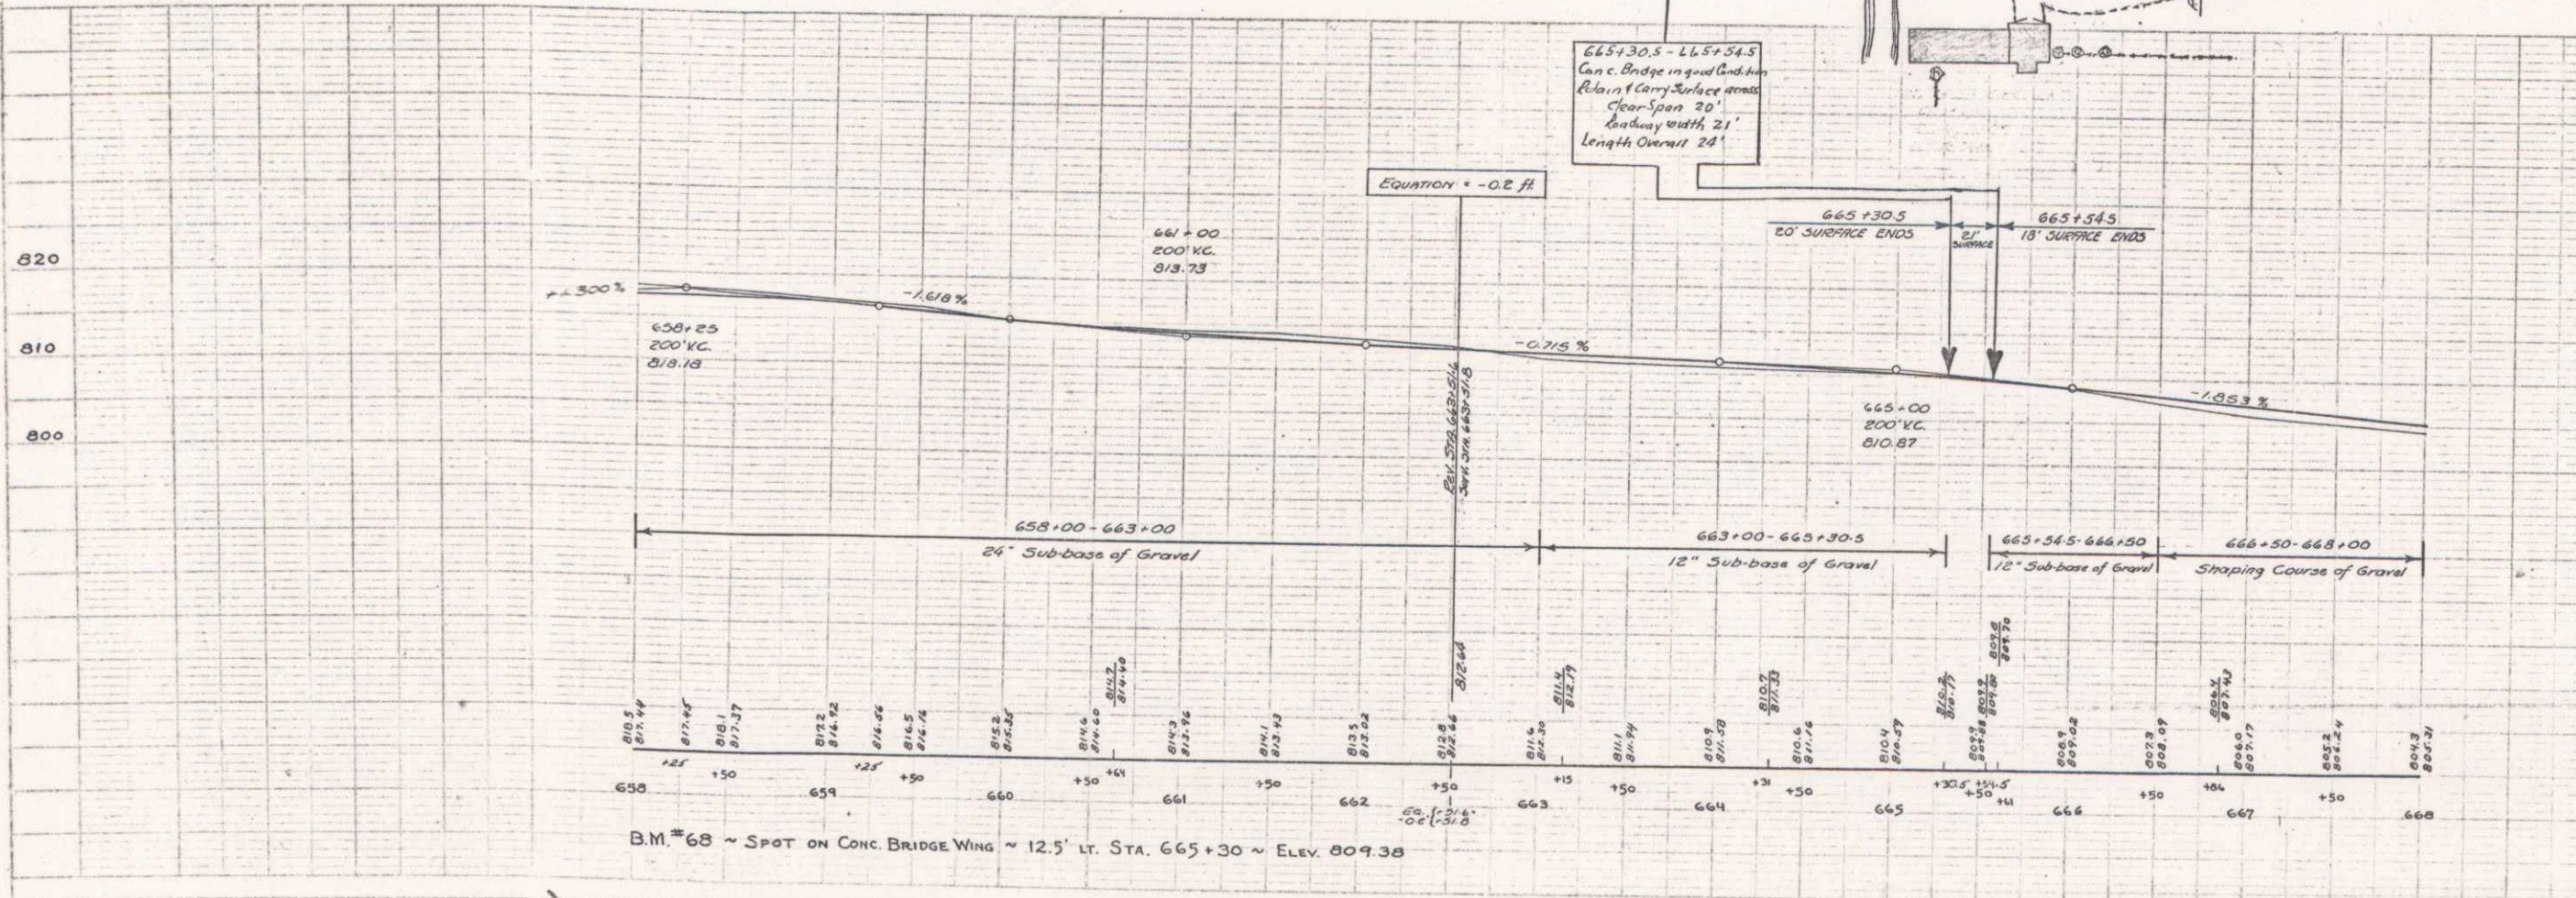

B.M. #68 ~ SPOT ON CONC. BRIDGE WING ~ 12.5' LT. STA. 665+30 ~ ELEV. 809.38

6