



W.P.H. STATE
 DIST. 127 E 1/4 16 6 43

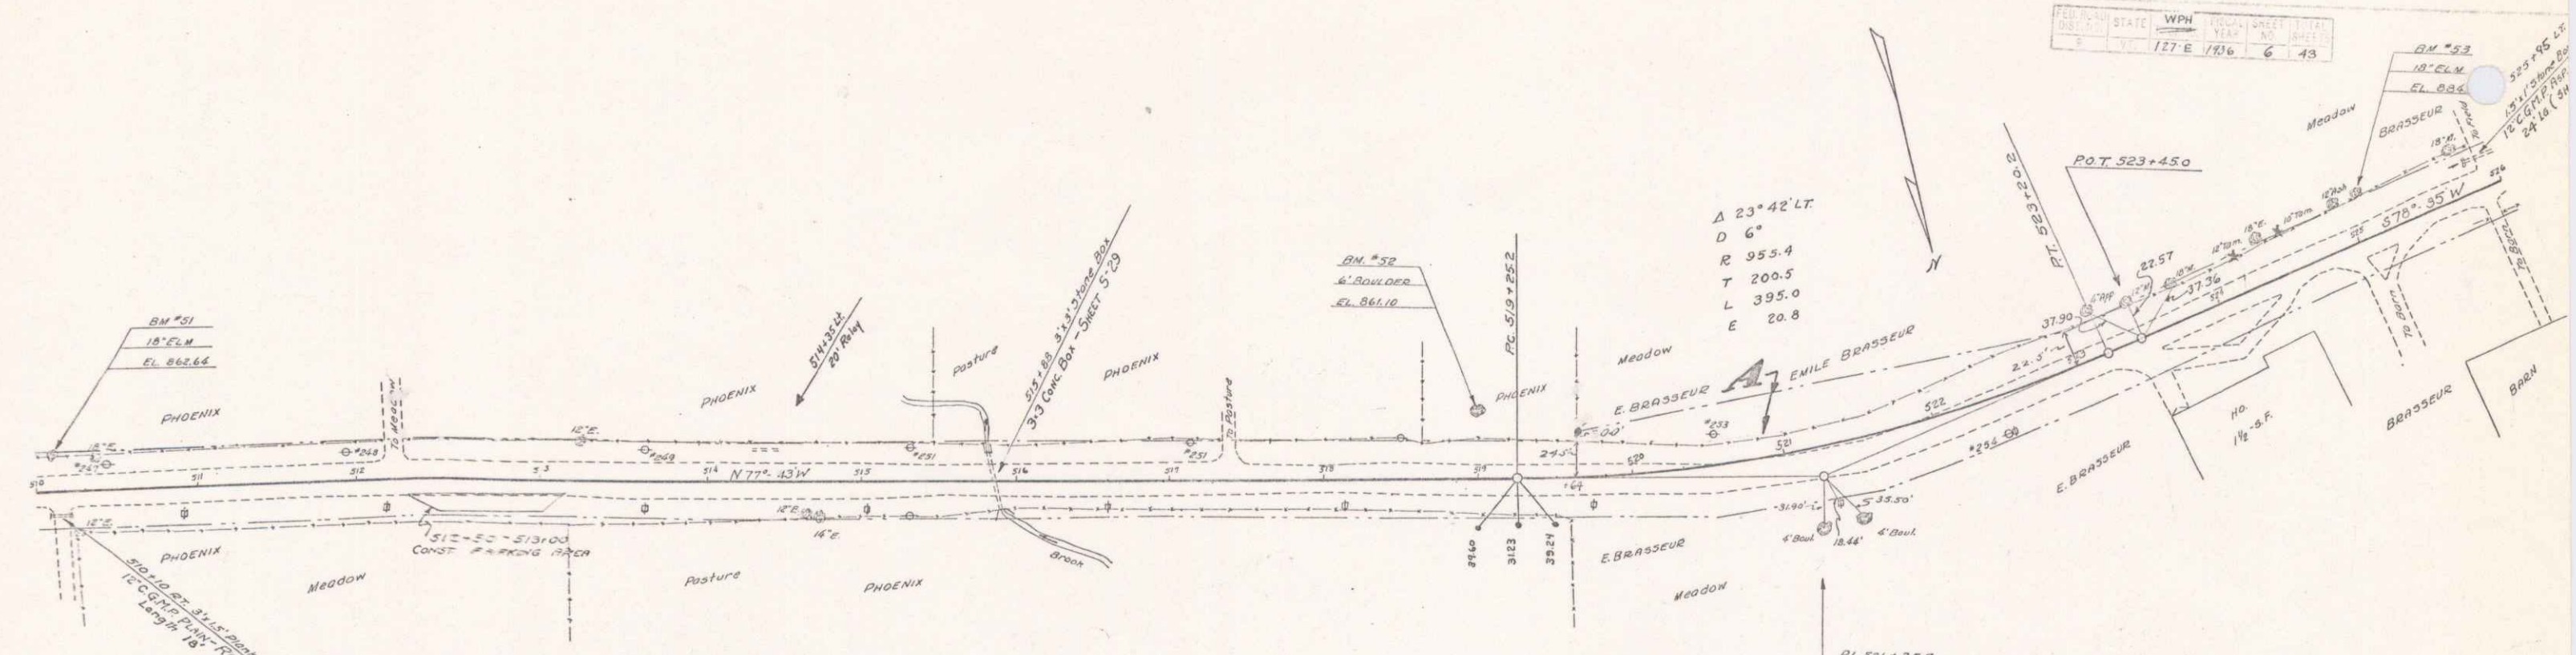

PARCEL INSTRUMENT	DATE	GRANTOR	GRANTEE	RECORDED	REMARKS
A & M.O.	10-4-34	EMILE BRASSEUR	STATE	740 Y	
A PARTIAL RELEASE	9-13-34	FED LAND BANK	STOFF	200 404 5	10-4-34
			"	28 406-7	10-4-34

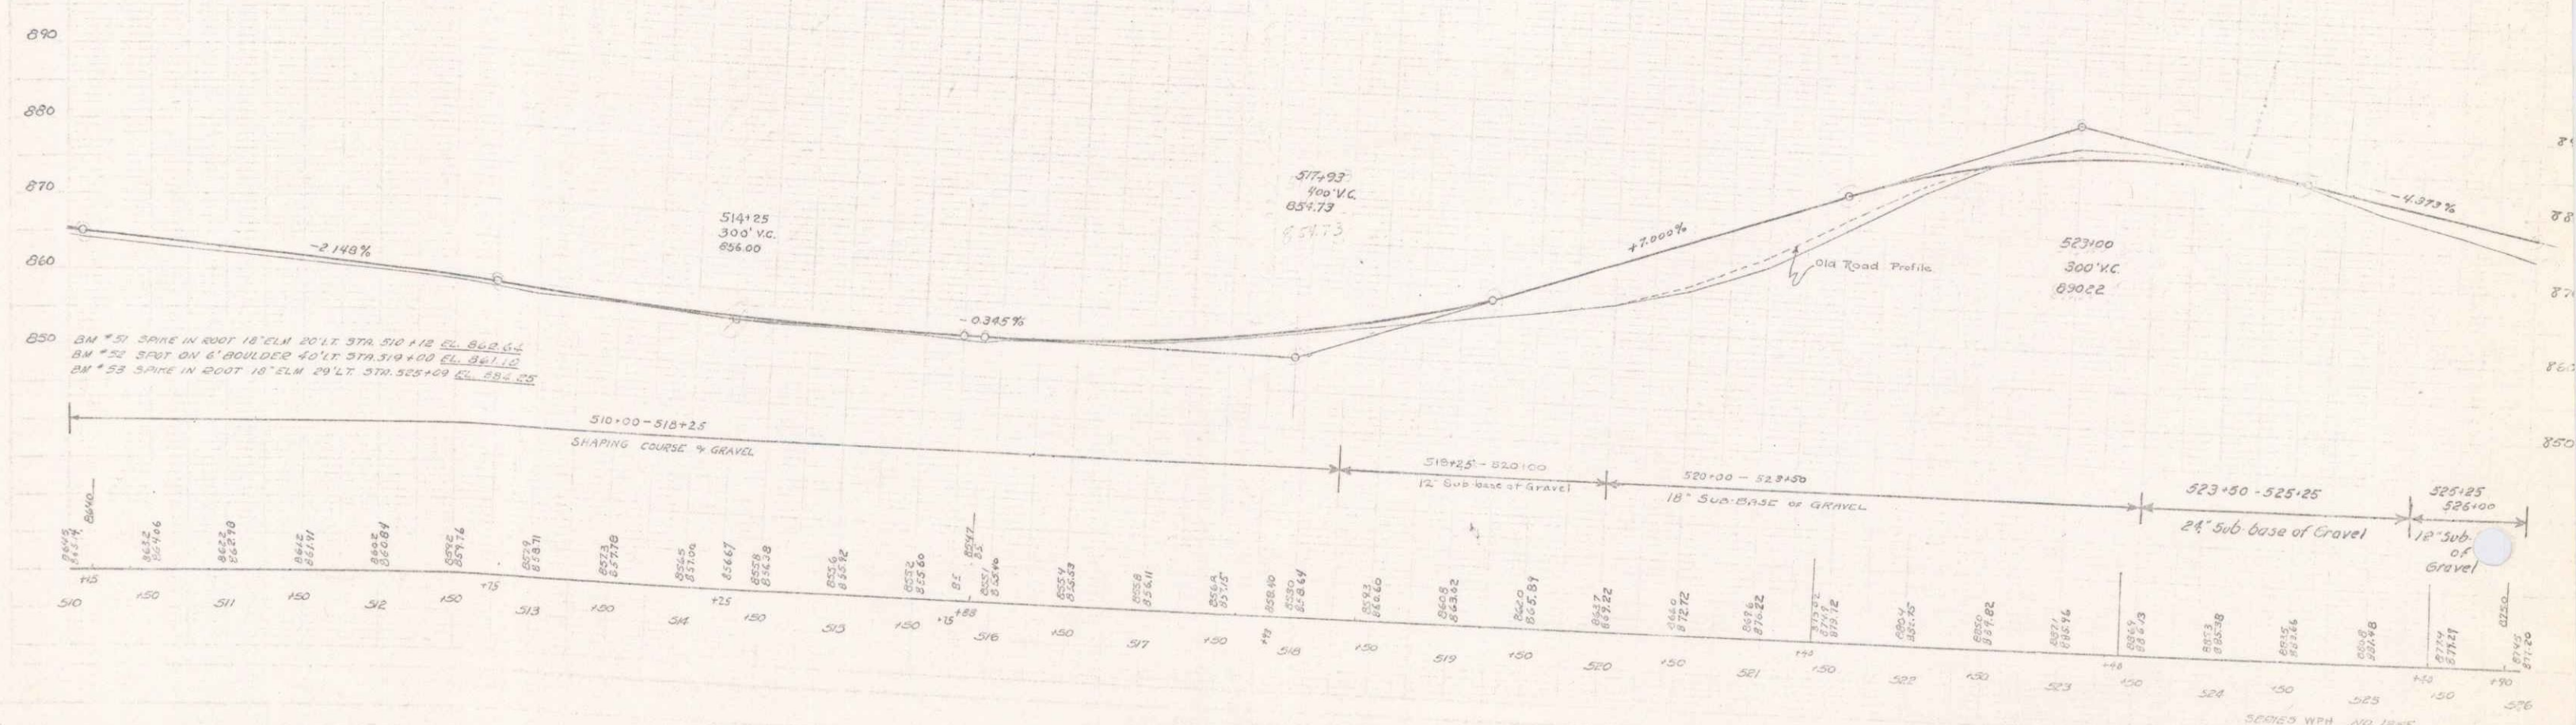

SECTED W.P.H. NO. 127 E
 SHEET 6 OF 43
 4