



511-216  
3.19  
75.77

FILE NO.	STATE	W.P.H.	SCALE	SHEET	OF
127-10	W.V.	1926	1" = 40'	8	43

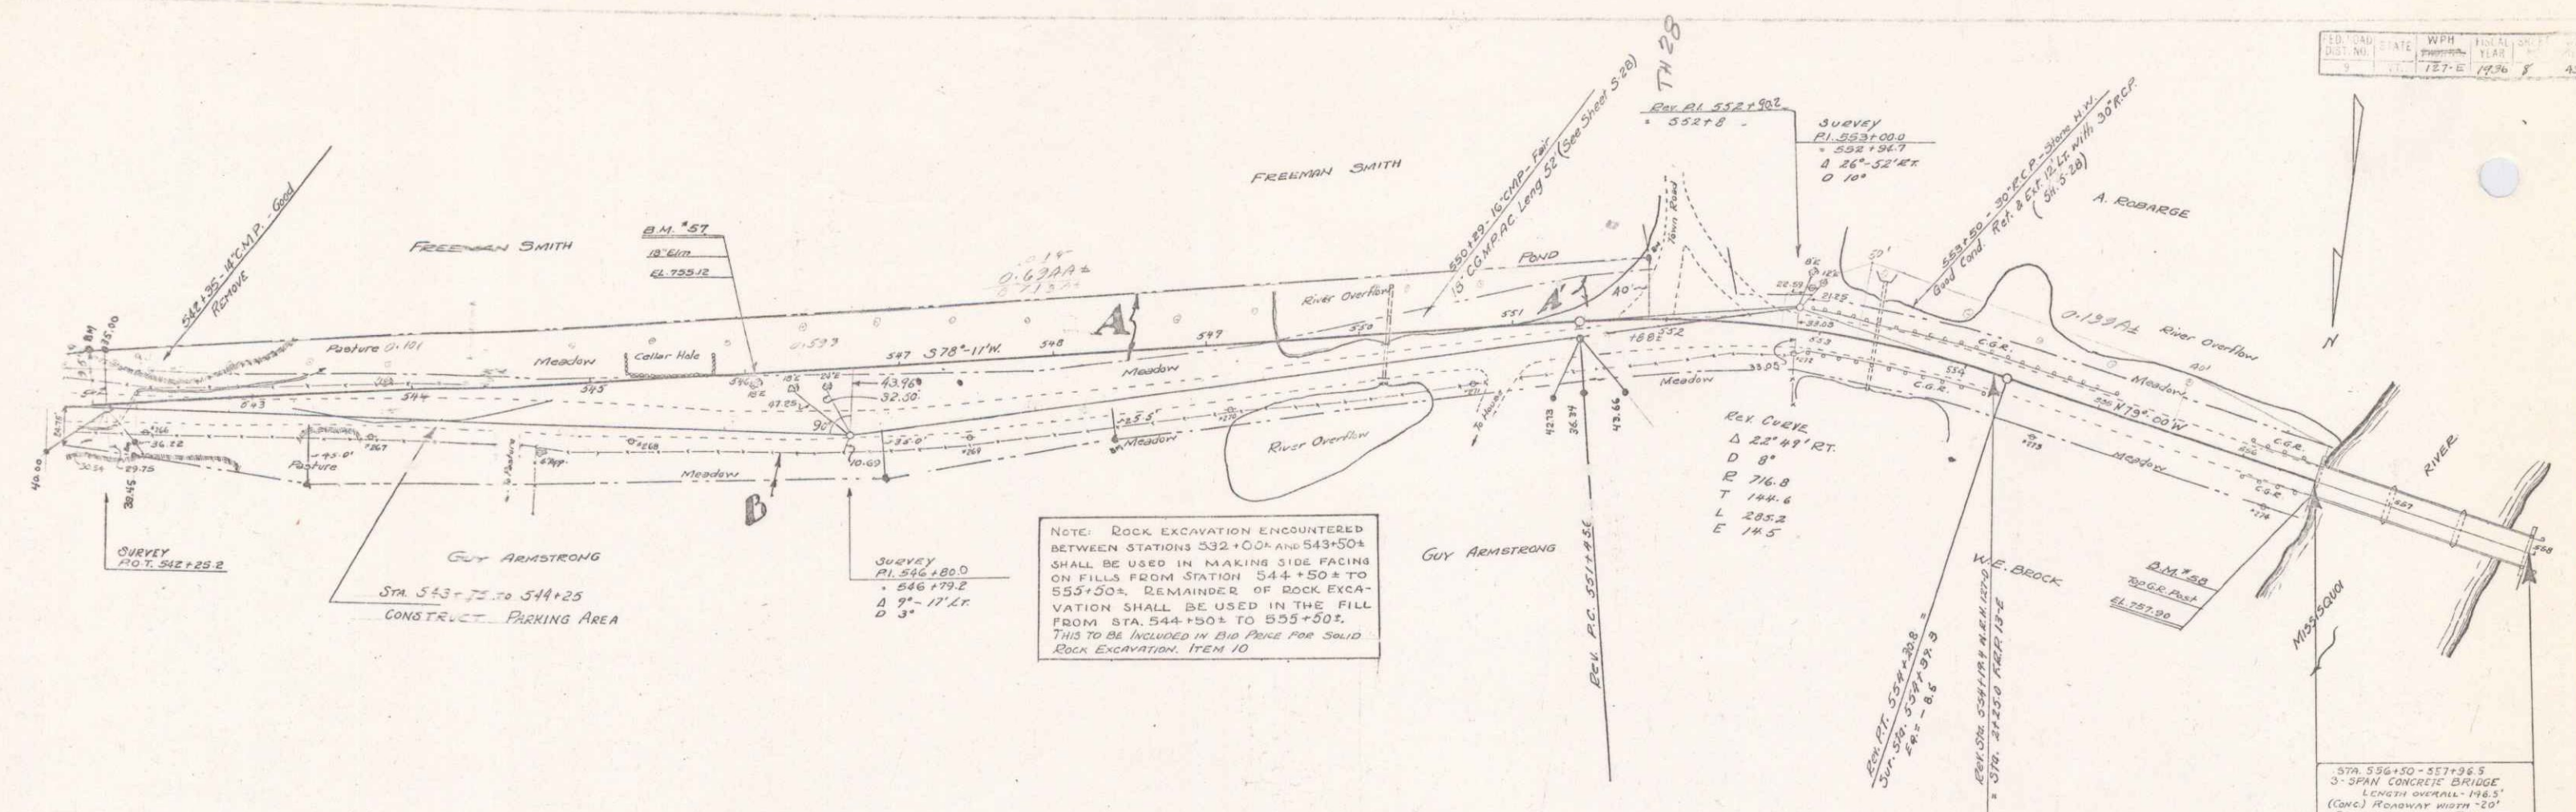

NOTE: ROCK EXCAVATION ENCOUNTERED BETWEEN STATIONS 532+00 AND 543+50+ SHALL BE USED IN MAKING SIDE FACING ON FILLS FROM STATION 544+50+ TO 553+50+. REMAINDER OF ROCK EXCAVATION SHALL BE USED IN THE FILL FROM STA. 544+50+ TO 553+50+. THIS TO BE INCLUDED IN BID PRICE FOR SOLID ROCK EXCAVATION, ITEM 10.

DISTRICT	INSTRUMENT	DATE	GRANTOR	GRANTEE	RECORDED BOOK PAGE	DATE	REMARKS
A	D.C.D.	11-6-35	FREEMAN SMITH	ST. OF VT.	28	511	11-6-35
B	M.D.	10-11-34	GUY ARMSTRONG	"	27	219	10-11-34
A'	M.D.	10-11-34	FREEMAN SMITH	"	27	220	10-11-34

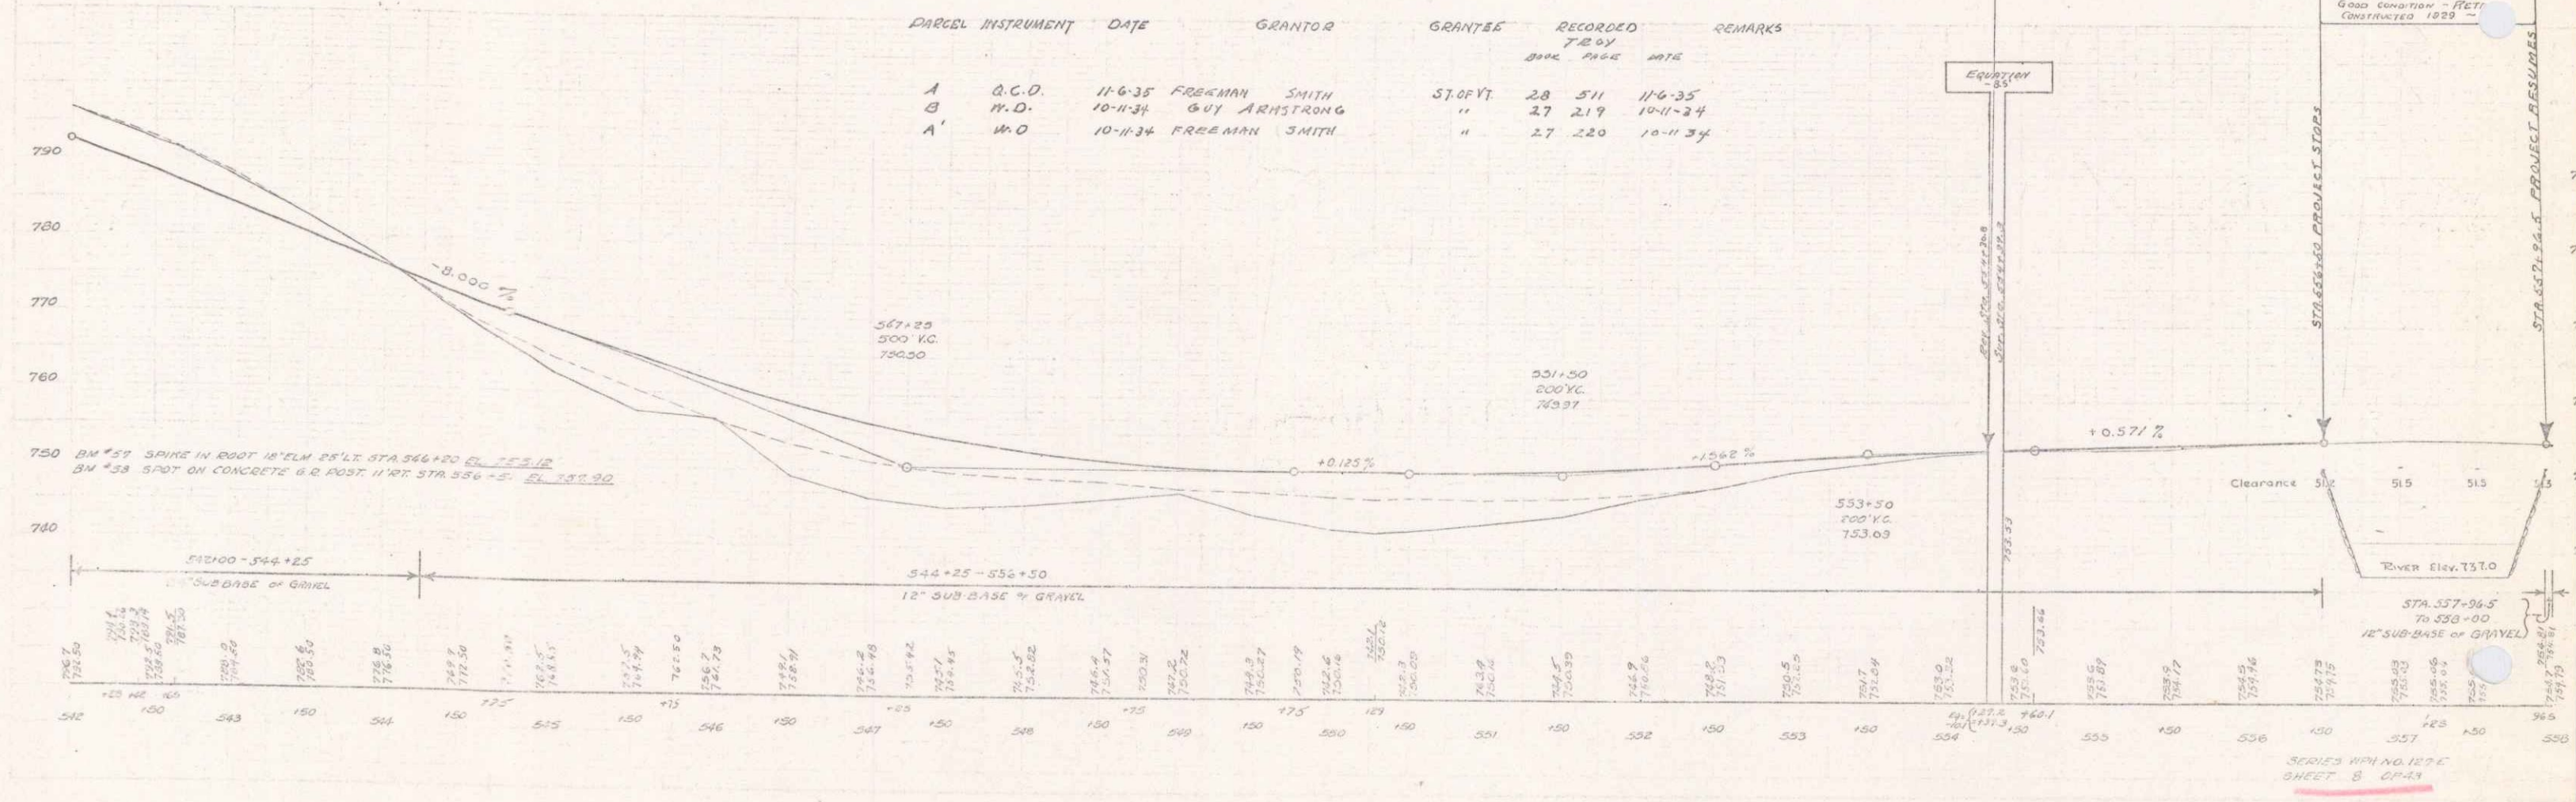

SERIES WITH NO. 127-K  
SHEET 8 OF 43

6