




ROUTE: VT100
 PROJECT: 1571 ST127L
 DATE: 01/01/1934
 TOWN: TROY
 PIN: 00R648

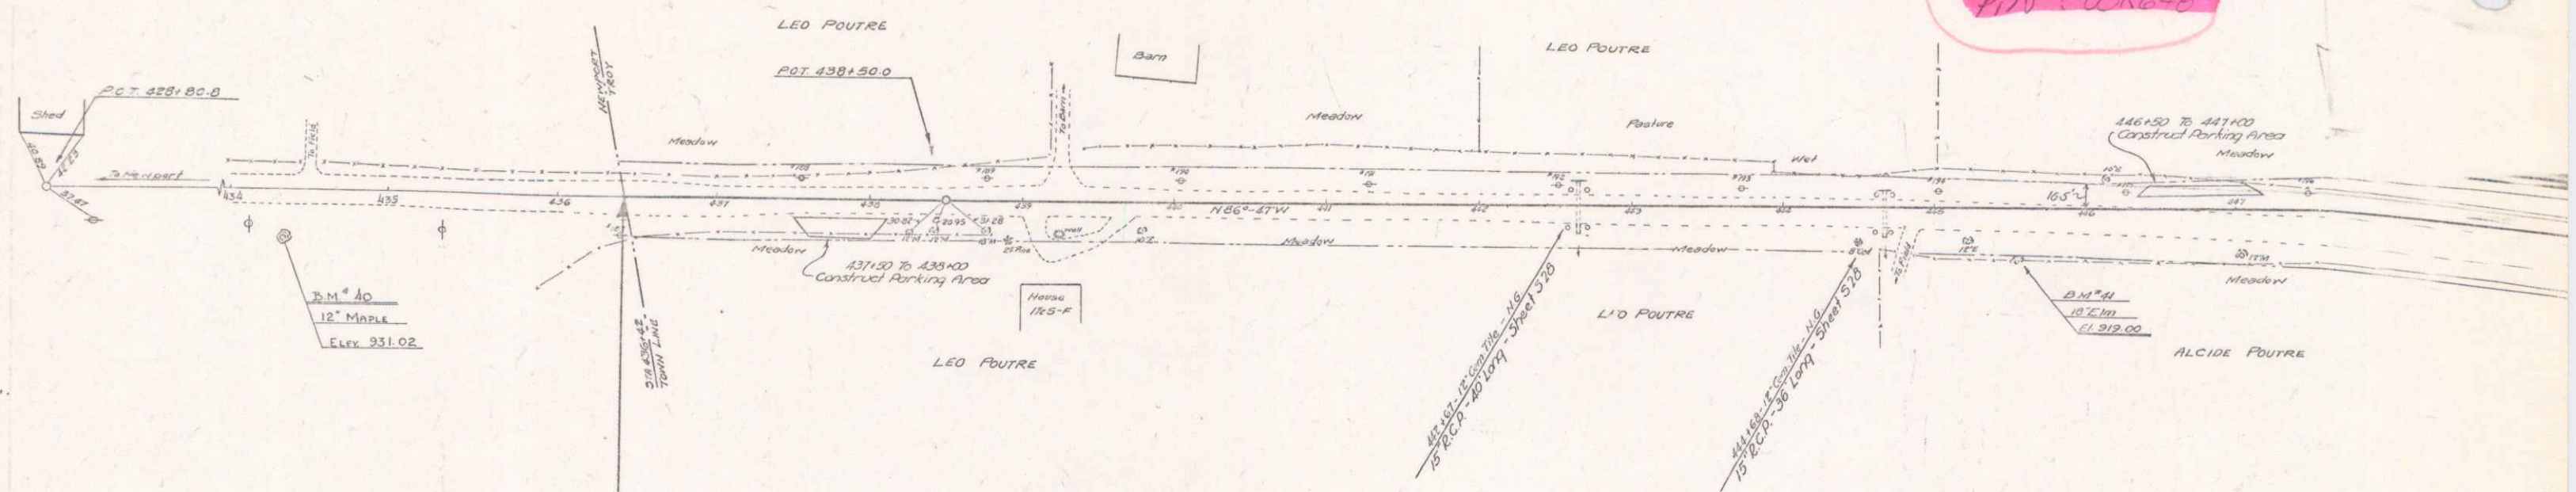

PARCEL	INSTRUMENT	DATE	GRANTOR	GRANTEE	RECORD'S
A	W.O.	8-9-34	ALCIDE & ALMEDA FOURTE	JJ OF VT	1801 PAGE 27 DATE 2/16 8-13

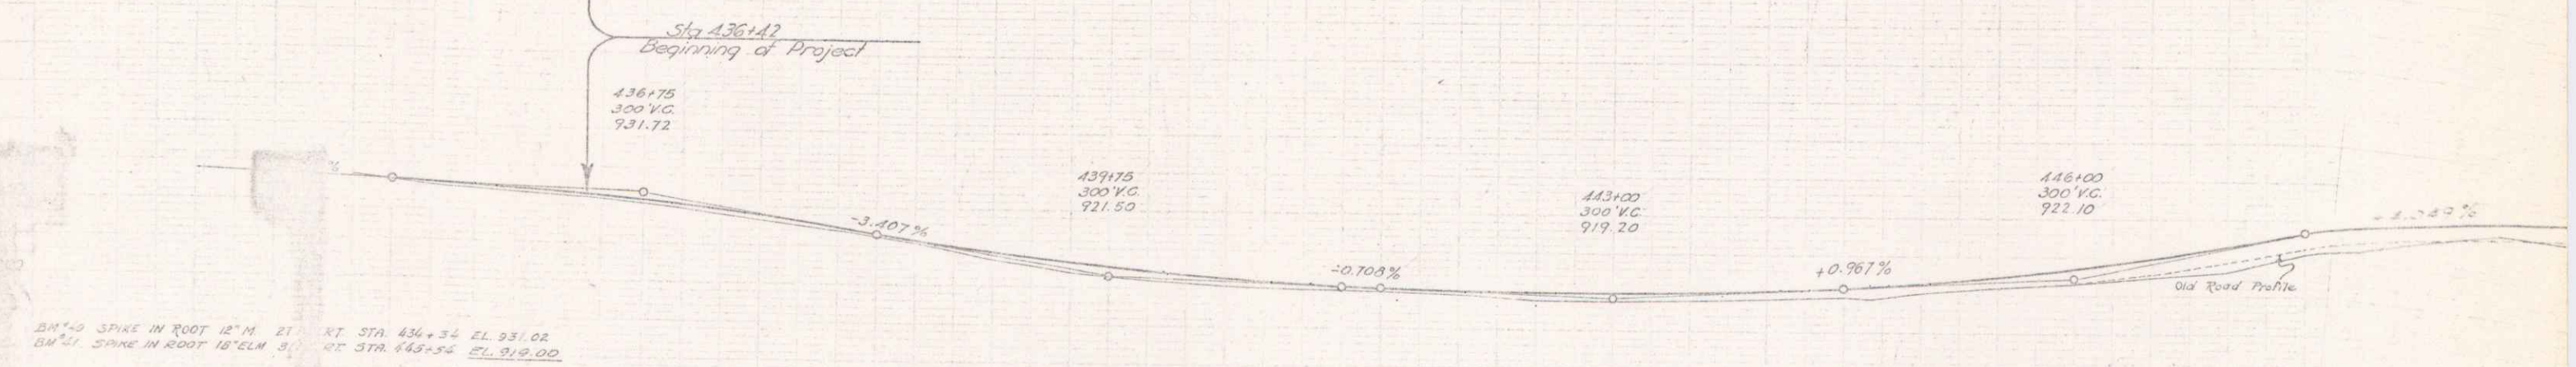

B.M. #10 SPIKE IN ROOT 12" M. 21 ST. STA. 436+34 EL. 931.02
 B.M. #11 SPIKE IN ROOT 18" ELM. 31 ST. STA. 443+54 EL. 919.00

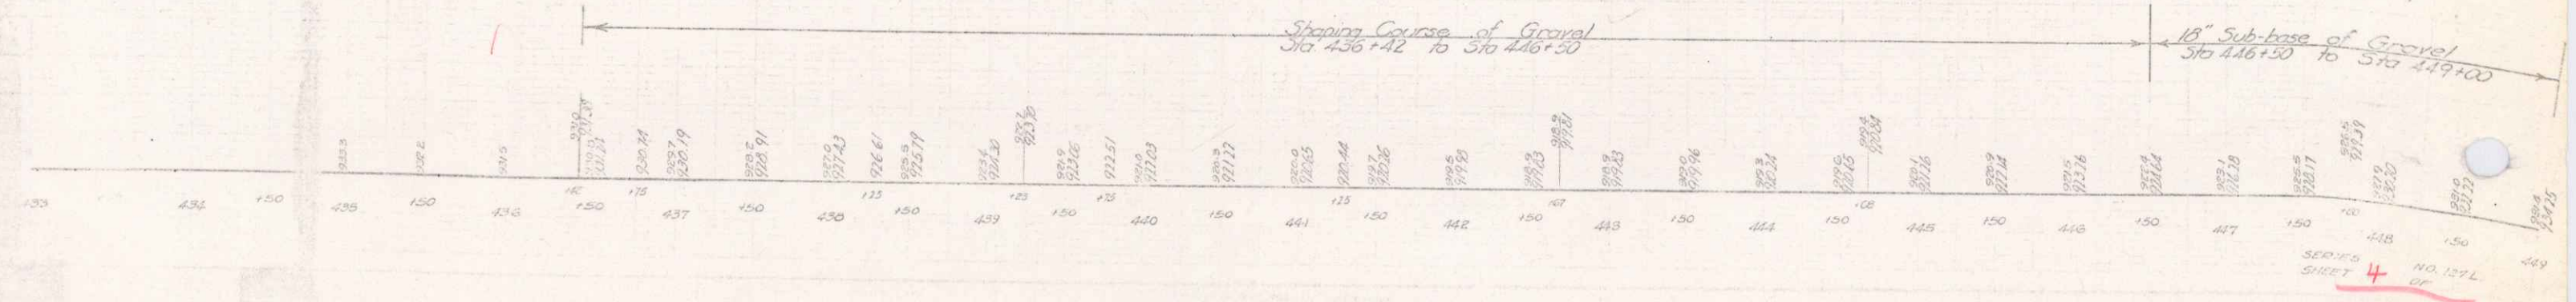

DIST. #9 Plans

SHEET 4 OF NO. 1571