


PARCEL	INSTRUMENT	DATE	GRANTOR	GRANTEE	RECORDED	REMARKS
ABCOEFG	W.D.	11-9-32	ALIDA TANGUAY	ST. OF VT.	300-12-3	2-28-32
A'G'	W.D.	11-9-32	C.E. SMITH	"	152	2-17-33
A"	W.D.	11-9-32	DURT RAYMO	"	398-7	

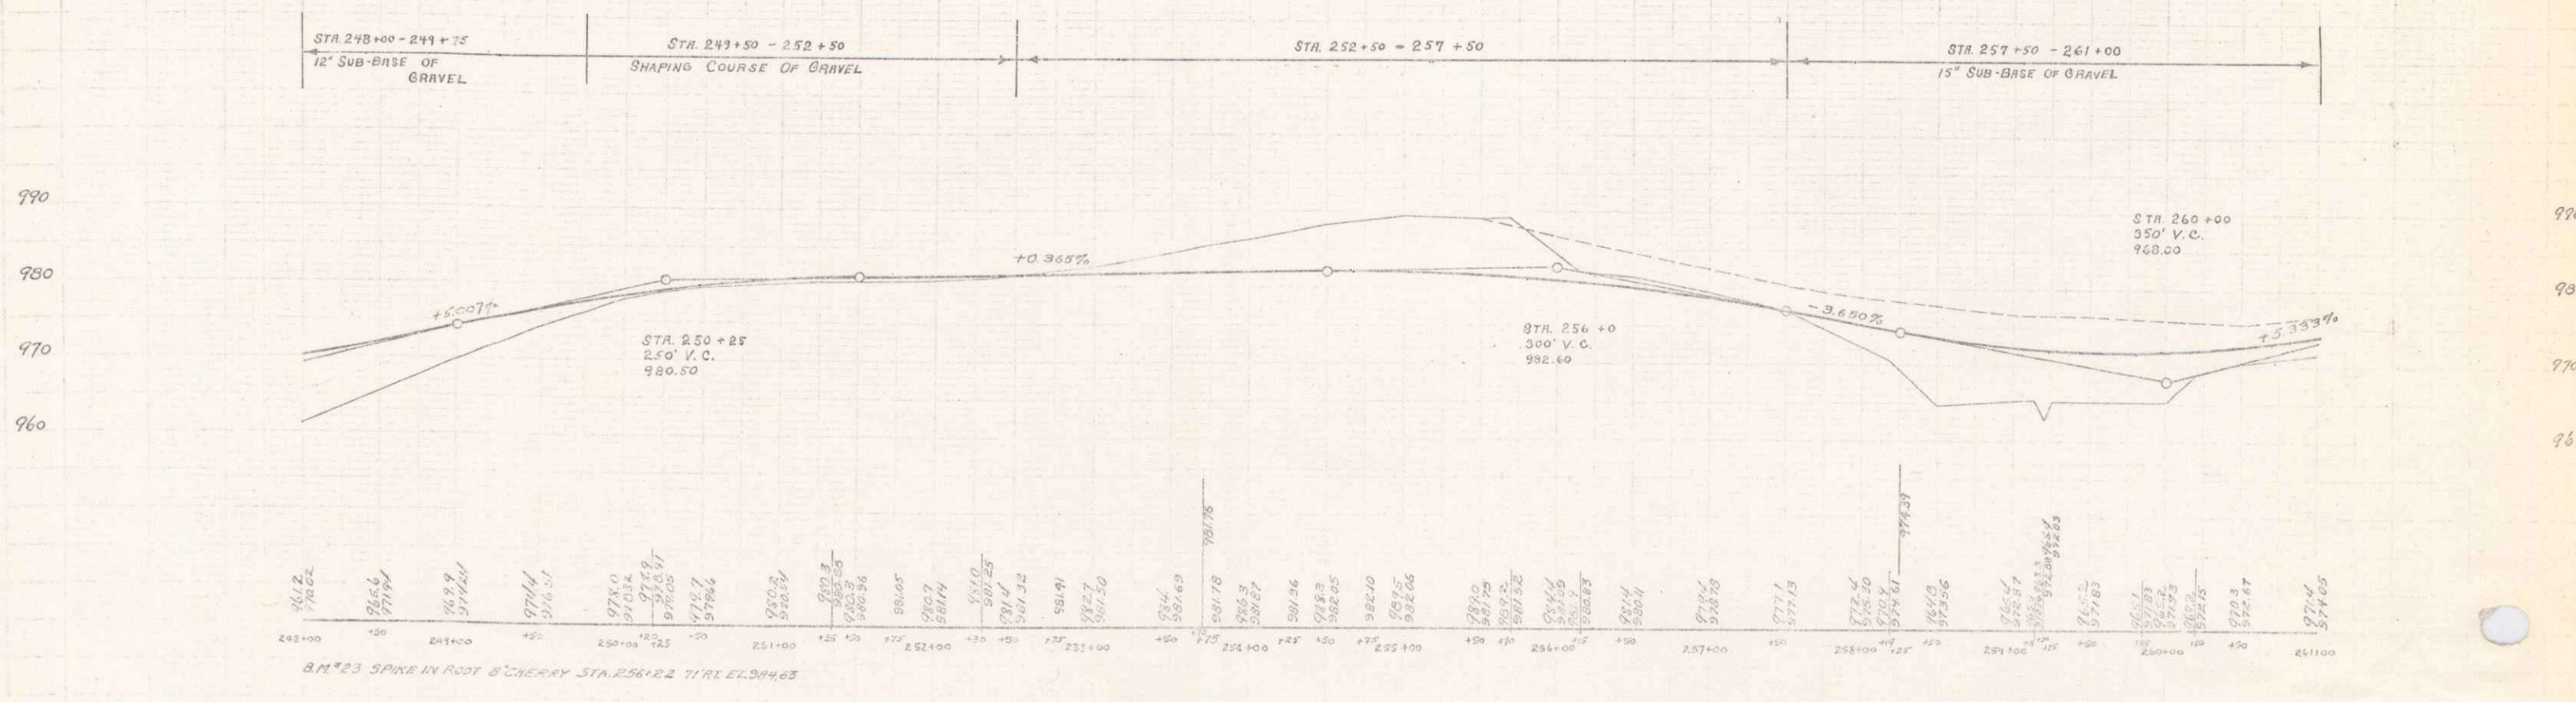

STATION	ELEVATION
248+00	961.2
248+10	962.1
248+20	963.0
248+30	964.0
248+40	965.0
248+50	966.0
248+60	967.0
248+70	968.0
248+80	969.0
248+90	970.0
249+00	971.0
249+10	972.0
249+20	973.0
249+30	974.0
249+40	975.0
249+50	976.0
249+60	977.0
249+70	978.0
249+80	979.0
249+90	980.0
250+00	981.0
250+10	982.0
250+20	983.0
250+30	984.0
250+40	985.0
250+50	986.0
250+60	987.0
250+70	988.0
250+80	989.0
250+90	990.0
251+00	991.0
251+10	992.0
251+20	993.0
251+30	994.0
251+40	995.0
251+50	996.0
251+60	997.0
251+70	998.0
251+80	999.0
251+90	1000.0
252+00	999.0
252+10	998.0
252+20	997.0
252+30	996.0
252+40	995.0
252+50	994.0
252+60	993.0
252+70	992.0
252+80	991.0
252+90	990.0
253+00	989.0
253+10	988.0
253+20	987.0
253+30	986.0
253+40	985.0
253+50	984.0
253+60	983.0
253+70	982.0
253+80	981.0
253+90	980.0
254+00	979.0
254+10	978.0
254+20	977.0
254+30	976.0
254+40	975.0
254+50	974.0
254+60	973.0
254+70	972.0
254+80	971.0
254+90	970.0
255+00	969.0
255+10	968.0
255+20	967.0
255+30	966.0
255+40	965.0
255+50	964.0
255+60	963.0
255+70	962.0
255+80	961.0
255+90	960.0
256+00	959.0
256+10	958.0
256+20	957.0
256+30	956.0
256+40	955.0
256+50	954.0
256+60	953.0
256+70	952.0
256+80	951.0
256+90	950.0
257+00	949.0
257+10	948.0
257+20	947.0
257+30	946.0
257+40	945.0
257+50	944.0
257+60	943.0
257+70	942.0
257+80	941.0
257+90	940.0
258+00	939.0
258+10	938.0
258+20	937.0
258+30	936.0
258+40	935.0
258+50	934.0
258+60	933.0
258+70	932.0
258+80	931.0
258+90	930.0
259+00	929.0
259+10	928.0
259+20	927.0
259+30	926.0
259+40	925.0
259+50	924.0
259+60	923.0
259+70	922.0
259+80	921.0
259+90	920.0
260+00	919.0
260+10	918.0
260+20	917.0
260+30	916.0
260+40	915.0
260+50	914.0
260+60	913.0
260+70	912.0
260+80	911.0
260+90	910.0
261+00	909.0