



ROAD STATE NO. 11, SHEET 10
 DIST. NO. 1118 NO. SHEETS
 DATE 6/27/1932 10 48

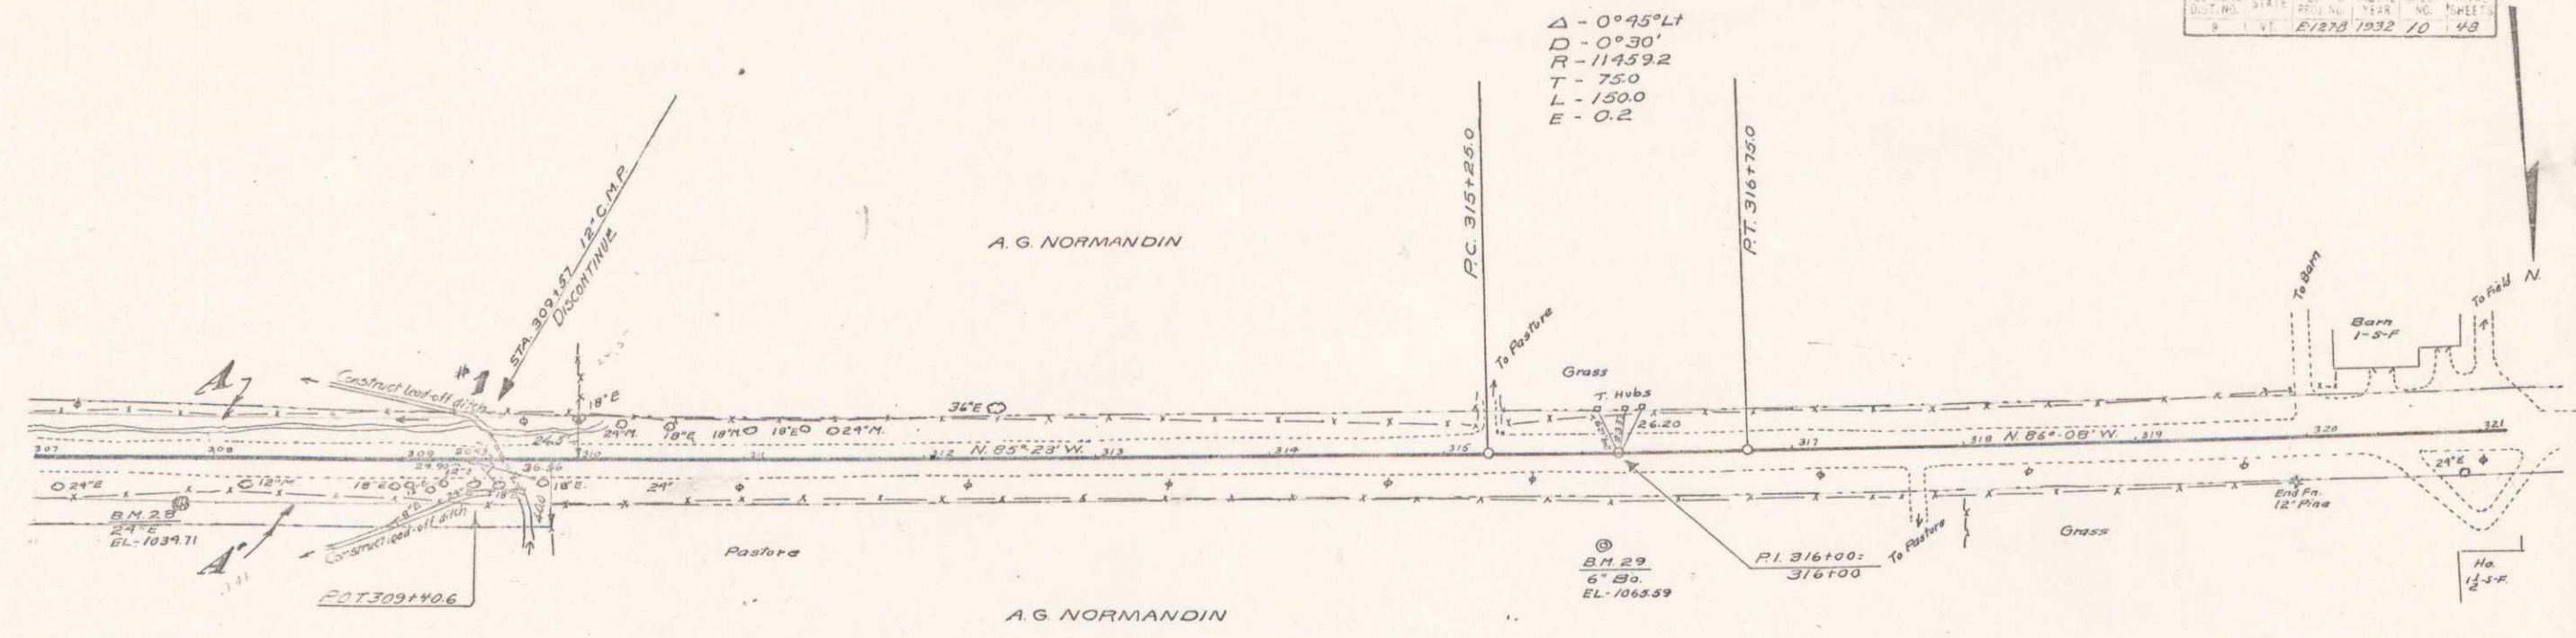

PARCEL	INSTRUMENT	DATE	GRANTOR	GRANTEE	RECORDED	REMARKS
A	C.C.D.	11-9-32	A. & IRENE NORMANDIN	ST. 301K	392	1-23-33 37A.
A'	C.C.D.	11-9-32	FRED BOWEN	-	394	1-23-33 38A+00

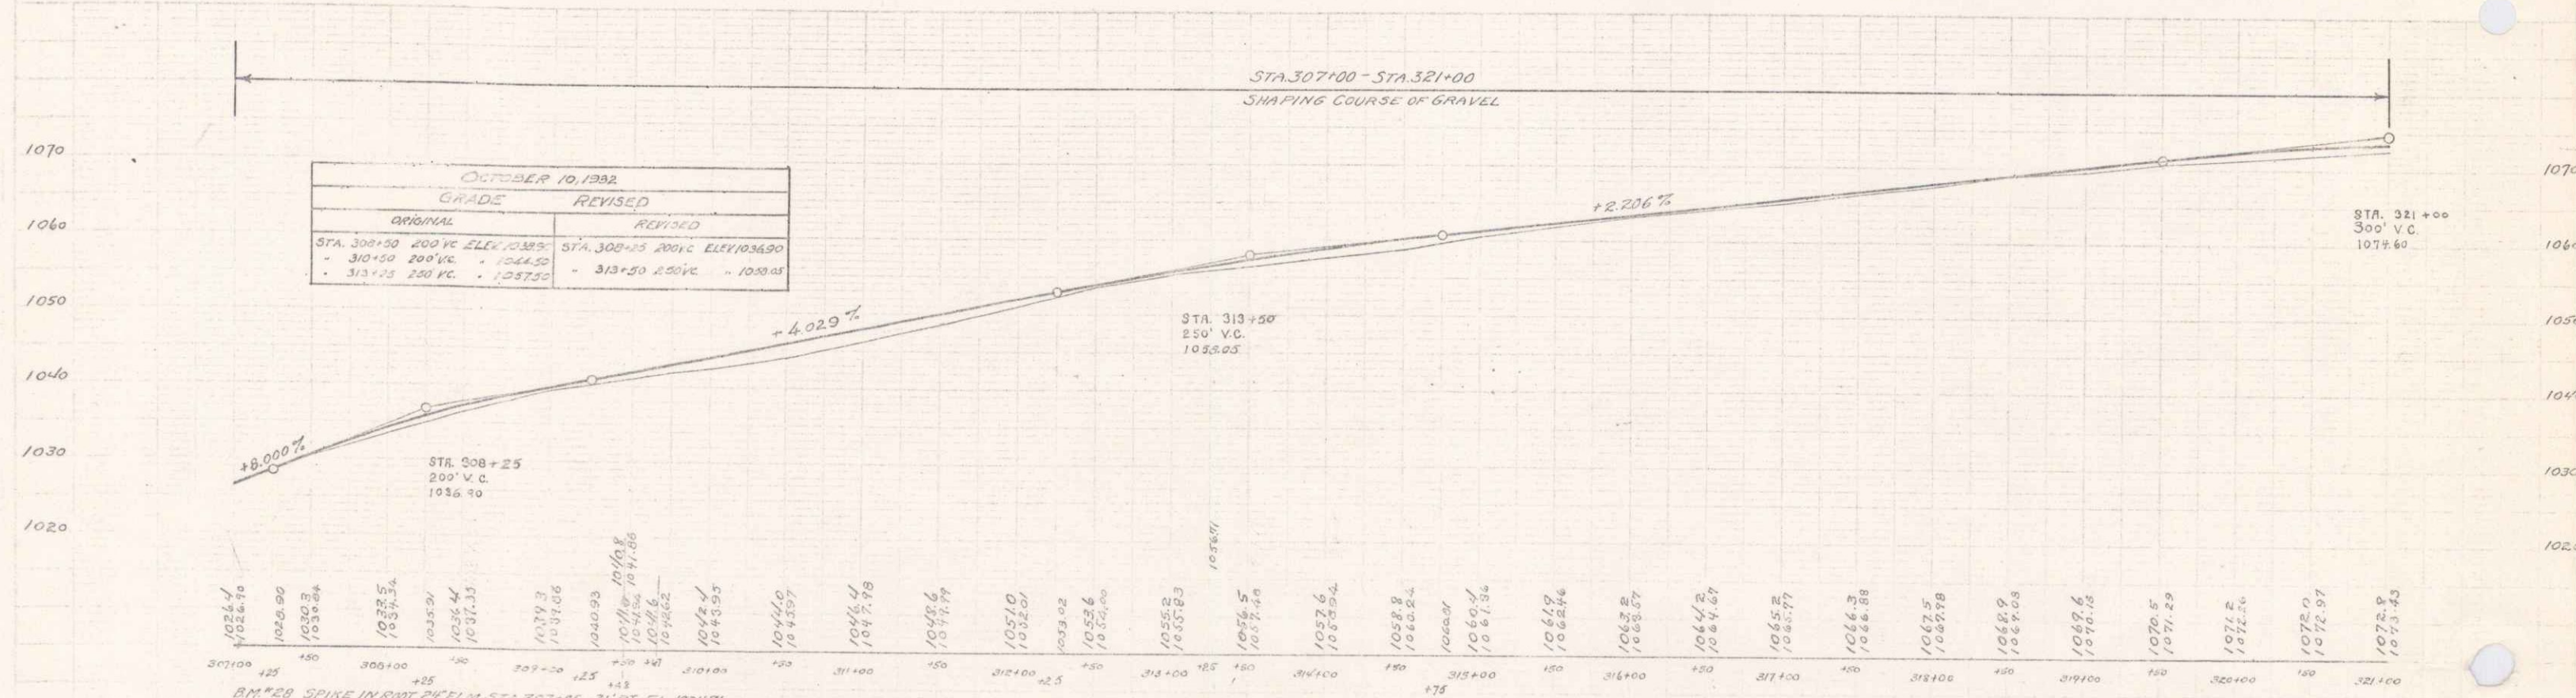

BM #28 SPIKE IN ROOT 24' ELM STA. 307+85 21' RT EL. 1034.71
 BM #29 SPIKE ON 6' BOULDER STA. 313+50 55' RT EL. 1035.59