


PARCEL	KIND OF INSTRUMENT	DATE OF INSTRUMENT	GRANTOR	GRANTEE	RECORDED
1120-01.5	W.D.	11-20-37	W.K. BARROWS	BARROWS	BOOK PAGE DATE
1121-13.5	W.D.	11-20-37	W.K. BARROWS	BARROWS	BOOK PAGE DATE
1122-37.2	W.D.	11-20-37	W.K. BARROWS	BARROWS	BOOK PAGE DATE
1123-14.5	W.D.	11-20-37	W.K. BARROWS	BARROWS	BOOK PAGE DATE
1124-100	W.D.	11-20-37	W.K. BARROWS	BARROWS	BOOK PAGE DATE
1125-100	W.D.	11-20-37	W.K. BARROWS	BARROWS	BOOK PAGE DATE

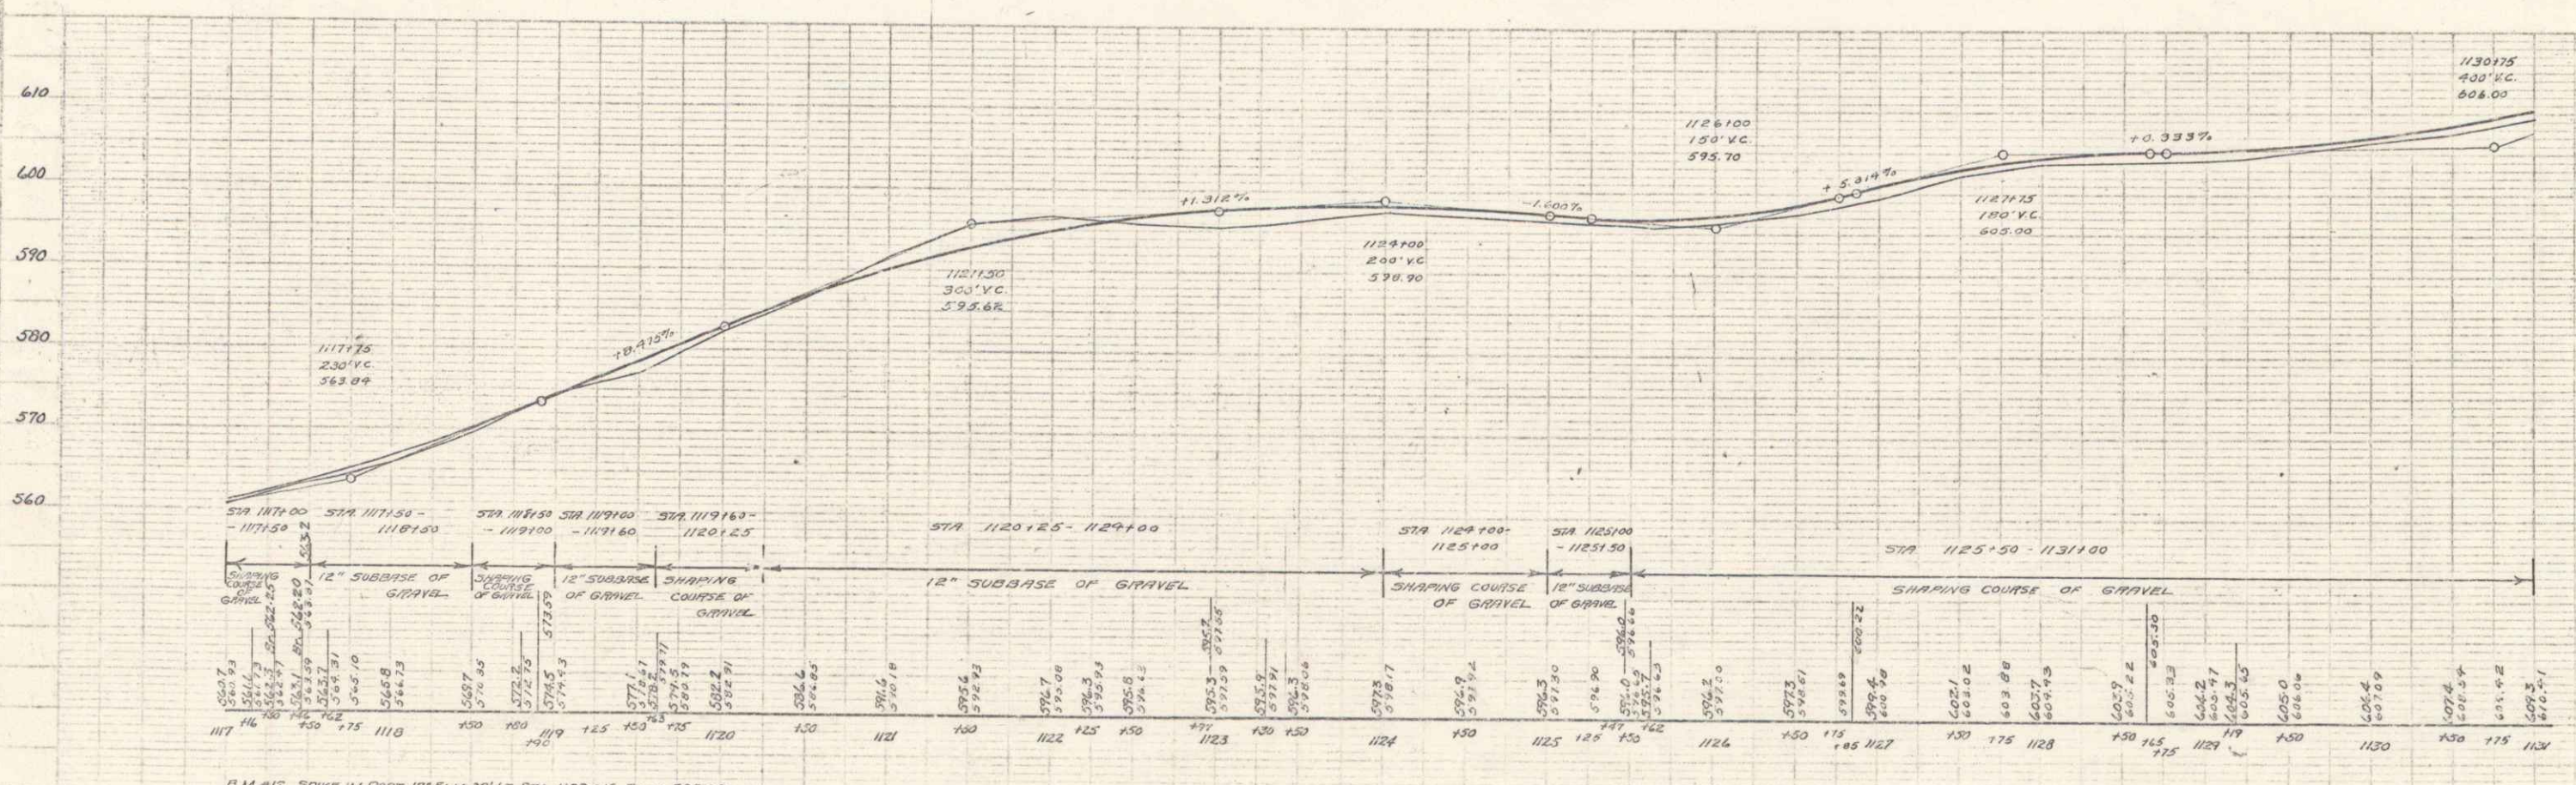

B.M. #12 SPIKE IN ROOT 12" ELM 32' LT STA 1123+15 ELEV. 595.33
 B.M. #11 SPIKE IN ROOT 24" YELLOW BIRCH 16' RT STA 1129+89 ELEV. 604.08