
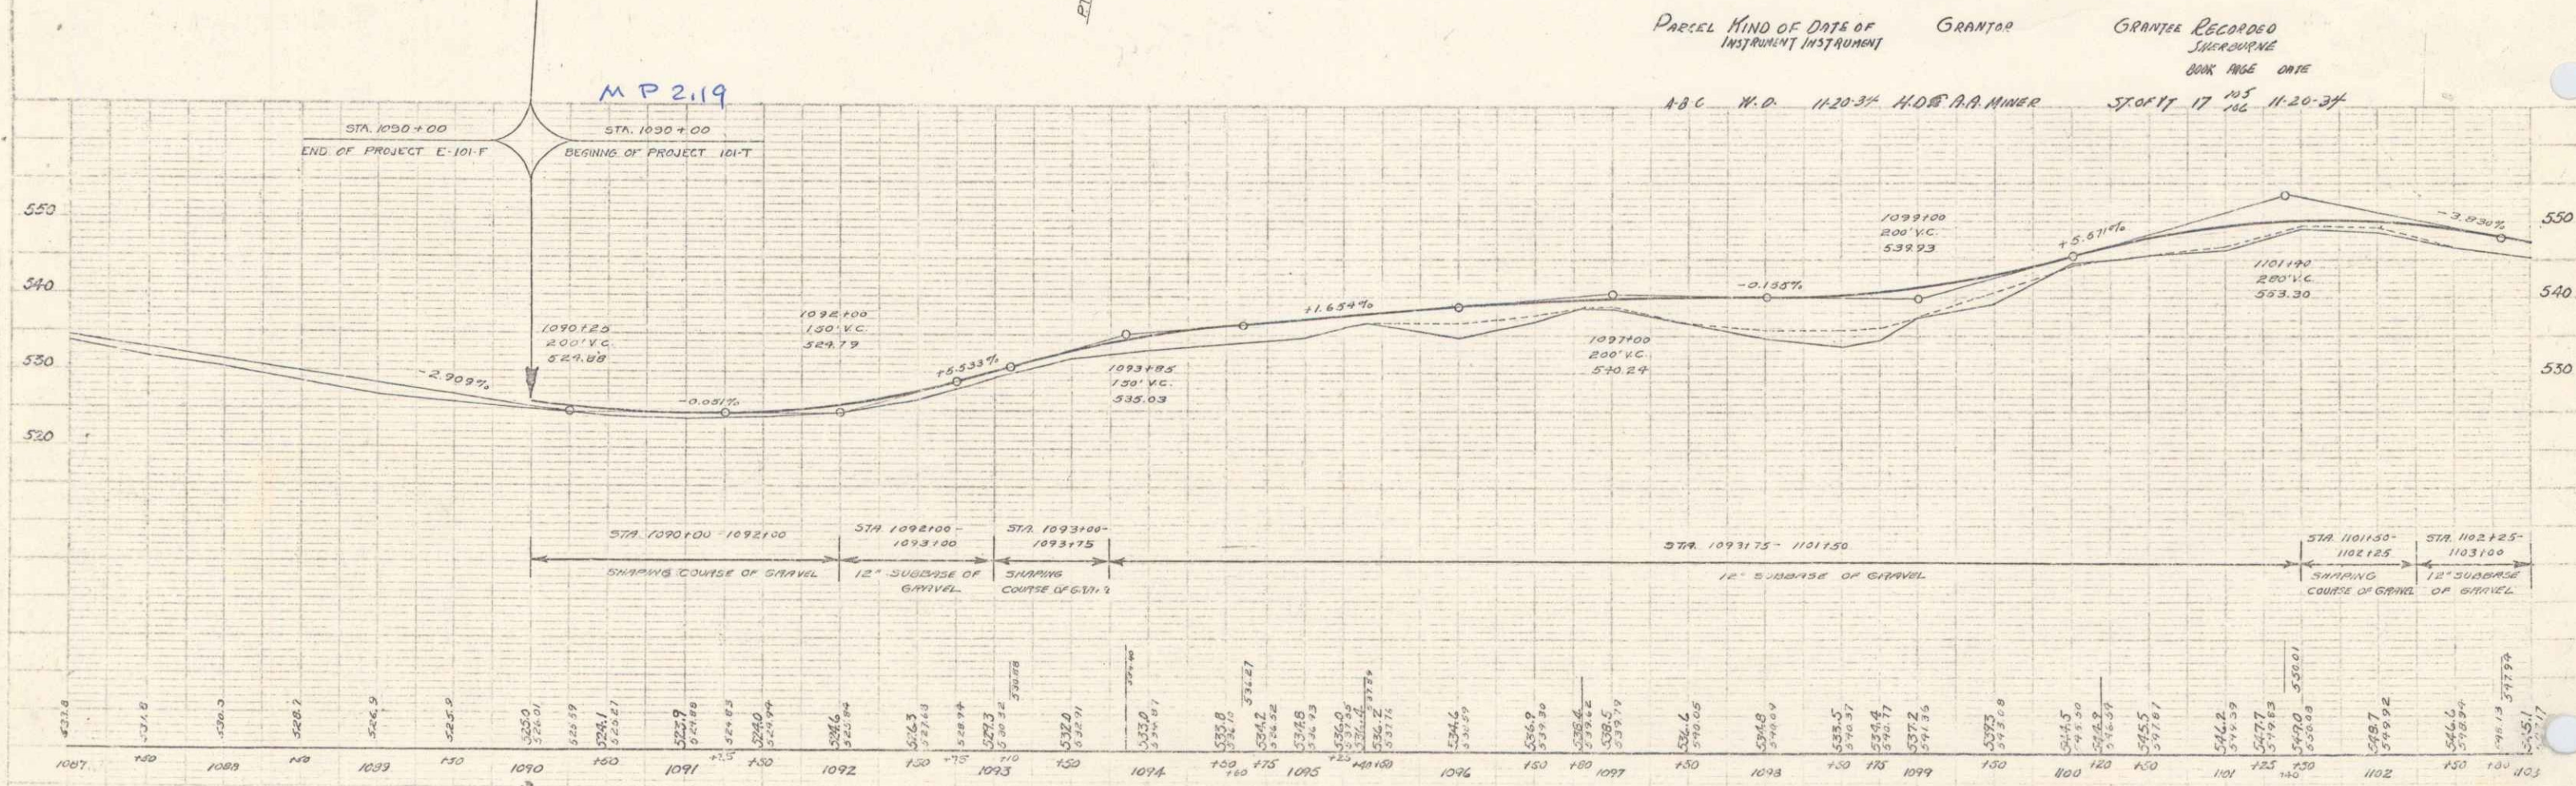


DATE: 03/01/1934  
 PROJECT: 101 T  
 TOWN: SHERBURNE  
 ROUTE: VT 100  
 PIN: 60653


101-T 1934 7 54

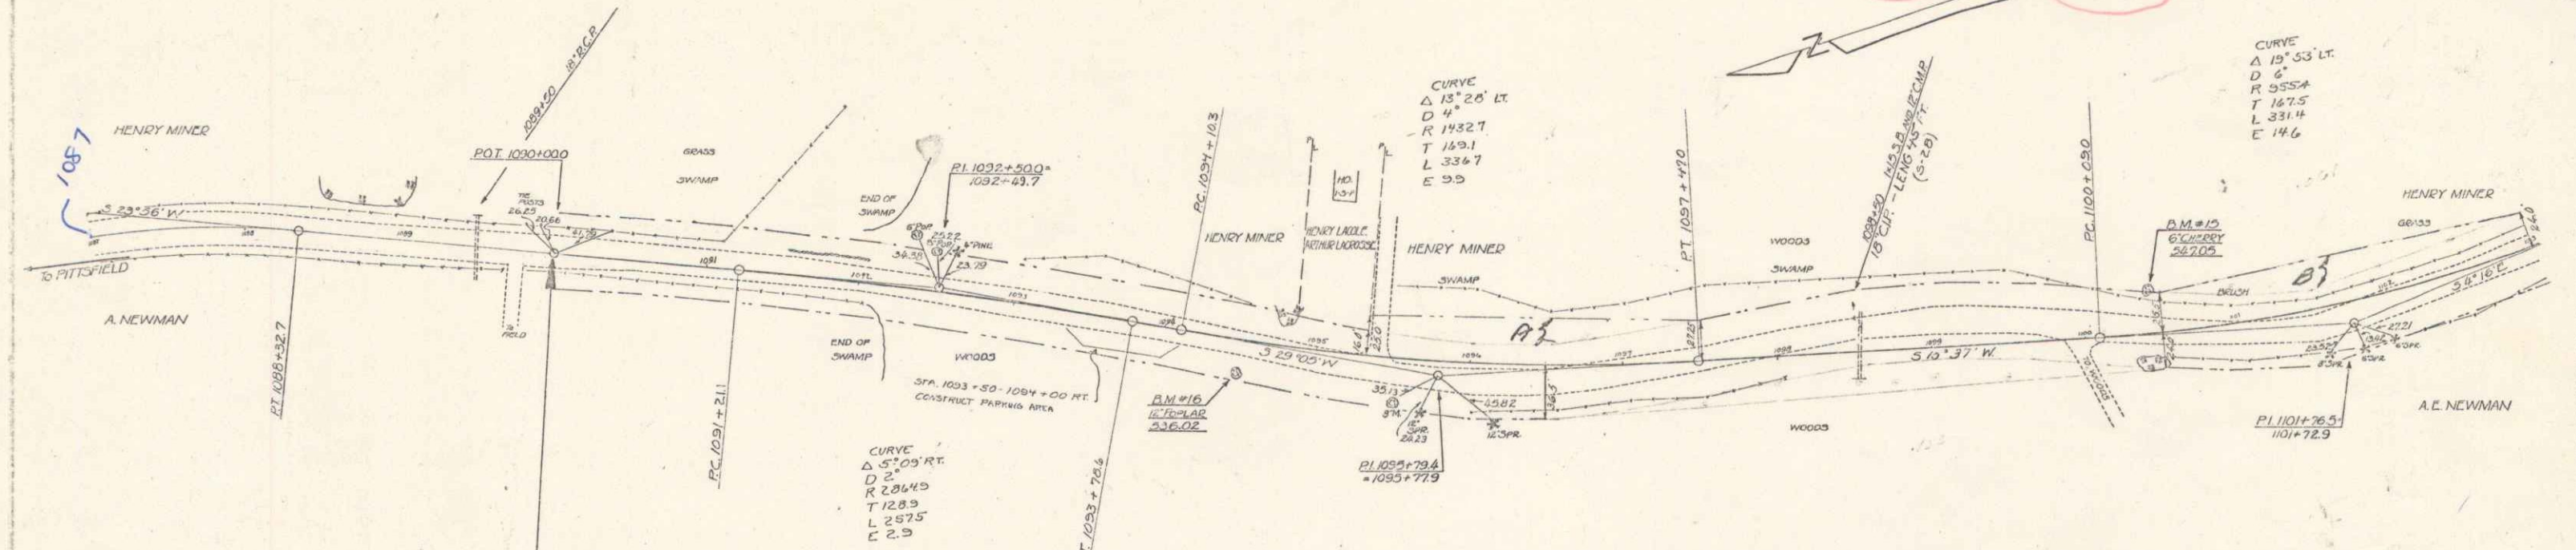


PARCEL	KIND OF DATE OF INSTRUMENT	GRANTOR	GRANTEE	RECORDED SHEET	DATE
A B C	W.D.	11-20-34	HOB. A. A. MINER	SP. 17	11-20-34

D.M. #16 5" PIPE IN TRUNK 12" POPLAR 18" RT STA. 1094+46 ELEV. 536.02  
 D.M. #15 5" PIPE IN TRUNK 8" CHERRY 24" LX STA. 1100+00 ELEV. 547.05


Sherburne  
 MP 0.51-2.19  
 VT Rte 100

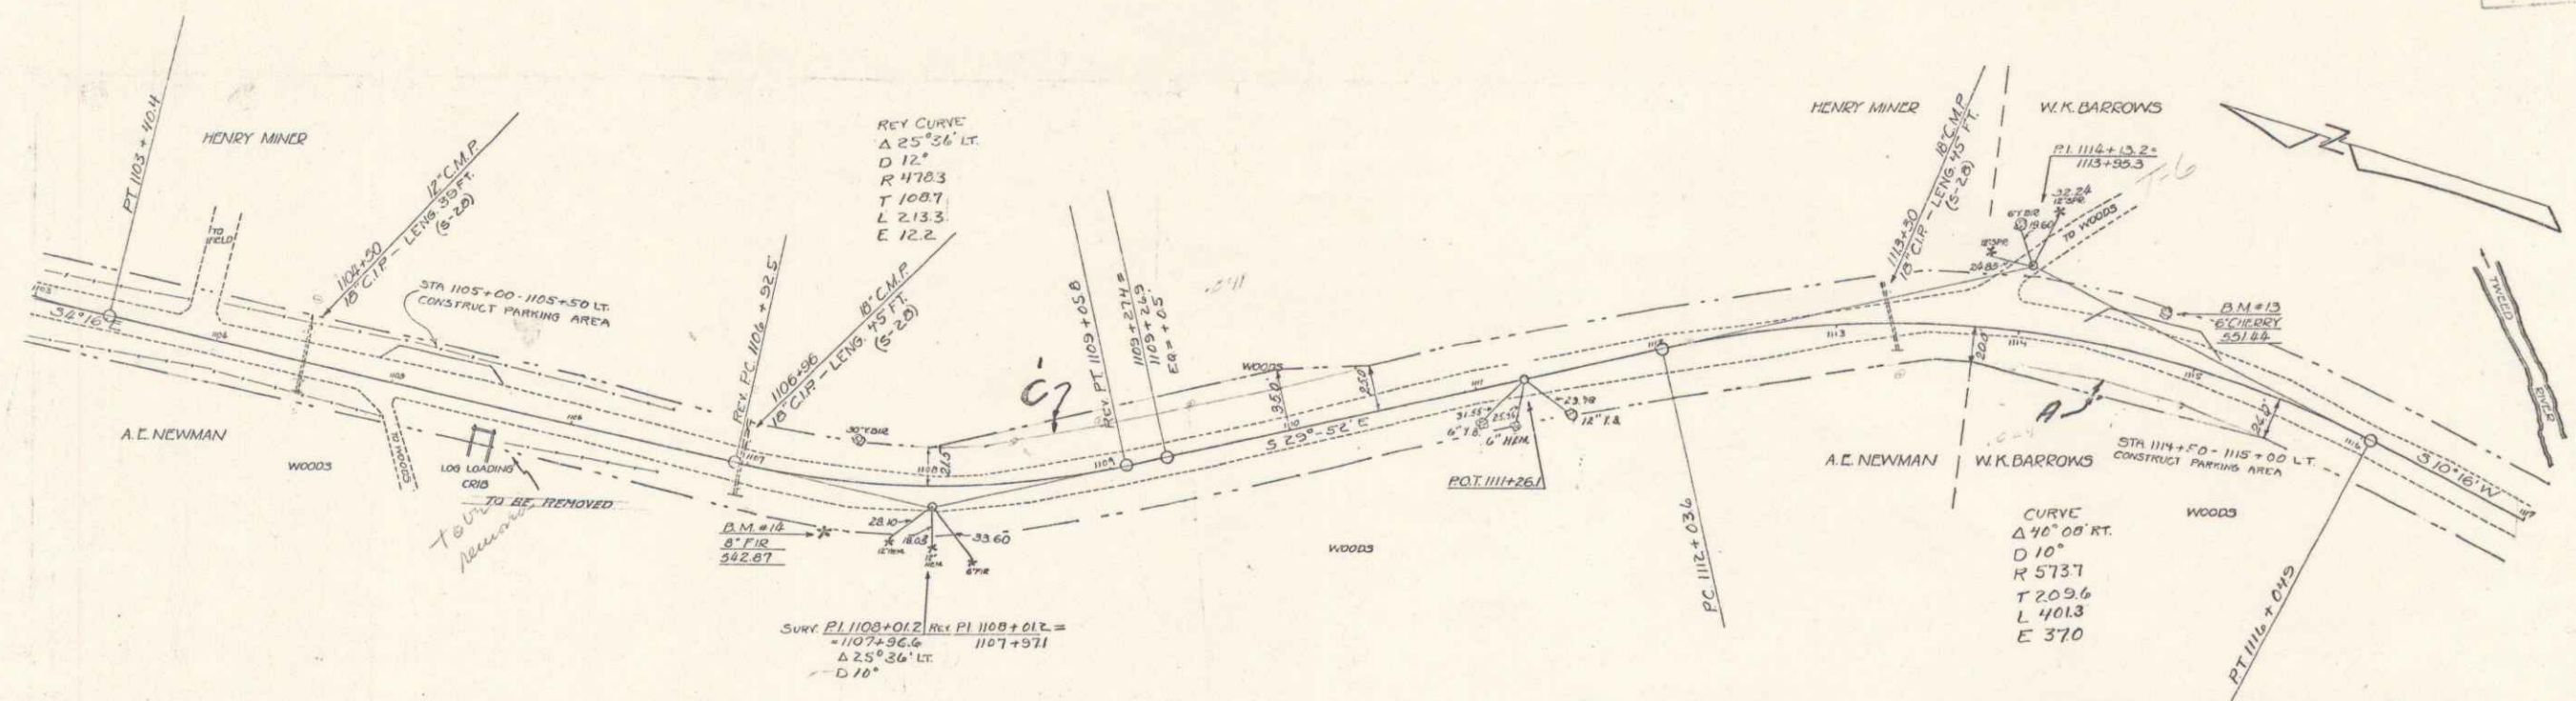


PARCEL	KIND OF DATA	GRANTOR	GRANTEE	RECORDED	REMARKS
A.E.C.	W.D.	11-20-34	HENRY D. & ANGLA A. MINER	BOOK PAGE DATE	87 105-106 8/23/34
W.K.B.	W.D.	11-20-34	M.K. BARROWS	"	17 103-105 8/20/34

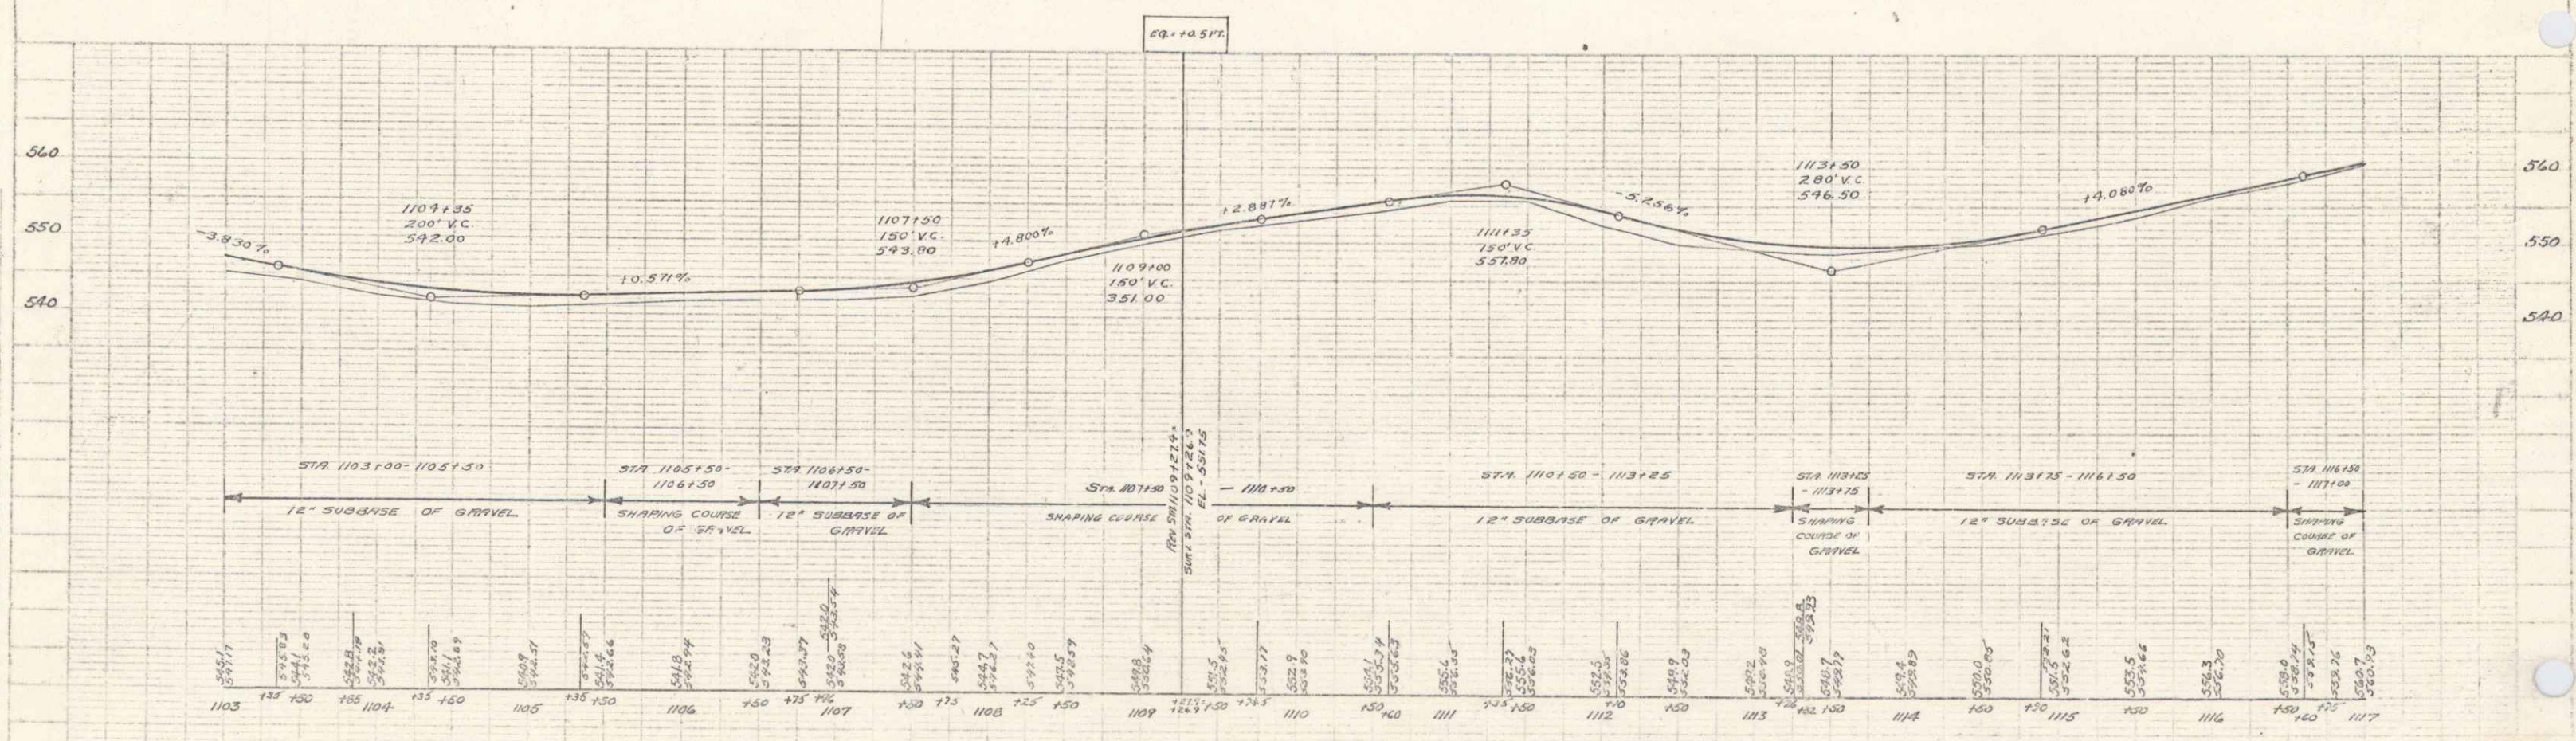


D.M. #18 SPIKE IN ROOT OF TREE 25' RT. STA. 1107+44 ELEV. 542.87  
 D.M. #13 SPIKE IN TRUNK OF CHERRY 21' LT. STA. 1114+79 ELEV. 551.64

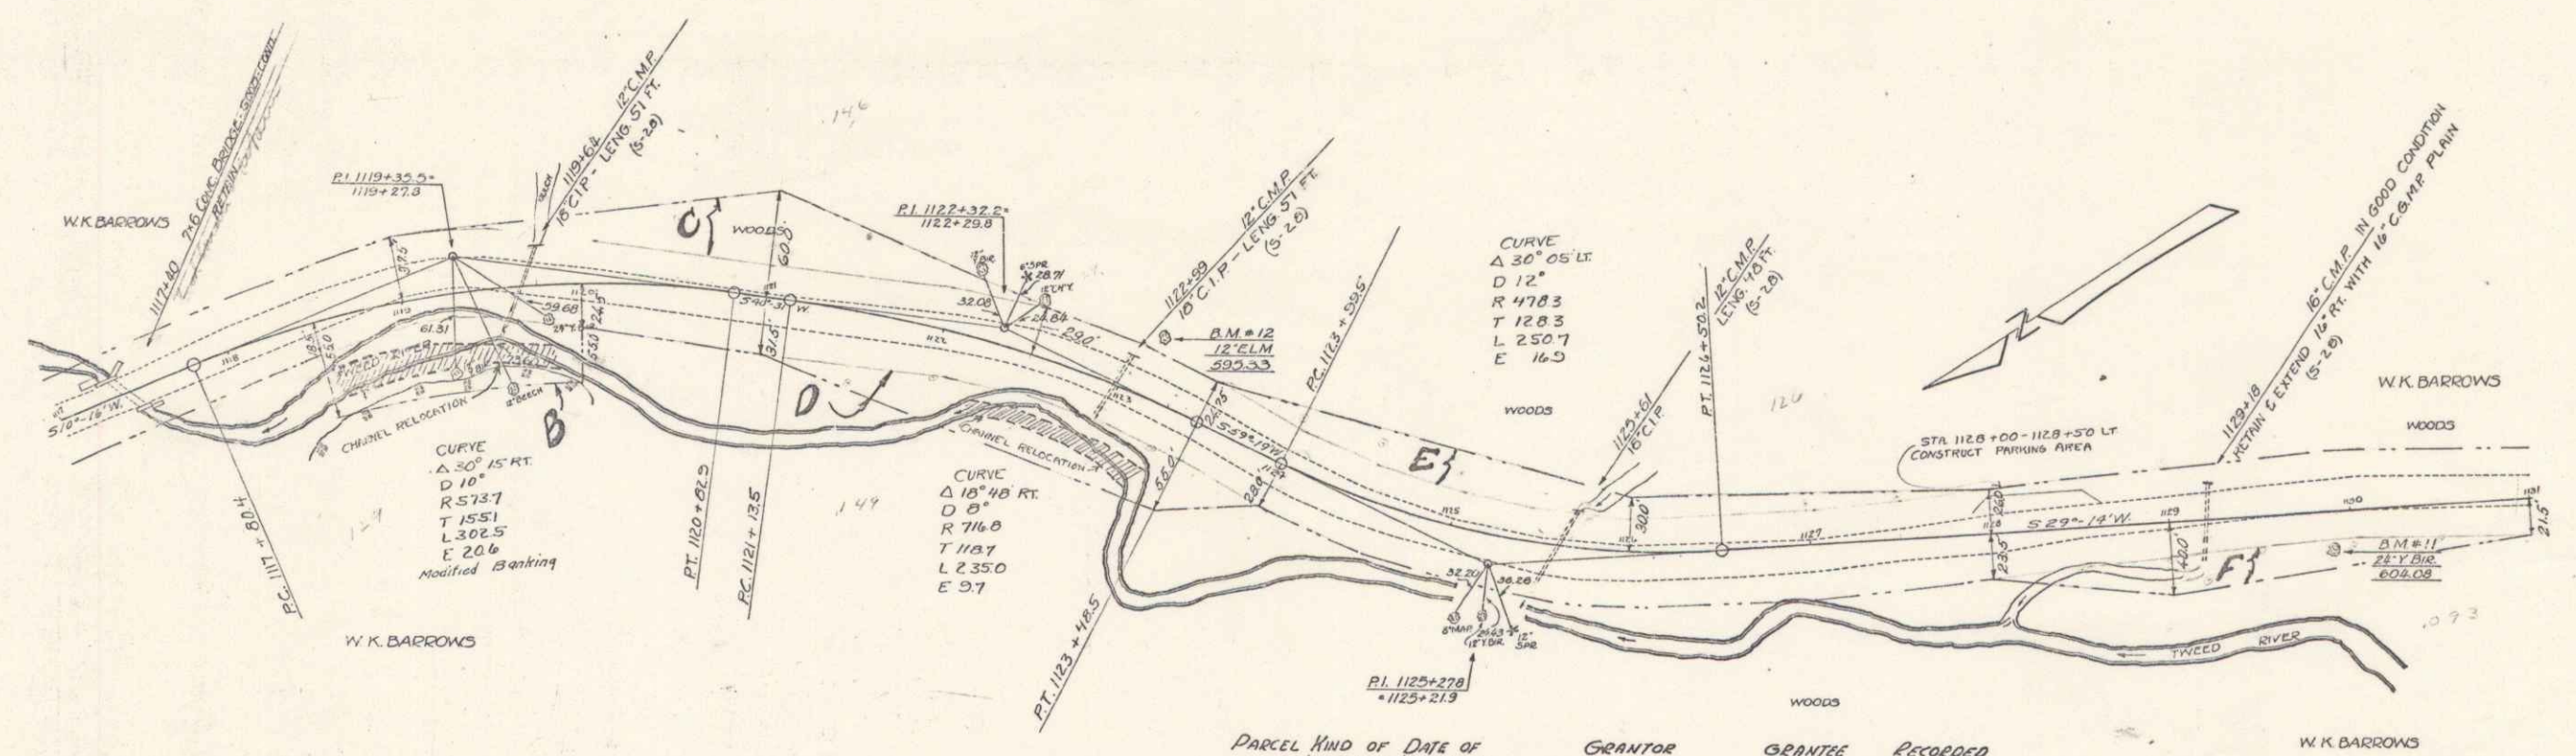


PARCEL	KIND OF INSTRUMENT	DATE OF INSTRUMENT	GRANTOR	GRANTEE	RECORDED
1120-01	W.D.	11-20-37	W.K. BARROWS	BARROWS	BOOK PAGE DATE
1120-02	W.D.	11-20-37	W.K. BARROWS	BARROWS	BOOK PAGE DATE
1120-03	W.D.	11-20-37	W.K. BARROWS	BARROWS	BOOK PAGE DATE

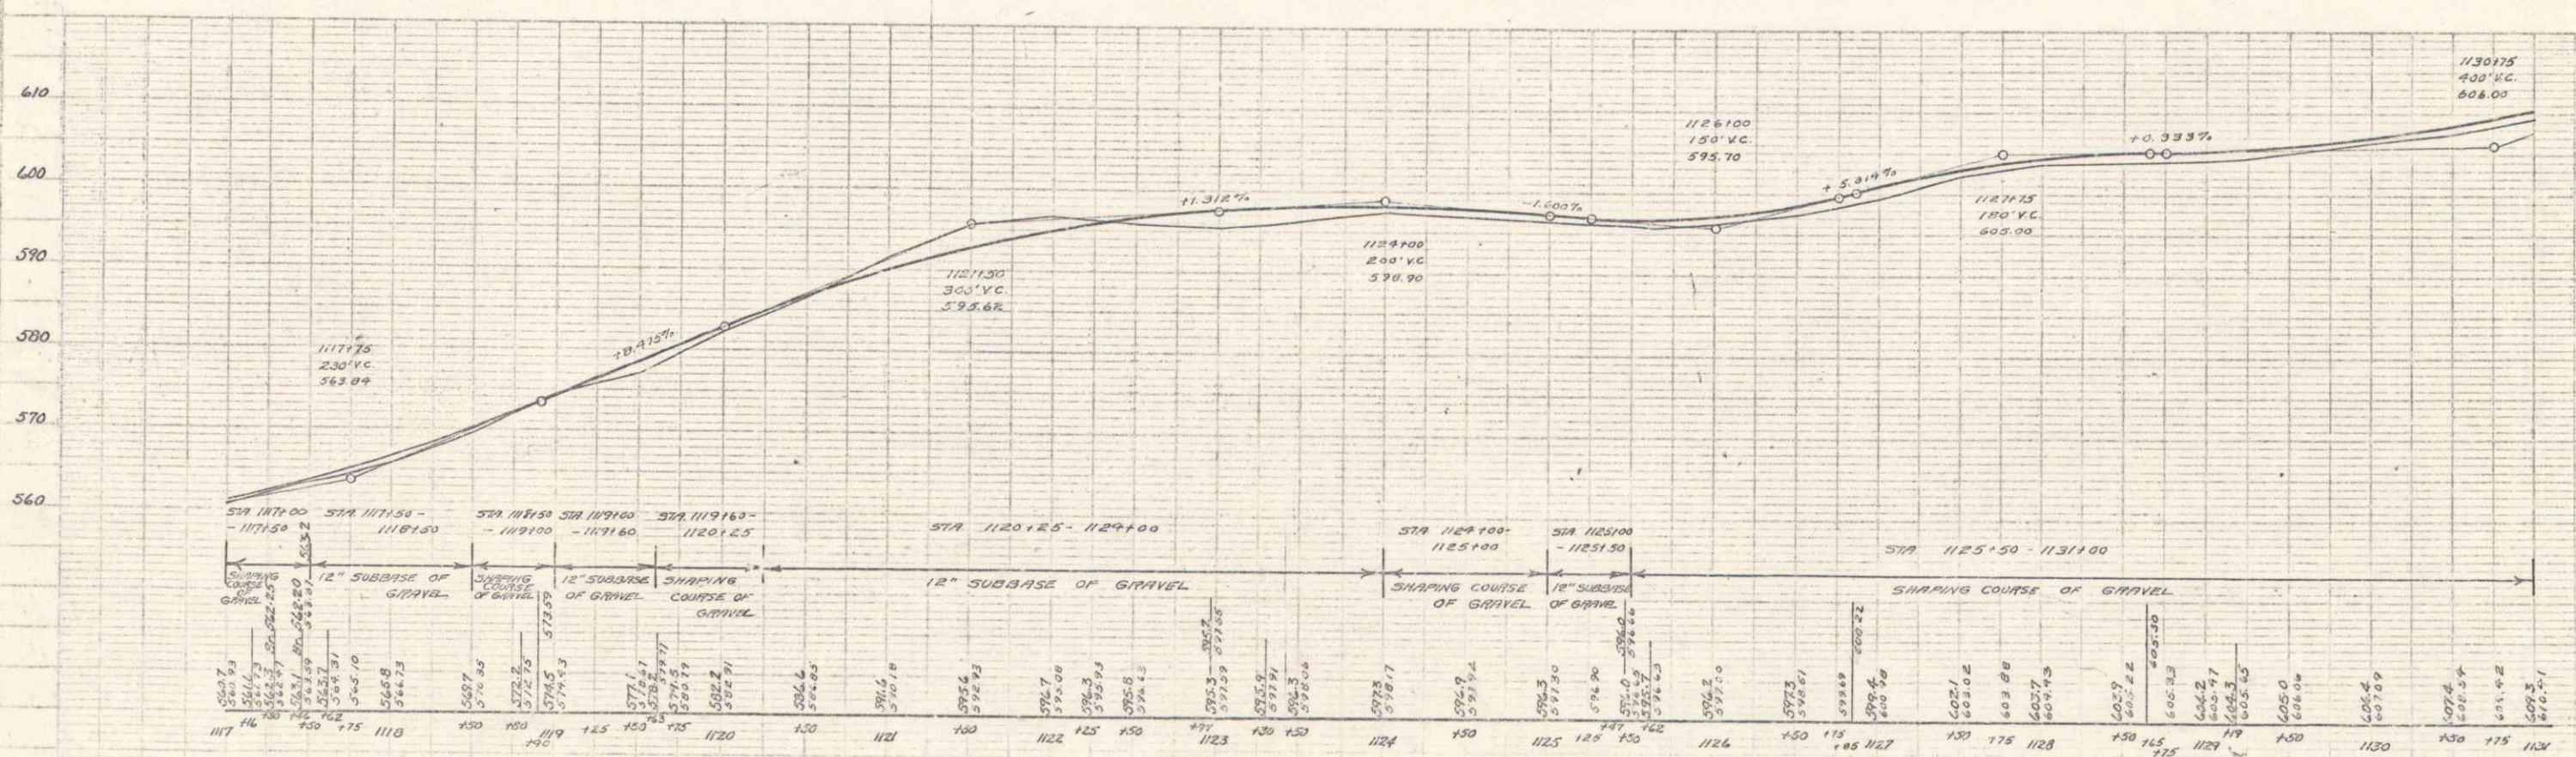


B.M. #12 SPIKE IN ROOT 12" ELM 32' LT STA 1123+15 ELEV. 595.33  
 B.M. #11 SPIKE IN ROOT 24" YELLOW BIRCH 16' RT STA 1129+89 ELEV. 604.08

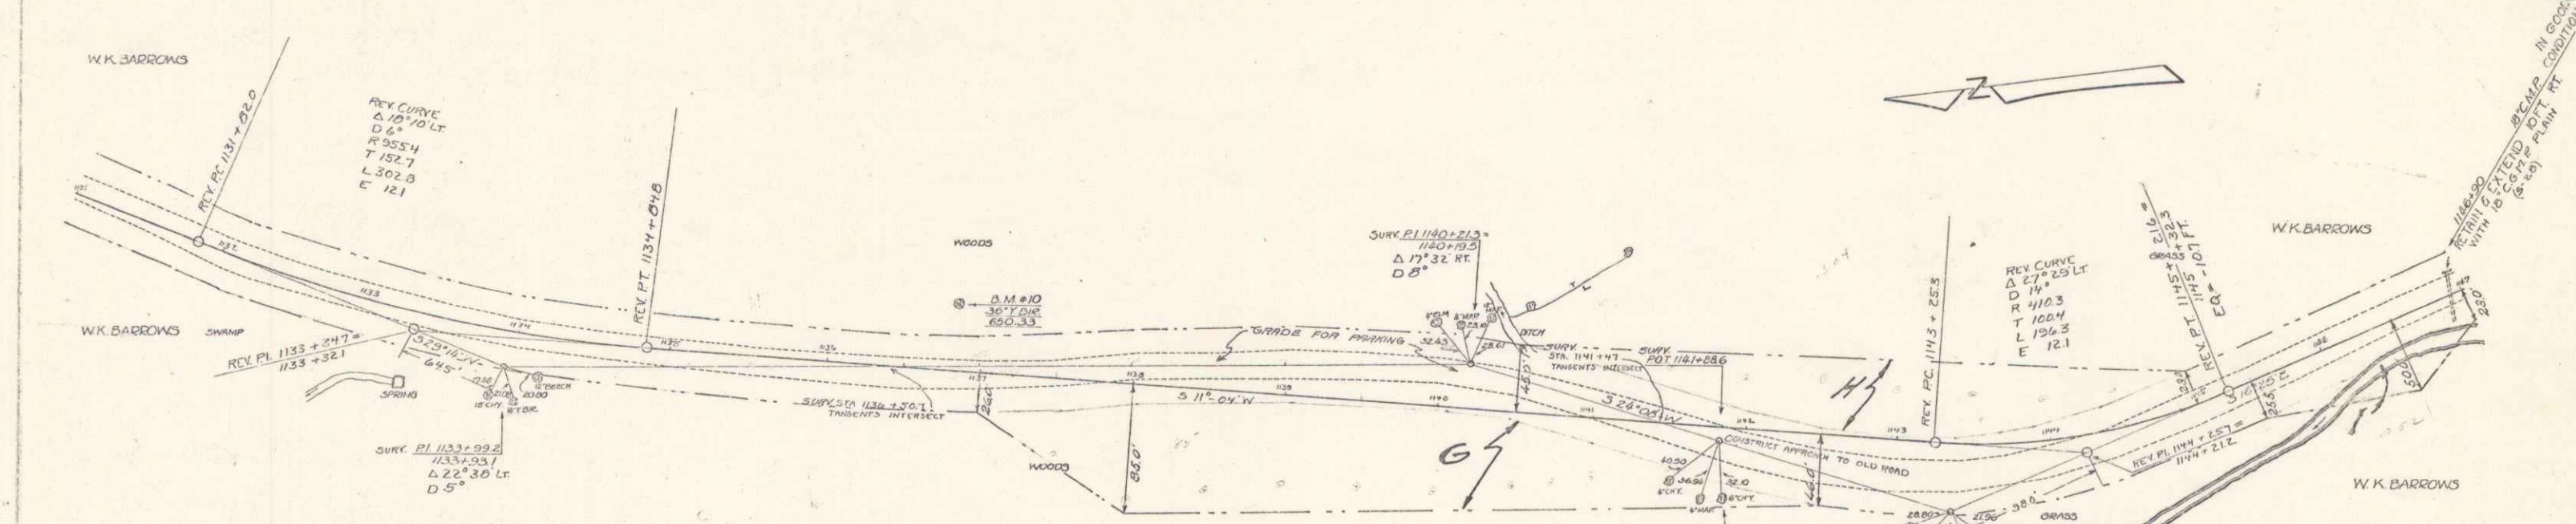


Parcel Kind of Data of INSTRUMENT GRANTOR GRANTEE RECORDED IN REMARKS  
 1862 STAMPA W.D. #20-34 W.K. BARROWS 57 OF 11 17 103-105 1120-34

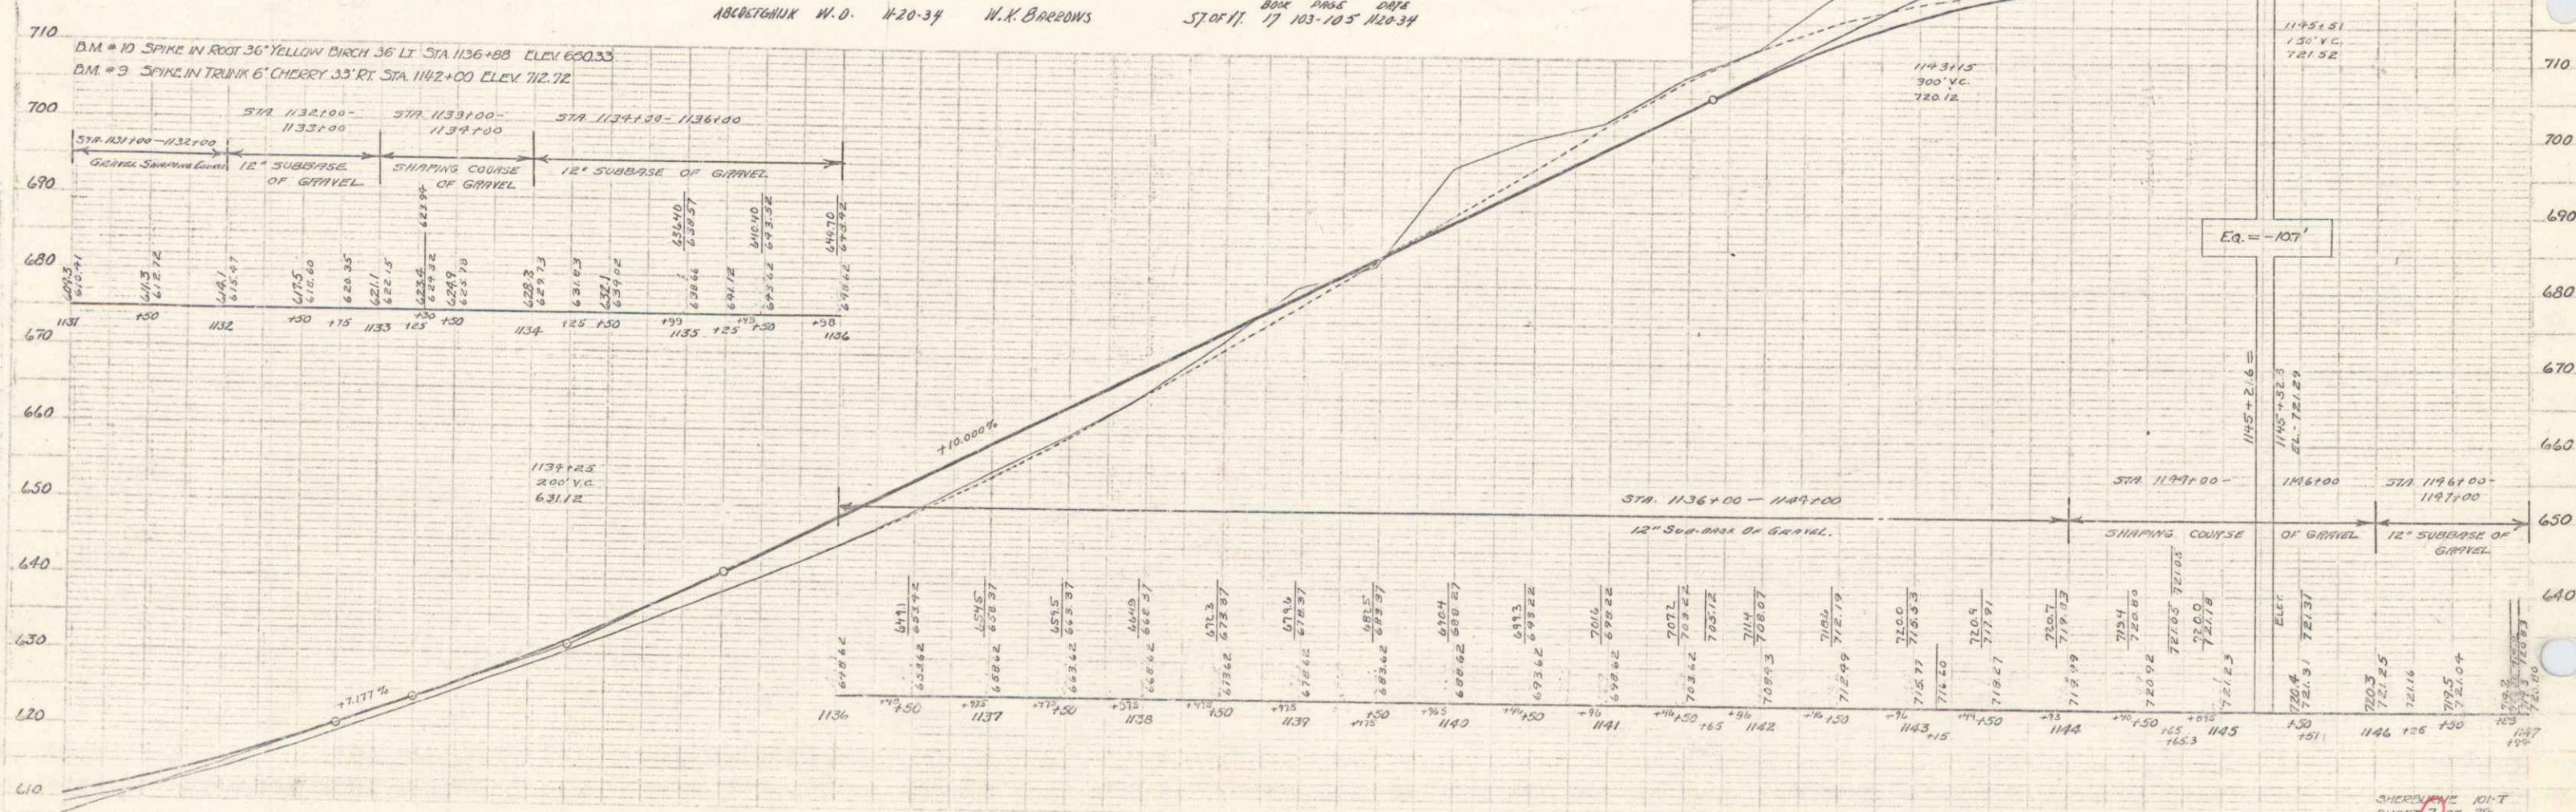



R.F.T. 1 3-1-33

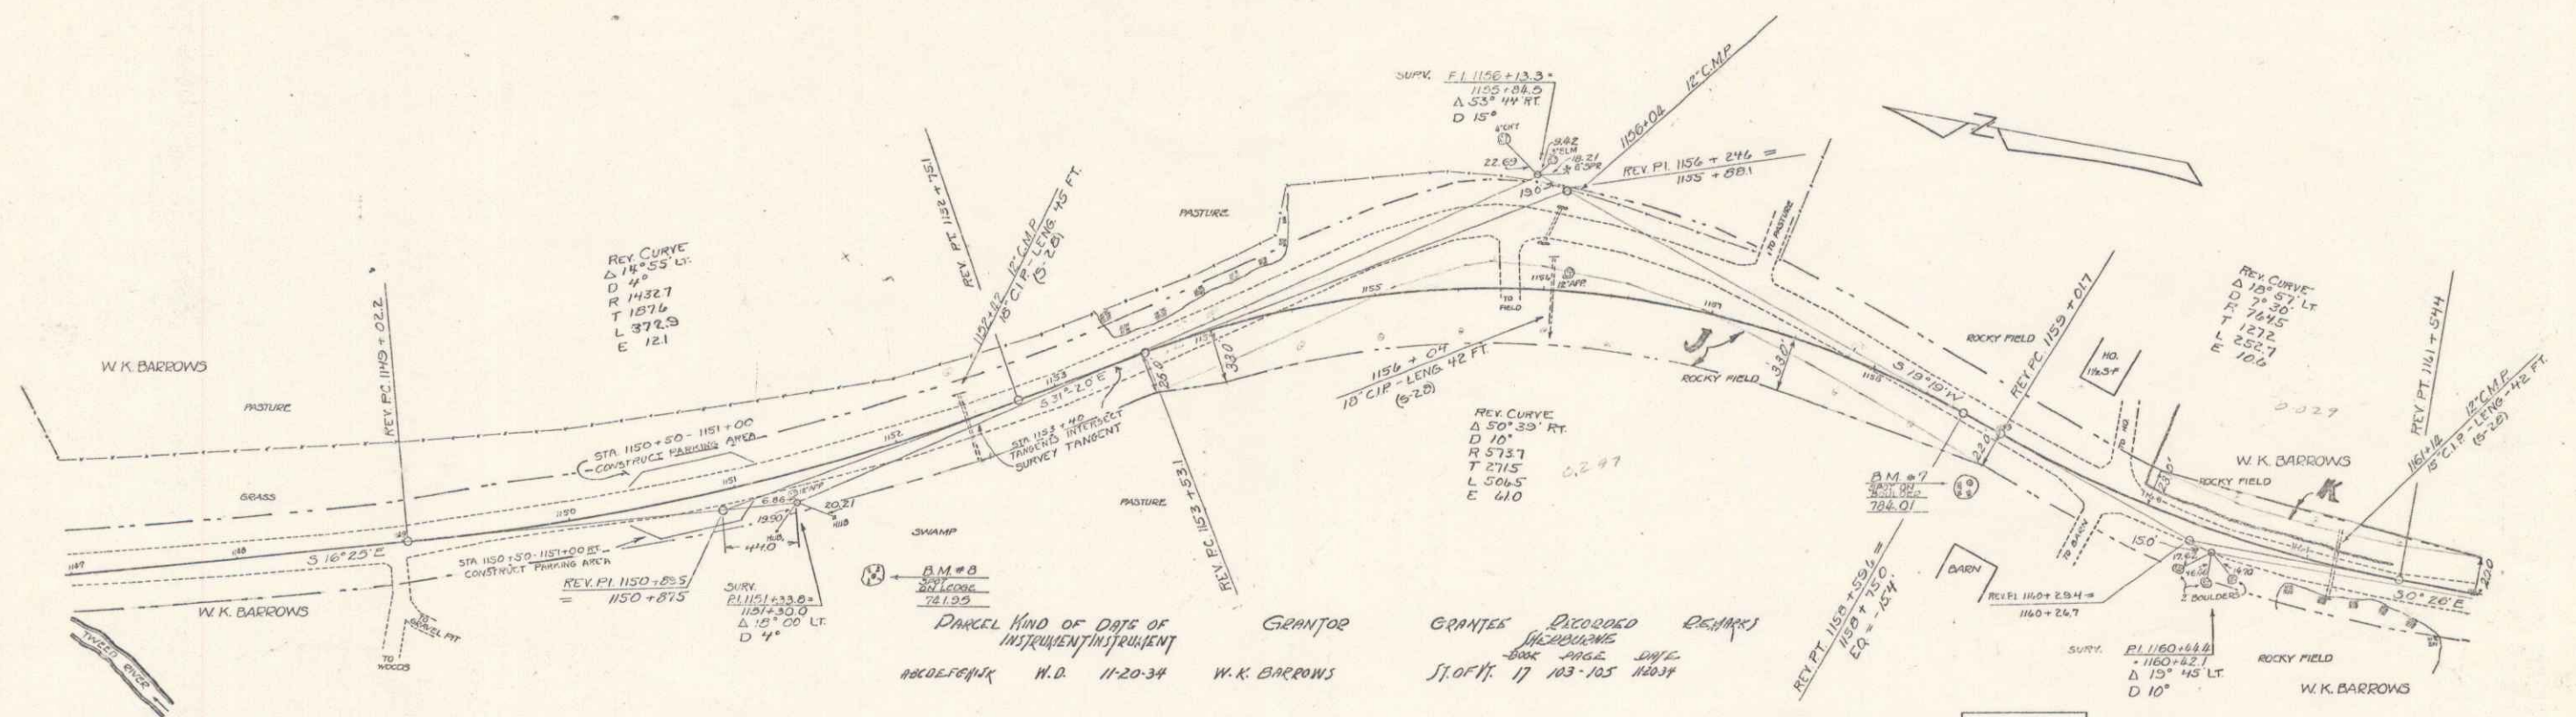

DRAWN KIND OF DATE OF INSTRUMENT EQUIPMENT GRANTEE GRANTEE RECORDED RECORDED  
 W.D. 11-20-34 W.K. BARROWS J.I. OFF. 17 103-105 11034

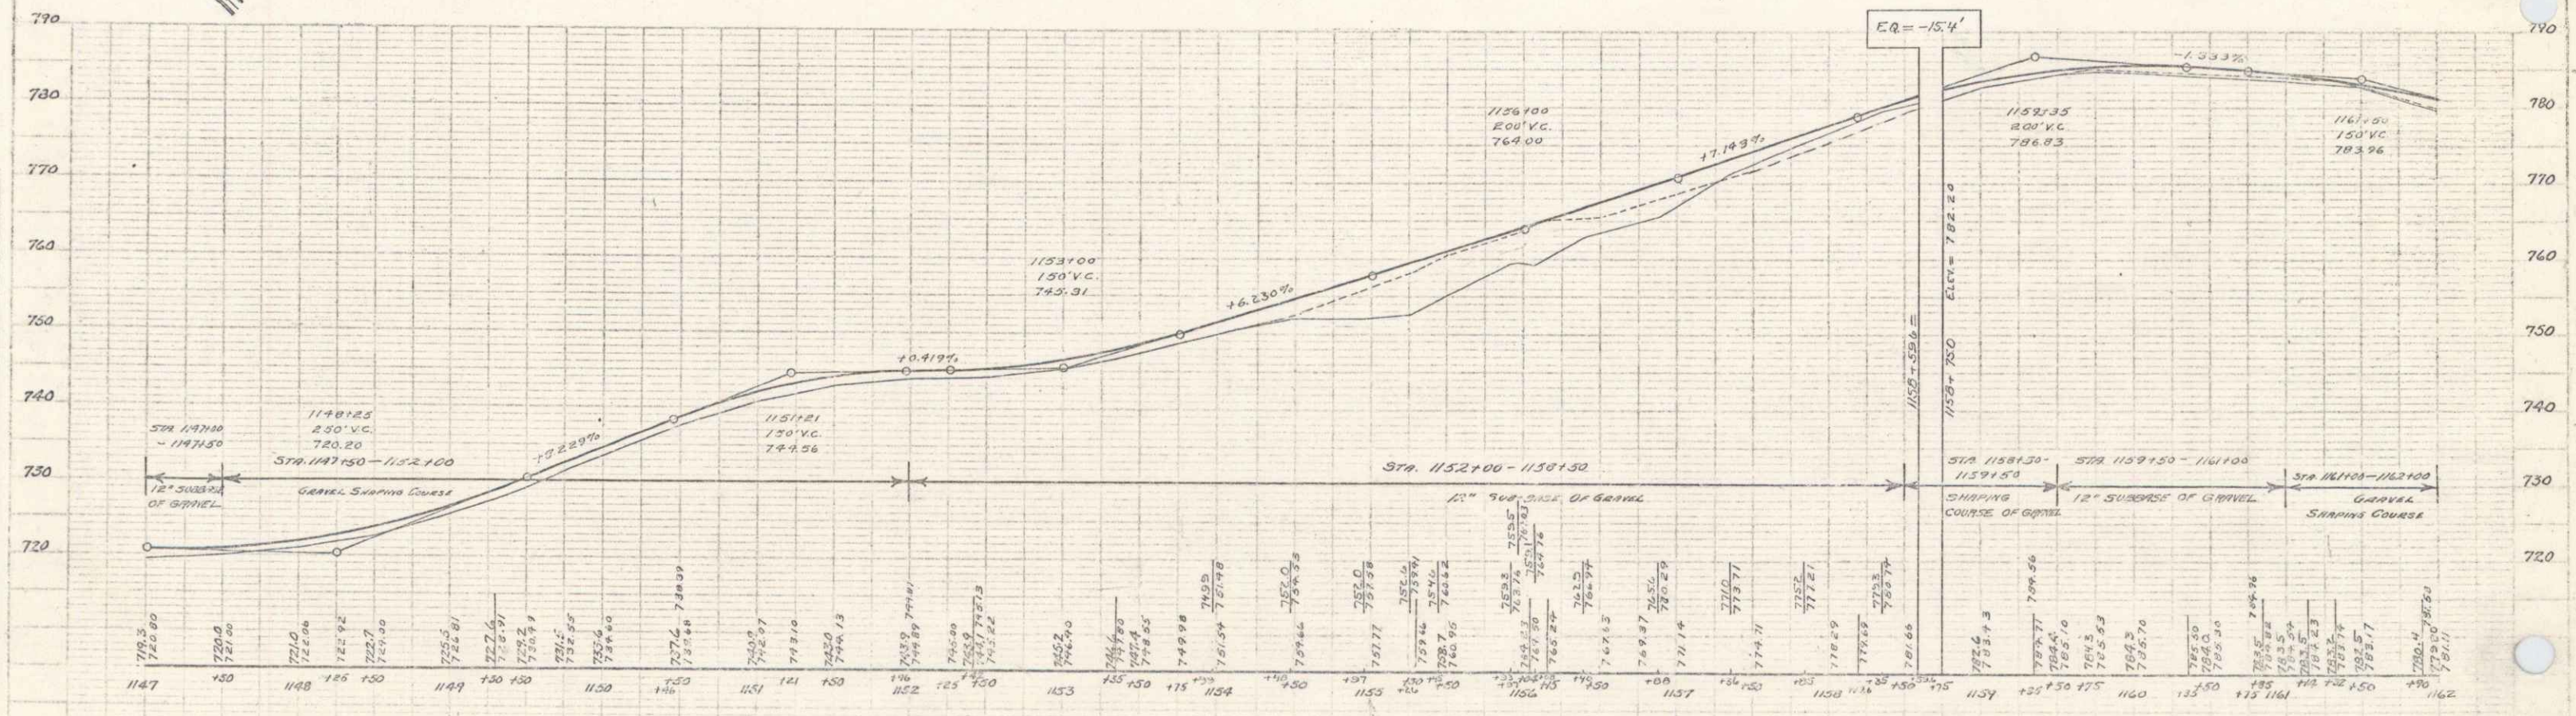

DM #8 SPOT ON LEDGE 65 FT STA. 1154+62 ELEV. 741.95  
 DM #7 SPOT ON B' COULDER 30 FT STA. 1153+00 ELEV. 749.01

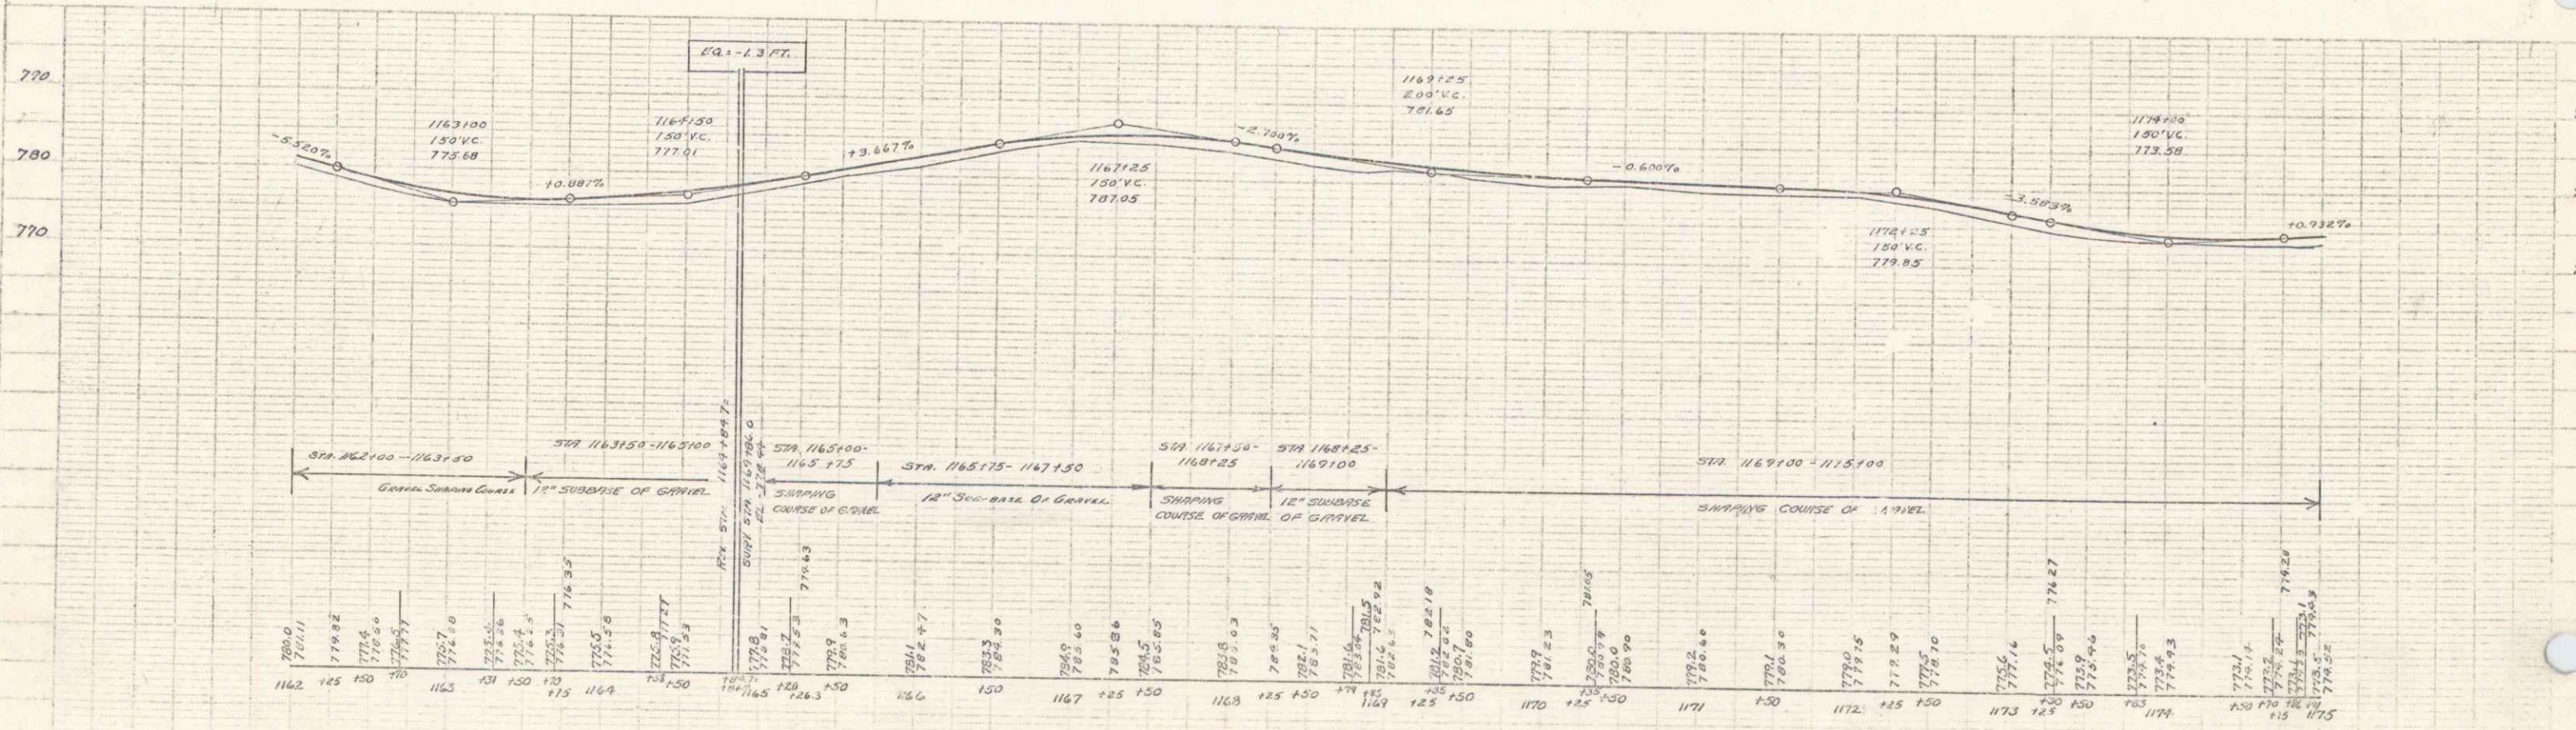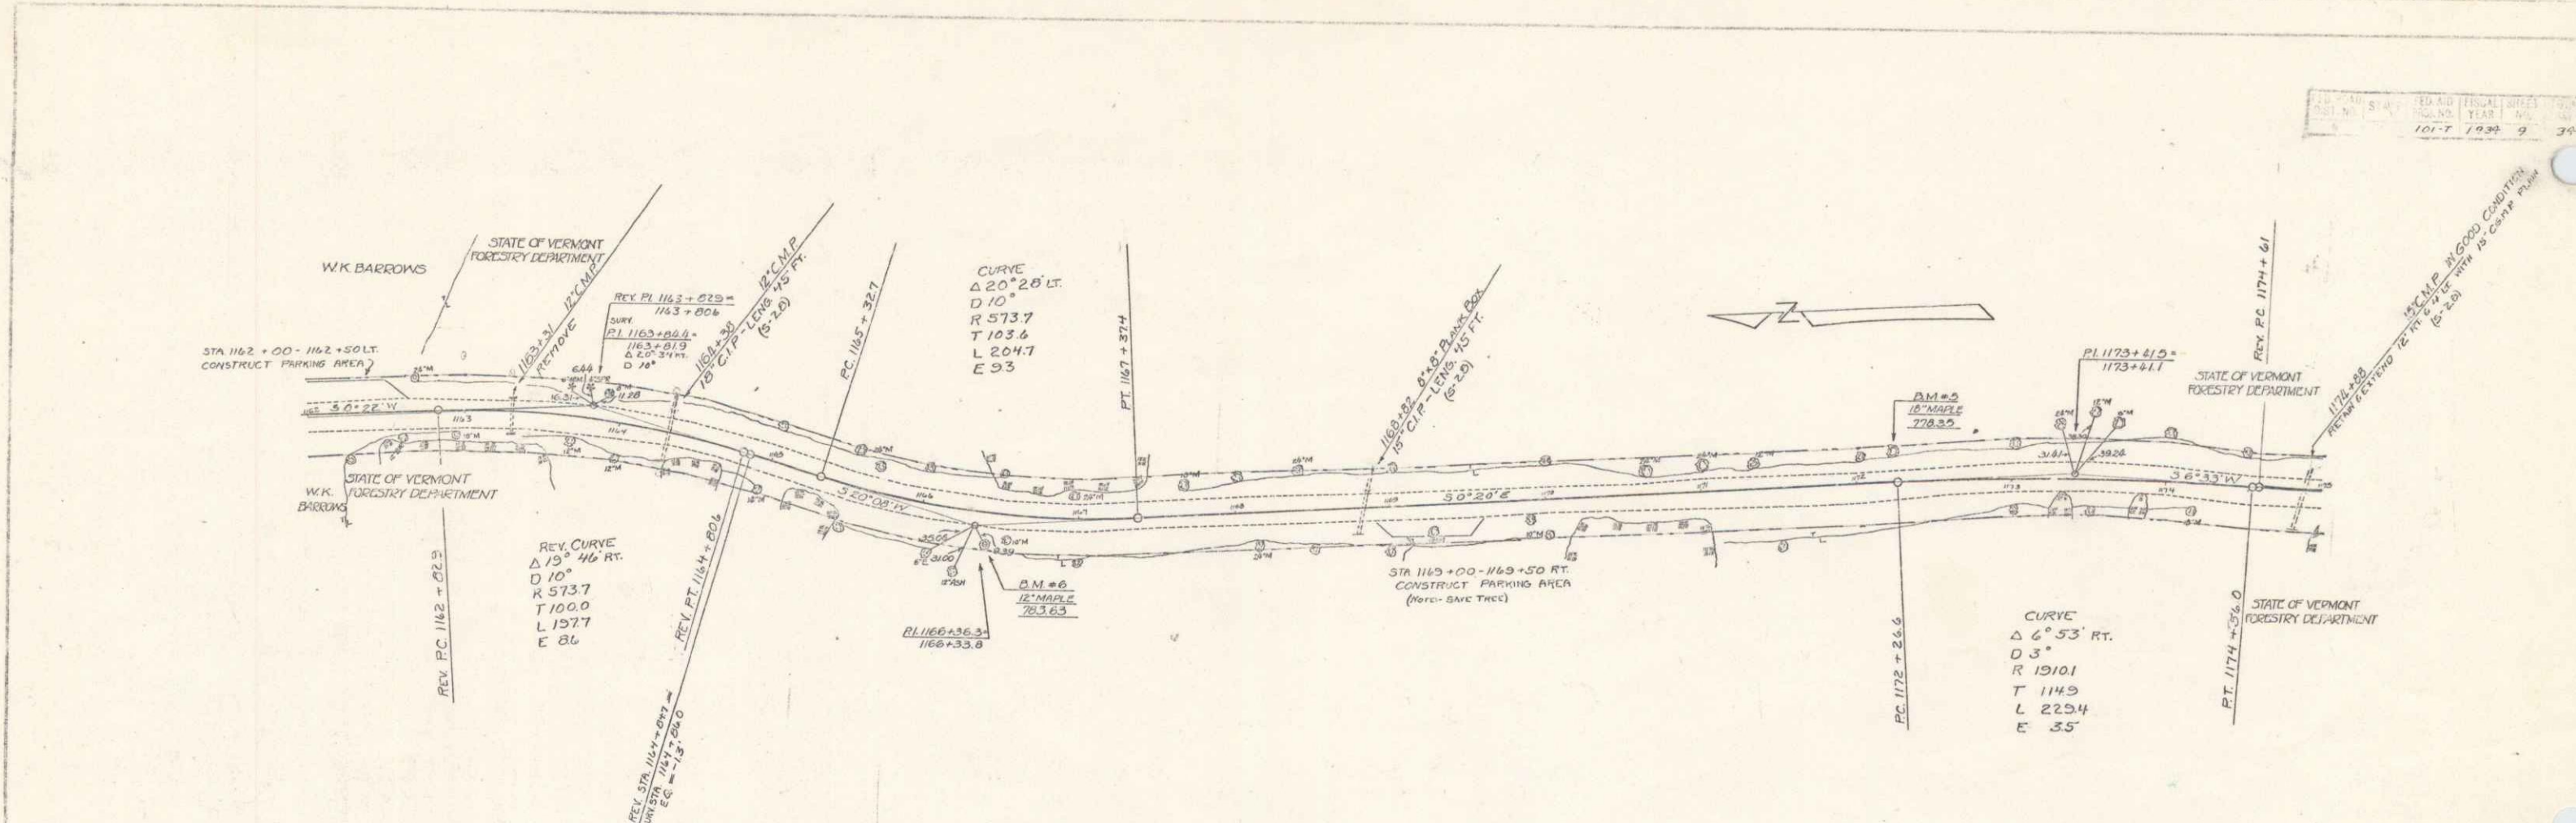

BM #6 SPIKE IN ROOT 12' MAPLE 18' RT. STA. 1166+80 ELEV. 783.63  
 BM #5 SPIKE IN ROOT 16' MAPLE 16' LT. STA. 1172+23 ELEV. 778.30

