


| Parcel | Kind of Instrument | Date of Instrument | Grantor | Grantee | Recorded | Filed | Remarks |
|--------|--------------------|--------------------|---------------------------|-----------|----------|----------|----------|
| A | Q.C.D. | 10-3-35 | Pearl C Ada B Adams | SI of Vt. | Book 16 | Page 319 | 10-3-35 |
| A-B-C | Q.C.D. | 10-4-35 | Cleone M. Townsend | " | 16 | 713 | 10-16-35 |
| A-B | W.D. | 11-22-35 | George S. & Ruby C. Wilde | " | 16 | 789 | 11-22-35 |
| A" | W.D. | 11-3-35 | F.R. Habel Bishop | " | 16 | 308 | 11-3-35 |

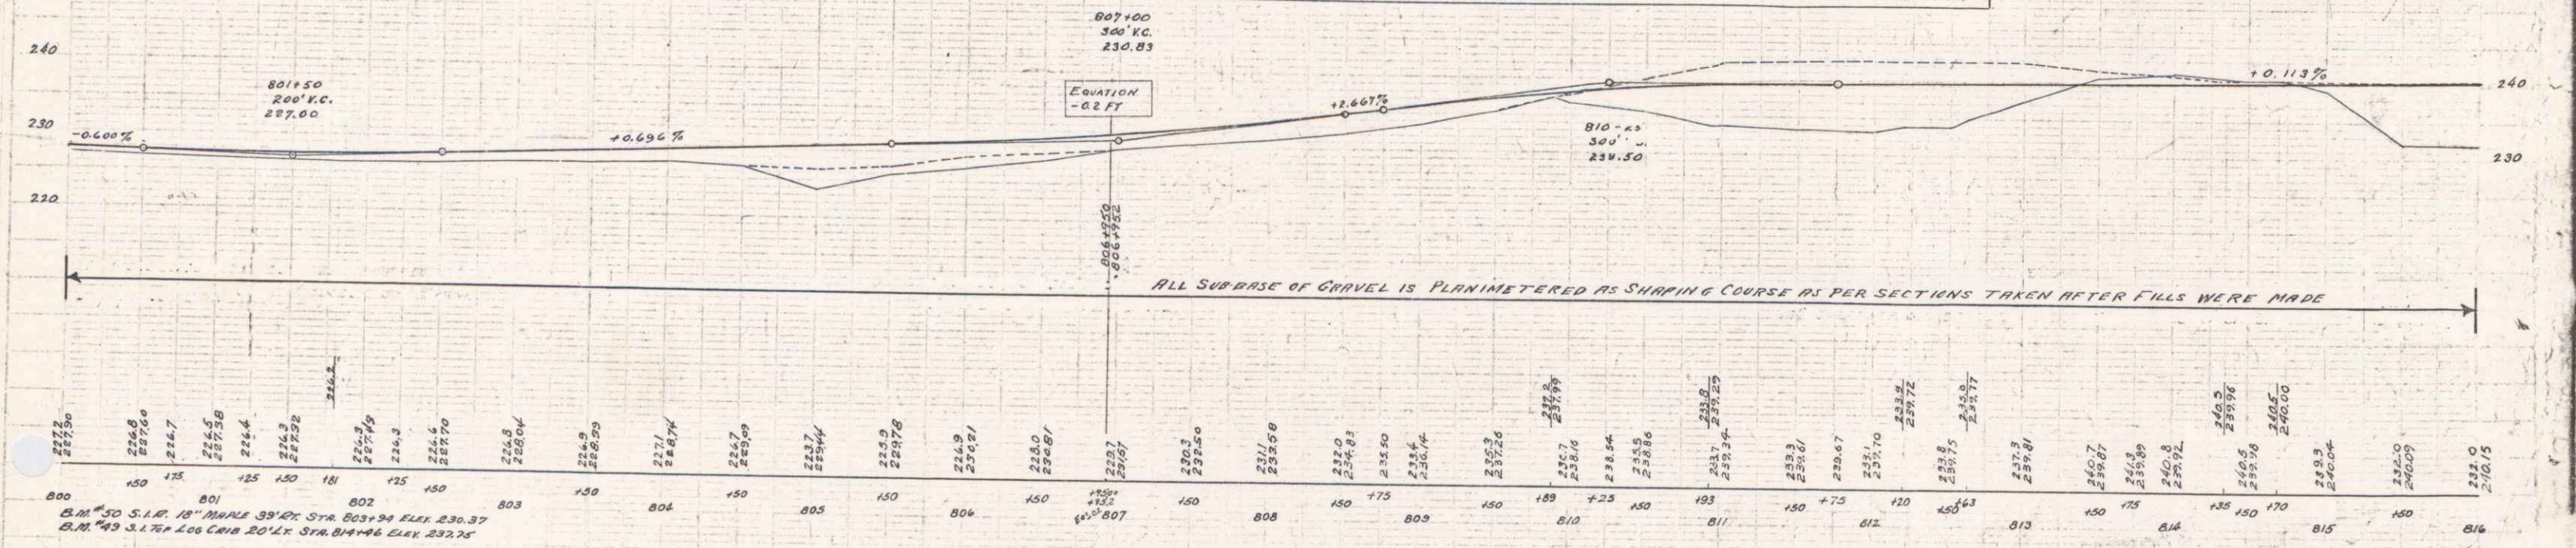

800 150 115 100 125 150 181 125 150 203 150 204 150 205 150 206 150 207 150 208 150 209 150 210 150 211 150 212 150 213 150 214 150 215 150 216

B.M. #30 S.I.T. 18" MARK 33" ST. STA 803+34 ELEV 230.37
 B.M. #49 S.I.T. 40" MARK 20" ST. STA 814+46 ELEV 232.25

Series: FAP 101-1
 Sheet 6 of 70