


Parcel	Kind of Instrument	Date of Instrument	Grantor	Grantee	Recorded District	Remarks
A	W.D.	10-3-35	F.H. Bishop	Geo. Wilde	Book 300	10-3-35
A-1/2	W.D.	11-22-35	G.S. Ruby Wilde	Geo. Wilde	16 935	11-22-35
A-Cul 1/2	W.D.	10-10-35	Charles French	Geo. Wilde	16 917	10-10-35

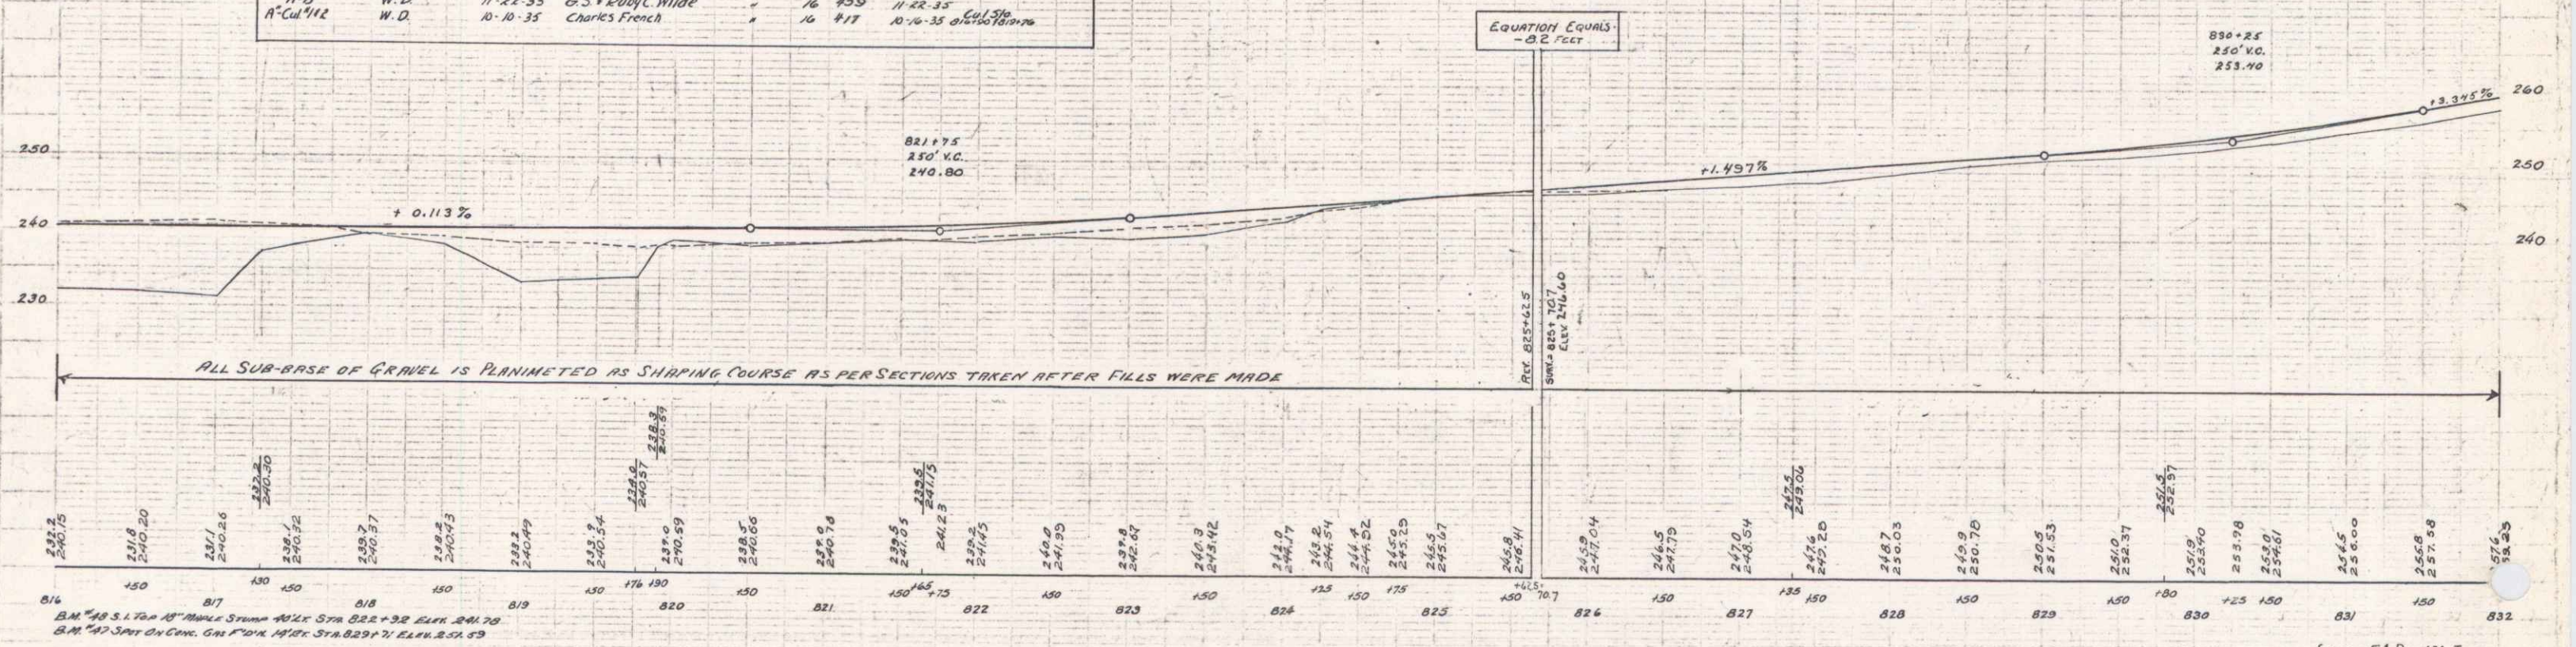

B.M. 14 S. 1. Top of Main Stone 412x Sta. 822+32 Elev. 241.70
 B.M. 142 Spot on Curve. Gas 1" dia. 1918x Sta. 825+71 Elev. 251.53