


NOTE: PRESENT GRAVED RAIL TO BE CAREFULLY REMOVED AND DISPOSED OF AS DIRECTED BY THE ENGINEER AND BECOME THE PROPERTY OF THE STATE

Parcel	Kind of Instrument	Date of Grantor	Grantor	Grantee	Recorded Book Page	Date	Remarks
A B C	O C D	9-30-35	Nobel, Winthrop, Rachee	Stall W Rannee	16 428	10-16-35	

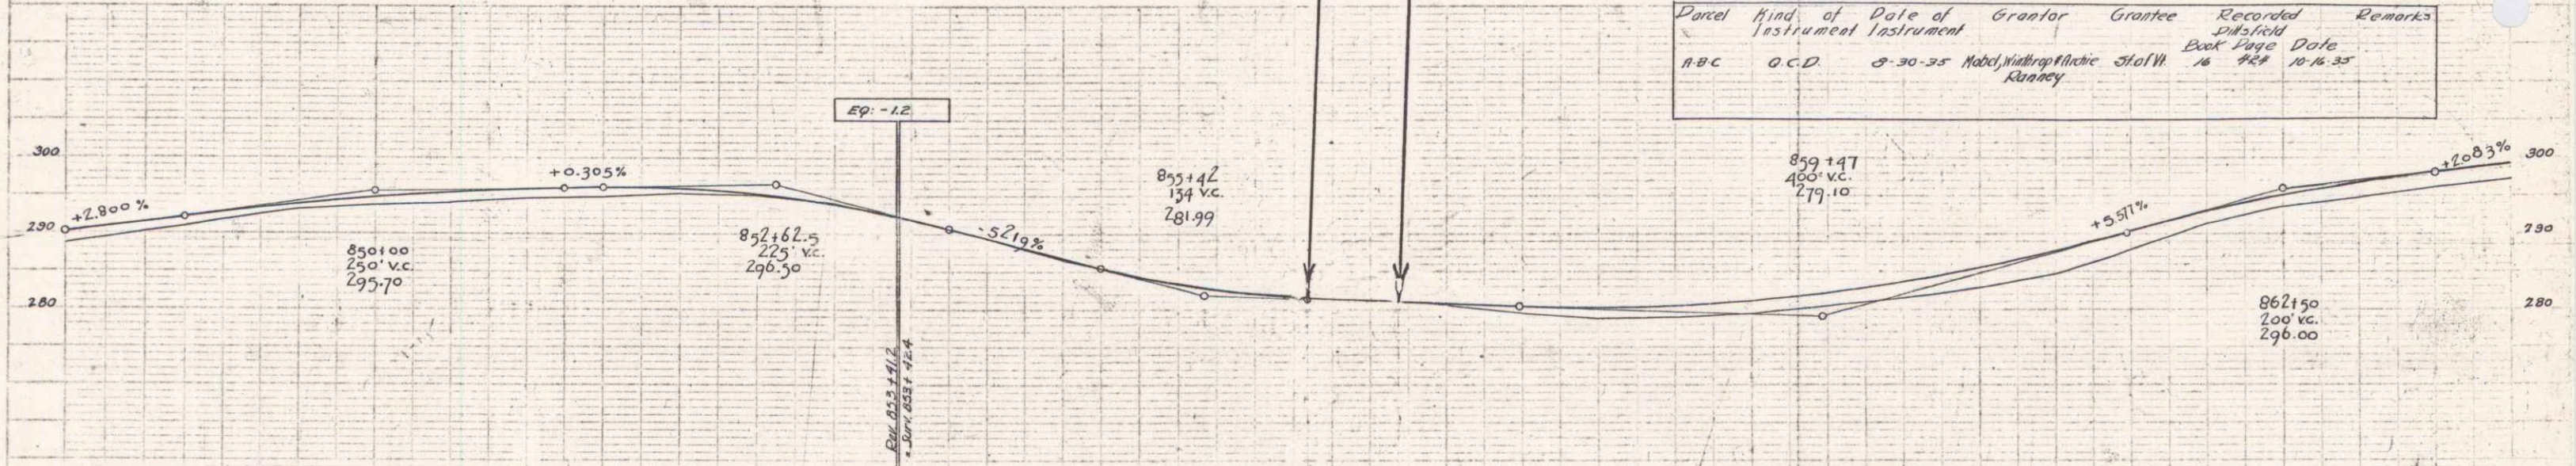

ALL SUB-BASE OF GRAVEL IS PLANIMETERED AS SHIPING COURSE AS PER SECTION TAKEN AFTER FILLS WERE MADE

Station	Elevation	Station	Elevation	Station	Elevation	Station	Elevation
848	280.10	852	281.50	856	281.12	860	281.15
150	290.7	150	282.75	150	281.18	150	282.9
175	290.9	175	282.75	175	281.18	175	282.9
200	292.20	200	282.75	200	281.18	200	282.9
225	292.87	225	282.75	225	281.18	225	282.9
250	293.02	250	282.75	250	281.18	250	282.9
275	293.92	275	282.75	275	281.18	275	282.9
300	294.7	300	282.75	300	281.18	300	282.9
325	295.57	325	282.75	325	281.18	325	282.9
350	296.08	350	282.75	350	281.18	350	282.9
375	296.76	375	282.75	375	281.18	375	282.9
400	297.15	400	282.75	400	281.18	400	282.9
425	297.00	425	282.75	425	281.18	425	282.9
450	297.70	450	282.75	450	281.18	450	282.9
475	298.04	475	282.75	475	281.18	475	282.9
500	298.9	500	282.75	500	281.18	500	282.9
525	299.65	525	282.75	525	281.18	525	282.9
550	300.3	550	282.75	550	281.18	550	282.9
575	301.4	575	282.75	575	281.18	575	282.9
600	302.7	600	282.75	600	281.18	600	282.9
625	303.62	625	282.75	625	281.18	625	282.9
650	304.8	650	282.75	650	281.18	650	282.9
675	306.18	675	282.75	675	281.18	675	282.9
700	307.5	700	282.75	700	281.18	700	282.9
725	308.7	725	282.75	725	281.18	725	282.9
750	310.02	750	282.75	750	281.18	750	282.9
775	311.48	775	282.75	775	281.18	775	282.9
800	312.9	800	282.75	800	281.18	800	282.9
825	314.37	825	282.75	825	281.18	825	282.9
850	315.81	850	282.75	850	281.18	850	282.9
875	317.2	875	282.75	875	281.18	875	282.9
900	318.57	900	282.75	900	281.18	900	282.9
925	319.92	925	282.75	925	281.18	925	282.9
950	321.28	950	282.75	950	281.18	950	282.9
975	322.62	975	282.75	975	281.18	975	282.9
1000	323.94	1000	282.75	1000	281.18	1000	282.9
1025	325.24	1025	282.75	1025	281.18	1025	282.9
1050	326.52	1050	282.75	1050	281.18	1050	282.9
1075	327.78	1075	282.75	1075	281.18	1075	282.9
1100	329.02	1100	282.75	1100	281.18	1100	282.9
1125	330.24	1125	282.75	1125	281.18	1125	282.9
1150	331.44	1150	282.75	1150	281.18	1150	282.9
1175	332.62	1175	282.75	1175	281.18	1175	282.9
1200	333.78	1200	282.75	1200	281.18	1200	282.9
1225	334.92	1225	282.75	1225	281.18	1225	282.9
1250	336.04	1250	282.75	1250	281.18	1250	282.9
1275	337.14	1275	282.75	1275	281.18	1275	282.9
1300	338.22	1300	282.75	1300	281.18	1300	282.9
1325	339.28	1325	282.75	1325	281.18	1325	282.9
1350	340.32	1350	282.75	1350	281.18	1350	282.9
1375	341.34	1375	282.75	1375	281.18	1375	282.9
1400	342.34	1400	282.75	1400	281.18	1400	282.9
1425	343.32	1425	282.75	1425	281.18	1425	282.9
1450	344.28	1450	282.75	1450	281.18	1450	282.9
1475	345.22	1475	282.75	1475	281.18	1475	282.9
1500	346.14	1500	282.75	1500	281.18	1500	282.9
1525	347.04	1525	282.75	1525	281.18	1525	282.9
1550	347.92	1550	282.75	1550	281.18	1550	282.9
1575	348.78	1575	282.75	1575	281.18	1575	282.9
1600	349.62	1600	282.75	1600	281.18	1600	282.9
1625	350.44	1625	282.75	1625	281.18	1625	282.9
1650	351.24	1650	282.75	1650	281.18	1650	282.9
1675	352.02	1675	282.75	1675	281.18	1675	282.9
1700	352.78	1700	282.75	1700	281.18	1700	282.9
1725	353.52	1725	282.75	1725	281.18	1725	282.9
1750	354.24	1750	282.75	1750	281.18	1750	282.9
1775	354.94	1775	282.75	1775	281.18	1775	282.9
1800	355.62	1800	282.75	1800	281.18	1800	282.9
1825	356.28	1825	282.75	1825	281.18	1825	282.9
1850	356.92	1850	282.75	1850	281.18	1850	282.9
1875	357.54	1875	282.75	1875	281.18	1875	282.9
1900	358.14	1900	282.75	1900	281.18	1900	282.9
1925	358.72	1925	282.75	1925	281.18	1925	282.9
1950	359.28	1950	282.75	1950	281.18	1950	282.9
1975	359.82	1975	282.75	1975	281.18	1975	282.9
2000	360.34	2000	282.75	2000	281.18	2000	282.9
2025	360.84	2025	282.75	2025	281.18	2025	282.9
2050	361.32	2050	282.75	2050	281.18	2050	282.9
2075	361.78	2075	282.75	2075	281.18	2075	282.9
2100	362.22	2100	282.75	2100	281.18	2100	282.9
2125	362.64	2125	282.75	2125	281.18	2125	282.9
2150	363.04	2150	282.75	2150	281.18	2150	282.9
2175	363.42	2175	282.75	2175	281.18	2175	282.9
2200	363.78	2200	282.75	2200	281.18	2200	282.9
2225	364.12	2225	282.75	2225	281.18	2225	282.9
2250	364.44	2250	282.75	2250	281.18	2250	282.9
2275	364.74	2275	282.75	2275	281.18	2275	282.9
2300	365.02	2300	282.75	2300	281.18	2300	282.9
2325	365.28	2325	282.75	2325	281.18	2325	282.9
2350	365.52	2350	282.75	2350	281.18	2350	282.9
2375	365.74	2375	282.75	2375	281.18	2375	282.9
2400	365.94	2400	282.75	2400	281.18	2400	282.9
2425	366.12	2425	282.75	2425	281.18	2425	282.9
2450	366.28	2450	282.75	2450	281.18	2450	282.9
2475	366.42	2475	282.75	2475	281.18	2475	282.9
2500	366.54	2500	282.75	2500	281.18	2500	282.9
2525	366.64	2525	282.75	2525	281.18	2525	282.9
2550	366.72	2550	282.75	2550	281.18	2550	282.9
2575	366.78	2575	282.75	2575	281.18	2575	282.9
2600	366.82	2600	282.75	2600	281.18	2600	282.9
2625	366.84	2625	282.75	2625	281.18	2625	282.9
2650	366.84	2650	282.75	2650	281.18	2650	282.9
2675	366.82	2675	282.75	2675	281.18	2675	282.9
2700	366.78	2700	282.75	2700	281.18	2700	282.9
2725	366.72	2725	282.75	2725	281.18	2725	282.9
2750	366.64	2750	282.75	2750	281.18	2750	282.9
2775	366.54	2775	282.75	2775	281.18	2775	282.9
2800	366.42	2800	282.75	2800	281.18	2800	282.9
2825	366.28	2825	282.75	2825	281.18	2825	282.9
2850	366.12	2850	282.75	2850	281.18	2850	282.9
2875	365.94	2875	282.75	2875	281.18	2875	282.9
2900	365.74	2900	282.75	2900	281.18	2900	282.9
2925	365.52	2925	282.75	2925	281.18	2925	282.9
2950	365.28	2950	282.75	2950	281.18	2950	282.9
2975	365.02	2975	282.75	2975	281.18	2975	282.9
3000	364.74	3000	282.75	3000	281.18	3000	282.9
3025	364.44	3025	282.75	3025	281.18	3025	282.9
3050	364.12	3050	282.75	3050	281.18	3050	282.9
3075	363.78	3075	282.75	3075	281.18	3075	282.9
3100	363.42	3100	282.75	3100	281.18	3100	282.9
3125	363.04	3125	282.75	3125	281.18	3125	282.9
3150	362.64	3150	282.75	3150	281.18	3150	282.9
3175	362.22	3175	282.75	3175	281.18	3175	282.9
3200	361.78	3200	282.75	3200	281.18	3200	282.9
3225	361.32	3225	282.75	3225	281.18	3225	282.9
3250	360.84	3250	282.75	3250	281.18	3250	282.9
3275	360.34	3275	282.75	3275	281.18	3275	282.9
3300	359.82	3300	282.75	3300	281.18	3300	282.9
3325	359.28	3325	282.75	3325	281.18	3325	282.9
3350	358.72	3350	282.75	3350	281.18	3350	282.9
3375	358.14	3375	282.75	3375	281.18	3375	282.9
3400	357.54	3400	282.75	3400	281.18	3400	282.9
3425	356.92	3425	282.75	3			